

LOCATION MAP

# **CONSTRUCTION PLANS**

FOR

# **SIOUX FALLS REGIONAL AIRPORT**

SIOUX FALLS, MINNEHAHA COUNTY, SOUTH DAKOTA

MARK D. WIEDERRICH ENGINEER CERTIFICATION ENGINEER CERTIFICATION

**AS-BUILT DRAWINGS** PREPARED BY: GOLDSMITH HECK ENGINEERS, INC. GENERAL CONTRACTOR: ASPHALT SURFACING COMPANY CONSTRUCTED: APRIL-NOVEMBER 2011

March 2011

AIP NO. 3-46-0050-042-2011

# ENGINEER CERTIFICATION

HEREBY CERTIFY THAT TO THE BEST OF MY PROFESSIONAL ABILITY THESE PLANS AND SPECIFICATIONS WERE DEVELOPED UNDER MY DIRECT SUPERVISION IN ACCORDANCE WITH ALL APPLICABLE FEDERAL STANDARDS AND REQUIREMENTS, AND THAT NO DEVIATION FROM OR MODIFICATIONS TO STANDARDS AS SET FORTH IN THE FEDERAL AVIATION ADMINISTRATION ADVISORY CIRCULARS WILL BE NECESSARY OTHER THAN THOSE PREVIOUSLY APPROVED BY THE FAA.

MARK D. WIEDERRICH, PE/LS S.D. NO. 5168

### SPONSOR APPROVAL

HEREBY APPROVE THESE PROJECT PLANS AND SPECIFICATIONS, CERTIFIED BY A LICENSED PROFESSIONAL ENGINEER THAT THEY HAVE BEEN DEVELOPED TO THE BEST OF HIS PROFESSIONAL ABILITY IN ACCORDANCE WITH FEDERALSTANDARDS AS SET FORTH IN THE FAA ADVISORY CIRCULARS AND THAT NO DEVIATIONS WILL BE NECESSARY OTHER THAN THOSE PREVIOUSLY APPROVED BY THE FAA

SIOUX FALL REGIONAL AIRPORT AUTHORITY

DAN LETELLIER. EXECUTIVE DIRECTOR

ACCEPTED

SOUTH DAKOTA DEPARTMENT OF TRANSPORTATION


BRUCE LINDHOLM, P.E. PROGRAM MANAGER OFFICE OF AERONAUTICS DATE

DATE

DATE

**RECONSTRUCT TERMINAL PARKING, ACCESS IMPROVEMENTS & MISCELLANEOUS ITEMS** 

NOTE: ALL SHEETS IN THIS AS-BUILT PLAN SET HAVE NOT BEEN UPDATED. ONLY SHEETS WITH THE AS-BUILT STAMP HAVE BEEN UPDATED TO REFLECT SIGNIFICANT CHANGES DURING CONSTRUCTION

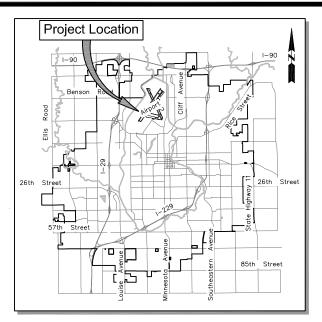

VICINITY MAP

# **INDEX OF SHEETS**

SHEET NO. A1 THRU A3 SHEET NO. B1 THRU B4 SHEET NO C1 THRU C1 SHEET NO. D1 THRU D6 SHEET NO. E1 THRU E9 SHEET NO. F1 THRU F17 SHEET NO. G1 THRU G5 SHEET NO. H1 THRU H8 SHEET NO. 11 THRU IS SHEET NO. J1 THRU J8 SHEET NO. K1 THRU K2 SHEET NO. L1 THRU L5 SHEET NO. M1 THRU M9 SHEET NO. N1 THRU N13 SHEET NO. O1 THRU O21 SHEET NO. Q1 THRU Q31 DETAILS / STANDARD PLATES

TITLE SHEET, LEGEND OF SYMBOLS, **ORIENTATION / CONTROL DATA / ALIGNMENTS** ESTIMATE OF QUANTITIES, TABLE OF STORM SEWER PIPE, TABLE OF DROP INLETS & JUNCTION BOXES TYPICAL SECTIONS GENERAL NOTES SEQUENCE OF OPERATIONS / TRAFFIC CONTROL EROSION & SEDIMENT CONTROL PLAN EXISTING CONDITIONS & DEMOLITION PLAN UTILITIES GRADING CURB & GUTTER AND PAVEMENT LAYOUT SURFACING PAVEMENT MARKINGS SIGNS LIGHTING & POWER LANDSCAPING & IRRIGATION SHEET NO\_P1 THRU P15 ARCHITECTURAL SIGNS & STRUCTURES



#### BID SCHEDULE 1 (AIRPORT FUNDED)

NO.	STD BID ITEM	ITEM DESCRIPTION	UNIT	APPROX QUANT.
1	<b>GRA DING</b> 9.0010	Mobilization	LS	
2	100.0020	Clear and Grub Tree	Each	18
3			LS	
	100.0100	Clearing		
4	110.0400	Remove Drop Inlet	Each	
5	110.0500	Remove Pipe Culvert	Ft	87:
6	110.0600	Remove Fence	Ft	99
7	Special	Remove Overhead Gate Assembly & Equip	LS	
8	Special	Remove Exit Plaza Booth	Each	:
9	Special	Remove Entrance & Exit Lane Equipment	LS	
10	Special	Remove Exit Plaza Canopy	LS	
11	Special	Remove Exit Plaza Canopy Footings	Each	
12	110.1010	Remove Asphalt Concrete Pavement	SqYd	45,12
13	110.1100	Remove Concrete Pavement		2,24
			SqYd	,
14	110.1140	Remove Concrete Sidew alk	SqYd	26
15	110.1540	Remove Luminaire Pole Footing	Each	1
16	Special	Remove Barrier Concrete Posts	Each	11
17	Special	Remove Parking Meters	Each	1
18	Special	Remove Bollard	Each	4
19	Special	Remove Electric Junction Box	Each	
20	110.8100	Saw Existing Asphalt	Ft	3,91
21	110.8110	Saw Existing PCC Concrete	Ft	4
22		Unclassified Excavation		
	120.0010		CuYd	20,89
23	120.0100	Unclassified Excavation, Digouts	CuYd	10
24	120.0480	Scarify and Recompact Subgrade	SqYd	56,34
25	120.6000	Water For Dust Control	MGal	10
26	120.6100	Water For Embankment	MGal	35
27	230.0010	Placing Topsoil	CuYd	3,08
28	230.0300	Salvage Topsoil	CuYd	3,08
29	380.9010	Temporary Gravel Crossing	Each	-,
30	735.5050	Transplant Tree	Each	4
		•		
31	950.5700	Locating Utility	Each	
32	950.5710	Verify Utility	Each	
	TRAFFIC C	ONTROL		
33	634.0100	Traffic Control	Unit	79
34	Special	Traffic Control, Special Signs	Unit	11
35	634.0120	Traffic Control, Miscellaneous	LS	
36	634.0420	Type C Advance Warning Arrow Panel	Each	
37	Special	Safety Fence	L.Ft	3.84
•	EROSION C	,		-,
38		Drainage Fabric	SaVd	10
			SqYd -	
		Class B Riprap	Ton	19
40	Special	BMP Forebay Check Dam Rock	Ton	4
41	734.0105	Erosion Control Blanket	SqYd	2,26
42	734.0135	Turf Reinforcement Mat	SqYd	17
43	734.0850	Inlet Protection	Each	3
44	734.5010	Sw eeping	Hour	2
45	734.6001	Temporary Vehicle Tracking Control	Each	
46	734.6006	Concrete Washout Facility	Each	
		· · · · · · · · · · · · · · · · · · ·		
47	Special	Temporary Sediment Basin	Each	
	STORM SE			
48	450.0105	12" RCP Class 5, Furnish	Ft	36
49	450.0110	12" RCP, Install	Ft	36
50	450.0114	12" RCP, Install 15" RCP Class 4, Furnish 15" RCP, Install 18" RCP Class 3, Furnish 18" RCP Class 5, Furnish 18" RCP Class 5, Furnish 18" RCP, Install	Ft	18
51	450.0120	15" RCP, Install	Ft	18
52	450.0123	18" RCP Class 3. Furnish N ENG / A/A	Ft	50
53	450.0125	18" RCP Class 5 Furnish	Ft	18
53 54		18" RCP Class 3, Furnish 18" RCP Class 5, Furnish 18" RCP, Install	- FL	
	450.0130			69
55	450.0143	24" RCP Class 3, Furnish 5168	Ft	50
56	450.0150	124" RCP, Install 🚄 😥 •	<b>I</b> Ft	50
57	450.0163	30" RCP Class 3, For nist MARK D.	Ft	13
58	450.0170	30" RCP, Install	Ft	13
59	450.0183	36" RCP Class 3. Furthistry	E Ft	56
60	450.0100	36" RCP Install	Ft	56
	450.0190			
61	450.0408	30" RCP Class 3, Finish MARK D. 30" RCP, Install WIEDERRICH 36" RCP Class 3, Funish State Stat	Each	
62	450.0409	18" RCP Bend, Install	Each	
	450 0700	IRCP Tee Eurnish 18"x 15"	Each	
63	450.0700			


ITEM	STD			APPROX.
NO.	BIDITEM			QUANT.
65	450.2024	30" RCP Flared End, Furnish	Each	1
66	450.2025	30" RCP Flared End, Install	Each	1
67	450.2028 450.2029	36" RCP Flared End, Furnish	Each	1 1
68 69	450.2029 Special	36" RCP Flared End, Install Connect to Existing Storm Structure	Each Each	3
70	Special	Connect to Existing Storm Pipe	Each	3 1
71	462.0100	Class M6 Concrete	CuYd	32.2
72	480.0100	Reinforcing Steel	Lb	3,704
73	Special	BMP Outlet Control Structure - South Pond	LS	<u> </u>
74	Special	BMP Outlet Control Structure - North Pond	LS	1
75	Special	Salvage & Reset Area Inlet Frame & Grate	Each	. 1
76	670.1200	Type B Frame and Grate Assembly	Each	3
77	670.5200	Special Frame & Grate (R-3541 w / L Grate or equal)	Each	1
78	671.6100	Type Y Manhole Frame and Lid	Each	7
79	950.5300	Manhole Frame and Cover, 7"	Each	6
80	Special	Storm Structure Adjustment	Each	3
81	Special	Storm Frame & Grate Adjustment	Each	3
	SANITARY	-		-
82	1	6" Sew er Cleanout Assembly	Each	1
83	950.4801	6" Boots For Manhole	Each	1
84	950.4951	6" Sanitary Sew er Service	Ft	75
85	Special	Precast 1300 Gallon Sanitary Sew er Holding Tank	Each	
	WATER			
86	Special	1" Copper Water Service, F&I	Ft	15
	SURFACING			
87	1	Water For Granular Material	MGal	283
88	260.1010	Base Course	Ton	28,330
89	320.1200	Asphalt Concrete Composite	Ton	14,137
90	320.1250	Asphalt Concrete For Patching	Ton	23
91	380.0010	6" Nonreinforced PCC Pavement	SqYd	1,463
92	380.4010	6" PCC Fillet Section	SqYd	259
93	650.7000	Concrete Curb & Gutter Type SF66	Ft	9,377
94	Special	PCC Pavement 6", Median Noses	SqYd	21
95	651.0050	5" Concrete Sidew alk	SqFt	14,478
96	651.6010	Detectable Warning Surface	SqFt	64
97	Special	Concrete Island Pavement, 6"	SqFt	713
98	Special	Bollards, 4"	Each	35
99	Special	Bollard/Chain Gate Assembly	Each	4
100	831.0050	Geotextile Fabric For Subgrade Stabilization	SqYd	7,871
101	950.5000	Adjust Manhole	Each	4
101	LIGHTING 8			
102		Remove Luminaire Pole Footing	Each	19
103	Special	Breakaw ay Base Luminaire Pole with Arm, 30' Mounting Height	Each	2
104	Special	Fixed Base Luminaire Pole with Arm, 35' Mounting Height	Each	5
105	Special	Roadway Luminaire, 250 Watt	Each	2
106	Special	Roadway Luminaire, 400 Watt	Each	3
100	Special	Roadway Luminaire, 1000 Watt	Each	8
108	Special	Floodlight Luminaire, 100 Watt	Each	6
109	Special	Floodlight Luminaire, 250 Watt	Each	2
110	635.8113	1" Rigid Conduit, Schedule 40	Ft	7,366
111	635.8115	1.5" Rigid Conduit, Schedule 40	Ft	5,323
112	635.8120	2" Rigid Conduit, Schedule 40	Ft	3,046
113	635.5020	2' Diameter Footing	Ft	197
114	Special	Type 1 Electrical Junction Box	Each	
115	Special	Type 2 Electrical Junction Box	Each	
116	Special	Type 4 Electrical Junction Box	Each	3
117	635.5530	Preformed Loop Detector	Each	22
118	Special	Remove and Reset Luminaire Pole	Each	19
119	Special	1/C #2 AWG Copper Wire	Ft	7,988
120	635.9016	1/C #6 AWG Copper Wire	Ft	21,043
	635.9018	1/C #8 AWG Copper Wre	Ft	15,954
121	635.9020	1/C #10 AWG Copper Wire	Ft	7,154
121 122		Remove Junction Box	Each	7,104
122				34
122 123	Special	Fixed Base Light Bollards 3' Height	Each I	
122 123 124	Special Special	Fixed Base Light Bollards, 3' Height Feed Point Modificatoin	Each LS	
122 123 124 125	Special Special Special	Feed Point Modificatoin	LS	1
122 123 124 125 126	Special Special Special Special	Feed Point Modificatoin Panel Board Modification	LS LS	1 1
122 123 124 125	Special Special Special	Feed Point Modificatoin	LS	1

ITEM NO.	STD BID ITEM	ITEM DESCRIPTION	UNIT	APPROX. QUANT.	ACCESS  MPROVEMENTS
NO.		MARKINGS & PERMANENT SIGNS	UNIT	QUANT.	
130	633.1400	Pavement Marking Paint, 4" White	Ft	137	
131	633.1405	Pavement Marking Paint, 4" Yellow	Ft	44,087	Å Å
132	633.1430	Pavement Marking Paint, 24" White	Ft	77	Σ
133	Special	Wheelchair Symbol, White Paint	Each	29	0.0
134	Special	Remove Traffic Sign	Each	120	I S H
135	110.5021	Salvage Traffic Sign for Reset	Each	4	
136	632.1320	2.0"x2.0" Perforated Tube Post	Ft	307	Ā
137	632.1330	2.25"x2.25" Perforated Tube Post	Ft	140	α α
138	632.1340	2.5"x2.5" Perforated Tube Post	Ft	60	
139	Special	Furnish Sheet Aluminum Sign with Reflective Sheeting	SqFt	93	Parking
140	632.3060	Install Traffic Sign on Post	Each	86.0	l l X
141	632.3065	Install Traffic Sign on Street Light	Each	4.0	
142	Special	Cantilever Sign Structure	LS	1.0	
	MEDIANLA	NDSCAPING & IRRIGATION			TFRMINAL
143	120.6300	Water For Vegetation (shrubs and spaded trees)	MGal	50	
144	Special	Soil Preparation, Till & Fine Grade for Law n and Landscape	MSf	295	Σ
145	730.0251	Special Permanent Seed Mixture	LB	1,970	<u> </u>
146	731.0100	Fertilizing	LB	1,468	
147	732.0200	Fiber Mulching	Ton	5	
148	733.0100	Sodding	SqYd	2,833	
149	Special	3 Gallon Deciduous Shrub, Furnish and Plant	Each	1,250	
150	Special	5 Gallon Deciduous Shrub, Furnish and Plant	Each	94	
151	Special	5 Gallon Coniferous Shrub, Furnish and Plant	Each	32	
152	735.1370	7' Coniferous Evergreen, Furnish and Plant	Each	37	TIES
153	735.2060	6' to 8' Tree, Furnish and Plant	Each	49	QUANTITIES
154	735.2220	2" Caliper Deciduous Tree, Furnish and Plant	Each	3	INAN
155	735.2225	2.5" Caliper Deciduous Tree, Furnish and Plant	Each	62	OF Q
156	735.0110	1 Gallon Perennial Plant, Furnish and Plant	Each	2,814	ОШ
157	735.5010	1 Gallon Ornamental Grass, Furnish and Plant	Each	1,359	ESTIMATE
158	900.5152	Weed Barrier Fabric	SqYd	6,405	STIP
159	999.5156	3" Depth Shredded Bark Mulch	SqYd	6,230	μü
160	Special	Quartzite Edging	SqYd	173	
161	Special	Landscape Edging- Polyethylene	LF	1,986	i i
162	Special	Landscape Edging- Metal	LF	255	100
163	Special	Spray Turf with Non-selective Herbicide	SqYd	13,782	č
164	Special	Pre-Emergent Herbicide	SqYd	6,405	
165	Special	Well, Pump, and Controls	Each	1	
166	Special	Irrigation Controller, 2 Wire Decoder Module, & Accessories	Each	1	
167	Special	Irrigation Remote Control	Each	1	
168	Special	Sylar Sync Sensor	Each	1	
169	Special	1" Automatic Globe Valve, Decoder, and Valve Box	Each	10	- 1 k
170	Special	1.5" Automatic Globe Valve, Decoder, and Valve Box	Each	24	
171	Special	1" Drip Zone Kit	Each	1	
172	Special	3" PVC Isolation Valve in Valve Box	Each	6	C
173	Special	Quick Coupling Valve and Valve Box	Each	18	
174	Special	Hunter Ultra Rotor Irrigation Head	Each	163 548	
175 176	Special Special	Hunter MP Rotator Irrigation Head 4" Irrigation Sleeve - Direct Bury	Each LF	548 670	
176	Special Special		_		
177	Special Special	4" Irrigation Sleeve - Bore 2-1/2" Class 200 Irrigation Mainline	LF LF	205 5,530	>
178	Special Special	1-1/4" Class 200 Irrigation Mainline	LF	5,530	
179	Special Special			11,710	
180	Special Special	1" SDR 21 Polyethylene Irrigation Lateral 1-1/4" SDR 21 Polyethylene Irrigation Lateral	LF	11,710	
181	Special Special	2-1/2" Class 160 Irrigation Lateral		1,900	
182	Special	2" Class 160 Irrigation Lateral		50	
184	Special	1-1/2" Class 160 Irrigation Lateral		855	
185	Special	3/4" CL315 PVC Drip Line Header Pipe	LF	400	
186	Special	Netafim Techline TLDL6-12 Dripline		2,230	cì
187	635.9020	1/C #10 AWG Copper Wire		4,680	
188	635.9020	1/C #12 AWG Copper Wire		4,840	
		TURAL SIGNS		-,,-	
100	Special	Entrance Sign and Sign Wall	Each	1	
	opoolai	Exit Sign	Each	1	
189	Special	a menor and the			I I
189 190	Special Special		Each	4	SHEE
189 190 191	Special	Exit Sign - small, exit text on 2 sides	Each Each	4	SHEET
189 190			Each Each LF	4 1 520	SHEE

#### BID SCHEDULE 2 (FAA AIP ELIGIBLE)

ITEM	STD			APPROX
NO.	BID ITEM	ITEM DESCRIPTION	UNIT	QUANTITY
	GRA DING	•		1
194	110.0400	Remove Drop Inlet	Each	1
195	110.0500	Remove Pipe Culvert	Ft	34
196	110.0510	Remove Pipe End Section	Each	1
197	110.1010	Remove Asphalt Concrete Pavement	SqYd	2,680
198	110.1100	Remove Concrete Pavement	SqYd	2,324
199	110.1140	Remove Concrete Sidew alk	SqYd	1,422
200	110.1540	Remove Luminaire Pole Footing	Each	3
201	Special	Remove Quartzite Paver Planter Wall	Each	2
202	110.8100	Saw Existing Asphalt	Ft	1,262
202	110.8110	Saw Existing PCC Concrete	Ft	669
204	120.0010	Unclassified Excavation	CuYd	8,955
204	120.0480	Scarify and Recompact Subgrade	SqYd	7,385
205	230.0010	· · · · ·	CuYd	
200	230.0010	Placing Topsoil		1,321 1,321
207		Salvage Topsoil	CuYd	1,321
00.0	STORM SE			
208	450.0105	12" RCP Class 5, Furnish	Ft	57
209	450.0110	12" RCP, Install	Ft	57
210	450.0123	18" RCP Class 3, Furnish	Ft	9
211	450.0125	18" RCP Class 5, Furnish	Ft	42
212	450.0130	18" RCP, Install	Ft	51
213	450.0143	24" RCP Class 3, Furnish	Ft	29
214	450.0150	24" RCP, Install	Ft	29
215	Special	Storm Sew er Boot Connection	Each	1
216	462.0100	Class M6 Concrete	CuYd	11
217	480.0100	Reinforcing Steel	Lb	1,750.0
218	Special	Salvage & Reset Type B Frame & Grate Assembly	Each	1
219	670.5200	Special Frame & Grate (R-3067-C w / L Grate or equal)	Each	1
220	671.6100	Type Y Manhole Frame and Lid	Each	4
	WATER			•
221	900.0201	6" C900 DR 18 PV C Watermain	Ft	107
222	900.0450	Valve Box Adjustment	Each	1
223	900.1502	Fire Hydrant	Each	1
224	900.6004	Excavate and Backfill for City furnished Smith Tap and Box	Each	1
225	Special	6"x6" Smith Tap Charge (paid to City)	LS	1
226	900.8001	6" Watermain Bedding Material	Ft	107
	SURFACING	-		
227	120.6200	Water For Granular Material	MGal	39
228	260.1010	Base Course	Ton	4,101
229	320.1200	Asphalt Concrete Composite	Ton	1,408
230	320.1250	A sphalt Concrete For Patching	Ton	27
231	332.0010	Cold Milling Asphalt Concrete	SqYd	1,009
232	380.0070	9" Nonreinforced PCC Pavement	SqYd	467
232	380.4010	6" PCC Fillet Section	SqYd	35
234	380.4070	9" PCC Fillet Section	SqYd	48
235	460.0380	Install Dow el in Concrete	Each	149
236	650.7000	Concrete Curb & Gutter Type SF66	Ft	4,256
237	650.7060	Concrete Curb & Gutter Type SF69	Ft	598
238	650.8000	Concrete Valley Gutter 6" Thick	SqYd	11
239	Special	PCC Pavement 6", Median Noses	SqYd	18
240	Special	PCC Pavement 9", Median Noses	SqYd	28
241	651.0050	5" Concrete Sidew alk	SqFt	13,650
242	651.6010	Detectable Warning Surface	SqFt	80
243	Special	Concrete Median Pavement, 6"	SqFt	3,127
244	831.0050	Geotextile Fabric For Subgrade Stabilization	SqYd	1,485

ITEM	STD			APPROX
NO.	BID ITEM	ITEM DESCRIPTION	UNIT	QUANTITY
	STREET LIC	SHTING & TRA FFIC SIGNALS (MINNESOTA A VENUE)		
245	635.5020	2' Diameter Footing	Ft	9
246	635.5025	2.5' Diameter Footing	Ft	40
247	635.5062	Anchor Botts (Signal)	Each	12
248	635.5100	Controller Cabinet Footing	Each	1
249	635.5318	18" Diameter Junction Box	Each	1
250	635.5324	24" Diameter Junction Box	Each	2
251	Special	Remove and Reset Electrical Junction Box	Each	1
252	635.5491	Tie to Existing Conduit	Each	2
253	635.5494	Tie to Existing Junction Box	Each	1
254	635.7500	Remove and Reset Luminaire Pole (50' Height)	Each	1
255	635.8020	2" Rigid Galvanized Steel Conduit	Ft	157
256	635.8030	3" Rigid Galvanized Steel Conduit	Ft	98
257	635.8040	4" Rigid Galvanized Steel Conduit	Ft	8
258	635.8120	2" Rigid Conduit, Schedule 40	Ft	203
259	635.8220	2" Rigid Conduit, Schedule 80	Ft	110
260	635.8330	2" Innerduct, SDR 13.5 w / Tracer Wire	Ft	1,285
261	635.9635	Install Street Light Wire	Ft	41
262	Special	Furnish and Install Transformer Base	Each	3
	PAVEMENT	MARKINGS & PERMANENT SIGNS	·	
263	110.1400	Remove Pavement Marking, 4" or Equivalent	Ft	654
264	633.0030	Cold Applied Plastic Pavement Marking, 24"	Ft	101
265	633.1400	Pavement Marking Paint, 4" White	Ft	2,013
266	633.1430	Pavement Marking Paint, 24" White	Ft	548
267	633.1445	Pavement Marking Paint, Arrow	Each	6
268	Special	Remove Traffic Sign	Each	21
269	110.5021	Salvage Traffic Sign for Reset	Each	19
270	632.1320	2.0"x2.0" Perforated Tube Post	Ft	324
271	632.1330	2.25"x2.25" Perforated Tube Post	Ft	123
272	632.1340	2.5"x2.5" Perforated Tube Post	Ft	51
273	Special	Furnish Sheet Aluminum Sign w ith Reflective Sheeting	SqFt	182
274	632.3060	Install Traffic Sign on Post	Each	40
275	632.3065	Install Traffic Sign on Street Light	Each	17.0
276	632.3070	Install Traffic Sign on Sign Structure	Each	3.0
199	632.1340	2.5"x2.5" Perforated Tube Post	Ft	51.0
200	Special	Furnish Sheet Aluminum Sign with Reflective Sheeting	SqFt	182.30
201	632.3060	Install Traffic Sign on Post	Each	40
202	632.3065	Install Traffic Sign on Street Light	Each	17
203	632,3070	Install Traffic Sign on Sign Structure	Each	3

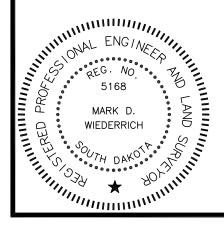



# TABLE OF STORM SEWER PIPE

BID ITEM	FURNISH	450.0105	450.0114	450.0123	450.0125	450.0143	450.0163	450.0183	450.2024	450.2028	450.0700	SPECIAL	450.7300
NUMBERS	INSTALL	450.0110	450.0120	450.0130	450.0130	450.0150	450.0170	450.0190	450.2025	450.2029	450.0701	SPECIAL	450.7301
						REINFOR	CED CONC	RETE PIPE	E				CORRUGAT POLYETHYL PIPE
	-				CIRCULAR				FLARE	D END	RCI	P TEE	CIRCULA
PLAN SHEET	PIPE DIA.	12"	15"	18"	18"	24"	30"	36"	30"	36	18"x15"	18"x12"	12"
LOCATION	TYPE UNIT	CLASS 5 FT	CLASS 4 FT	CLASS 3 FT	CLASS 5 FT	CLASS 3 FT	CLASS 3 FT	CLASS 3 FT	EACH	EACH	(F&I) EACH	(BOOT CONNECT.) EACH	FT
SHEET H1 (AI #2 TO B1 #1)		131							LAGH	LAGIT	LAON	LAGI	
SHEET H1 (AI #2 TO AI #3)		101			187								
SHEET H1 (B1 #3 TO B1 #2)		59											
SHEET H1 (DI #1 TO B1 #3)		30											
SHEET H1 (DI #1 TO DI #2)				9									
SHEET H1 (DI #2 TO DI #3)					42								
SHEET H2 (DI #2 TO T #1)				142									
SHEET H2 (T #1)											1		
SHEET H2 (T #1 TO DI #4)			18										
SHEET H2 (T #1 TO JB #1)				128									
SHEET H3 (15"RCP CONNEC	CT. TO DI #5)		161										
SHEET H4 (JB #5 TO DI #7)				235									
SHEET H5 (AI #2 TO DI #8)						465							
SHEET H5 (DI #8 TO DI #9)						29							
SHEET H5 (DI #9 TO DI #10)						40							
SHEET H6 (JB #6 TO JB #2)								198					
SHEET H6 (FE #1)										1			
SHEET H6 (FE #1 TO JB #6)								32					
SHEET H6 (JB #5 TO DI #11) SHEET H6 (DI #11 TO DI #12		147											
SHEET H6 (SOUTH POND F		47											10
SHEET H6 (JB #7 TO OUTLE								212					
SHEET H8 (JB #7 TO OUTLE	-						126	212					
							120		1				
							8						
SHEET H8 (FE #2 TO DI #8) SHEET H8 (NORTH POND F SHEET H8 (T #2) SHEET H8 (T #2 TO B1 #4)	DREBAY)						~						10
SHEET H8 (T #2)	,											1	
SHEET H8 (T #2 TO B1 #4)		10											
	TOTAL:	424	179	514	229	534	134	442	1	1	4	1	20

# **TABLE OF DROP INLETS & JUNCTION BOXES**

# TABLE OF DROP INLETS

PLAN SHEET LOCATION	INLET NO.	INLET SIZE (L'xW')	INLET TYPE	FRAME & GRATE / LID TYPE	CLASS M6 CONC. (CUYD)	REINF. STEEL (LB)
SHEET H1	AI #1	4x2*	-	R-3541-A ("L" GRATE)	-	-
SHEET H1	B1 #1	3x2	STANDARD	R-3067 ("VB" GRATE)	0.79	28.0
SHEET H1 & H5	AI #2	3x2^	STANDARD	RESET SALVAGED	1.04	28.0
SHEET H1	AI #3	4x3*	-	-	-	-
SHEET H1	B1 #2	3x2	STANDARD	R-3067 ("VB" GRATE)	0.79	28.0
SHEET H1	B1 #3	3x2	STANDARD	R-3067 ("VB" GRATE)	0.79	28.0
SHEET H1	DI #1	6x3	STANDARD	Y	1.94	321.6
SHEET H1	DI #2	6x3	STANDARD	Y	2.00	324.7
SHEET H1	DI #3	4x2*	-	-	-	-
SHEET H2	DI #4	6x3	STANDARD	Y	2.13	334.6
SHEET H3 & H4	AI #4	4x3**	-	-	-	-
SHEET H3	DI #5	6x3	STANDARD	Y	1.96	312.7
SHEET H3 & H4	DI #6	4x2*	-	Y (NEW 5'x3' INLET LID)	0.31	67.2
SHEET H4	DI #7	6x3	STANDARD	Y	2.05	324.7
SHEET H5 & H8	DI #8	10x3	STANDARD	Y	4.00	679.3
SHEET H5 & H8	DI #9	6x3	STANDARD	Y	2.57	394.3
SHEET H5 & H8	DI #10	10x3	STANDARD	Y	3.33	539.2
SHEET H6	DI #11	6x3	STANDARD	Y	1.87	305.1
SHEET H6	DI #12	6x3	STANDARD	Y	2.05	323.9
SHEET H8	AI #5	3x2B	-	R-3067-C ("L" GRATE)	-	-
SHEET H8	B1 #4	3x2	STANDARD	RESET SALVAGED	1.11	28.0
ITALICS= BID SCH	IEDULE 2 (FAA A	IP ELIGIBLE)		SUBTOTAL:	28.7	4,067

PLAN SHEET LOCATION	J.B. NO.	J.B. SIZE (L'xW')	FRAME & LID (TYPE)	CLASS M6 CONC. (CUYD)	REINF. STEEL (LB)
SHEET H2	JB #1	4x2*	R-1772A (NEW 5'x3' J.B. LID)	0.29	46.6
SHEET H2	JB #2	4x3**	R-1772A (NEW 5'x4' J.B. LID)	0.42	57.0
SHEET H3	JB #3	4x2*	R-1772A (NEW 5'x3' J.B. LID)	0.29	46.6
SHEET H3	JB #4	4x3**	R-1772A (NEW 5'x4' J.B. LID)	0.42	57.0
SHEET H3 & H4	JB #5	4x4***	-	-	-
SHEET H6	JB #6	4x4	R-1772A	4.15	267.5
SHEET H6 & H8	JB #7	8x6	R-1772A	9.10	912.0
			SUBTOTAL:	14.7	1387

\* = EXISTING DROP INLET

\*\* = EXISTING AREA INLET

\*\*\* = EXISTING JUNCTION BOX

### QUANTITIES SUMMARY

BID ITEM NO.	BID ITEM	QUANTITY	UNITS
462.0100	M6 CONCRETE (BID 1= 32.2 CUYD; BID 2 = 11.2 CUYD)	43.4	CUYD
480.0100	REINFORCING STEEL (BID 1= 3,704 LBS; BID 2 = 1,750 LBS)	5,454	LBS
670.1200	TYPE B FRAME & GRATE (R-3067 w/ "VB" GRATE)	3	EACH
670.5200	SPECIAL FRAME & GRATE (R-3541 w/ "L" GRATE)	1	EACH
670.5200	SPECIAL FRAME & GRATE (R-3067-C w/ "L" GRATE)	1	EACH
671.6100	TYPE Y MANHOLE FRAME & LID (BID 1= 7 EA; BID 2= 4 EA)	11	EACH
950.5300	MANHOLE FRAME & COVER (R-1772A)	6	EACH
SPECIAL	STORM STRUCTURE ADJUSTMENT	3	EACH
SPECIAL	STORM FRAME & GRATE ADJUSTMENT	3	EACH
950.5000	ADJUST MANHOLE	4	EACH

# TABLE OF STORM FRAME & GRATE / MANHOLE CASTING ADJUSTMENTS

PLAN SHEET LOCATION	INLET OR J.B. NO.	INLET OR J.B. SIZE (L'xW')	ADJUSTMENT TYPE / DETAILS
SHEET H1	AI #1	4x2*	FRAME & GRATE (DURING CONCRETE PAVING)
SHEET H1	AI #3	4x3*	FRAME & GRATE +0.17' (DURING ASPHALT OVERLAY)
SHEET H2	JB #1	4x2*	MANHOLE (DURING ASPHALT PAVING)
SHEET H2	JB #2	4x3**	MANHOLE +0.82' OF ADJUST. RINGS (DURING ASPHALT PAVING)
SHEET H3	JB #3	4x2*	MANHOLE (DURING ASPHALT PAVING)
SHEET H3	JB #4	4x3**	MANHOLE +0.94' OF ADJUST. RINGS (DURING ASPHALT PAVING)
SHEET H3 & H4	AI #4	4x3**	FRAME & GRATE +0.43' (DURING ASPHALT PAVING)
ONLET NO WITH	74 // -	47.0	

* = EXISTING DROP INLE	Т
------------------------	---


- \*\* = EXISTING AREA INLET
- B = EXISTING B1 INLET
- ^ = REMOVE & INSTALL NEW AREA INLET

### TABLE OF STORM STRUCTURE ADJUSTMENTS

	ITALICS= BID SCH	IEDULE 2 (FAA A	IP ELIGIBLE)		SUBTOTAL: 28.7			
	mmmm							
	WAL ENGINE	1111	* = EXISTING DR	OP INLET				
JIN.		P	** = EXISTING AREA INLET					
TE,	5168	3	B = EXISTING B1	INLET				
IIIIIIIIIIIIIIIIIIIIIIIIIIIIIIIIIIIIII	$\frac{1}{2}$ $\frac{1}$	LAND SUPL	^ = REMOVE & IN	STALL NEW AREA	INLET			
	S_3 → → → → → → → → → → → → → → → → → → →		E OF STORM	STRUCTURE	ADJUSTMENTS			
	PLAN SHEET LOCATION	INLET OR J.B. NO.	INLET OR J.B. SIZE (L'xW')		ADJUSTMENT DETAILS			
	SHEET H1	AI #1	4x2*	ADJUST -0.58	3' ON 3 SIDES, ADJUST +0.42' ON FRONT S	BIDE		
	SHEET H2	JB #1	4x2*	ADJUST -0.79	' ON 3 SIDES, ADJUST +0.21' ON FRONT S	BIDE		
	SHEET H3	JB #3	4x2*	ADJUST +0.20	6' ON 3 SIDES, ADJUST +1.26' ON FRONT S	SIDE		


# TABLE OF JUNCTION BOXES




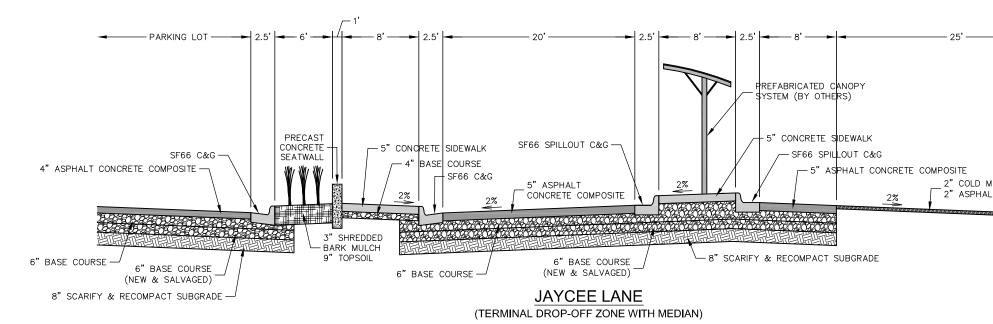


NOTE ENTRANCE AND EXIT PLAZA SHALL BE: 5" ASPHALT CONCRETE COMPOSITE OVER 11" BASE OR

OR OR 6" PCC PAVEMENT OVER 10" BASE REFER TO SURFACING PLAN FOR EXACT LOCATIONS

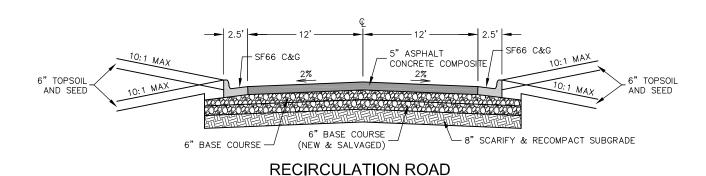

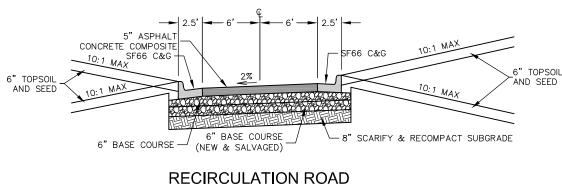

(RETURN TO TERMINAL)

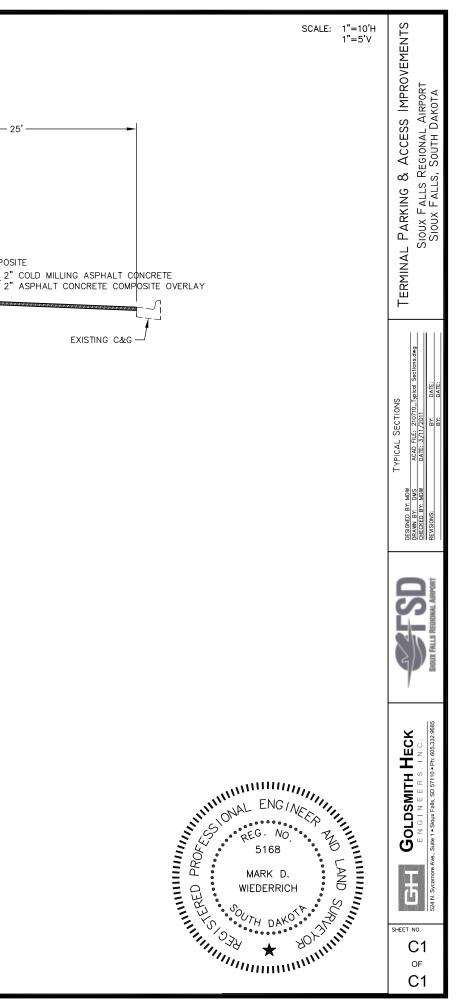

# **GENERAL NOTES**

#### **PROJECT SCOPE**

This project consists of the reconstruction of the Terminal Parking Lot and Terminal Access Roads Improvements at the Sioux Falls Regional Airport. Work includes demolition, erosion control, water main, storm sewer, grading, curb & gutter, asphalt composite pavement, PCC pavement, concrete sidewalk, street lighting, colored concrete median pavement, permanent signage, sign structures, lighting, pavement markings, irrigation (including private well) and landscaping.

#### SPECIFICATIONS TO BE USED

The most current edition of the City of Sioux Falls General Conditions for Public Improvements and Supplemental Standard Specifications, together with the most current edition of the South Dakota Department of Transportation Standard Specifications for Roads and Bridges with Supplemental Specifications and Errata and required provisions, supplemental specifications, and/or special provisions as included in the Project Manual are hereby made a part of these specifications in its entirety unless otherwise revised, deleted, or supplemented herein.

The City of Sioux Falls Engineer's Office will provide a copy of the City of Sioux Falls General Conditions for Public Improvements and the City of Sioux Falls Supplemental Standard Specifications free of charge to all prospective bidders upon request. The Supplemental Standard Specifications can also be downloaded from the City of Sioux Falls website at address http://www.siouxfalls.org/publicworks under Engineering Documents. The South Dakota Department of Transportation Standard Specifications for Roads and Bridges with Supplemental Specifications and Errata can be downloaded from the SDDOT's website at http://www.sddot.com/.

### ORDER OF PRECEDENCE

If conflicts arise, the order of precedence of the contract documents shall be as follows: Plans over Special Provisions over Supplemental Specifications over City of Sioux Falls Supplemental Standard Specifications over City of Sioux Falls General Conditions for Public Improvements over South Dakota Department of Transportation Supplemental Specifications and Errata over South Dakota Department of Transportation Standard Specifications for Roads and Bridges.

#### **CONSTRUCTION LIMITS**

The construction limits shall be within work limits shown on the plans. Material storage and vehicle and equipment traffic shall be limited to the construction limits and the area designated on the traffic control sheets for staging and storage. All paved streets adjacent to the project are to be cleaned at the end of each working day.

It shall be the responsibility of the contractor to coordinate with the property owners relating to access to their property and any subsequent damages.

### **GRADE STAKES, BENCHMARKS AND MONUMENTS**

All stakes, stones, and monuments now in place and marking lines and corners of boundaries which are likely to be affected by the work herein provided for shall be carefully preserved by the Contractor. In no case shall any excavation be made within five feet (5') of any such stake, stone or monument until they have been properly reset, witnessed, or otherwise cared for by the Engineer and permission is given to proceed with the work.

All lines, grade stakes, and benchmarks set by the Engineer in connection with the work herein provided for shall be carefully preserved by the Contractor and shall not be disturbed nor moved from the exact position and elevation as set by the Engineer. No excavated material shall be thrown over or against said stakes and, except where necessary to remove the stakes as the work progresses, all stakes shall be carefully preserved in the original position and elevation until the work has passed final inspection and been accepted. Stakes, which must be removed as the work progresses shall be so removed only upon the order of the Engineer.

All stakes, stones, monuments, and benchmarks disturbed or removed through carelessness or without proper authority will be reset at the expense of the Contractor.

#### NOISE PERMIT

The Contractor shall obtain a noise permit from the City of Sioux Falls Health Department (Mark Schuttloffel 367-8783) if working between 10:00 PM to 6:00 AM. The Contractor shall submit a request in writing to the Engineer for approval 24 hours in advance when nighttime work is to occur.

#### SUBMITTALS

The following documents shall be submitted by the Contractor:

- Construction Schedule 1
- Asphalt/Concrete job mix formula 2
- 3. Certification of Compliance for Asphalt
- Materials Certifications 4.
- 5 Shop Drawings

#### CONSTRUCTION SCHEDULE

The Contractor shall prepare a construction schedule for approval to the Engineer that will ensure the completion of the project within the time frame specified. This schedule must be provided to the Engineer for review a minimum of 3 days prior to the preconstruction meeting. The notice to proceed will not be issued until the schedule has been approved by the Airport. The construction schedule shall be in bar or network diagram form and show the start and completion dates for significant items of work in their respective phases. Significant items of work includes but is not limited to: erosion control, removals, grading, the installation of watermain, sanitary sewer, storm sewer, lighting, base course, curb and gutter, paving, sidewalk, signage, irrigation, landscaping and pavement markings. When applicable the schedule shall include submission dates for shop drawings, manufacturing and installation of materials, supplies, equipment, and testing for various parts of the work.

The construction schedule shall be updated on a bi-weekly basis. If it appears the rate of progress is such that the contract will not be completed within the time frame allowed the Contractor will be required to provide written documentation as to what measures they will take to complete the project within the specified time frame or to prosecute work in a satisfactory manner. Failure to submit the schedule on a bi-weekly basis will result in the Airport withholding the pay applications until the updated schedule is submitted.

#### COORDINATION MEETINGS

The contractor shall conduct coordination meetings with the subcontractors, utilities, the Engineer and Airport Users. These meetings shall be held weekly in the Terminal Building Main Floor Conference Room. The Contractor shall determine the time and location and as approved by the Engineer. The frequency of the meetings may be reduced, as approved by the Engineer, if it is determined that adequate coordination is being attained.

Airport Users will be invited to the first half of the meeting. The Contractor will give a brief summary of the project schedule and will answer any questions. The Users will then be dismissed and the Contractor can discuss construction coordination and other issues as needed

All costs to conduct the coordination meetings shall be incidental to the project.

#### ACCEPTANCE TESTING

The Airport will be responsible for taking the first acceptance test and a backup test if required. All subsequent tests required due to failures will be paid by the Contractor by deducting the cost from the pay request.

#### DRAINAGE

Drainage is the Contractor's responsibility. Contractor shall be aware of existing drainage conditions and facilities, and shall provide for drainage during all phases of construction. Damage caused by improper temporary drainage facilities shall be repaired at the Contractor's expense and to the satisfaction of the Engineer.

#### UTILITIES

All utilities shall be verified by the Contractor prior to starting work. Any time existing utilities impede the progress of work, the Contractor shall immediately notify the Engineer.

All utilities, whether privately or publicly owned, shall be moved, relocated, and/or replaced as necessary, by the respective utility company or companies except as noted in the plans. These modifications shall take place in advance of construction when applicable or when advised by the Engineer. No payment shall be made to the Contractor unless specified in the contract documents

The Contractor shall safeguard all utilities and coordinate his efforts to coincide with utility work by others in order to minimize inconvenience to the public and utility companies. When pipe utility installation crosses existing utilities, the Contractor shall be responsible for supporting the utilities in a manner that is acceptable to the owner of the utility. Any damage caused to the utilities due to Contractor carelessness shall be repaired at the Contractor's expense to the satisfaction of the utility owner.

Abandoned utilities (gas lines, telephone lines, etc.) encountered during construction shall be removed and disposed of by the Contractor. Costs associated with this work shall be incidental to the various bid items associated with work adjacent to the abandoned utility.

The Contractor shall be responsible for the coordination of all work associated with the disturbance, removal, or replacement of unidentified metallic natural gas mains or services when encountered. The Contractor shall, in advance and prior to proceeding with the work, coordinate with the City of Sioux Falls, MidAmerican Energy Company, and all other companies related to the associated work.

Existing utility locations shown on drawings are approximate. There is no guarantee that the utilities shown include all such utilities or that the locations indicated are exact. The Contractor shall contact South Dakota One Call system, utility companies, and the City of Sioux Falls to verify locations of all existing utilities prior to excavation.

The Contractor shall be responsible for notifying South Dakota One Call 1-800-781-7474 to have utilities field located.

The following utility companies are known to have facilities on the project:

Qwest Bob Donat (En (605) 339-5343

Sioux Falls Wa Brad Maddox 668 W. Algong Sioux Falls. SD (605) 367-8810

MidAmerican E Eric Bera 1200 S Blauvel Sioux Falls, SD (605) 373-6038

The Contractor shall cooperate with and coordinate his efforts to work with the utility companies and their contractors. Each bidder shall be responsible prior to bid letting, for determining the effects of utility work on the project work scope and schedule, and shall account for all such effects in his bid.

#### LOCATING UTILITY

This work consists of excavating material to locate a utility line, (Private or Public), when the utility owner cannot find said line, or utility line is not within four (4) feet either side of markings established by the utility owner. Payment for this item will be at the contract unit price per each. Five locates are estimated for this project.

#### VERIFY UTILITY

This work consists of excavating material to verify the depth of an existing utility line, (Private or Public), to avoid possible conflicts, when directed by the Engineer. Payment for this item will be at the contract unit price per each. Two verifications are estimated for this project.

The Contractor shall verify the depths of the following utilities:

information with the Engineer.

# AND VALVE BOXES

Under these items of work, the frames and covers on sanitary sewer manholes and storm sewer junction boxes and water main valve boxes are to be adjusted flush with the top of the finished asphalt or concrete surface. The Contractor shall furnish the new manhole frames and covers where shown on the plan sheets. The sanitary sewer frames and covers shall be in accordance with the supplemental standard


ngineering) 3	Midcontinent Communications Al Mullinix 274-8546
ater & Sewer	Sioux Falls Water Purification Plant Bruce Anderson
uin Street D 57104	(605) 940-0526
0	Municipal Light & Power Mike Burkard
Energy Company	2000 North Minnesota Sioux Falls, SD 57104
elt D 57105 8	(605) 367-7006

24" Well line between Area Inlet #2 and B1 Inlet #1

24" Well line between at Jaycee Lane water main crossing

After verification, the Contractor shall coordinate

# ADJUSTMENT OF MANHOLE CASTINGS

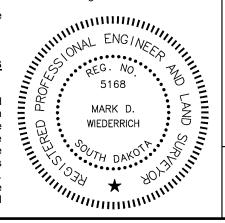



specifications. The existing valve boxes are to be adjusted to the top of the finished surface as per standard plate 900.02.

The adjustment of the manhole covers involves adding or removing adjusting rings under the frame. If the elevation of the covers is too high, it may be necessary for the Contractor to remove the upper course of brick and/or break down the concrete walls in the existing manhole and seat the manhole frames in mortar, at the elevations for the manhole covers to be flush with the top of the finished surface. Adjustment of frame and covers shall be in accordance with city detail for manhole casting and cover adjustment. The maximum amount of adjustment with adjusting rings is 14 inches.

Existing frames and/or lids cracked or broken through the carelessness of the Contractor's forces shall be replaced with new frames and/or lids at the Contractor's expense.

Payment for adjusting manhole frames and covers and valve boxes shall be the unit contract bid price per each in the proposal which price shall constitute full compensation for material, adjusting rings, tools, asphalt and concrete removal and replacement, excavation, back filling, furnishing labor, and other incidentals necessary to complete the work. Payment shall be made for both new and existing manhole frames and covers and valve boxes which are adjusted to the new pavement height.

#### WASTE DISPOSAL SITE

All material generated from this project for disposal must be disposed of at a state-permitted solid waste disposal site. Depending on what material is generated and whether it is contaminated or uncontaminated will determine which permitted facility can accept it. Permitted facilities include construction and demolition debris sites, restricted use sites, and regional landfills. The Contractor can contact SDDENR Waste Management Program at (605) 773-3153 to identify locally permitted disposal sites for various categories of contaminated and uncontaminated materials.

All costs associated with disposing of waste shall be incidental to the various contract items.

#### DEWATERING

It is anticipated that groundwater may be encountered during excavation. Dewatering may be needed to perform the contract work. There is no separate bid item for dewatering and all costs associated shall be incidental to the various related bid items.

It shall be the responsibility of the Contractor to discharge and dispose of the water in an approved manner. No water shall be allowed to enter the sanitary sewer. The Contractor shall dispose of water in a suitable manner without damage to adjacent property. The water shall be filtered using an approved method to remove sand and fine-sized soil particles before disposal into any drainage system. Discharge from dewatering operations shall be controlled to prevent erosion and scour.

The Contractor is responsible for obtaining a Temporary Water Use Permit from the SD DENR prior to commencing dewatering operations. Prior to excavating, the Contractor shall submit for review a dewatering plan to be approved by the Engineer.

# REMOVALS

#### **REMOVE CONCRETE PAVEMENT**

The concrete pavement shall be disposed of by the Contractor at a site approved by the Engineer. Payment for concrete pavement removal is included in the contract unit price per square yard for "Remove Concrete Pavement". Payment shall be at the contract unit price per square yard, regardless of variations in thickness.

#### Curb and Gutter shall be paid under the item "Remove Concrete Pavement."

The aggregate in the existing P.C.C. pavement is quartzite.

#### **REMOVE ASPHALT PAVEMENT**

The asphalt concrete pavement shall be disposed of by the Contractor at a site approved by the Engineer. Payment for asphalt mat removal is included in the contract unit price per square yard for "Removal of Asphalt Concrete". Payment shall be at the contract unit price per square yard, regardless of variations in thickness.

When asphalt is laid over concrete pavement, removal of the asphalt surfacing shall be incidental to the unit price for "Removal of Concrete Pavement".

Existing asphalt surfacing thicknesses as identified by soil borings are as follows:

Soil Boring No.	Location	Asphalt Thickness	fenc
4	See Soils Report	4"	Airpo
5	See Soils Report	4"	be d
6	See Soils Report	4"	
7	See Soils Report	6"	REN
8	See Soils Report	4"	
9	See Soils Report	4"	The
10	See Soils Report	6"	equi
11	See Soils Report	3.5"	aggr
12	See Soils Report	4"	Rem
13	See Soils Report	4"	barri
14	See Soils Report	4"	
			The

#### CLEARING

The lump sum payment for "Clearing" will be full compensation for all removal and disposal of trees less than six (6) inches in diameter, stumps, roots, and other vegetation designated for removal and mowing as required. The Engineer will establish right-of-way lines and construction limit lines prior to the start of clearing operations. The Engineer, at the start of the project, will mark the clearing limits.

Organic material shall not be used as fill in trenches or embankment. The Contractor shall dispose of all trees, brush, stumps, roots and other remains in a legal manner. Burying or burning of debris on or adjacent to the project shall be prohibited.

Erosion control measures shall be installed and functioning prior to clearing and excavation. See erosion control plans and notes.

#### **CLEAR AND GRUB TREE**

The unit price payment for "Clear and Grub Tree" will be full compensation for all removal and disposal of trees. The Engineer will establish right-of-way lines and construction lines prior to the start of clearing and grubbing operations.

Some trees may require the Contractor to have the tree topped by a licensed arborist, prior to clearing and grubbing the tree, due to the close proximity of physical features to remain. All costs associated with this work is considered incidental to the contract unit price for "Clear and Grub Tree"

Some trees to be removed are located near driveway pavements, fences or other items not being removed with this project. The Contractor shall cut these trees level with the ground, and grind the stump 8" below ground line. All costs associated with this work is considered incidental to the contract unit price for "Clear and Grub Tree". Removal of trees, are identified on the Demolition sheets. All smaller trees and shrubs (less than six (6) inches in diameter) will be removed and paid under the bid item "Clearing"

#### **REMOVE LUMINAIRE POLE FOOTING**

The unit price for "Removal of Luminaire Pole Footings" shall be full compensation for removing existing lighting footings. This item is not intended to pay for removal of items set in concrete such as parking meters, bollards, sign posts, fence posts, security barrier posts.

#### **REMOVE ELECTRICAL CONDUIT**

Removal of abandoned electrical conduit, as required for grading or other utility installations, shall be considered incidental with no separate payment made.

#### REMOVE PARKING METER

The unit price for "Removal of Parking Meters" shall be full compensation for all equipment, labor and incidentals necessary to removal the existing parking meters along Jaycee Lane including any concrete footing.

#### **REMOVE PIPE CULVERT**

The unit price for "Remove Pipe Culvert" shall be full compensation for removing storm sewer pipe, regardless of size, and backfilling trench to specified density at locations shown on the demolition plan sheets

Where existing pipe remains in-place, concrete plugs shall be installed at the ends to settlement into pipe. Payment for concrete pipe plugs shall be considered incidental.

#### **REMOVE FENCE**

The unit price for "Remove Fence" shall be full compensation for all equipment, labor and incidentals necessary to remove the existing chain link security fence with security top at locations shown on the demolition plan sheets. The bid item shall include removal of the disposed of offsite.

### MOVE CONCRETE BARRIER POST

e unit price for "Remove Concrete Barrier Post" shall be full compensation for all uipment, labor and incidentals necessary to remove the existing security exposed pregate barrier posts around the parking lot perimeter including any concrete footing. moval of barrier chain between the posts shall be considered incidental to the security rier post removal.

The Contractor shall salvage 50 of the best condition posts and return them to the Airport. Location for stockpiling the posts shall be determined by the Airport during construction.

#### REMOVE OVERHEAD GATE AND EQUIPMENT

The lump sum price shall be full compensation for removal of the existing overhead gate, footings and equipment located on the north side of the Jaycee Lane entrance as shown on the demolition plan. The gate operator/motor shall be returned to the Airport Maintenance Shop on the west side of the airfield. All other gate materials shall be disposed of offsite.

### REMOVE ENTRANCE AND EXIT LANE EQUIPMENT

The lump sum price for the item "Remove Entrance and Exit Lane Equipment" shall be full compensation for all equipment, labor and incidentals necessary to remove and dispose of all entrance and exit lane gate equipment including the following:

### **REMOVE EXIT BOOTHS**

The contract unit price for the item "Remove Exit Plaza Booth" shall be full compensation for all equipment, labor and incidentals necessary to remove and dispose of each of the two exit plaza prefabricated booth buildings including the remaining furnishings and equipment inside the booths and exterior attached power boxes, equipment and signage. The Contractor shall coordinate with Standard Parking to ensure all salvageable furnishings and equipment are removed prior to demolition

### **REMOVE EXIT PLAZA CANOPY**

The lump sum price for the item "Removal of Plaza Canopy" shall be full compensation for all equipment, labor and incidentals necessary to remove and dispose of the canopy system and eight columns at the existing plaza including any lighting or attached signage. The canopy dimensions are approximately 56' wide x 34' long. Removal of canopy column footings are paid separately.

### **REMOVE QUARTZITE PAVER PLANTER WALL**

The unit price for "Removal of Quartzite Paver Planter Wall" shall be full compensation for all equipment. labor and incidentals necessary to remove the existing guartzite paver walls including any footing supporting the walls. The quartzite pavers shall be returned to the City Parks Storage Lot just north of Elmwood Golf Course. All other wall materials shall be disposed of offsite.

### SAW EXISTING ASPHALT PAVEMENT

exercise particular care to ensure that the adjacent surface is left intact and undamaged when removing the sawed out portion. Sawing of asphalt shall be paid for once at each location. Additional sawing required to form neat edges prior to paving will be incidental to sawing bid item

Where new surfacing is placed adjacent to existing asphalt concrete, a joint shall be sawed in the existing bituminous material prior to placing new materials.

"Saw Existing Asphalt Pavement" shall be paid for at the contract unit price per lineal foot.

ice fabric, posts, rails and concrete footings. Fabric shall be rolled up and returned to the port Maintenance Shop on the west side of the airfield. All other fencing materials shall

 Entrance Ticket Dispensers – 4 Each Entrance/Exit Gate Operators – 8 Each Exit Credit Card Pay Machine – 1 Each

Asphalt sawing shall be performed at all locations shown on the plans or as directed by the Engineer during construction. The pavement shall be sawed full depth. The Contractor shall

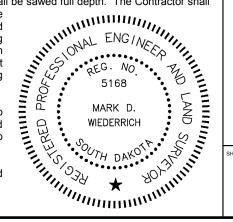


Image: Section Procession Section Procession Proc				r t r t	f r	
Decomber Month and Control of the co	SHEET N	GOI DSMITH HECK			eral Notes	TERMINAL PARKING & ACCESS IMPROVEMENTS
24 N Synamore Ave., Suite 1 - Stoux Fails, SD 57110 - Ph: 605 332 30685 SIOUX FAILS REGIONAL AIRPORT REVISIONS: BY: DATE: DATE	OF	ENGINEERS INC.			FILE: 210710_General Notes.doc	CIVILY FALLS DECIMIAL ALBORT
85 SIOUX FALLS REGIONAL AIRPORT REVISIONS: BY: DATE: BY: DATE:				CHECKED BY: MDW	DATE: 3/11/2011	SIGUN I ALLA INEGIONAL AINFONI
DATE:		524 N. Sycamore Ave., Suite 1 - Sioux Falls, SD 57110 - Ph: 605.332.9685	SIOUX FALLS REGIONAL AIRPORT	REVISIONS:		SIOUX FALLS, SOUTH DAKOTA

#### SAW EXISTING PORTLAND CEMENT CONCRETE PAVEMENT

Concrete sawing shall be performed at all locations shown on the plans or as directed by the Engineer during construction. The payement shall be sawed full depth. The Contractor shall exercise particular care to ensure that the adjacent surface is left intact and undamaged when removing the sawed out portion. Sawing of PCC concrete shall be paid for once at each location. Additional sawing required to form neat edges prior to paving will be incidental to sawing bid item.

Where new Portland Cement Concrete (PCC) pavement is to be placed adjacent to existing PCC pavement, the existing PCC pavement shall be sawed full depth to a true line with a vertical face

"Saw Existing Portland Cement Concrete Pavement" shall be paid for at the contract unit price per lineal foot.

## GRADING

Total Excavation	29,851 CuYd
Embankment + 15% Shrink	1,857 CuYd
Waste	27,994 CuYd
Total Embankment	29,851 CuYd
Excavation	20,111 CuYd
Stripping Topsoil	4,402 CuYd
Asphalt Pavement Removal	4,964 CuYd
Concrete Pavement Removal	374 CuYd
Total Unclassified Excavation	29,851 CuYd

The estimated quantity of stripped Topsoil has been added to the Unclassified Excavation quantity. By doing this, the quantity of Topsoil from the cuts will be paid for twice as Unclassified Excavation. This will be full compensation for Excavation, which includes necessary undercutting to provide space for placement of topsoil

The volume of asphalt pavement removal is included in the Unclassified Excavation quantity. The quantity of asphalt pavement removal shall be plans quantity and will not be adjusted according to field measurements.

#### SOIL BORINGS

Soil boring information taken for the project has been included in the project specifications. Locations, water, and rock depths encountered at the time of the borings are indicated on the plans. There is no expressed or implied agreement that depths or character of materials shown are correct or complete. Conditions affecting work may actually differ from those shown in the boring logs. Bidders are expected to examine the site, interpret or disregard soil boring logs as they see fit, and arrive at their own conclusions regarding the character and locations of materials to be encountered. All Contractors desiring to take additional soil borings on this project must obtain permission from the property owners involved and from the Engineer.

#### UNCLASSIFIED EXCAVATION

Excavate the existing subgrade to provide for the required depth of aggregate base course and asphalt surfacing or aggregate base course and concrete surfacing. Earthwork shall be performed as shown on appropriate typical sections or plan notes.

Due to the difficulty in making field measurements on this project and to expedite final payment, the computed quantity of Unclassified Excavation shall be the basis of payment for this item. No field measurements will be made for payments except when changes from the plan shown construction limits are ordered by the engineer.

All excavations made for underground utilities are incidental to the installation of that utility. All spoil material removed for pipe installation is the property of the Contractor and is to be removed from the project by the Contractor. All spoil material and costs for removing it are incidental to pipe installation costs.

Undercutting of subgrade will not be required due to the possible utility conflicts. No separate payment will be made for preparation, shaping and recompacting of the subgrade.

Scarify and recompaction will be required where possible. Separate payment will be made for scarify and recompact.

The excess soil resulting from earthwork activities, if any, shall become the property of the contractor who shall be responsible for its removal from the site.

Water for compaction of subgrade and embankments shall be provided by the contractor and used to maintain soil at or near optimum moisture content to obtain required density. Compaction of subgrade and embankments shall be governed by the specified density method. Compaction of embankment shall be no less than 95% of Standard proctor density. Separate payment will be made for water used for compaction of subgrade. The estimated quantity of water for embankment is based on 12 gallons per cubic yard of Unclassified Excavation

SHRINKAGE FACTOR: Embankment +15%

#### **UNCLASSIFIED EXCAVATION - DIGOUTS**

An estimated quantity of 100 cubic yards of "Unclassified Excavation - Digouts" has been included in the plans to excavate isolated locations of unstable grade as determined by the Engineer. The excavated material shall be disposed of by the Contractor. The backfill material shall be aggregate base course or other material as approved by the Engineer.

The actual field measured quantity of "Unclassified Excavation - Digouts" will be the basis for payment.

#### SCARIFY AND RECOMPACT SUBGRADE

The depth of scarification of the subgrade shall be no less than 8 inches. The basis of payment for "Scarify & Recompact Subgrade" will be plan quantity. No separate measurement will be made unless so directed and authorized by the engineer.

If subgrade stabilization is not necessary the engineer may remove the scarify and recompact bid item for those areas.

#### PLACING TOPSOIL

Prior to starting construction operations, existing topsoil shall be removed from the construction limits to cover the disturbed areas and will be paid for under the bid item Salvage Topsoil

Following completion of grading operations, topsoil shall be spread evenly over the disturbed areas to a depth of 6 inches for all areas scheduled for turf grass. See Erosion Control plans for locations

For areas scheduled for planting beds, the topsoil depth shall be 18".

The small berms to be constructed between the throughout the project shall be constructed entirely of salvaged topsoil.

No topsoil shall be hauled off site until all topsoil until it is determined that there is adequate topsoil to meet the requirements above.

The basis of payment for "Placing Topsoil" will be the plan quantity. No separate measurement will be made unless changes from the plan shown construction limits are ordered by the Engineer.

# **SEE SECTION "E" FOR TRAFFIC CONTROL NOTES**

SEE SECTION "F" FOR EROSION CONTROL NOTES

#### **SANITARY SEWER - GENERAL**

- 2.
- 3. acceptance.

#### PRECAST 1300 GALLON SANITARY SEWER HOLDING TANK

The Precast Sanitary Sewer Holding Tank shall conform to the following:

- Capacity = 1300 gallons
- . Diameter = 108" Width = 96"
- Tanks Height = 59" .
- connection

The holding tank shall be constructed of reinforced concrete. Thickness, strength and reinforcement shall be designed by manufacturer to accommodate H-20 surface loadings at the depth specified. The holding tank shall be a Josten 1300 Gallon Precast Round Holding Tank or approved equal.

The contract unit price for "Precast 1300 Gallon Sanitary Sewer Holding Tank" shall full compensation for furnishing and installing the holding tank and associated fittings as described above including backfilling.

### **STORM SEWER - GENERAL**

#### **INLETS AND JUNCTION BOXES**

Storm sewer inlets and junction boxes shall be paid for under the unit prices for "Class M-6 Concrete" and "Reinforcing Steel" as shown in the table of quantities. Plans quantity will be the basis for payment unless changes are ordered by the Engineer. Casting shall be paid separately under their respective bid items.

#### STORM STRUCTURE ADJUSTMENT

If adjustment of a storm sewer inlet or junction box requires additional work to lower or raise existing structure walls, this work shall be paid under the item "Storm Structure Adjustment". The anticipated extent of the structure modification is shown on the plan notes. All labor, materials, equipment and incidentals necessary to modify the structure including sawing walls to lower or forming and pouring additional wall are included in the per each unit price for "Storm Structure Adjustment."

# SANITARY SEWER

1. Sanitary sewer work involves a sanitary sewer holding tank and sanitary sewer service from the holding tank to the Exit Plaza office/bath building.

Contractors License. The Contractor shall obtain a "South Dakota State Sewer and Water Plumbing Contractor's License" prior to commencing construction.


The Contractor shall notify the City Engineer's office upon completion of the sanitary sewer. Inspection of the sanitary sewer will be made by the City Engineer's office with the Contractor and all discrepancies will be noted. Final payment will not be made until all discrepancies have been corrected and the sanitary sewer work has been given final

Precast Slab Cover shall include 1 - 24" manhole opening with concrete manhole cover, 1 - 6" opening for pump access and 1 - 6" opening for sewer service

The pump access shall have a 6" schedule 80 PVC riser pipe that extends to the finished surface grade and removable threaded plug.

# STORM SEWER

All reinforced concrete pipe shall be Class III for areas of normal trench construction. Standard bedding material (Type B or Type D) for reinforced concrete storm sewer pipe shall be considered incidental to the installation of the storm sewer pipe. No separate measurement or payment shall be made for standard bedding material or joint seals.

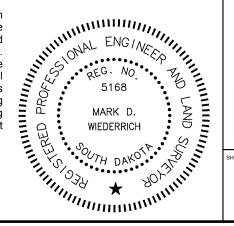

 				_	
TERMINAL PARKING & ACCESS IMPROVEMENTS	Οιοιν Ελιις Περιονικί Αισοπτ	SIUUN I ALLS REGIONAL AIRFORI	SIOUX FALLS. SOUTH DAKOTA		
GENERAL NOTES DESIGNEDEN: MDW	DRAWN BY: MDW FILE: 210710_General Notes.doc	CHECKED BY: MDW DATE: 3/11/2011	REVISIONS: BY: DATE:	BY: DATE:	
			SIOUX FALLS REGIONAL AIRPORT		
			524 N. Sycamore Ave., Suite 1 - Sioux Falls, SD 57110 - Ph: 605.332.9685		
SHEET N		3			

#### **STORM FRAME & GRATE ADJUSTMENT**

If adjustment of a storm sewer frame and grate is required, this work shall be paid under the item "Storm Frame & Grate Adjustment" and shall include all labor, materials, equipment and incidentals necessary to adjust the inlet to finished grade as noted on the Utilities plan sheets. Adjustments shall be made by installing adjusting rings as approved in the Supplemental Specifications or by shimming and grouting void with concrete.

#### CONNECT TO EXISTING STORM STRUCTURE

The contract unit price for the item "Connect to Existing Storm Structure" shall be full compensation for the labor, materials, equipment and incidentals necessary to connect a new storm sewer pipe to an existing storm sewer inlet or junction box including creating an opening in the wall to accommodate the new pipe, inserting the pipe and grouting the connection to provide a watertight seal and restore the structural integrity of the inlet or iunction box

#### CONNECT TO EXISTING PIPE

If a male/female joint is not available to connect existing pipe with new storm sewer pipe, a concrete collar shall be installed. The collar shall be Class M-6 concrete and shall be 6 inches thick and 2 feet wide with wire mesh reinforcement. All costs for connecting to existing pipe shall be incidental to the various pipe bid items.

### WATER

#### WATER MAIN

All valve operation will be done by the City of Sioux Falls Water Department.

All ductile iron pipe and fittings shall be wrapped with polyethylene tube material to protect the pipe from any future corrosion. The poly material shall be installed as detailed in the supplemental specifications and the ductile iron handbook from DIPRA and ANSI A21.5 (AWWA C105)

#### WATER MAIN PARALLELING OR CROSSING SEWERS

Installation of water mains parallel to sanitary or storm sewer lines shall be completed in a manner such that the water mains shall be laid at least 10 feet horizontal distance from any existing or proposed sanitary sewer, storm sewer, or sewer manhole. Where water mains cross above storm sewers or sanitary sewers, there shall be at least 18 inches vertical clearance between the bottom of the water main and the top of the sewer pipe and one full length of water pipe must be located so both joints will be as far from the sewer as possible.

A water main may cross below a non-perforated sewer main if minimum vertical separation of 18 inches is provided and the sewer main is of acceptable water main pipe material and is a continuous piece of at least 20 feet in length with the length of the water pipe located so both joints are as far as possible from the sewer main. A water main may cross either above or below a non-perforated sewer line with a vertical separation of less than 18 inches if either the water or sewer line is encased in PVC or cast iron for at least 10 feet each side of the crossing. If PVC or cast iron is used as encasement material, the ends shall be adequately sealed with a rubber boot. Where water mains are to be installed in parallel with a sewer or a sewer manhole that is less than 10 feet away horizontally and is not at least 18 inches below the water main, the water main shall be encased in PVC or cast iron for the entire distance that the sewer is too close to the water main. If PVC or cast iron is used as encasement material, the ends shall be adequately sealed with a rubber boot. Payment for crossings shall be incidental to the contract unit prices for the water main items.

#### WATER MAIN DISINFECTION

When minor water main work occurs (i.e. tie-in connections of new water main to existing water main, water main adjustments, installation of new valves on existing main or any other work deemed minor by the Engineer) the existing main, prior to the completion of the bacteria testing, may be returned to service once the line has been flushed and a boil order has been issued. The boil order will be rescinded with the passing of the bacteria test.

When flushing the water main, the water used for disinfecting the main shall not reach a stream, river, or water way if chlorine is detected in the water. Contact City Engineering for more information

The Contractor shall notify all consumers affected by any interruption of water service at least 24 hours before the interruption of water service. Consumers shall be verbally notified when possible. In the event a consumer cannot be verbally notified, the Contractor shall secure a door hanger provided by City Engineering to the most frequently used entrance.

#### **DISCHARGE OF CHLORINATED WATER**

Water from the City's Water Distribution System that is drained into work areas or open trenches must be discharged without impact to the environment. The following is a prioritized list for dewatering of trenches in work areas:

- 1. Water from the distribution system shall be pumped to the City's sanitary sewer system. Contractor is responsible for verifying hydraulic loading on existing sanitary sewer system during trench dewatering operations to ensure that sewer backups do not occur.
- Water from the distribution system shall be pumped to areas were water can be 2 stored and discharged through infiltration. Overland flow is not allowed. If discharge is on private property, contractor shall secure permission prior to discharge.
- 3. Water from the distribution system may be pumped into vactor trucks or septic tank trucks and hauled to the Water Reclamation Plant or other facility permitted by (DENR) to accept such discharge.

The above items will be considered incidental to the work necessary to complete tie-ins to existing and operational waterlines.

# SURFACING

#### AGGREGATE BASE COURSE

Aggregate Base Course shall be in accordance with SDDOT Standard Specifications Section 260. Material for base course shall meet requirements set forth in SDDOT Standard Specifications Section 882.

Aggregate Base Course shall be compacted with pneumatic rollers and shall continue on each lift of the base course until the surface is firm and unyielding, and attains a density of 97% of the maximum dry density as determined by SD 104, Method 4 and SD 105 or SD 114

Water for compaction is estimated at 12 gallons per ton and shall be paid for at the contract unit price per MGAL for bid item "Water for Granular Material".

Payment shall be made on a per ton basis. Any aggregate base course delivered to the site without a scale ticket will not be measured for payment.

#### SALVAGE AGGREGATE BASE COURSE

The Contractor shall salvage existing base course to the extent possible during construction operations. Salvaged base course shall be free of clay, topsoil and other contaminants. The salvaged base course shall be used in the lower lift(s) of the proposed parking lot and access road pavement sections. Salvaged Base Course shall not be used in the top 6" of the proposed base section. The contract unit price per cubic yard for "Unclassified Excavation" shall be full compensation for salvaging, stockpiling, placing, grading and compacting the base course to plan specifications.

#### COLD SURFACE ROTOMILL PLANING

Cold surface rotomill planning shall be completed to the dimensions as shown on the plans for both depth and width.

All grindings from rotomill operations shall be disposed of by the contractor. The cost of disposing grindings and all transportation shall be included in the cost per square yard of rotomill planning.

The computed quantities shown in the estimate of quantities shall be the basis of payment unless changes are directed by the Engineer.

#### ASPHALT CONCRETE FOR PATCHING

"Asphalt Concrete for Patching" shall be installed in locations shown in the plans or as directed by the Engineer. The minimum depth of all asphalt concrete patching shall be 4".

Compaction of asphalt concrete shall be by the specified density method. The minimum density requirement is 92% (Rice Method) of specified density or to the satisfaction of the Engineer

Asphalt concrete composite shall conform to the SDDOT Specifications for Class G. Aspha Concrete. The top lift shall conform to Class G-2 for the mineral aggregate specifications All lower lift(s) shall conform to Class G-1 for the mineral aggregate specifications unles otherwise noted or by direction of the Engineer. The surface course shall not exceed 2" thickness when laid and compacted.

The asphalt cement used in the mixture shall be Performance Graded AASHT Designation: PG64-22 or PG58-28 and shall conform to the current SDDOT Specifications Certificates of compliance will be required on the asphalt concrete composite mix and th performance graded asphalt binder. The Engineer may accept the mixture on the basis the certificate of compliance and visual inspection or may test the mixture for specificatio compliance.

Tack coat (SS-1h or CSS-1h) shall be applied between each lift of asphalt and along existin concrete and asphalt faces and any areas as determined by the Engineer at the rate of .0 gal/sq. yd. Payment for this work shall be incidental to the unit price for asphalt.

#### ASPHALT CONCRETE COMPOSITE

Compaction of asphalt concrete shall be by the specified density method. The minimum density requirement is 92% (Rice Method) of specified density or to the satisfaction of the Engineer.

Asphalt concrete composite shall conform to the SDDOT Specifications for Class G, Aspha Concrete. The top lift shall conform to Class G-2 for the mineral aggregate specifications All lower lift(s) shall conform to Class G-1 for the mineral aggregate specifications unles otherwise noted or by direction of the Engineer. The surface course shall not exceed 2" thickness when laid and compacted.

The asphalt cement used in the mixture shall be Performance Graded AASHT Designation: PG64-22 or PG58-28 and shall conform to the current SDDOT Specifications Certificates of compliance will be required on the asphalt concrete composite mix and the performance graded asphalt binder. The Engineer may accept the mixture on the basis the certificate of compliance and visual inspection or may test the mixture for specification compliance.

Tack coat (SS-1h or CSS-1h) shall be applied between each lift of asphalt and along existin concrete and asphalt faces and any areas as determined by the Engineer at the rate of .09 gal/sg. vd. Payment for this work shall be incidental to the unit price for asphalt.

Intermediate and/or top lifts shall not be placed until the underlying layer has cooled to 17 degrees Fahrenheit or below. Also, if the contractor's paving operation is damaging the underlying asphalt, paving shall be suspended until the asphalt can withstand the pavin operation or an alternate paving operation which does not cause damage is determined.

#### Longitudinal Joints:

- 3 4

#### Seasonal Limitations:

- frozen temperatures.
- temperatures.

Asphalt concrete composite shall be paid for at the contract unit price per ton, furnished complete in place, and shall be full compensation for asphalt cement, mineral aggregate, tack coat (SS-1h or CSS-1h), all materials, equipment, labor and incidentals necessary to complete the work.

Placement of asphalt concrete shall be by self-propelled payers. Compaction of the aspha concrete shall be by methods and equipment satisfactory to the Engineer.

1. Rolling operations for confined edges, the first pass adjacent to the confined edge the compaction equipment shall be entirely on the hot mat 6" from the longitudina

2. Rolling operations for un-confined edges, the compaction equipment shall exten 6" beyond the edge of the mat.

Longitudinal joints of succeeding lifts should be offset approximately 6".


Longitudinal joints should be on the lane lines in the top lift. A paving plan will be required from the Contractor

1. Asphalt Concrete Composite will not be laid if the underling surface is wet of

2. Temperature for lower lifts shall be, at minimum, 35 degrees Fahrenheit, with forecast of holding or rising

3. Temperatures for top lift shall be, at minimum, 40 degrees Fahrenheit, with a forecast of holding or rising

4. The Engineer may require tarping of loads during cool or windy conditions.

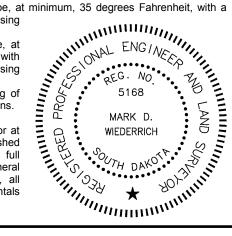

alt s.ss in Os.ie of n g5 alt me	TERMINAL PARKING & ACCESS IMPROVEMENTS	- SIOUX FALLS REGIONAL AIRPORT	SIOUX FALLS. SOUTH DAKOTA		
alt s. ss in O s. ie of on	GENERAL NOTES DESIGNED BY: MDW	DRAWN BY: MDW FILE: 210710_General Notes.doc CHECKED BY: MDW DATE: 3/11/2011	IS: DATE:	BY: DATE:	
ng 95 75 ne ng e, al	Designe	DIAMN B DIAMN B	SIOUX FALLS REGIONAL AIRPORT REVISIONS		
e or a	GOLDSMITH HECK	ENGINEERS, INC.	524 N. Sycamore Ave., Suite 1 - Sioux Falls, SD 57110 - Ph: 605.332.9685		
	SHEET N	∘ D4 ₀⊧ D6			

#### **MISCELLANEOUS CONCRETE**

Concrete for storm structures, curb & gutter, valley gutters, sidewalk, driveway approaches, and outlet structures shall be Class M-6 as detailed in the SDDOT Standards Specifications Section 462

Concrete shall be cured using a curing compound in accordance with section 821.1 of the 2004 SDDOT Standard Specification for Roads and Bridges. A 1/2" preformed expansion material shall be placed between the sidewalk and other concrete items (back of curb, driveways, existing sidewalks, etc.). Payment for this item shall be incidental and included in the unit price for the respective bid item.

#### **GEOTEXTILE FABRIC FOR SUBGRADE STABILIZATION**

Geotextile fabric has been included in the project to be installed as directed by the Engineer at locations where poor subgrade stability is encountered. The bid item "GEOTEXTILE FABRIC" has been established to pay for all labor, equipment and material to install the fabric

Pay quantities for the geotextiles will be paid for at the contract price per square yard in place. Measurement for payment excludes the geotextile used for overlapping as well as seam overlaps

Installation shall be in accordance with the manufacturer's recommendations. Overlap shall be a minimum of 24 inches. The end of the roll overlaps shall be three feet minimum.

The contractor shall not drive equipment directly on top of the geotextile. Should the geotextile be torn or punctured, the damaged area shall be repaired or replaced by the contractor at no expense to the owner. The repair shall consist of a patch of the same type of geotextile a minimum of three feet from the edge of any part of the damaged area.

Geotextile fabric shall conform to the requirements listed below. The contractor shall provide a certificate of compliance verifying that the material meets the specification prior to the installation of the fabric.

- 1. Wide Width Tensile Strength (ASTM D-4595)
  - 3600 lb/ft minimum
- 2. Wide Width Tensile Strength at 5% Strain (ASTM D-4595) 1350 lb/ft minimum
- 3. Permittivity (ASTM D-4491)
- 0.25 sec-1 minimum
- 4. UV Resistance at 500 hours (ASTM D-4355) 70% minimum

The City has verified that the following products meet these specifications.

- 1 Mirafi HP465
- 2. Propex Getotex 3x3
- Lumite GTF465 3

#### INSERT STEEL BAR IN CONCRETE PAVEMENT

The contractor shall furnish and insert steel bars where existing pavement meets new pavement as shown in plans and on standard plate no. 380.11. The steel bars shall be cut to the specified lengths by sawing and shall be free from burring or other deformations. Shearing is not permitted.

The diameter of the drilled holes in the existing pavement for the steel bars shall not be less than 1/8" nor more than 3/8" greater than the overall diameter of the steel bar. Holes drilled into existing payement shall be located at mid-depth of the slab true and normal. The drilled holes shall be blown out with compressed air using a device that will reach the back of the holes to ensure that all debris or loose material has been removed prior to epoxy injection.

Epoxy resin adhesive shall be of the type intended for horizontal applications and shall conform to the requirements of ASTM C 881, Type IV, Grade 3 (Equivalent to AASHTO M235, Type IV, Grade 3).

Mix the epoxy resin as recommended by the manufacturer and apply by an injection method approved by the engineer. If an epoxy pump is used, it shall be capable of metering the components at the manufacturer's designated rate and be equipped with an automatic shutoff. The pump shall shut-off when any of the components are not being metered at the designated rate. Fill the drilled holes 1/3 to 1/2 full of epoxy or as recommended by manufacturer, prior to inserting steel bar. Care shall be taken to prevent epoxy from running out of the horizontal holes and prior to inserting steel bar. Rotate bar during insertion to eliminate voids and ensure complete bonding of the bar. Insertion of bars by dipping method is not allowed.

#### Estimated Bars:

#5 x 24" Epoxy Coated Deformed Bars = 88 Each 1 <sup>1</sup>/<sub>4</sub>" x 18" Epoxy Coated Smooth Steel Dowel = 61 Each

#### NONREINFORCED PORTLAND CEMENT CONCRETE PAVEMENT

PCC Pavement consists of constructing 6" and 9" pavement in accordance with typical sections and paving sheets which illustrate construction limits and joint layout.

PCC Pavement shall conform to Section 380 of the 2004 SDDOT Standard Specifications for Roads and Bridges. Exceptions and additions to this section are written in the following notes

The coarse aggregate shall be crushed ledge rock.

The fine aggregate may require screening as determined by the Engineer.

The concrete for the nonreinforced PCC shall be of an approved job mix. The mix design shall be submitted three weeks prior to and approved prior to any concrete placement. The design mix shall meet a minimum 4000 PSI compressive strength in 28 days.

Concrete used in Portland cement concrete pavement shall have a minimum cement content of 510 pounds per cubic vard and a fly ash content of 112 pounds per cubic vard. Fly ash shall be class F or class C and shall meet the requirements of Section 605 of the SDDOT Standard Specifications for Roads and Bridges.

The contractor may elect not to use fly ash in the concrete for payement. The concrete shall than have a minimum cement content of 600 pounds per cubic yard. Any additional costs associated with this or other mix designs shall be at the expense of the contractor. Any changes from the original submitted and approved mix design, shall be approved by the Engineer prior to its use.

The surface tolerance shall be 1/4" in ten feet instead of 1/8" in ten feet as per standard specification. The surface shall be free from a noticeable "chatter" or "ripple or washboard" ride. Failure to meet these specifications may result in the contractor being required to diamond grind to a satisfactory ride and/or could be subject to a payment adjustment as deemed reasonable by the Engineer.

A metal tine finish will not be required.

In lieu of an automatic subgrader operating from a preset line, a motor grader or other suitable equipment may be used to bring the gravel cushion or base course to final grade prior to placement of concrete.

There will be no direct payment for trimming of the gravel cushion or base course for PCC Pavement. The trimming will be considered incidental to the related items required for PCC Pavement.

The surface of the mainline paving shall be an Engineer approved Astroturf finish or carpet drag finish. A self-propelled machine is not required to pull either of the approved carpets.

All paving shall be cured with a white pigmented linseed oil base emulsion compound. Application of the curing compound shall be in accordance with section 380.3.P.2 of the 2004 SDDOT Standard Specifications for Roads and Bridges. Curing compound material shall be in accordance with section 821.1.D.

#### DETECTABLE WARNING PANELS

The Contractor shall supply detectable warning panels which conform to the list of approved products shown below. If the Contractor wants to substitute a product not shown on the list, a written request must be submitted to the Engineer prior to construction for approval. In no case will the stamping of concrete be allowed as a method of creating the domes on the tactile warning panels.

> Approved Products Manufacturer: Hand and Spirit, Inc. Type: Cast-in-place-detectable warning panel Local Supplier: Bierschbach Equipment and Supply

Manufacturer: Armor-Tile, Inc. Type: Cast-in-place tactile/detectable warning surface tile 800-682-2525

### PCC PAVEMENT MEDIAN NOSES

This item includes all materials, labor, equipment and incidentals necessary to construct PCC median noses along the project as shown in the pavement layout/curb & gutter sheets.

### COLOR FOR CONCRETE SIDEWALK

and labor.

The contractor shall prepare samples of color listed above and coordinate a meeting on site with the Engineer, Landscape Architect and Owner to confirm or adjust the color as specified.

The color shall be integral. The concrete surface shall be broom finished.

Two coats of non-yellowing acrylic curing and sealing compound shall be applied to the surface of the colored concrete. Poly, burlap or white-pigmented curing compounds are not allowed. If applied by spray method, spraying must be done in two passes in opposite directions and rolled to ensure complete coverage. The curing and sealing compound shall be as listed below or engineer approved equal:

> CLEAR GUARD Cure and Seal Butterfield Color Distributor: Construction Products & Consultants, Inc. Phone: 605.332.4991

All costs for furnishing, handling and applying the curing and sealing compound and liquid integral color shall be included in the contract unit price for the items Colored Concrete Sidewalk, 5" and Colored Concrete Median Pavement 6".

#### BOLLARD/CHAIN BARRIER ASSEMBLY

The contractor shall install a bollard and chain assembly at the four locations shown to prevent the public from using the snow removal access pavements to exit the parking lot. The bollards shall be as per Bollard, 4" detail with the exception that a heavy duty hook shall be welded or threaded to the bollard 4" from the top for hooking the chain barrier.

The contract unit price per each for the item "Bollard/Chain Barrier Assembly" shall include furnishing and installing two bollards at locations shown and salvaged barrier chain cut and installed on bollard hooks across the approach pavement opening. Chain sag shall provide a minimum chain clearance of 12" from finished grade.

#### PAVEMENT MARKINGS

Pavement marking material shall meet the specifications for Traffic Paint as per the City of Sioux Falls Supplemental Specifications Section 633.2.A. Glass beads shall meet the requirements of 633.2.C. Construction requirements shall conform to section 633.3 of the Sioux Falls Supplemental Specifications.


Manufacturer: ADA Solutions, Inc. Type: Cast-in-place tactile/detectable warning tile Local Supplier: Dakota Supply Group

Manufacturer: Armor-Tile, Inc. Type: Replaceable cast-in-place tactile system Local Supplier: Brock White

The add alternate item to add color to concrete sidewalk shall include the following materials

Color shall be as listed below or engineer approved equal:

Match Solomon color 306 Toffee (dark brown)

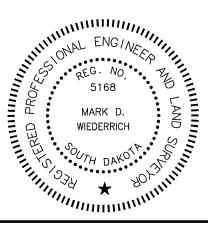

-					-
	TERMINAL PARKING & ACCESS IMPROVEMENTS	CIVIX FALLS DECIMIAL ALPOAT	SIDUAL ALLS REGIONAL AIRFURI	SIOUX FALLS. SOUTH DAKOTA	
	GENERAL NOTES DESIGNEDEN: MDW		HECKED BY: MDW DATE: 3/11/2011	REVISIONS: BY: DATE:	BY: DATE:
				SIOUX FALLS REGIONAL AIRPORT RI	
				524 N. Sycamore Ave., Suite 1 - Sioux Falls, SD 57110 - Ph: 605.332.9685	
	SHEET N		5		

# TRAFFIC SIGNAL AND LIGHTING NOTES

#### GENERAL

Grounding conduits and the end points of continuous steel conduit bounded systems shall have around bushings

Lighting in this section refers to public street lighting on Minnesota Avenue. Parking lot and Jaycee Lane lighting is covered under Section "N".

#### UTILITIES

The Contractor shall refer to the list of utility owners previously detailed in the plan notes. The contractor shall schedule the electrical company(s) to get the power disconnected prior to removals and to get reconnected.

#### CONDUIT

Conduits shall be installed to a minimum depth of 24". Conduit ends shall be capped or sealed as shown on the standard plates. Rigid steel conduit for signal wiring shall be galvanized and meet the requirements of SDDOT Specifications and UL 651 and UL 514. Steel conduit ends shall be threaded and capped. Each section of conduit shall bear the underwriter's laboratory's label. The work shall be accomplished by a licensed electrician in conformance with applicable codes of the State of South Dakota. Refer to the electrical plan sheets for guantities and locations. Plan shown guantities shall be the basis of payment for this work unless changes are made in the field.

All connections to existing conduit, including any necessary fittings shall be included in the contract unit price per foot for the conduit.

All conduit borings shall be included in the contract unit price per foot for the various conduit items

#10 AWG Tracer wire shall be installed in all traffic interconnect regardless of type.

#14 AWG Tracer wire shall be installed in all lighting conduit not carrying street light wire.

#### CONDUIT INSTALLATION

A minimum of 2" Rigid Steel Conduit shall be used as designated in the plans for all conduits not designated as traffic interconnect but carrying traffic signal cables unless tying to existing conduit. Lighting conduit shall be a minimum of 2" Sch. 80 under all roadways. The contractor shall furnish and install "innerduct" for traffic interconnect conduit as designed in the plans. Traffic Interconnect "innerduct" conduit shall be sleeved in a steel conduit large enough to incorporate the innerduct under all roadways (from back of curb to back of curb) or as shown in the plans. Innerduct conduit shall be schedule 40 high density polyethylene. The innerduct conduit for traffic interconnect shall be orange in color and longitudinally ribbed on the inside wall. Contractors bid for "2" Innerduct, SDR 13.5" shall include furnishing and installing the innerduct including pull rope, all work to seal the traffic interconnect conduit within the junction box, and the steel conduit needed to sleeve the innerduct on roadways. All innerduct installed with this project with or without fiber optic cables shall be sealed with Tyco Electronics inflatable sealing system TDUX, or approved equal. The contractor shall not use machines requiring flowing water for installation of conduit under streets or roadways unless specifically permitted by the engineer.

#### STREET LIGHT FOOTINGS

The Contractor is responsible for installing all street light footings according to the plans and standard details. All labor and materials needed to construct the footings shall be included in the contract unit price per foot for "2' Diameter Footing". Refer to standard detail 635.50 (Sioux Falls Street Light Footing Standard). Anchor Bolts will be supplied by the City of Sioux Falls

#### **TRAFFIC SIGNAL FOOTINGS**

The Contractor is responsible for installing 3 traffic signal footings as shown on the plan sheets. All signal pole footings are to be installed to the depth and diameter as shown in the Footing Data Table. All signal pole footings shall be constructed with permanent casing in accordance with the Drilled Shaft Construction Method as outlined in section 465 of the Standard Specifications for Roads and Bridges, 2004 Edition, except section 465.3.A will not be necessary. All labor and materials needed to construct the footings including but not limited to permanent casing, concrete, and reinforcing steel shall be included in the contract unit price per foot for "2.5' Diameter Footing".

#### TABLE OF FOOTING DATA

#### Minnesota Avenue and North Jaycee Lane

Site Designation	Footing Diameter	*Footing Depth	**Spiral Diameter	**Spiral Length	Vertical Reinforcement
SW Quadrant	2'-6"	14'	2'-2"	112'-0"	12-#7 X 13'-6"
SE Quadrant	2'-6"	12'	2'-2"	98'-6"	12-#7 X 11'-6"
NE Quadrant	2'-6"	14'	2'-2"	112'-0"	12-#7 X 13'-6"

\*Footing Depth shall be below ground level.

\*\*The size of all spirals shall be #3.

\*\*\* See Standard Plate 635.12 for footing details

#### SIGNAL FOOTING ANCHOR BOLTS

The anchor bolts (12 total) for the signal footings at North Jaycee Lane and Minnesota Avenue shall be supplied by the contractor. The contractor shall provide anchor bolt that are 1-1/2 inches by 60 inches. The anchor bolt material shall meet ASTM specifications as specified in the Traffic Signal Supplemental Specifications by the City of Sioux Falls. The supplemental specifications for traffic signals, roadway lighting, and fiber optic cable can be viewed online at:

http://www.siouxfalls.org/PublicWorks/engineering/construction mgmt/specs policies manuals

#### CONTRACTOR FURNISHED TRANSFORMER BASE

The contractor is responsible for furnishing and installing three (3) transformer bases at the intersection of North Jaycee Lane and Minnesota Avenue. The transformer bases shall be manufactured by Millerbernd. The Millerbernd Transformer Base No. is 390A117-1-A572-GV. The cost to furnish and install the transformer bases shall be at the contract unit price per each for "Furnish and Install Transformer Base".

#### **REMOVE 50' LUMINAIRE POLE FOR RESET**

The contractor is responsible for removing and resetting one existing 50' luminaire poles as shown on the grading plan sheet. The removal of the luminaire poles shall be at the contract unit price per each for "Remove 50' Luminaire Pole for Reset".

#### STREET LIGHT FOOTING ANCHOR BOLTS

Anchor bolts for the new street light footing for the 50' reset luminaire pole on Minnesota Avenue shall be considered incidental to the unit price for the street light footing

#### STREET LIGHTING SYSTEM

The contractor shall install all conduit, junction boxes and footings for construction of the Street Light System in accordance with the standard details and at locations shown on the plans. The Contractor shall be responsible to warranty all materials and workmanship as per the general conditions and supplemental specifications.


The installation of the City furnished street light poles (luminaire poles including arms, luminaires, bulbs, photo eye, and luminaire wire (14/2 wire) from base to luminaire) shall be at the contract unit price per each for "Install Luminaire Pole" under its respective height and type.

Contractor shall pull all wires through conduit, junction boxes, and footings to be paid under the bid item "Install Street Light Wire" per linear foot.

Light department will make line to line connection in each light base and (or) junction boxes. Light department will also de-energize lights to be removed as specified in the plans.

#### JUNCTION BOXES

The contractor is responsible for furnishing and installing the junction boxes required for both the traffic and lighting departments as shown in the plans. Junction Boxes shall be at the contract cost per each for 12" Junction Box, 18" Junction Box, 24" Junction Box, and 30" Junction Box regardless of the owner. The appropriate designation on the lid of the junction box shall be according to the utility owner (Electrical or Traffic) as shown on the standard plates and in the tables located in Section B.

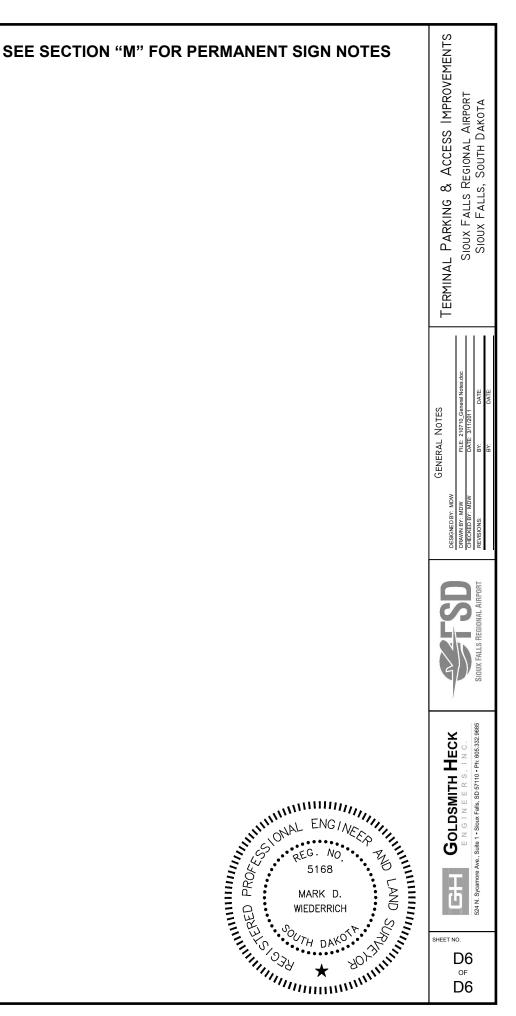

### TRAFFIC CONTROL

#### SEQUENCE OF OPERATIONS

The following Sequence of Operation shall be followed by the Contractor unless an alternate Sequence of Operations is submitted in writing and approved by the Engineer.

#### PHASE 1A

- 1. Exclusive Phase 1A work includes the construction of the south extension of the long term parking lot. Construction will begin at the south edge of the asphalt overlay limits.
- 2. Install the overflow parking lot approach, construction fence, sidewalk, and barrels for the overflow parking lot and rental car parking expansion at the beginning of Phase 1A. Stockpile necessary signs on site for use by Standard Parking when needed for overflow parking.
- 3. The proposed curb and gutter at the temporary gravel crossing location and removal of the existing parking lot light shall be performed at the beginning of Phase 1A work to allow for complete installation of Phase 1A traffic control.
- 4. Installation of the lane closure and construction of the right turn lane and work on the Minnesota Ave & Jaycee Lane intersection may be completed at any time during Phase 1A or Phase 1B.
- 5. Storm sewer work adjacent to the temporary gravel crossing shall be completed in Phase 1A to allow for shifting of the access road to the south for Phase 1B work.
- 6. Perform water main tie-in next to terminal building and crossing of Jaycee Lane to parking lot area. Crossing shall be done half at a time to allow for maintenance of traffic on Jaycee Lane.

#### PHASE 1B

- 1. Upon completion of storm sewer and asphalt work from Phase 1A, the temporary gravel crossing from Phase 1A shall be shifted to the south to allow for remaining Phase 1B asphalt work to be completed.
- 2. Upon completion of the south extension of the long term parking lot in Phase 1A the westernmost rows of parking spaces in the long term overflow area can be removed from use and Phase 1B construction work in the area can commence.
- 3. The right turn lane and intersection tie-in of Minnesota Avenue & Jaycee Lane shall be completed in Phase 1B.
- 4. The proposed sidewalk route to the terminal building and interior parking lot curb and gutter, base course, proposed asphalt paving, and asphalt overlay for the north long term parking lot shall be completed during Phase 1B.
- 5. Install the east half of 18" storm sewer crossing on Jaycee Lane west of the parking lot entrance plaza

#### PHASE 2

- 1. Install temporary gravel crossing over new curb and gutter for vehicle access to north long term parking lot
- 2. Finish the construction of exit plaza, entrance plaza, and Minnesota Ave. & Jaycee Lane intersection
- 3. Install traffic control for Minnesota Avenue lane closure and complete modifications to the median bull-nose on the south side of the intersection.
- 4. Allow Standard Parking vendors 2 weeks to install entrance & exit revenue control equipment and buildings.

#### PHASE 3

- 1. Close down existing second chance entrances for short and long term parking and open up the new entrance plaza for all parking.
- 2. Maintain temporary gravel crossing at location of existing parking lot exit plaza for contractor inaress/earess.
- 3. Upon completion of long term parking lot work in Phase 3, complete the curb and gutter work required to remove the old parking lot exit road onto Minnesota Ave.
- 4. Construct the second chance entrances for short and long term parking lots.
- 5. Begin work on the perimeter curb and gutter and sidewalk for the proposed short term parking lot
- 6. Construct the south long term parking lot.
- 7. Finish the construction of the Phase 3 landscaping and detention ponds.

#### PHASE 4

- 1. Open all of the long term parking lots for use.
- 2. Open the re-circulation perimeter road around the parking lot.

- 3. Install lane closure on Minnesota Ave. and install curb and gutter to close median opening. 4. Close the short term entrance plaza.
- 5. Finish construction of the terminal drop-off lanes and short term parking lot.
- 6. Allow Standard Parking vendors one week to install second chance revenue control equipment.

#### PHASE 5

- 1. Open the new parking lot for full use.
- 2. Install lane tapers and barrels around work areas for the west half of the storm sewer crossing Jaycee Lane west of the entrance plaza and for the asphalt mill/overlay in front of the terminal buildina.

#### SPECIAL CONDITIONS

- 1. The contractor may use the open field north of the cell phone lot at the NW corner of the Jaycee Lane & Minnesota Avenue intersection for staging operations and materials storage.
- 2. The Contractor is required to maintain a minimum of one drop-off lane and one 12 foot driving lane in front of the terminal building at all times during construction.
- 3. The Contractor shall coordinate with the Engineer on clearing of parking lots prior to commencement of proceeding work phase.
- 3.1. Barrels and special warning signs shall be installed two weeks prior to the start of Phase 1A work to allow existing parked cars to clear from the proposed work area.
- 3.2. The contractor shall work with the Engineer as phases proceed to install required signage in advance of the next phase to allow existing parked cars to clear from the next phase work area
- 3.3. Parked cars remaining in the proposed work areas will be moved by the Airport to a designated location.
- 3.4. The Engineer will place brochures at parking lot entrances to notify travelers of designated parking areas for each phase of work.

#### TIME PROVISIONS

- 1. The successful Bidder hereby agrees to commence and complete the work under this contract within the time schedule indicated and further agrees to pay as liquidated damages the sum as shown for each consecutive calendar/working day thereafter as provided in the following schedule. Schedule based on Notice of Award on or before April 14, 2011 and issuance of the Notice to Proceed on or before April 18, 2011 .
- 2. The work shall be commenced within ten (10) consecutive calendar days after the date of issuance of the Notice to Proceed. The project shall be substantially completed with all project phases entirely open and usable for the Owner and public (including all pedestrian access and lighting) by October 7, 2011. The only remaining work allowed beyond the substantial completion date is landscaping, irrigation and punch list work. Perimeter parking stalls adjacent to landscape work shall be allowed to be closed off to public during landscape and irrigation work.

Additionally, the following interim completion dates shall apply to the project:

Phase	Inte	erim Completion Date	Liquidated Damages	
Jaycee Ln Storm Sew	er Crossing	5 Working Days	\$500/Working Day	C
Jaycee Ln Water Mair	Crossing	5 Working Days	\$500/Working Day	0
Jaycee Lane MIII & Ov	/erlay	5 Working Days	\$500/Working Day	р
SB Minnesota Ave La	ne Closure	15 Working Days	\$500/Working Day	р
and Jaycee Lane Inter	rsection			
All other Minn Ave La	ne Closures	5 Working Days Each	\$500/Working Day	

All construction contract items (including punch list items) must be completed and finalized on or before November 18, 2011. If the Contractor does not meet these dates for any phase, liquidated damages will be assessed per calendar day for every day beyond these dates.

All required work shall be completed and finalized in accordance with Section 90, subsection 9 of the General Provisions.

#### GENERAL MAINTENANCE OF TRAFFIC

- 1. Installation of traffic control shall conform to the Manual on Uniform Traffic Control Devices (MUTCD) 2009 Edition unless otherwise modified in the plans.
- 2. Storage of vehicles and equipment shall be within the designated work limits for each phase of work. No employee vehicles or contractor equipment is allowed to be parked or stored in any

designated visitor parking areas during construction.

- 3. Indiscriminate driving and parking of vehicles within the right-of-way or airport property will not be permitted. Any damage to the vegetation, surfacing, embankment and existing signs resulting from such indiscriminate use shall be repaired and/or restored by the Contractor, at no expense to the Airport Authority, and to the satisfaction of the Engineer.
- 4. All breakaway sign supports shall comply with FHWA NCHRP 350 crash-worthy requirements. The Contractor shall provide post installation details at the pre-construction meeting for all steel post breakaway sign support assemblies.
- 5. Installation, maintenance, relocation and removal of Type I and II barricades, safety fence, cones, vertical panels, drums, barricade warning lights, watchmen, tubular markers and flags shall be included in the lump sum price bid for "Traffic Control Miscellaneous".
- 6. The Contractor or designated traffic control subcontractor shall ensure the adequacy, legibility, and reflectivity of each sign and device. Sign washing shall be considered incidental to Traffic Control and required as directed by the Engineer.

#### REMOVAL OF PAVEMENT MARKINGS

Pavement markings which conflict with temporary pavement markings, channelizing devices or new pavement markings shall be removed by the Contractor. Masking of pavement marking will not be allowed. The method of removal shall be non-destructive to pavements which will remain in place at project completion and shall be approved by the Engineer. Pavement marking removal shall be incidental to the contract lump sum price for "Traffic Control, Miscellaneous".

#### PEDESTRIAN TRAFFIC

The Contractor will be required to maintain pedestrian access from the airport parking lot to the terminal building at all times during construction. Pedestrian access shall be ADA accessible. Access can either be maintained on concrete sidewalk or on a temporary boardwalk. This work may include but is not limited to sawing existing sidewalk to leave half in place, staging sidewalk removal and construction to maintain access, installing safety fence around work areas, and construction and removal of temporary boardwalk. The Contractor shall determine the actual location of temporary access during construction and shall be approved by the Engineer. Payment for all work and associated materials shall be incidental to the contract lump sum price for "Traffic Control, Miscellaneous".


#### TEMPORARY GRAVEL CROSSINGS

Temporary Gravel Crossings shall be used and placed at locations as shown in the Traffic Control Plans and/or as determined by the Engineer during construction. An estimated quantity of 104 tons of base course has been included in the plans for gravel crossings. Base course shall be salvaged from the temporary crossings and be reused for roadbed placement. Temporary gravel crossings shall be paid at the contract unit price for "Aggregate Base Course" and shall be full compensation for installation, maintenance and salvage of material.

#### CHANNELIZING DEVICES

In transition and taper sections, channelizing devices shall be reflectorized drums. In tangent sections, 42" tall grabber cones may be used instead of reflectorized drums. Payment for channelizing devices shall be incidental to the lump sum bid price for "Traffic Control, Miscellaneous".

Channelizing devices used for lane closures shall be spaced at a maximum of 25' for tapers and 50' on tangents unless otherwise shown. Channelizing devices used to enclose work areas in the parking lot shall be spaced a maximum of 15' and shall be be spaced as required in the field to prevent vehicles from entering phase work zones.

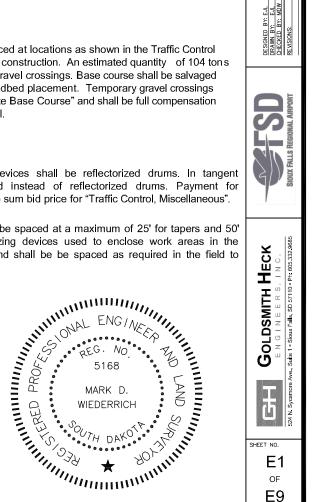



**IMPROVEMENTS** 

PARKING & ACCESS IMPRIOUX FALLS REGIONAL AIRPOR-IOUX FALLS, SOUTH DAKOTA

 $\overline{\Omega}$ 

Terminal

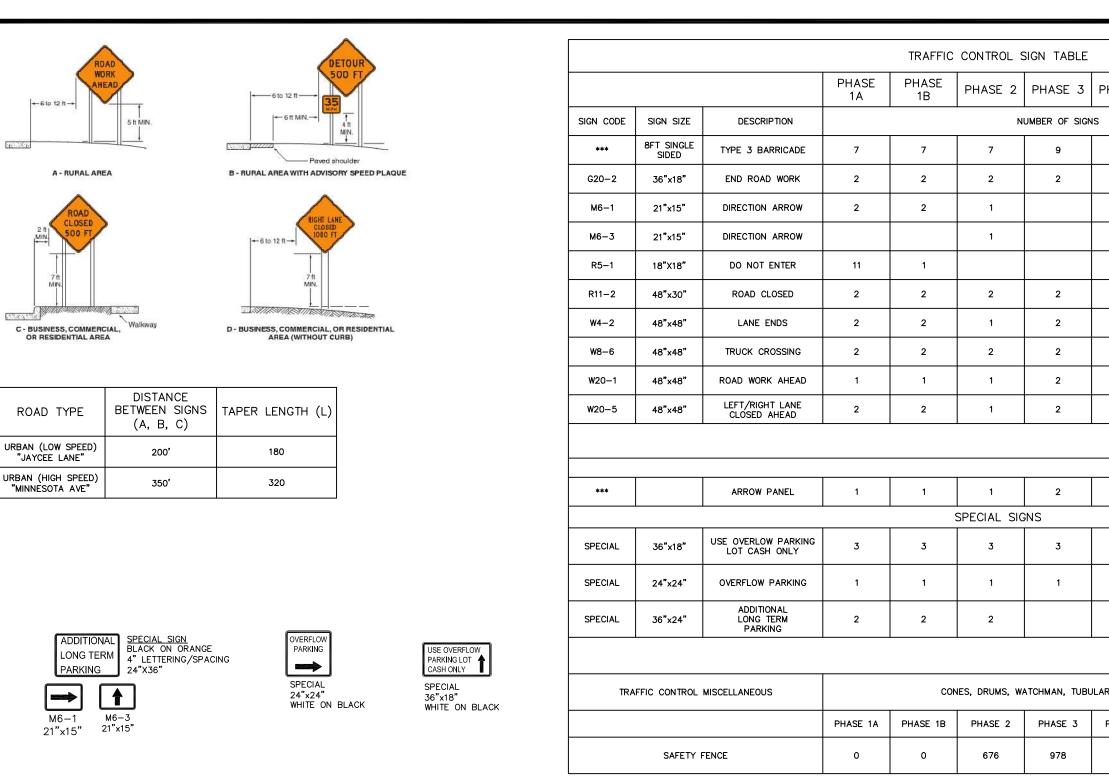

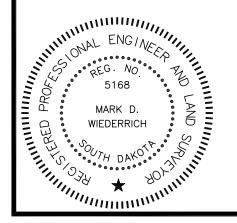










48"x48"

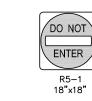

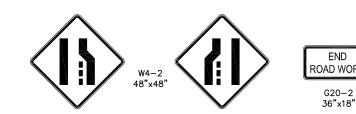



					NTS
	I	L			
HASE 4	PHASE 5	MAX REQUIRED	UNITS PER SIGN	UNITS	TERMINAL PARKING & ACCESS IMPROVEMENTS SIOUX FALLS REGIONAL AIRPORT SIOUX FALLS, SOUTH DAKOTA
					S IM Airpo
5	3	9	40	360	CCES ONAL UTH [
2		2	17	34	& A REGI S, SC
		2	5	10	AING FALLS
		1	5	5	- PARKING & ACCESS IMPRO SIOUX FALLS REGIONAL AIRPORT SIOUX FALLS, SOUTH DAKOTA
		11	5	55	NAL S
	1	2	27	54	ERMI
1	1	2	34	68	
		2	34	68	5
		2	34	68	Control.dv
1	1	2	34	68	ROL 10_Traffic C DATE: DATE:
			TOTAL:	790	TRAFFIC CONTROL AGAD FILE: 210710_Troffic Control.dwg DATE: 3/11/2011 BY: DATE: BY: DATE:
					TRAFFI ACAD DATE:
		2	EACH	2	
	-	-			DESIGNED BY: E.I. DRAMN BY: E.I. CHECKED BY: MDW REVISIONS:
		3	18	54	DESIGN DRAWN CHECKI REVISIO
		1	16	16	
		2	24	48	
			TOTAL:	118	DUX FALLS REE
R MARKERS,	FLAGS, FLASH	ERS		1 L.S.	
PHASE 4	PHASE 5	OVERFLOW F	ARKING LOT	TOTAL:	<u>88</u>
1019	0	11	70	3843	LDSMITH HECK G I N E E R S . I N C. Sour Fails, SD 57710 - Pr. 605-322 2066
	1	1			<b>TH P</b>
					LDSMITH G I N E E R S Sioux Falls, SD 57110




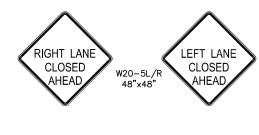





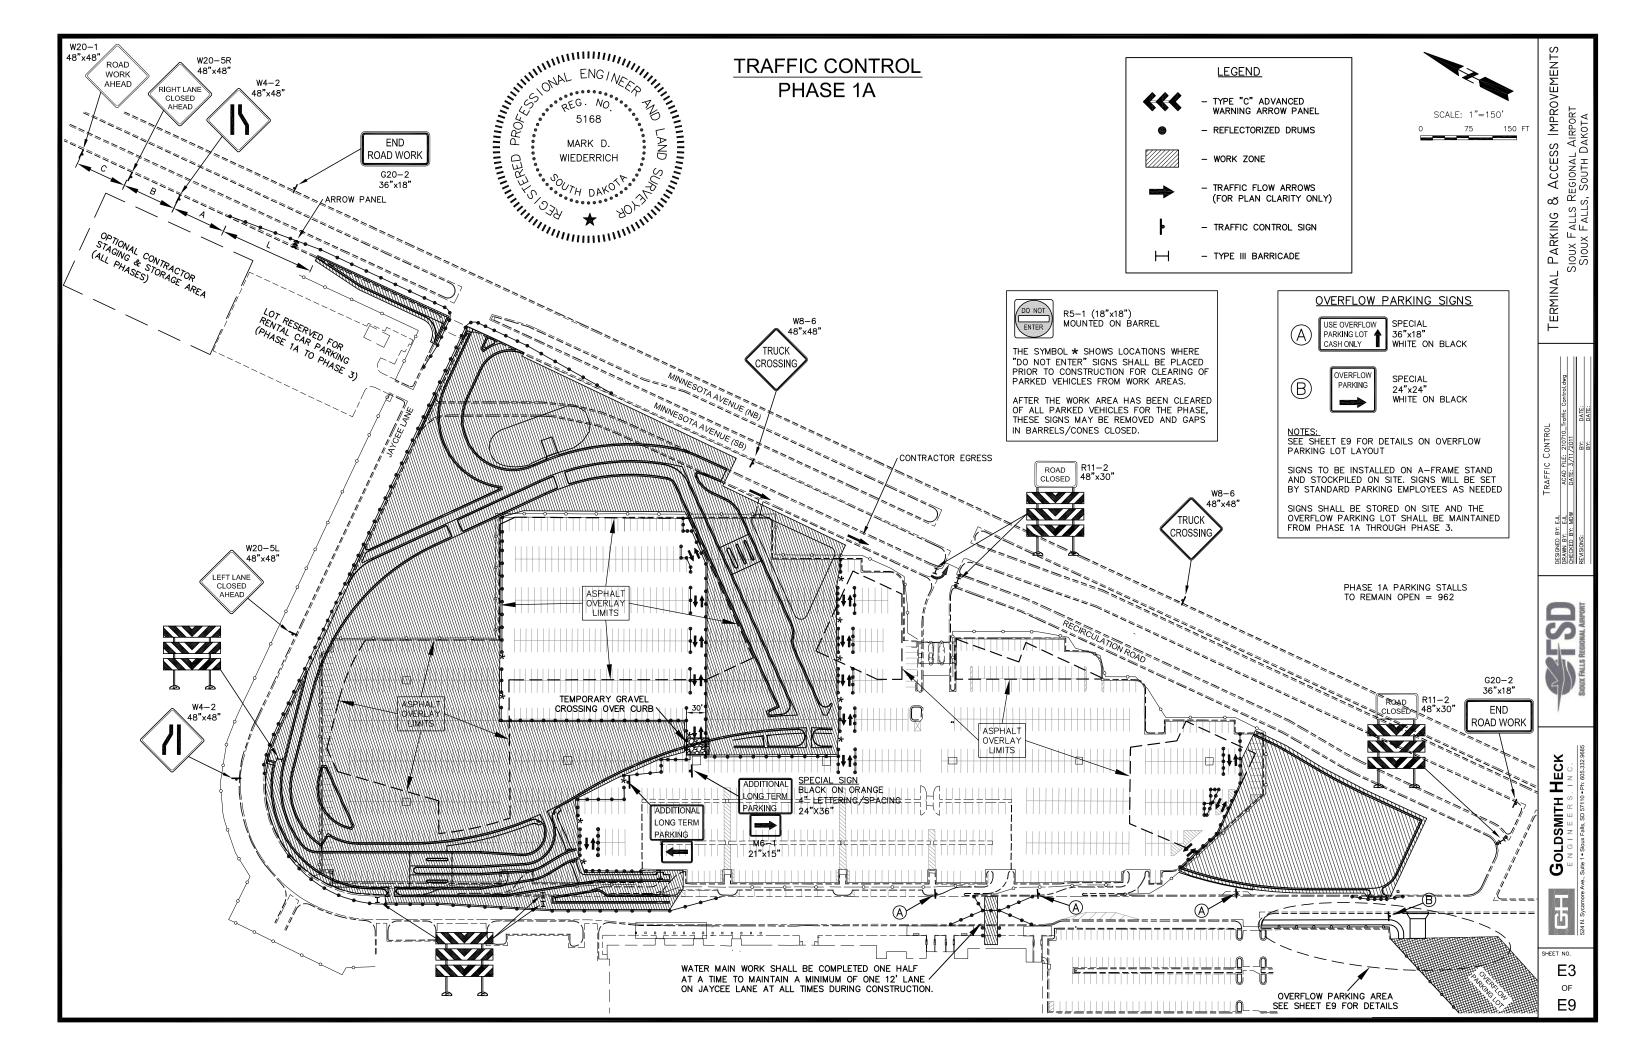


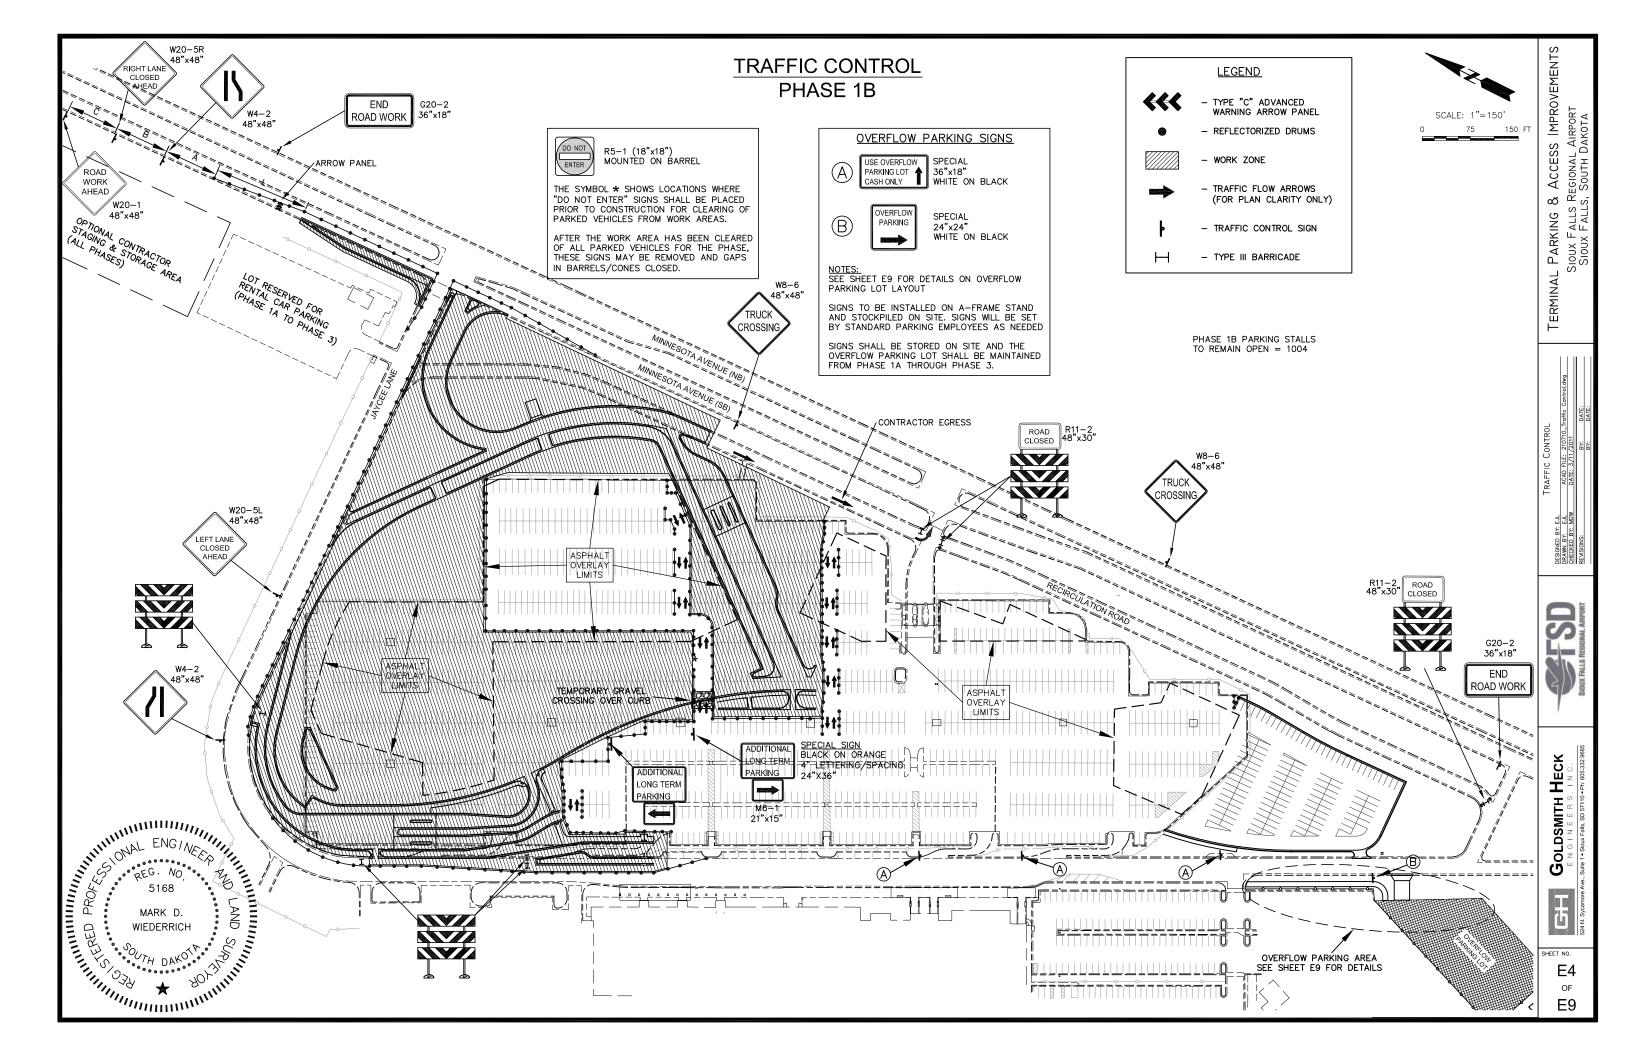


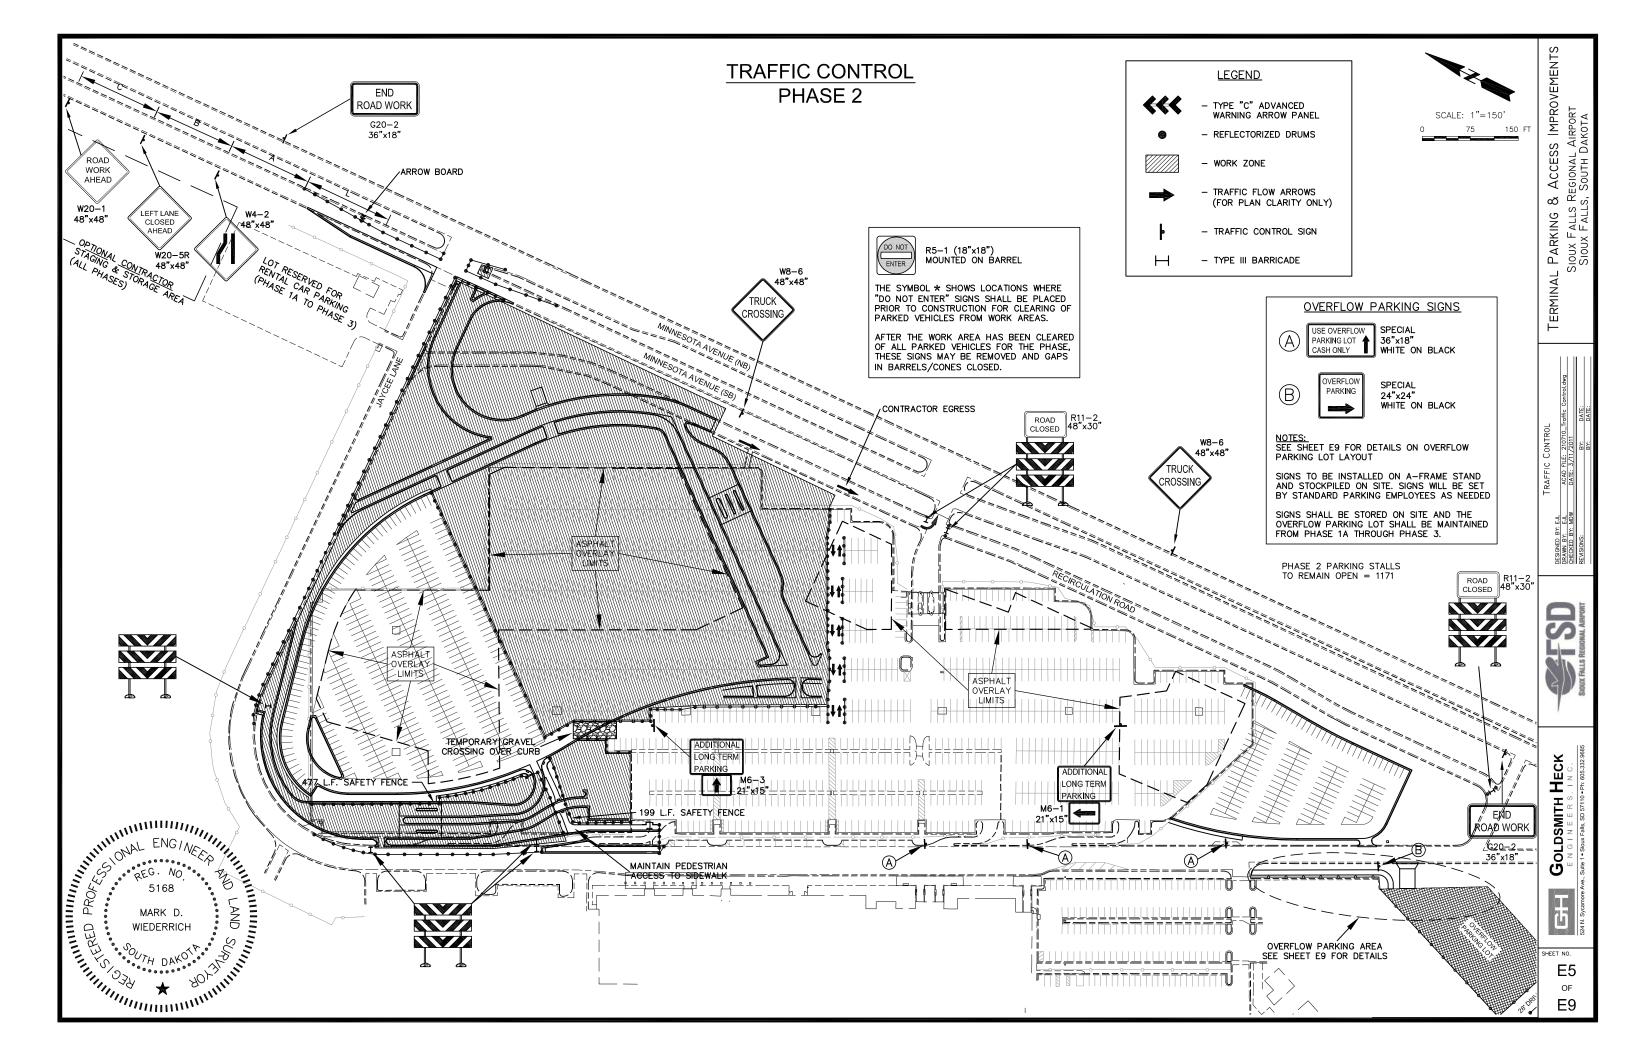

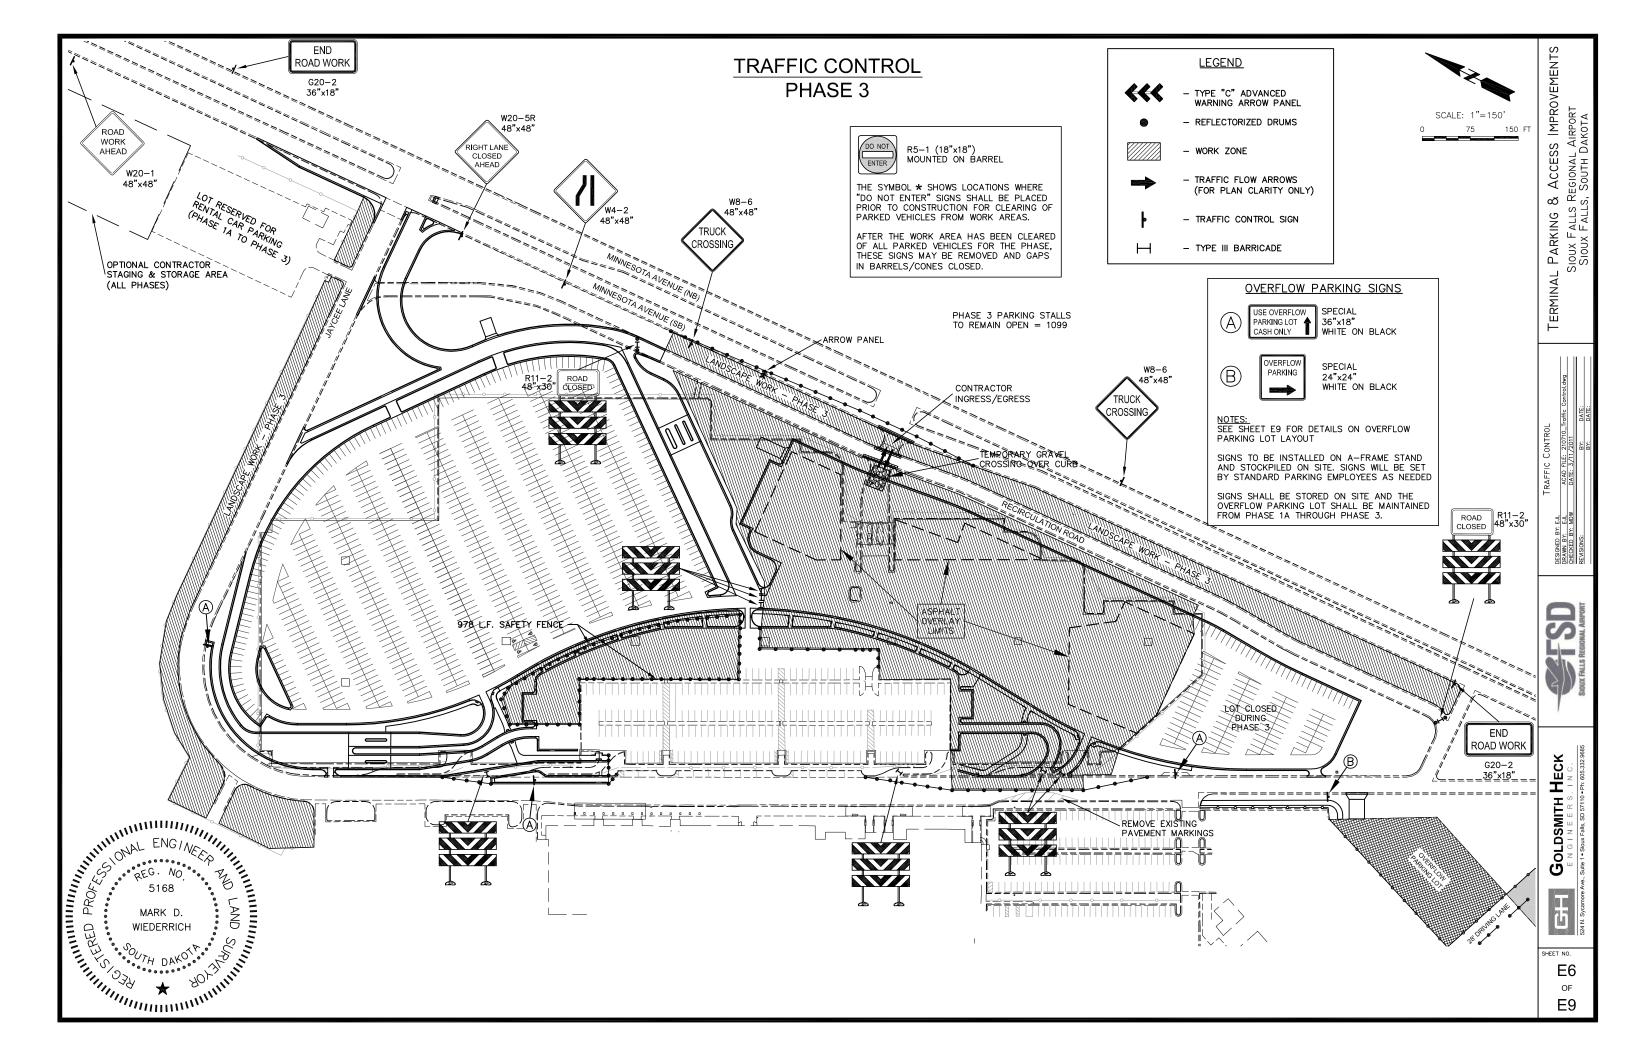


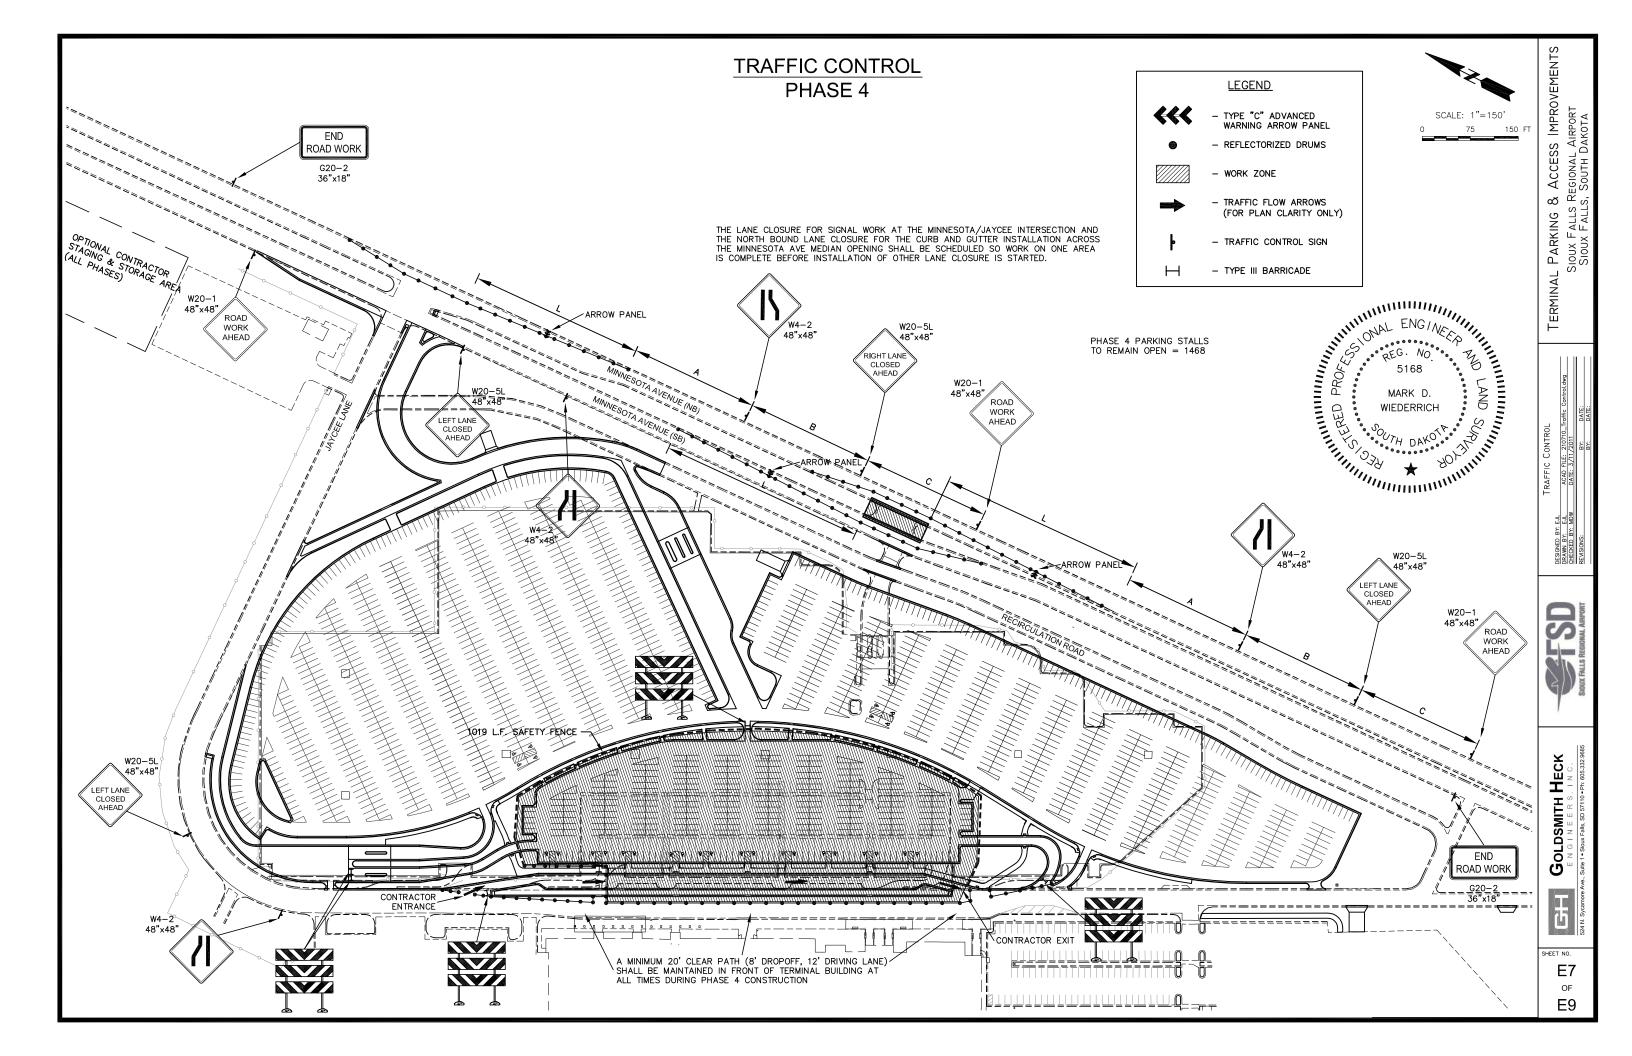

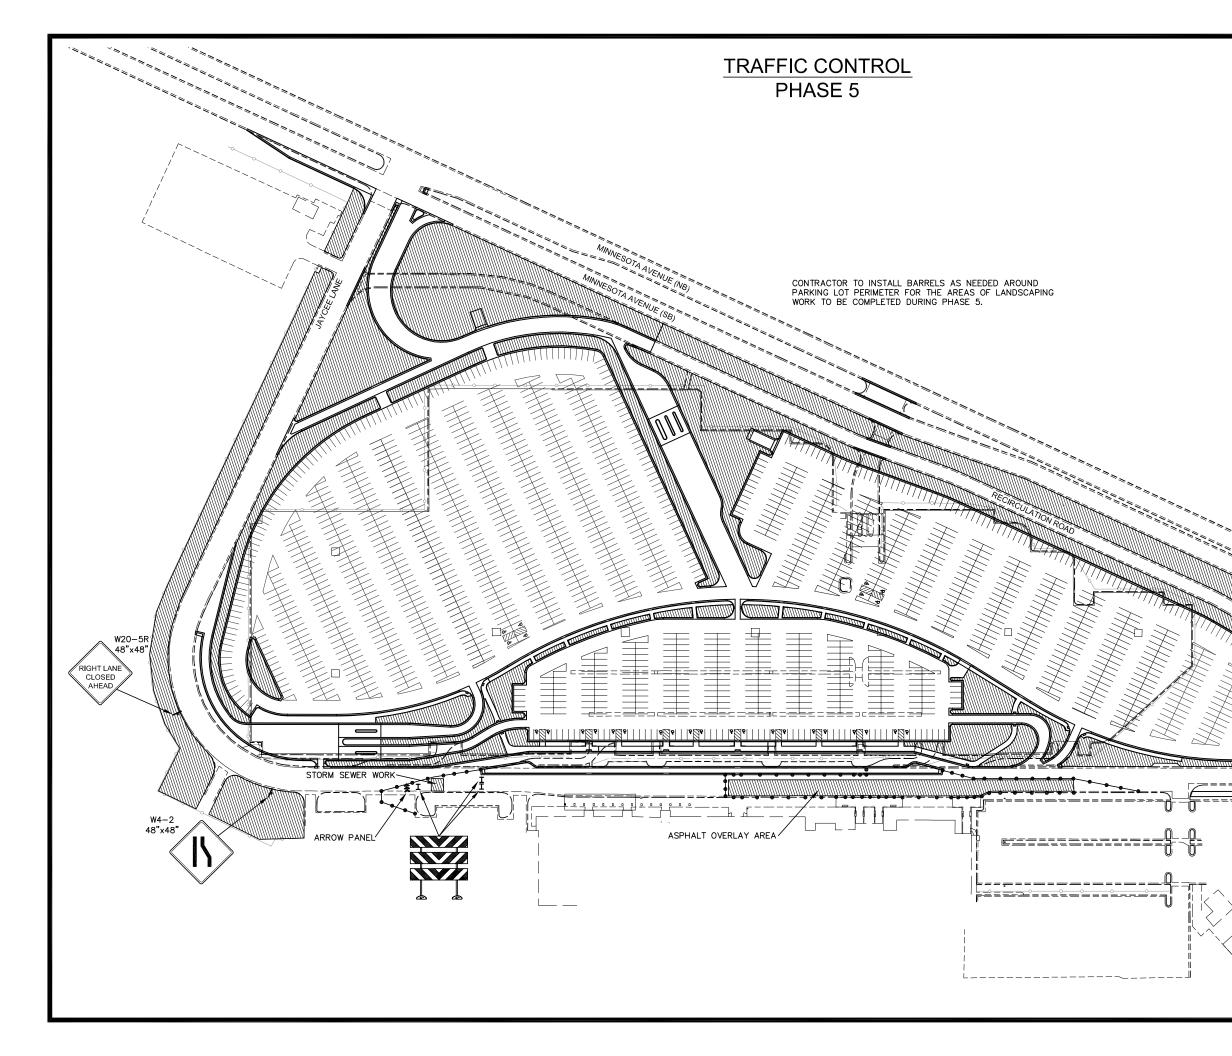

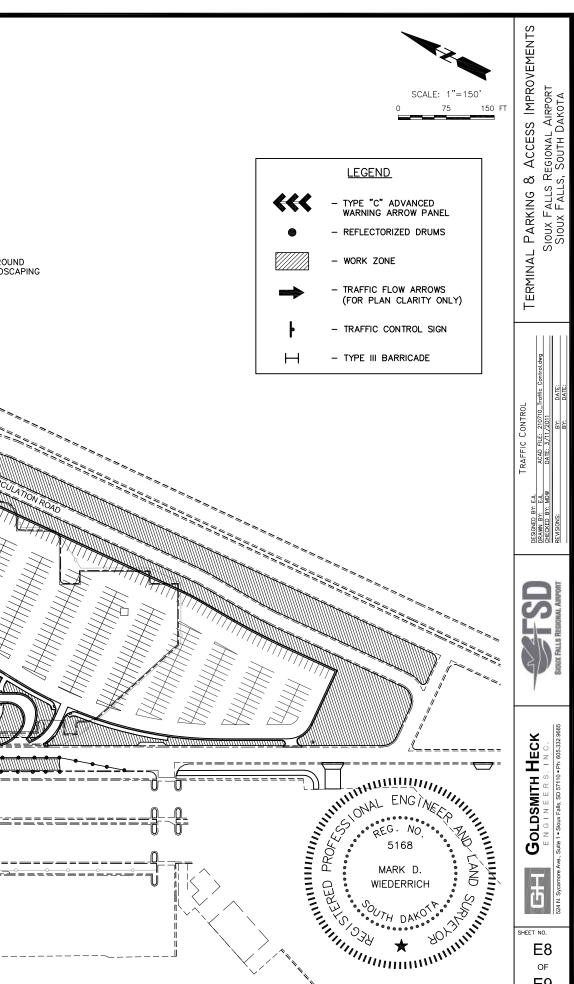

OF E9

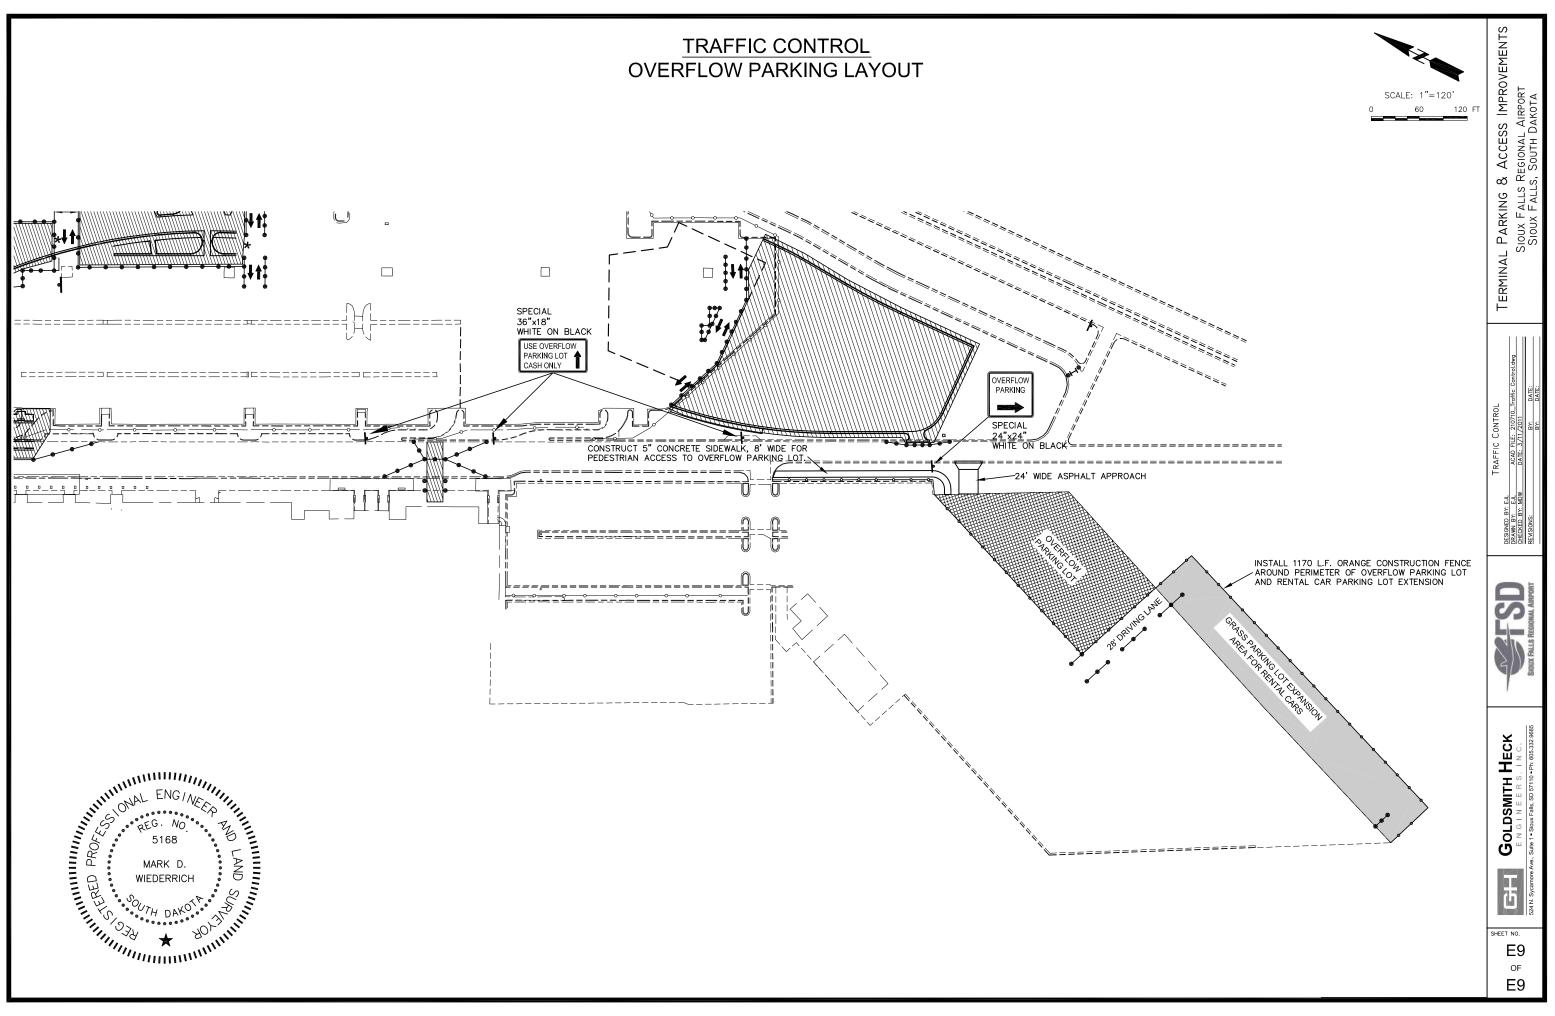

#### Storm Water Pollution Prevention Plan (SWPPP) Also known as Erosion & Sediment Control Plan (ESCP)

### NARRATIVE

#### OWNER

Sioux Falls Regional Airport Authority 2801 Jaycee Lane Sioux Falls, SD 57104 Executive Director: Dan Letellier Email Address: dan.letellier@sfairport.com Phone Number: 605-336-0762

I certify under penalty of law that this document and all attachments were prepared under my direction or supervision in accordance with a system designed to assure that qualified personnel properly gather and evaluate the information submitted. Based on my inquiry of the person or persons who manage the system, or those persons directly responsible for gathering the information, the information submitted is, to the best of my knowledge and belief, true, accurate, and complete. I am aware that there are significant penalties for submitting false information, including the possibility of fine and imprisonment for knowing violations.

Date

Date

Name:

Printed Name

Signed:

Director of Public Works

**DESIGN ENGINEER** 

Goldsmith Heck Engineers, Inc. 524 N. Sycamore Avenue, Suite 1 Sioux Falls, SD 57110 Registered Engineer: Mark Wiederrich, PE/LS Email Address: mwiederr.goldeng@midconetwork.com Phone Number: 605-332-9685

This SWPPP appears to fulfill the technical criteria for erosion control and the requirements of the City of Sioux Falls. I understand that additional erosion and sediment control measures may be needed if unforeseen erosion problems occur or if the submitted plan does not function as intended. The requirements of this plan shall run with the land and be the obligation of the Primary Responsible Party until such time as the plan is properly completed, modified or voided.

Signed:

Name/Title

PRIME CONTRACTOR

This section is to be executed by the Prime Contractor or his representative after the award of the contract. Work may not begin on the project until this section is signed.

I am acknowledging the review and acceptance of responsibility as the Primary Responsible Party for the installation, maintenance, and proper function of this SWPPP.

I certify under penalty of law that this document and all attachments will be revised or maintained under my direction or supervision in accordance with a system designed to assure that qualified personnel properly gather and evaluate the information submitted. Based on my inquiry of the person or persons who manage the system, or those persons directly responsible for gathering the information, the information submitted is, to the best of my knowledge and belief, true, accurate, and complete. I am aware that there are significant penalties for submitting false information, including the possibility of fine and imprisonment for knowing violations.

Name:	
Printed Name/Title	
Signed:	
Name	Date
Company:	
Address:	
Phone Number:	
Email Address:	

#### NOTICE OF INTENT

A Notice of Intent (NOI) for coverage under the General Permit for Storm Water Discharges Associated with Construction Activities has been submitted to the SD DENR and the permit number is SDR10F182. A copy of the permit may be downloaded from http://www.state.sd.us/denr/DES/Surfacewater/IPermits/ConstructionPermit.pdf

#### PERMIT AND EROSION CONTROL CONTACT INFORMATION POSTING

The Contractor is required to post and maintain for public viewing a laminated copy of the Department of Environment and Natural Resources authorization letter. The authorization letter will be furnished to the Contractor by the City Engineer's office. The Contractor is also required to post and maintain for public viewing an Erosion Control Contact Information Posting (ECCIP) sign. The sign shall include the name and contact information of the Contractor. The ECCIP signs are available from the City Engineer's office. The letter and ECCIP sign must be posted in a prominent location such as the project's information board or the main entrance of the construction site. Multiple ECCIP signs should be posted on projects that have multiple entrances such as a street type project.

#### MODIFICATIONS TO THE SWPPP

The Engineer may order changes to the SWPPP and/or the Contractor is responsible to request changes to the SWPPP if unforeseen changes occur, or the SWPPP does not perform as intended, or to improve the effectiveness of the SWPPP, or to comply with the SD DENR permit. The Engineer will evaluate and determine if any Contractor requested changes to the SWPPP should be made. The Contractor is responsible to implement these changes as soon as practical. All approved changes to the SWPPP must be documented by the Engineer.

#### **KEEPING THE SWPPP CURRENT**

The Engineer will be responsible to maintain an original copy of the SWPPP. Any modifications to the SWPPP must be documented and made part of the SWPPP. Any modifications must be recorded on the modification form, available from the City Engineer's Office, and a copy of the form will be submitted to the Contractor for implementation. The SWPPP must be submitted at the end of the project and retained by the City of Sioux Falls for a period of 3 years from submittal of the Notice of Termination.

#### INSPECTIONS

The Contractor and Engineer will be required to perform inspections on the project at the following minimum frequency until the site has reached final stabilization and a Notice of Termination is submitted to the SDDENR:

- Prior to the removal of any surfacing or topsoil.
- 2. Once every seven calendar days (minimum). When runoff is unlikely due to winter conditions the inspections may be reduced to once a month.
- 3 Within 24 hours after every rainfall of 1/2 inch or greater.
- After a snow melt that causes erosion. 4.
- Within 24 hours of a complaint being made to the Contractor or Engineer. 5

The Engineer reserves to right to perform inspections more frequently than identified and additional inspections will be made if obvious items of non-compliance exist. If the Contractor fails to attend any inspection it does not relieve them of their responsibility to comply with any corrective or maintenance actions needed.

Items noted as being non-compliant or needing maintenance as a result of the inspections must be corrected as soon as practical. The site shall continue to be considered in noncompliance until the issue has been corrected to the satisfaction of the Engineer. Failure to correct items of non-compliance or those needing maintenance prior to the next inspection will result in price adjustment to the contract. The minimum price adjustment to the contract will be \$100 per day per item per individual location. The Engineer may delay the issuance of the price adjustment(s) if the Engineer has determined all the following apply:

- 1. The Contractor has made a good faith effort to bring the items into compliance with the Erosion and Sediment Control Plan (ESCP) also known as a Storm Water Pollution Prevention Plan (SWPPP) and the State's General Permit.
- 2. Compliance was not achieved due to weather conditions outside the Contractor's control and the conditions were severe enough to prevent the Contractor from bringing the item into compliance.
- 3. The Contractor brought the item into compliance as soon as possible after the weather and site conditions permit.

The City Engineer's Office must also perform a regulatory oversight inspection as part of the Construction Site Program at least once per month or if a complaint is made to the City Engineer's office. These regulatory inspections may be performed jointly with one of the above listed inspections or they may be performed independently. The City is required to take formal enforcement actions in accordance with the City's Enforcement Response Plan for any identified non-compliance issues. These enforcement activities are independent and separate from the above described price adjustment.

Any price adjustment or formal enforcement actions taken by the City, State or Federal governments for the failure to implement the accepted ESCP is the Contractor's sole responsibility and shall not be a reimbursable expense to the City of Sioux Falls.

### NOTICE OF TERMINATION

The Contractor is responsible for complying with the SWPPP until a Notice of Termination (NOT) of coverage under the General Permit has been issued. The N.O.T. will be prepared by the Engineer for submittal to the City and then the SDDENR when all storm water discharges covered by the permit are eliminated and final stabilization has been achieved on all portions of the site for which the permittee is responsible. Final stabilization means either or a combination of

#### **PROJECT DESCRIPTION**

The Sioux Falls Regional Airport terminal parking lot project, located in Sections 4 and 5 -T101N - R49W, consists of the demolition and reconstruction of the terminal parking lot and includes access and other improvements. Project work includes installing traffic control devices to allow the parking lot to remain open at all times, partial removal of existing parking lot surfacing, excavating for installation of storm sewer, watermain and sanitary sewer and the construction of parking lot and street surfacing and landscaping.

#### **EXISTING SITE CONDITIONS**

The Sioux Falls Regional Airport terminal parking lot is currently an asphalt surfaced parking lot with two access roads: Jaycee Lane and Recirculation Road. Jaycee Lane allows access to a drop-off lane by the terminal building, a short-term parking access, a long-term parking access and a ticketing exit plaza. The Recirculation Road access is near the end of Jaycee Lane and allows traffic to circle back to the beginning of Jaycee Lane. All existing street and parking lot storm inlets drain to an existing storm sewer truck that runs under the parking lot from west to east and outlets into the Big Sioux River Diversion Channel east of Minnesota Avenue.

#### ADJACENT AREAS

### SOILS


The soils throughout the project generally consist of silty clay or sandy clay.

### AREA AND VOLUME DISTURBED


acres. It is estimated that 20,896 cubic yards of soil will be excavated

1. All soil disturbing activities at the site have been completed and a uniform perennial vegetative cover with a density of 70% of the native cover for unpaved areas and areas not covered by permanent structures has been established, or equivalent permanent stabilization measures (such as the use of riprap, gabions, or geotextiles) have been employed; or

2. For construction projects on land used for agricultural purposes, final stabilization may be accomplished by returning the disturbed land to its pre-construction agricultural use. Areas disturbed that were not previously used for agricultural activities, such as buffer strips immediately adjacent to "waters of the state." and areas which are not being returned to their pre-construction agricultural use must meet the final stabilization criteria in (1) above.

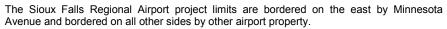

The total surface area to be disturbed is 24.3

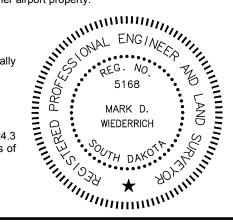



### EROSION & SEDIMENT CONTROL SEQUENCE AND TIME SCHEDULE

The following paragraph(s) are intended to provide a guideline to the Contractor for the installation of initial erosion and sediment control measures and implementation of the Erosion & Sediment Control Plan during construction. The timeline and sequence are for reference only and may change depending on the Contractor's sequence of operations and must be approved by the Engineer prior to making changes.

#### Time Schedule:

Anticipated start date of construction is May 1, 2011.

Install and maintain preliminary erosion control measures such as inlet protection, vehicle tracking control and sediment basins prior to beginning grading activities in each phase.

Anticipated completion date of October 7, 2011 for Phase 4. Anticipated completion date of November 18, 2011 for Phase 5.

Place seed mix and sod no more than 14 days after final grading work is complete.

Install erosion control measures such as inlet protection, mulch, erosion blanket, turf reinforcement mat, riprap, and any other measures deemed necessary by the Engineer upon completion of final grading.

#### Phase 1A - South extension of the long term parking lot, Part of North half of parking lot

Initial erosion control measures include the installation of inlet protection on all inlets affected by demolition or grading as shown on the plan. Sediment basins #1 and #2 shall be constructed prior to disturbing 5 acres or more. The temporary vehicle tracking control stations shown on the plan shall be installed immediately following pavement removals. Inlet protection shall be installed following the completion of each drop inlet or area inlet.

Upon completion of construction, install permanent erosion control and re-vegetation measures.

#### Phase 1B - Part of North half of long term parking lot

Maintain initial erosion control measures such as inlet protection installed with Phase 1A. Maintain sediment basins #1 and #2 such as horseshoe filter riprap as needed. Maintain temporary vehicle tracking control as shown on the plan. Temporary vehicle tracking control shall be moved as necessary for construction. Inlet protection shall be installed following the completion of each drop inlet or area inlet. Multiple installations of inlet protection may be required at each location due to construction activities.

#### Phase 2 - North half of long term parking, entrance plaza, exit plaza, Minn. Ave. & Jaycee Ln.

Maintain initial erosion control measures such as inlet protection installed with Phase 1A. Maintain sediment basins #1 and #2 such as horseshoe filter riprap as needed. Maintain temporary vehicle tracking control as shown on the plan. Temporary vehicle tracking control shall be moved as necessary for construction. Inlet protection shall be installed following the completion of each drop inlet or area inlet. Multiple installations of inlet protection may be required at each location due to construction activities.

#### Phase 3 - South half of long term parking, landscaping

Install new inlet protection as shown on the plan for Phase 3 and maintain inlet protection installed with Phase 1A. Maintain sediment basins #1 and #2 such as horseshoe filter riprap as needed. Install new temporary vehicle tracking control as shown on the plan. Temporary vehicle tracking control shall be moved as necessary for construction. Multiple installations of inlet protection may be required at each location due to construction activities.

Upon completion of construction, install permanent erosion control and re-vegetation measures

#### Phase 4 - Short term parking lot

Maintain initial erosion control measures such as inlet protection installed with both Phase 1A and Phase 3. Maintain sediment basins #1 and #2 such as horseshoe filter riprap as needed. Install new temporary vehicle tracking control as shown on the plan. Temporary vehicle tracking control shall be moved as necessary for construction. Multiple installations of inlet protection may be required at each location due to construction activities.

#### Phase 5 - Asphalt mill/overlay at front of terminal building, storm crossing, landscaping

Install new inlet protection as shown on the plan for Phase 5 and maintain inlet protection installed with both Phase 1A and Phase 3. Convert sediment basins #1 and #2 into BMP Extended Detention Basins (referred to on plan as BMP Ponds #1 and #2).

Upon completion of construction, install permanent erosion control and re-vegetation measures such as erosion blanket, turf reinforcement mat and riprap.

Remove all initial erosion control measures at the end of Phase 5.

#### PERMANENT STABILIZATION MEASURES

Sod, seed, erosion blanket, turf reinforcement mat and riprap will be used for permanent stabilization of all disturbed areas not paved throughout the project limits.

#### STORMWATER MANAGEMENT CONSIDERATIONS

Storm water runoff from the reconstructed terminal parking lot will generally surface drain to the existing and proposed storm sewer system inlets. The existing storm sewer system will be reconstructed to route the storm water runoff through two BMP Extended Detention Basins as shown on Phase 5 of the plan. Each BMP will have an outlet flow control structure that drains to the existing 72 inch truck storm sewer and then outlets into the Big Sioux River Diversion Channel east of Minnesota Avenue.

#### GOOD HOUSEKEEPING

Nonstructural BMPs such as good housekeeping measures can, to some degree, prevent the deposition of pollutants on the urban landscape or remove pollutants at their source. The source of pollutants for assimilation into storm water is the land surface itself, especially the impervious surfaces in the urban area. Thus, it is expected that when nonstructural measures are effectively implemented, they will reduce the amount of pollutants being deposited on land surfaces for eventual contact with storm water and transported to the receiving water system. Therefore, the Contractor should evaluate and determine which appropriate good housekeeping measures listed below could be used.

Operation and Maintenance: To assure that equipment and work related processes are working well, the following practices can be implemented:

- Maintain dry and clean floors and ground surfaces by using brooms, shovels, vacuum cleaners, or cleaning machines rather than wet cleanup methods.
- 2 Regularly pick up and dispose of garbage and waste material.
- Make sure all equipment and related processes are working properly and 3 preventative maintenance is kept up with on both.
- 4 Routinely inspect equipment and processes for leaks or conditions that could lead to discharges of chemicals or contact of storm water with raw materials, intermediate materials, waste materials, or products used on site.
- Assure all spill cleanup procedures are understood by employees. Training of 5 employees on proper cleanup procedures shall be implemented.
- 6 Designate separate areas of the site for auto parking, vehicle refueling, and routine maintenance
- Clean up leaks, drips, and other spills immediately. 7
- Cover and maintain dumpsters and waste receptacles. 8

Material Storage Practices: Improperly storing material on site can lead to the release of materials and chemicals that can cause storm water runoff pollution. Proper storage techniques include the following:

- 1. Provide adequate aisle space to facilitate material transfer and ease of access for inspection
- Store containers, drums, and bags away from direct traffic routes to prevent 2. accidental spills.
- Stack containers according to manufacturer's instructions to avoid damaging the 3 containers from improper weight distribution.
- Store containers on pallets or similar devices to prevent corrosion of containers 4 that results from containers coming in contact with moisture on the ground.
- Store toxic or hazardous liquids within curbed areas or secondary containers. 5
- Assign responsibility of hazardous material inventory to a limited number of people 6 who are trained to handle such materials.

Material Inventory Practice: An up-to-date inventory kept on all materials (both hazardous and nonhazardous) present on site will help track how materials are stored and handled onsite, and identify which materials and activities pose the most risk to the environment. The following description provides the basic steps in completing a material inventory:

- 1. Identify all chemical substances present at work site. Perform a walk-through of the site, review purchase orders, list all chemical substances used, and obtain Material Safety Data Sheets (MSDS) for all chemicals.
- 2. Label all containers. Labels shall provide name and type of substance, stock number, expiration date, health hazards, handling suggestions, and first aid information. This information can also be found on an MSDS.
- 3 Clearly mark on the hazardous materials inventory which chemicals require special handling, storage, use, and disposal considerations. Decisions on the amounts of hazardous materials that are stored on site shall include an evaluation of any emergency control systems that are in place. All storage areas shall be designed to contain any spills.

Training and Participation: Frequent and proper training in good housekeeping techniques reduces the possibility of chemicals or equipment that will be mishandled. Reducing waste generation is another important pollution prevention technique. The following are ways to get people involved in good housekeeping practices: 1. Provide information sessions on good housekeeping practices in training

- programs.
  - 2.

#### SPILL PREVENTION AND RESPONSE

In addition to good housekeeping measures, the Contractor should evaluate the Spill Prevention and Response Plan identified in section 12.8.6 of the City of Sioux Falls Engineering Design Standards to determine what Spill Prevention and Response measures should be used.

#### METHODS OF ENSURING SURFACE WATER QUALITY

The Contractor shall be responsible to ensure no sediment laden waters leave the project without exposure to an erosion or sediment control device.

The only non storm water discharge allowed by the General Permit for Storm Water Discharges Associated with Construction Activities is uncontaminated ground water or waters, used as a best management practice, to wash vehicles and control dust. It is the responsibility of the Contractor to obtain a General permit to discharge under the South Dakota Surface Water Discharge System for temporary discharge activities in South Dakota (dewatering permit) for all other non storm water discharges. All monitoring, testing, and other requirements of the dewatering permit are the responsibility of the Contractor.

Pumping (mechanically discharging) sediment laden water including ponded storm water or contaminated trench dewatering into the storm sewer or off the project site is not covered under the General Permit. It is the responsibility of the Contractor to obtain and comply with a dewatering permit for these activities. The Engineer may notify the SDDENR if the Contractor is observed pumping sediment laden water into the storm sewer or off site. Pumping sediment laden water through inlet protection is not allowed as a BMP.

In lieu of pumping sediment laden water the following are some methods the Contractor may use to control sediment laden water.

No payment will be made to the Contractor to comply with a dewatering permit unless otherwise specified and it will be considered incidental to the various bid items.

#### AGENCY COORDINATION

Are wetlands an issue? No

If wetlands are an issue, has a determination been made by the US Army Corps of Engineers? N/A.

Does the State Historical Preservation Office (SHPO) need to review these plans? No. No new areas are being graded that have not already been constructed with past Sioux Falls Regional Airport improvements.

review these plans? No.

review these plans? No.

Discuss good housekeeping at meetings. 3. Publicize pollution prevention concepts through posters or signs.


 The best method is for the Contractor to maintain positive drainage during all phases of the project to prevent water from ponding on the project.

Treat the sediment laden water onsite through the use of filter bags, deflocculating chemicals, sediment basins, or a portable containment system.

Pump or discharge the water to other portions of the site. This is allowed if the waters do not leave the project limits.

Does the SD Game Fish and Parks need to

Does the US Fish and Wildlife Service need to

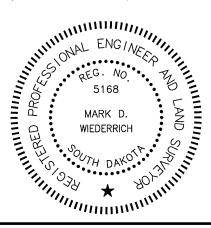

Constrained     Cold DSMITH Heck       E N G IN E E R S, I N C.     E N G IN E E R S, I N C.       Status States     Status States       Status States     Status States	N A B A TIVE
SIOUX FALLS REGIONAL AIRPORT SIOUX FALLS REGIONAL AIRPORT BY: DATE: 2017/0 Eroson Contol Narrative doc OVERCISED BY: MOW DATE: 2017/0 Eroson Contol Narrative doc	TERMINAL PARKING & ACCESS IMPROVEMENTS
CHECKED BY: MDW DATE: 3/1/2011 SIOUX FALLS REGIONAL AIRPORT REVISIONS BY: DATE:	
SIOUX FALLS REGIONAL AIRPORT REVISIONS: BY: DATE:	SIUUA L'ALLS REGIONAL AIRFORT
	NE SIOUX FALLS SOUTH DAKOTA
BY: DATE: 0.000	

HEET NO

F2

F17

#### MODIFICATIONS OF EROSION AND SEDIMENT CONTROL DEVICES TO PREVENT PROPERTY DAMAGE

The Contractor is responsible to maintain drainage. In the event that an erosion or sediment control device is obstructing drainage and damage to property is possible the Contractor may temporarily modify or remove the device to facilitate drainage. An example is inlet protection in a sump location surrounded by buildings. If a device is removed for this purpose, the Contractor shall immediately notify the Engineer to discuss and implement alternatives to comply with the SWPPP and General Permit.

#### SOIL SURFACE STABILIZATION PRACTICES

After construction begins, soil surface stabilization shall be applied within 14 days to all disturbed areas that may not be at final grade but will remain dormant (undisturbed) for periods longer than 21 calendar days. Within 14 days after final grade is reached on any portion of the site, permanent or temporary soil surface stabilization shall be applied to disturbed areas and soil stockpiles. The following table lists the amount of time various erosion control measures are applicable.

#### Maximum Time Limits of Land Exposures for Selection of Erosion Controls

Erosion Control Method	Maximum Allowable Period of Exposure (Months)
Surface Roughening	1
Mulching	12
Temporary Revegetation	12 – 24
Permanent Revegetation	24 Or More
Soil Stockpile Revegetation	2
Early Application of Road Base	1

#### MAINTENANCE

The Contractor is responsible for maintaining and repairing all temporary erosion control, sediment control, and permanent erosion control measures until the Notice of Termination is filed. No payment will be made to the Contractor for maintaining or repairing these items unless otherwise specified. General maintenance requirements are listed but are not all inclusive and additional measures may need to be taken to comply with the General Permit and SWPPP.

#### REMOVAL OF TEMPORARY EROSION AND SEDIMENT CONTROL DEVICES

The Contractor is responsible to remove all temporary erosion control and sediment control devices when the site reaches final stabilization. No payment will be made to the Contractor for removing these items unless otherwise specified. The Engineer may order specific temporary erosion control and sediment control devices to remain in place past final stabilization. The Contractor will not be responsible to remove these items.

# **TEMPORARY EROSION & SEDIMENT CONTROL MEASURES**

#### INSTALLATION OF SEDIMENT CONTROL MEASURES

The Contractor shall not begin the removal of surfacing or topsoil within the applicable work area until all applicable sediment control measures are placed. Sediment control measures shall be installed as necessary as construction progresses and these sediment control devices shall be installed within 24 hours at locations identified on the SWPPP.

#### **TEMPORARY VEHICLE TRACKING CONTROL**

**Maintenance Requirements:** Temporary vehicle tracking control should be inspected frequently to ensure that mud and dirt or not being tracked onto the roadway. Temporary vehicle tracking control material must be cleaned or replaced when the effectiveness of dirt removal is reduced.

**Measurement:** Temporary vehicle tracking control will be measured per each. Additional measurement will not be made for temporary vehicle tracking control that has been maintained, which includes replacement or repair at individual locations or for vehicle tracking control removed and reset in the same location to facilitate the contractor's method of operation.

**Payment:** Temporary vehicle tracking control will be paid for at the contract unit price per each. Payment shall be full compensation for all materials, labor, equipment, and incidentals required to install, maintain, and remove the temporary vehicle tracking control.

#### **TEMPORARY SEDIMENT BASIN**

Two temporary sediment basins shall be constructed at the two locations shown on the Erosion & Sediment Control Plan sheets. Excavation of the sediment basin shall be included in the contract unit price for Unclassified Excavation. Construction of the horseshoe filter including furnishing rock, maintenance and restoration of the sediment basins shall be included in the per each contract unit price for the item Temporary Sediment Basin. After stabilization has been achieved, the sediment basins shall be converted to the two BMP Extended Detention Basins (referred to on plan as BMP Ponds #1 and #2) and match the plan contours. The BMP ponds shall be topsoiled, seeded, fertilized, mulched and reinforced matted/blanketed. Separate payment will be made for the topsoil, seed, fertilizer, mulch and reinforced mat/blanket.

**Maintenance:** Temporary sediment basins will require the removal of the accumulated sediment when the design storage level is one half full. Payment for removal of the sediment shall be considered incidental to the various bid items associated with the construction of the temporary sediment basin.

#### STREET SWEEPING

**Construction Requirements:** Street sweeping is required during construction and before final completion of work to keep streets adjacent to and within the project area clean. The minimum equipment to be used for street sweeping shall be a skid loader with a pick up broom attachment or engineer approved equal. No rotary broom without the pick up broom attachment system will be acceptable to perform this work.

**Maintenance:** Sweeping shall be performed as needed to remove tracked mud from the roadway. Daily sweeping may be necessary if project conditions warrant.

Measurement: Street sweeping will be measured to the nearest tenth of an hour.

**Payment:** Street sweeping will be paid for at the contract unit price per hour. Payment shall be full compensation for all labor, equipment, and incidentals.

### **INLET PROTECTION**

**Maintenance Requirements:** Accumulated sediment should be removed and disposed of on site. Device should be cleaned or replaced if standing water is evident 48 hours after a rain event. Damaged devices must be repaired.

**Measurement:** Inlet protection will be measured per each type installed. Additional measurement will be made when a different type of inlet protection is installed at each location. No additional measurement will be made when the same type of inlet protection is removed and reinstalled at the same location.

**Payment:** Inlet protection will be paid for at the contract unit price per each. Payment shall be full compensation for all materials, labor, equipment, and incidentals required to install, maintain, and remove the inlet protection.

#### CONCRETE WASHOUT FACILITY

**Construction Requirements:** A concrete washout facility shall be installed on the project site at a location approved by the Engineer if concrete trucks deliver concrete to the site. No washout facility is necessary if all concrete trucks are going to wash out at approved site constructed by the concrete supplier.

**Maintenance Requirements:** The concrete washout facility must be kept in a condition to maintain the capacity for all wasted concrete and washout water on the project.

**Measurement:** Concrete washout facility will only be measured if the corresponding bid item has been included in the plans and a concrete washout facility has been constructed on the project site. Measurement for the concrete washout facility will be per each.

**Payment:** Payment for the concrete washout facility will be at the contract unit price per each if specified. Payment shall be full compensation for all materials, labor, equipment, and incidentals required to install, maintain, and remove the concrete washout facility. If the corresponding bid item has not been included in the plans the concrete washout facility will be considered incidental to the contract.

#### CHECK DAM (FOREBAY ROCK BERM)

**Maintenance Requirements:** Sediment should be removed when it reaches one half of the original dam height. Any washouts and stones that have been washed downstream shall be repaired.

**Measurement:** Check dam will be measured to the nearest tenth of ton of rock. Additional measurement will be made for any additional rock that is added to maintain or repair the check dam.

**Payment:** Check dam will be paid for at the contract unit price per ton. Payment shall be full compensation for all materials, labor, equipment, and incidentals required to install, maintain, and remove the check dam. Payment also includes restoration of the area unless covered by other pay items in the contract.

# PERMANENT EROSION CONTROL MEASURES

### INSTALLATION OF PERMANENT EROSION CONTROL MEASURES

This work shall be done as soon as possible after finish grading and topsoil placement is completed, and if practical, prior to seeding, fertilizing, and mulching of adjacent areas. At a minimum, the work must be completed within the timeframes listed within the Soil Surface Stabilization Practices notes.

#### TOPSOIL

The following information is to provide an informational guideline to the Contractor regarding topsoil placement and the SWPPP. Detailed topsoil placement notes are found in the **Landscaping & Irrigation plan and notes in Section "O"**. Generally, topsoil will be placed over all disturbed areas to a depth of 6 inches. The placement of the topsoil shall be as soon as possible upon completion of the grading operations.

#### **RIP RAP**


Riprap shall be Class B and installed in the areas identified on the plans and shall conform to Section 700 of the SDDOT Standard Specifications. The drainage fabric for rip rap shall conform to Section 831-Type B.

### SEEDING, SODDING, FERTILIZING & MULCHING

See Section "O" For Landscaping & Irrigation plan and notes.

### MULCH FOR STOCKPILES AND INTERIM GRADING AREAS

If the Contractor creates stockpiles or has other disturbed areas that will remain dormant for a period of longer than 21 days then methods described in the Soil Surface Stabilization Practices note shall be used. A quantity of 1 ton of fiber mulch has been included in the estimate of quantities based on anticipated construction methods and timeframes. The Contractor will be required to grade the stockpiles in a manner to properly apply the fiber mulch. No payment will be made for mulch that must be applied as a result of the Contractor not meeting the specified completion dates of the project or as a result of changes to the sequence of operations.

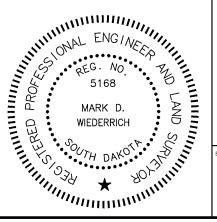

EROSION & SEDIM EROSION & SEDIM DESCRED BY: ARS DEWN BY: ARS DOWN FALLS REGIONAL AIRPORT REVISIONS:	EROSION & SEDIMENT CONTROL NARRATIVE TEDMINIAL PARKING & ACCESS IMPDOVEMENTS		FILE: 210710_Erosion Control Narrative.doc	BY: DATE: SIOUX FALLS. SOUTH DAKOTA	BY: DATE:	
OLDSMITH HECK N G I N E E R S, I N C. 1 - Slowe Fails, SD 67110 - Ph. 605.332.8065 Sloux FALLS RI	EROSION & SEDIMEN	DESIGNED BY: ARS			8	
GH GG			ENGINEERS INC	24 N. Sycamore Ave., Suite 1 - Sioux Falls, SD 57110 - Ph: 605.332.9685 SIOUX FALLS REGI		

OF

F17

#### **EROSION CONTROL BLANKET**

The extended-term erosion control blanket shall be installed at the locations shown on the plans.

**Maintenance:** The ground surface should be inspected for signs of rill or gully erosion below the matting. If there are any signs of erosion, tearing of the matting, or areas where the matting is no longer anchored firmly to the ground, the matting should be repaired.

**Material Content:** The extended-term erosion control blanket shall be the North American Green SC150, or equivalent. The SC150 erosion control blanket shall have the following physical properties:

- Matrix: 70% Straw Fiber (0.35 lb/yd²) (0.19 kg/m²) 30% Coconut Fiber (0.15 lb/yd²) (0.08 kg/m²)
- Netting: Top Heavyweight photodegradable with UV additives (3.0 lbs/1,000 ft<sup>2</sup> [1.47 kg/100m<sup>2</sup>] approx. weight)
  - Bottom Lightweight Photodegradable

Minimum Netting Weight (1.5 lbs/1000 ft2 [0.73 kg/100 m2] approx. weight)

Thread: Degradable

Stitch Spacing for all rolls = 1.50 inches (3.81 cm)

**Material Specification:** The extended-term erosion control blanket shall be a machineproduced mat of 70% straw/30% coconut fiber matrix with functional longevity of up to 24 months. (Note: functional longevity may vary depending upon climatic conditions, soil, geographic location, and elevation).

The blanket shall be of consistent thickness with the straw and coconut evenly distributed over the entire area of the blanket. The blanket shall be covered on the top side with heavyweight photodegradable polypropylene netting having ultraviolet additives to delay breakdown with an approximate  $0.63 \times 0.63$  inch  $(1.59 \times 1.59 \text{ cm})$  mesh, and on the bottom side with a lightweight photodegradable polypropylene netting with an approximate  $0.50 \times 0.50$  inch  $(1.27 \times 1.27 \text{ cm})$  mesh. The blanket shall be sewn together on 1.50 inch (3.81 cm) centers with degradable thread.

The extended-term erosion control blanket shall meet requirements established by the Erosion Control Technology Council (ECTC) Specification and the U.S. Department of Transportation, Federal Highway Administration's (FHWA) *Standard Specifications For Construction of Roads and Bridges on Federal Highway Projects, FP-03 2003 Section 713.17* as a *Type 3.B Extended-term Erosion Control Blanket*.

Installation staple patterns shall be clearly marked on the erosion control blanket with environmentally safe paint. The blanket shall be manufactured with a colored line or thread stitched along both outer edges (approximately 2-5 inches [5-12.5 cm] from the edge) to ensure proper material overlapping.

Installation on slopes or channels shall be in accordance with details shown in the plans. The erosion control blanket shall be secured using Staple Pattern E.

**Payment:** The contract unit price per square yard shall include all labor and materials associated with furnishing and installing the blanket in accordance with plan details and manufacturer's recommendations.

#### TURF REINFORCEMENT MAT

The composite turf reinforcement mat shall be installed at the locations shown on the plans.

**Maintenance:** The ground surface should be inspected for signs of rill or gully erosion below the matting. If there are any signs of erosion, tearing of the matting, or areas where the matting is no longer anchored firmly to the ground, the matting should be repaired.

**Material Content:** The composite turf reinforcement mat shall be the North American Green SC250, or equivalent. The SC250 composite turf reinforcement mat shall have the following physical properties:

- Matrix: 70% Straw Fiber (0.35 lb/yd<sup>2</sup>) (0.19 kg/m<sup>2</sup>) 30% Coconut Fiber (0.15 lb/yd<sup>2</sup>) (0.08 kg/m<sup>2</sup>)
- Netting: Top and Bottom Heavy Duty UV Stabilized Polypropylene (5.0 lbs/1,000 ft<sup>2</sup> [2.44 kg/100m<sup>2</sup>] approx. weight)
  - Mid Corrugated Ultra Heavy Duty UV Stabilized Polypropylene (24 lbs/1,000 ft<sup>2</sup> [11.7 kg/100m<sup>2</sup>] approx. weight)
- Thread: UV Stabilized Polypropylene

Stitch Spacing for all rolls = 1.50 inches (3.81 cm)

**Material Specification:** The composite turf reinforcement mat shall be a machine-produced mat of 70% straw/30% coconut fiber matrix incorporated into permanent three-dimensional turf reinforcement matting.


The matrix shall be evenly distributed across the entire width of the matting and stitch bonded between a heavy duty UV stabilized bottom net with 0.50 x 0.50 inch (1.27 x 1.27 cm) openings, an ultra heavy duty UV stabilized, dramatically corrugated (crimped) intermediate netting with 0.50 x 0.50 inch (1.27 x 1.27 cm) openings, and covered by a heavy duty UV stabilized top net with 0.50 x 0.50 inch (1.27 x 1.27 cm) openings. The middle corrugated netting shall form prominent closely spaced ridges across the entire width of the mat. The three nettings shall be stitched together on 1.50 inch (3.81 cm) centers with UV stabilized polypropylene thread to form a permanent three-dimensional turf reinforcement matting.


The composite turf reinforcement mat shall meet requirements established by the Erosion Control Technology Council (ECTC) Specification and the U.S. Department of Transportation, Federal Highway Administration's (FHWA) *Standard Specifications For Construction of Roads and Bridges on Federal Highway Projects, FP-03 2003 Section* 713.18 as a Type 5A, B, and C Permanent Turf Reinforcement Mat.

Installation staple patterns shall be clearly marked on the turf reinforcement matting with environmentally safe paint. All mats shall be manufactured with a colored thread stitched along both outer edges (approximately 2-5 inches [5-12.5 cm] from the edge) as an overlap guide for adjacent mats.


Installation on slopes or channels shall be in accordance with details shown in the plans. The turf reinforcement mat shall be secured using Staple Pattern E.

**Payment:** The contract unit price per square yard shall include all labor and materials associated with furnishing and installing the mat in accordance with plan details and manufacturer's recommendations.

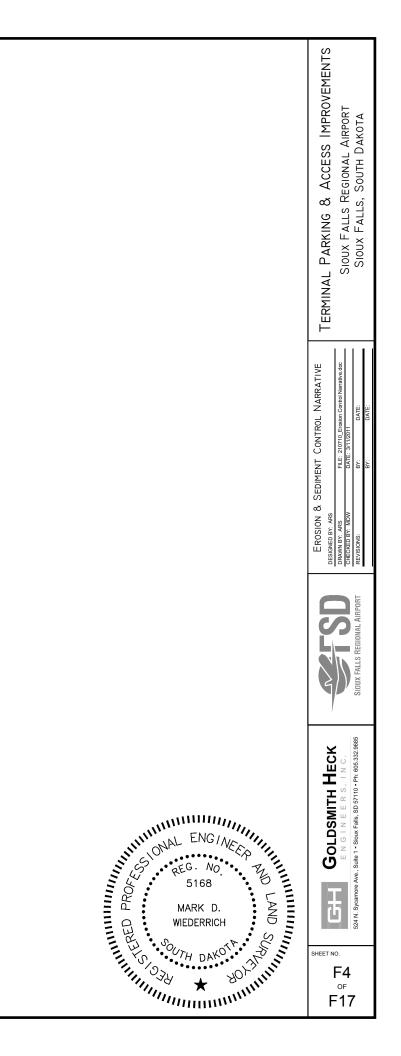

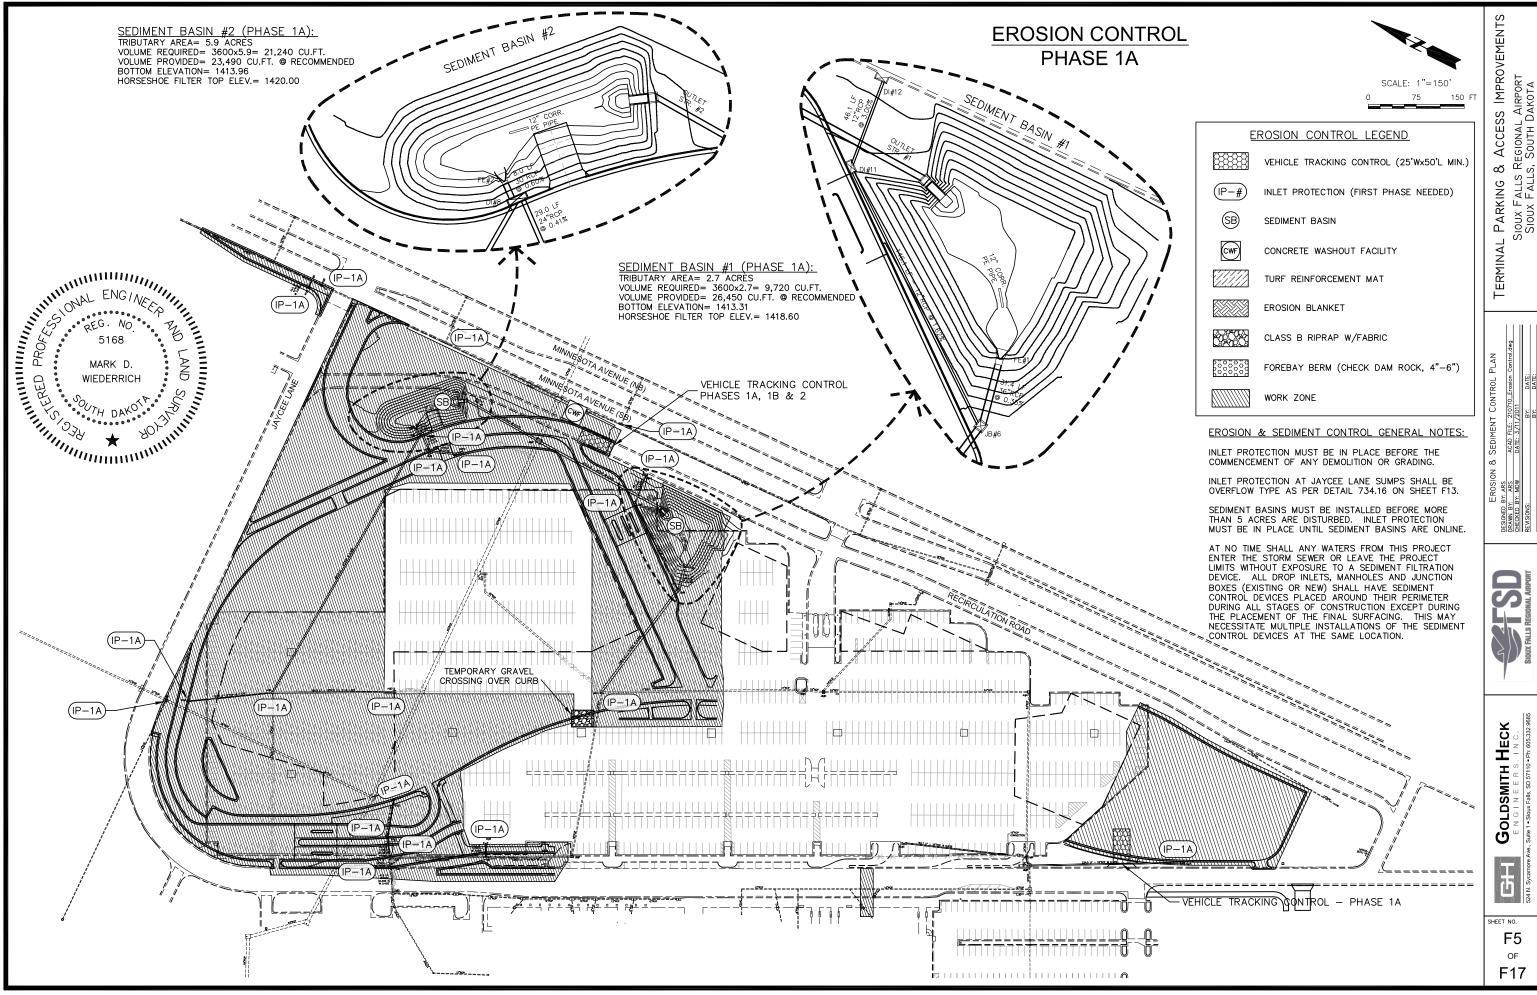




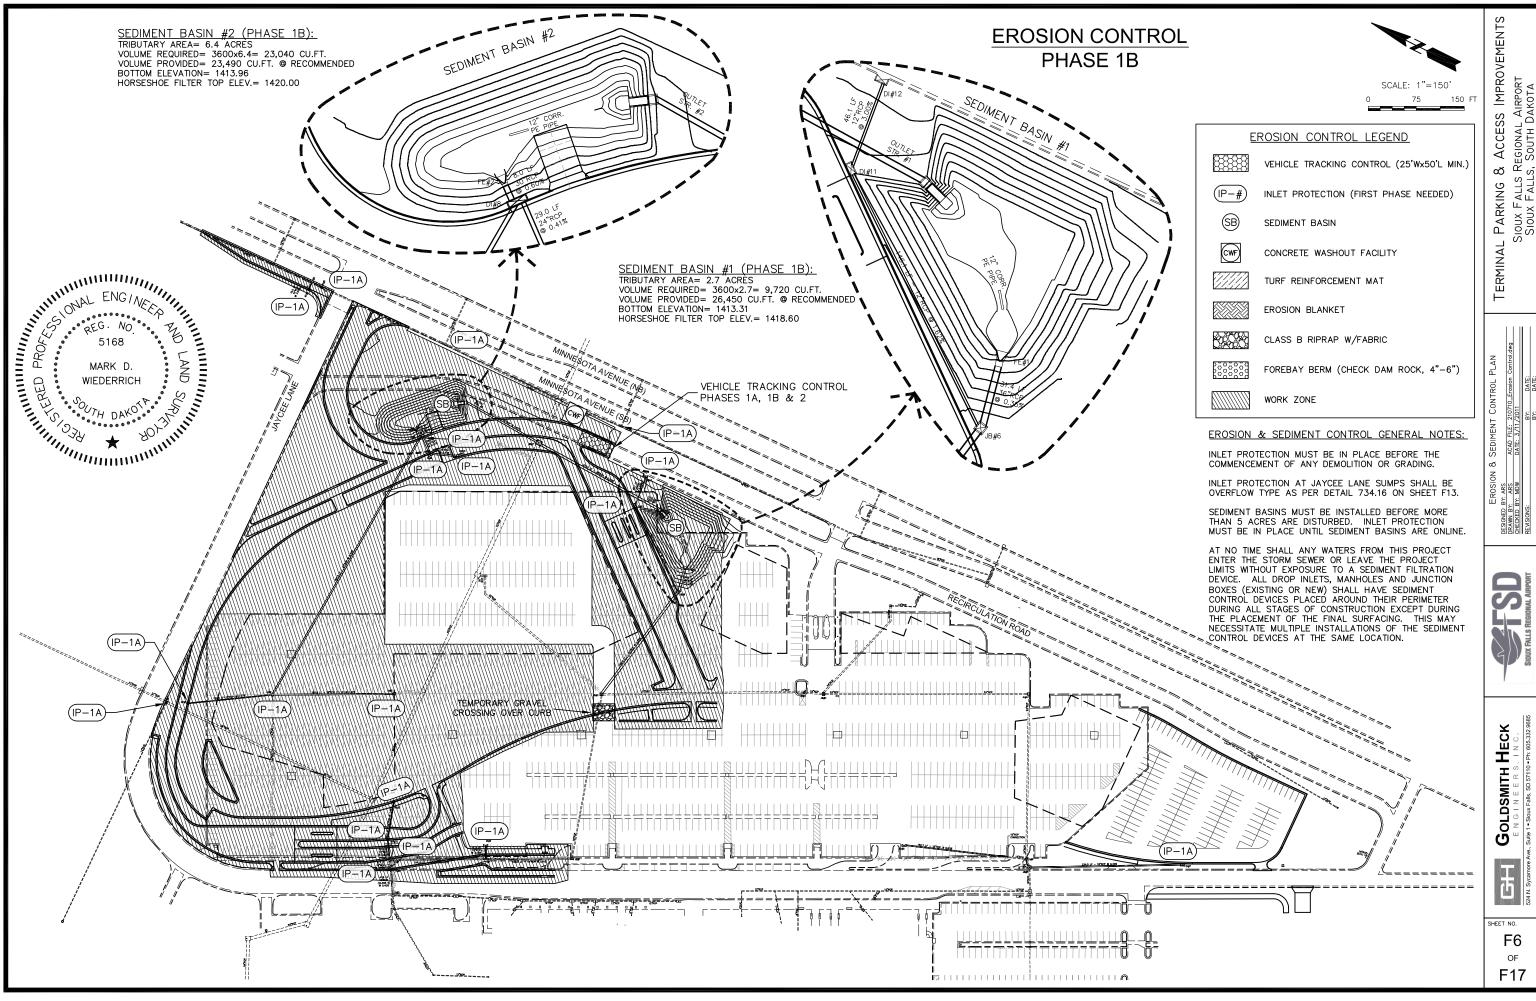




REGIONAL AIRPO


ACAD DATE:

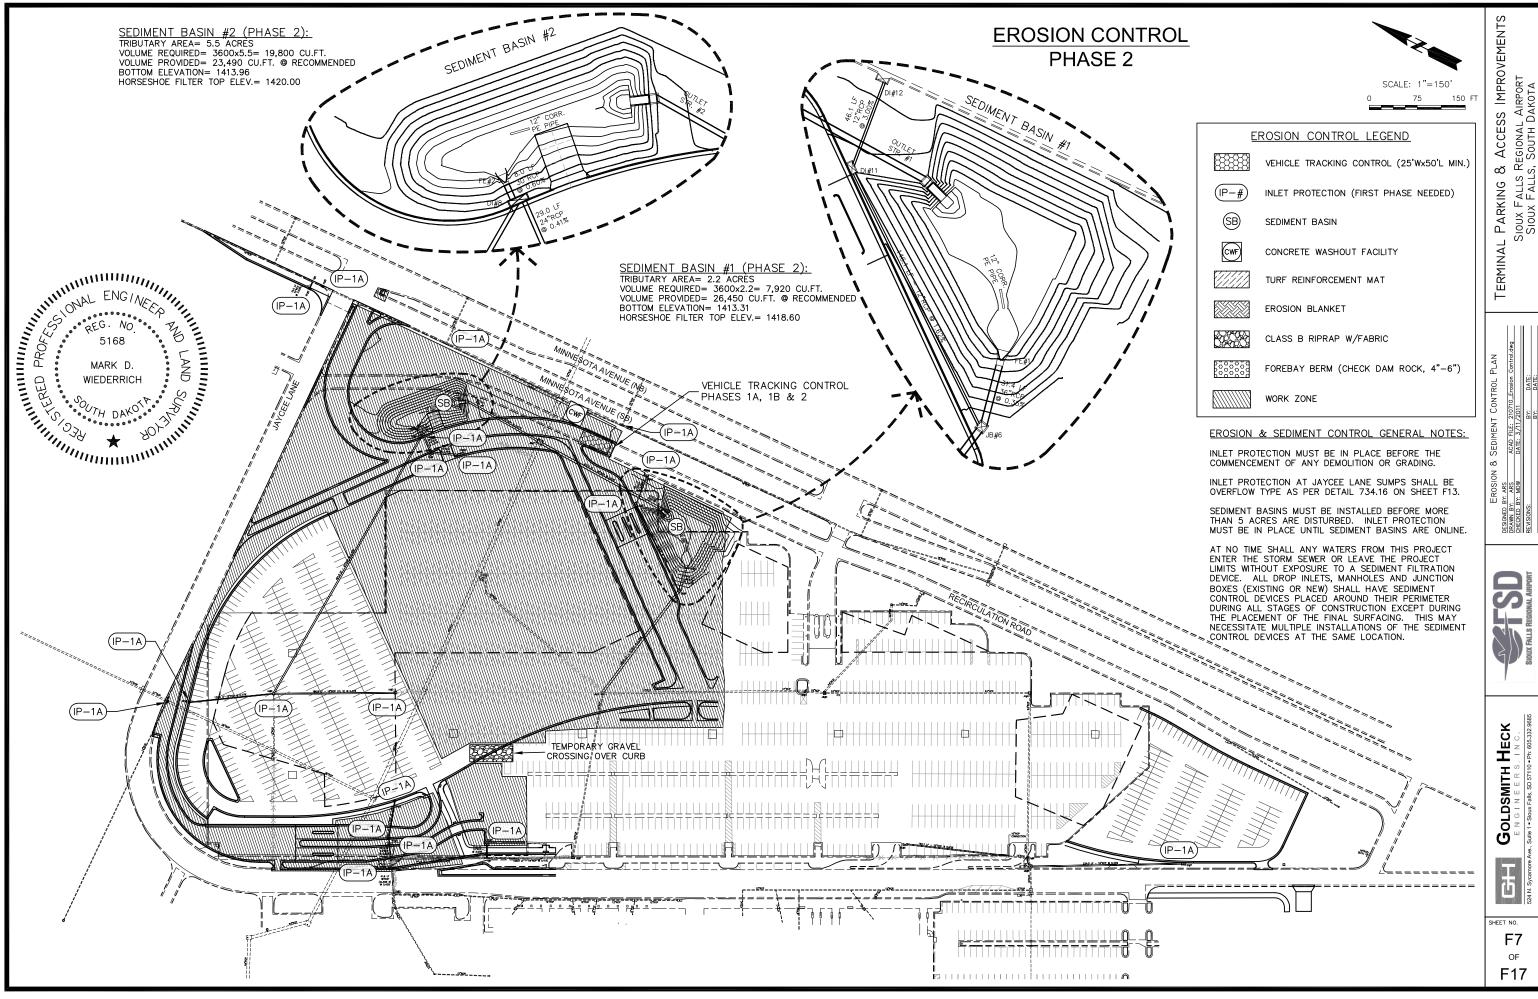




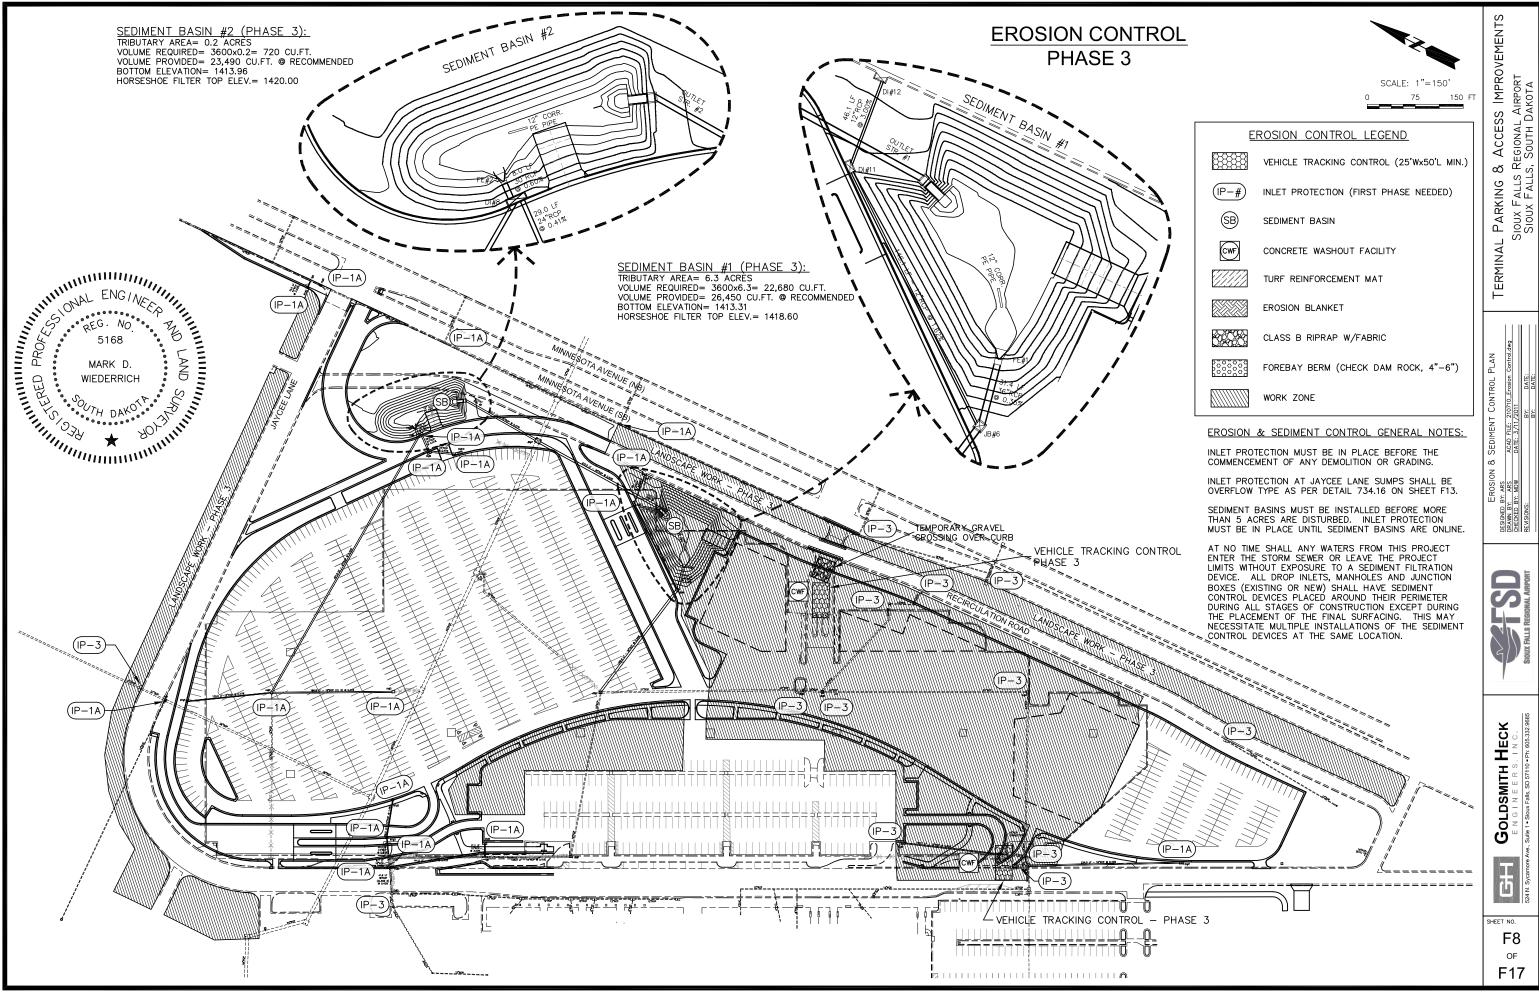



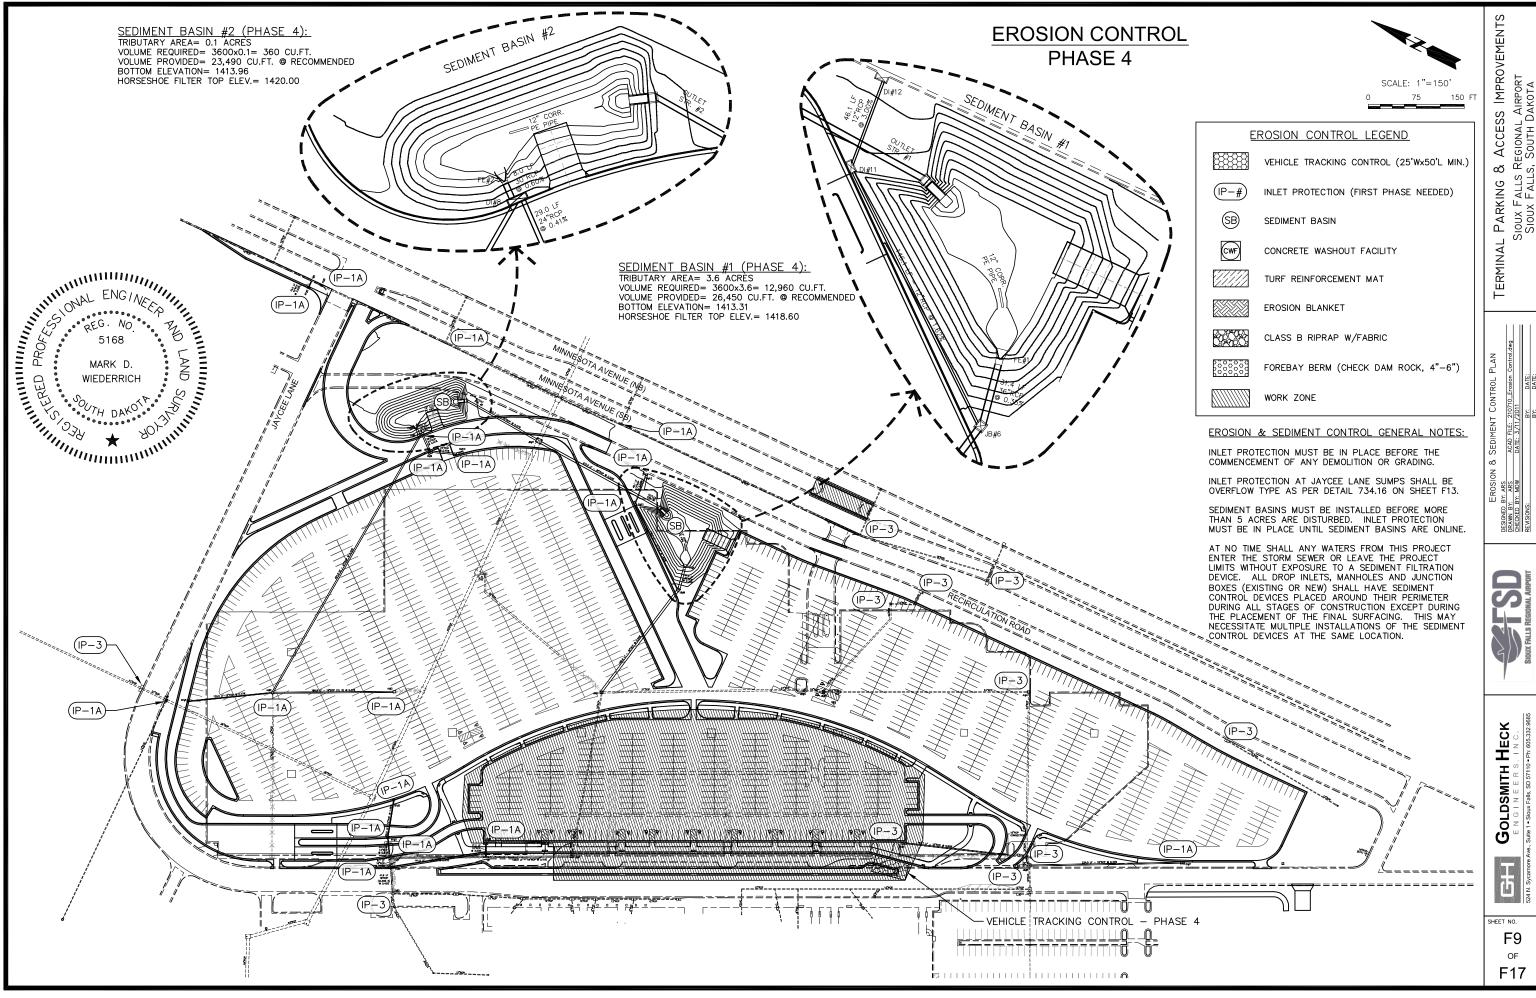





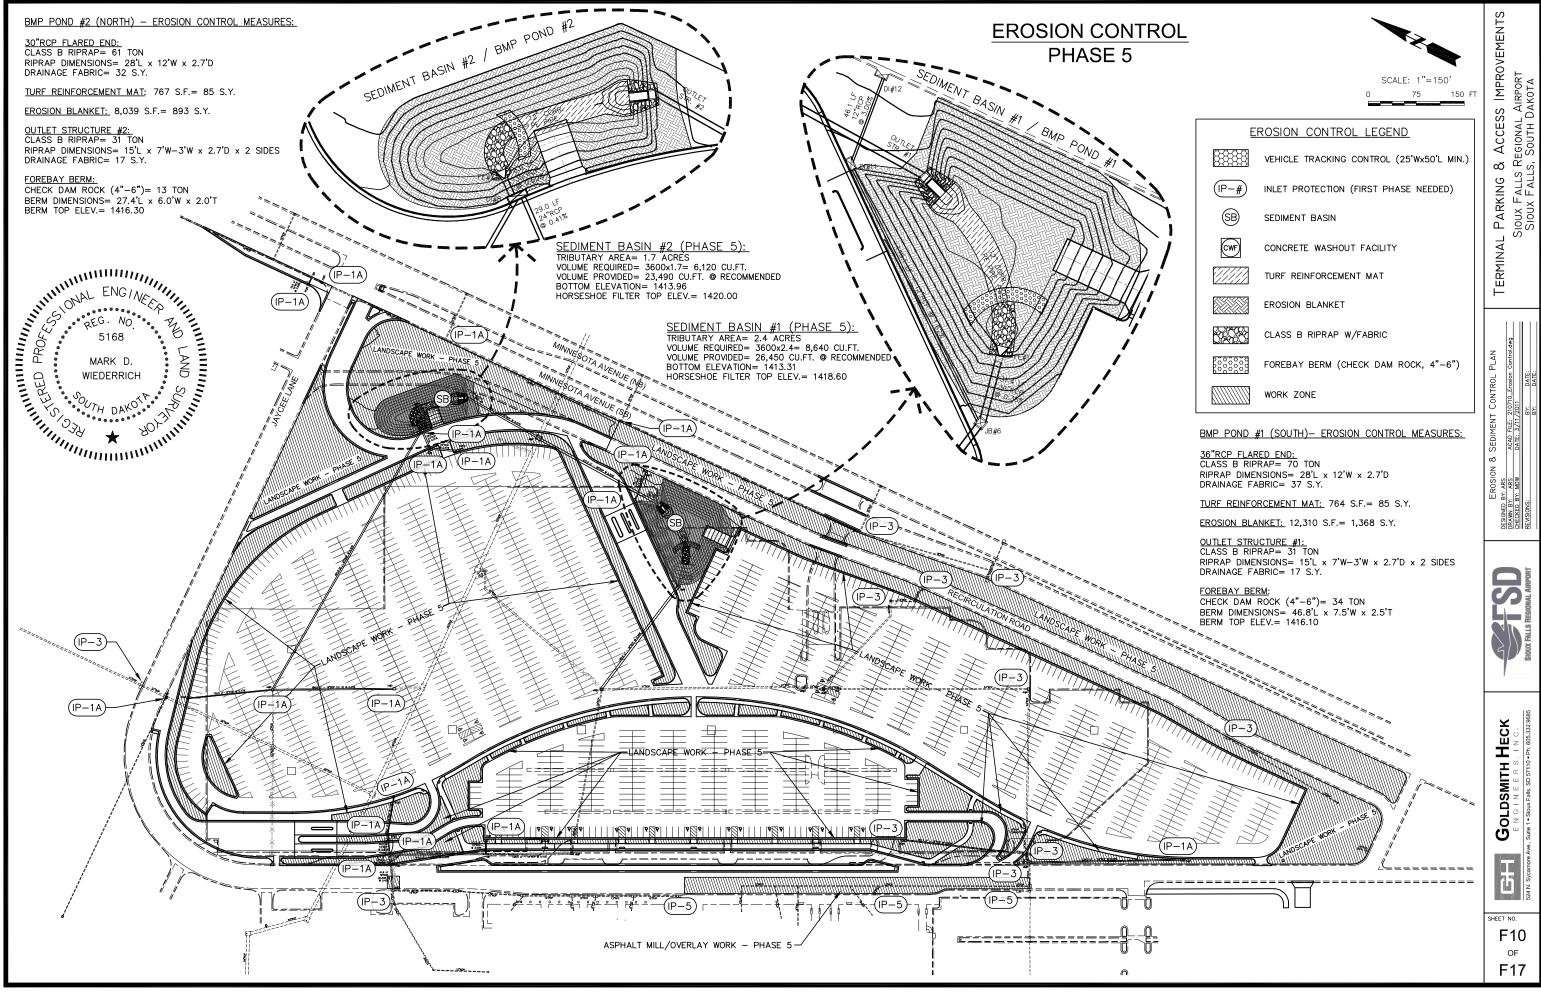






1	
যি হৈ উপ	

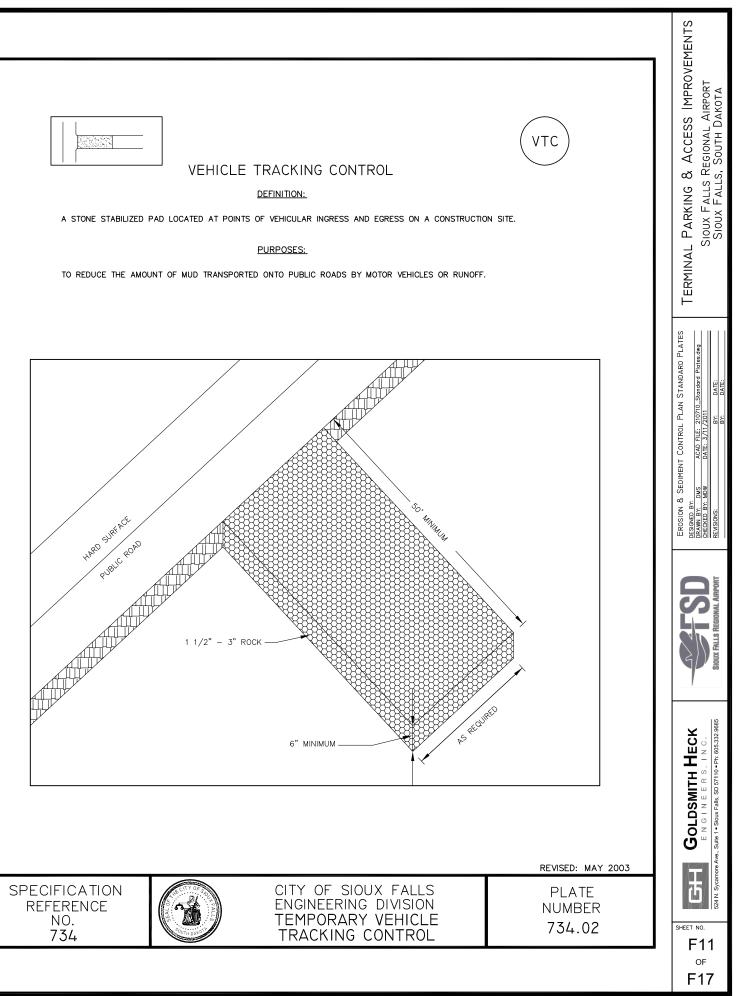

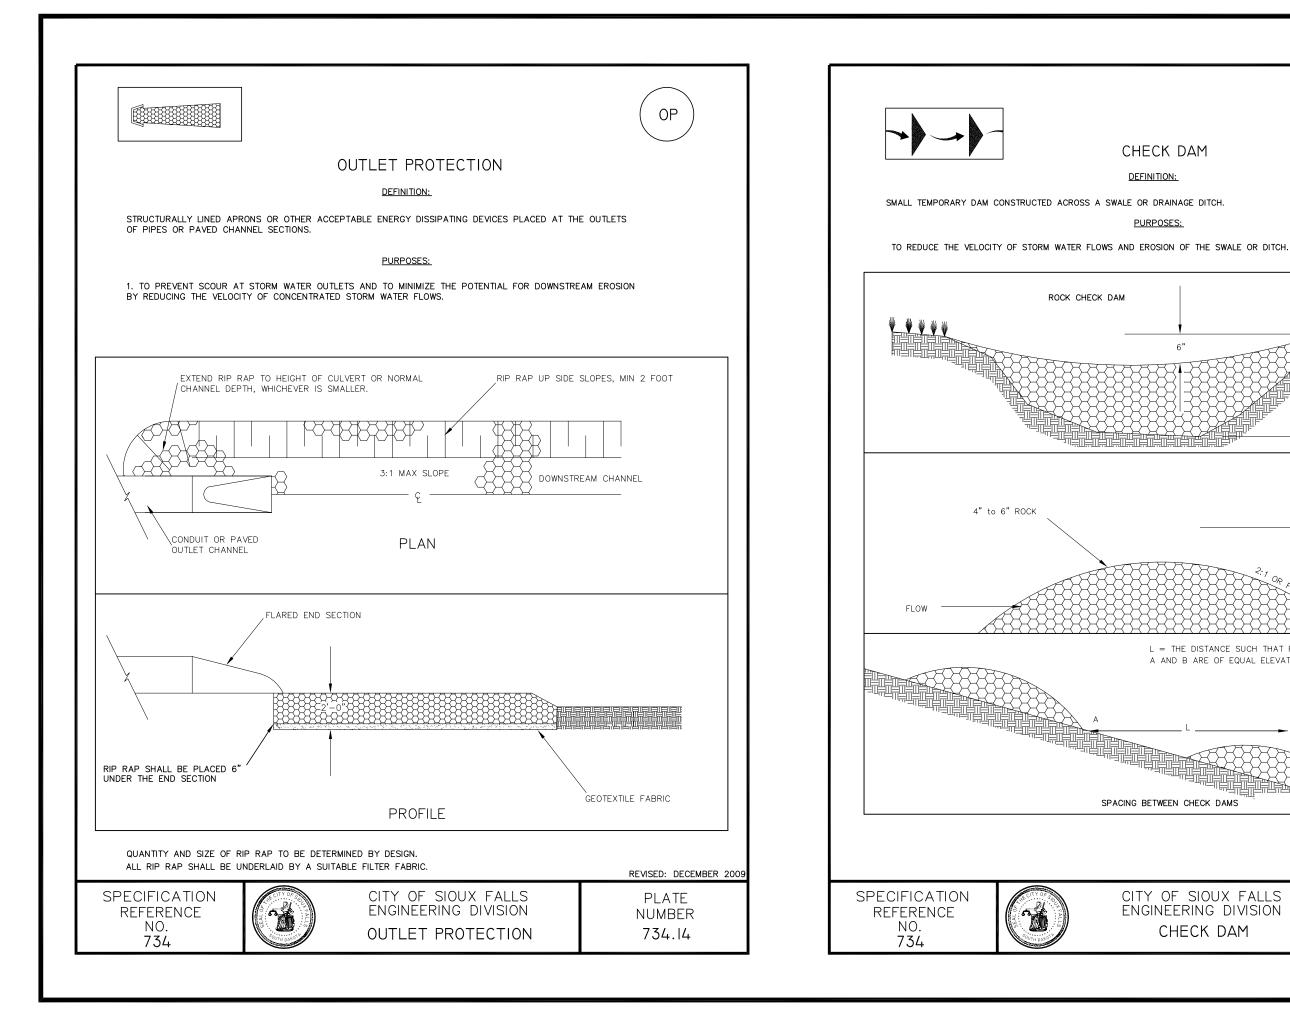

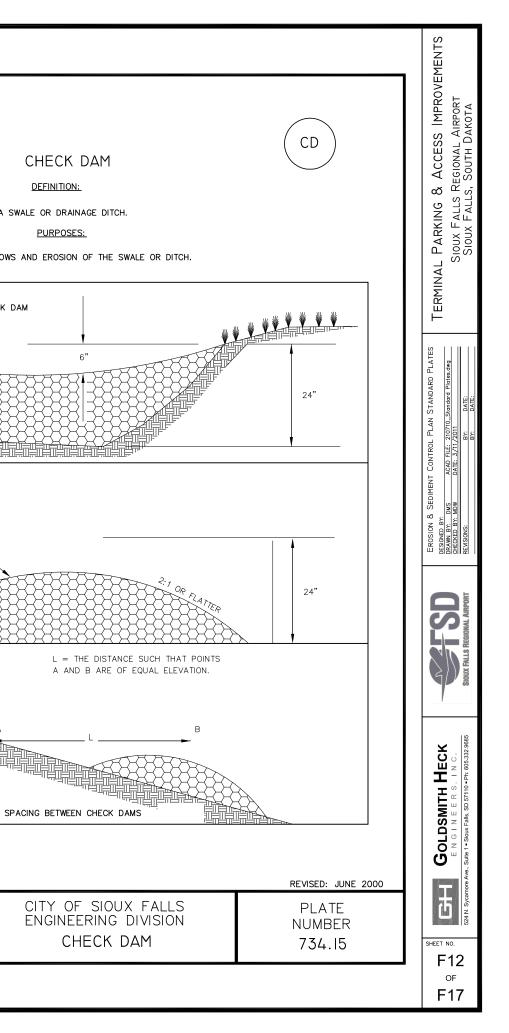

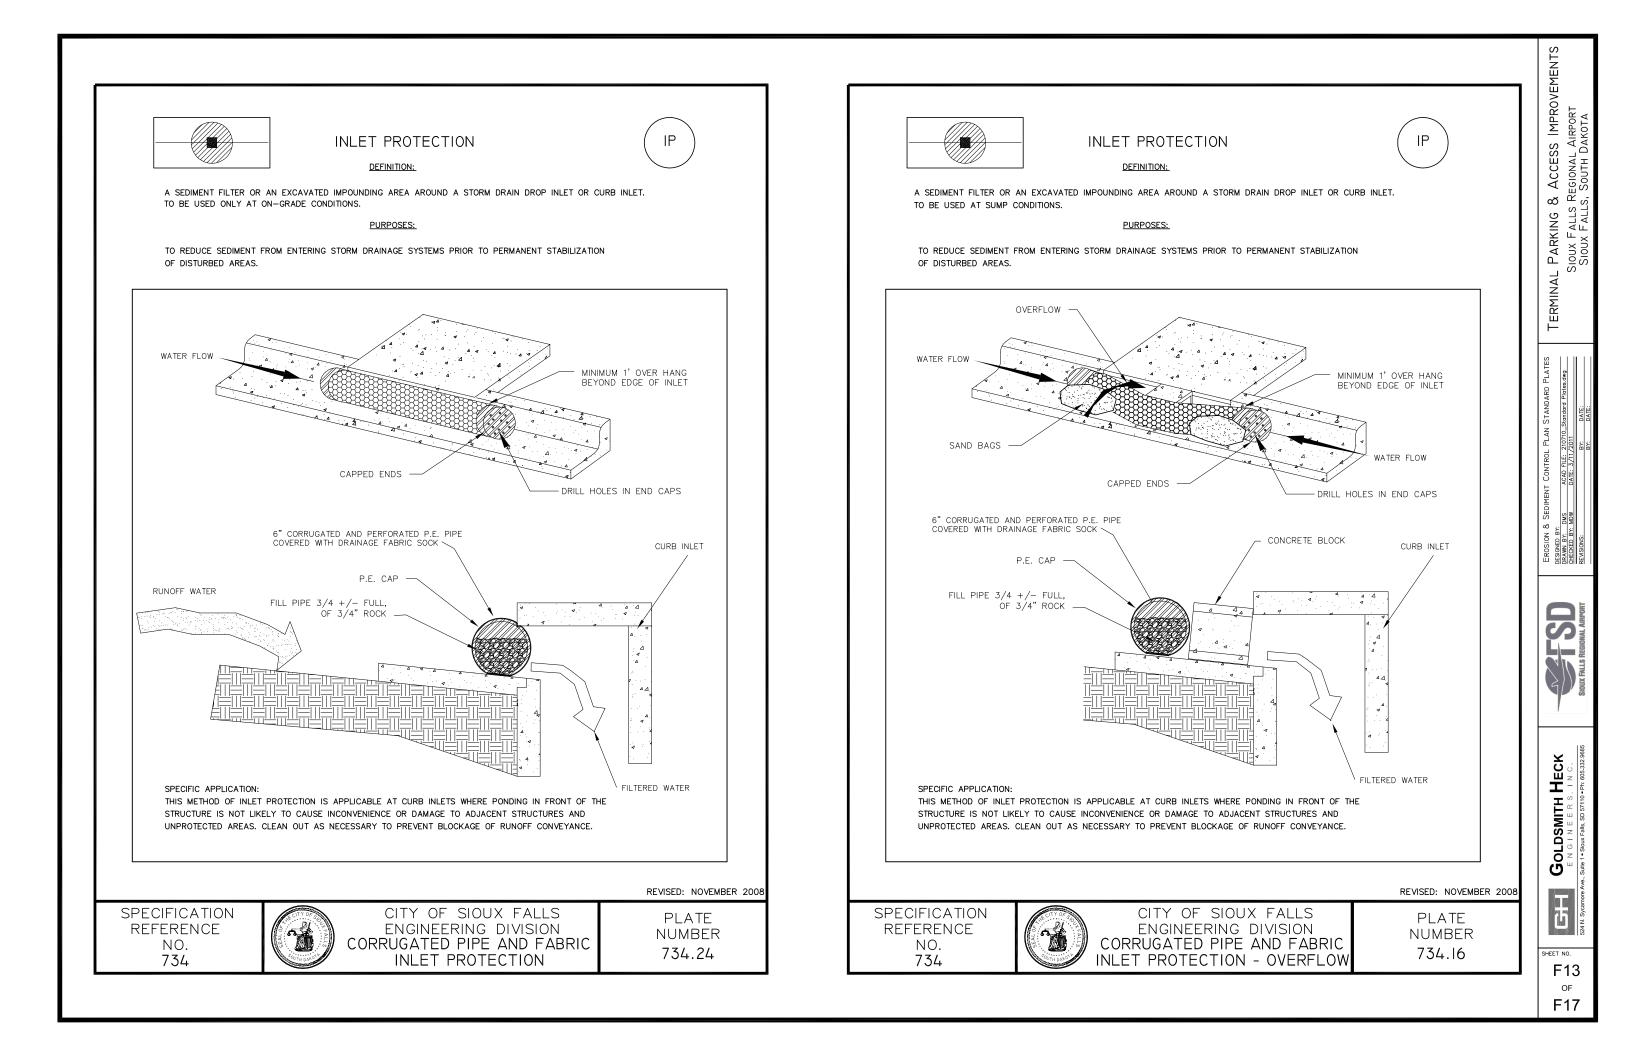

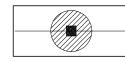




IΡ


DEFINITION:


A SEDIMENT FILTER OR AN EXCAVATED IMPOUNDING AREA AROUND A STORM DRAIN DROP INLET OR CURB INLET.


#### PURPOSES:


TO REDUCE SEDIMENT FROM ENTERING STORM DRAINAGE SYSTEMS PRIOR TO PERMANENT STABILIZATION OF DISTURBED AREAS.

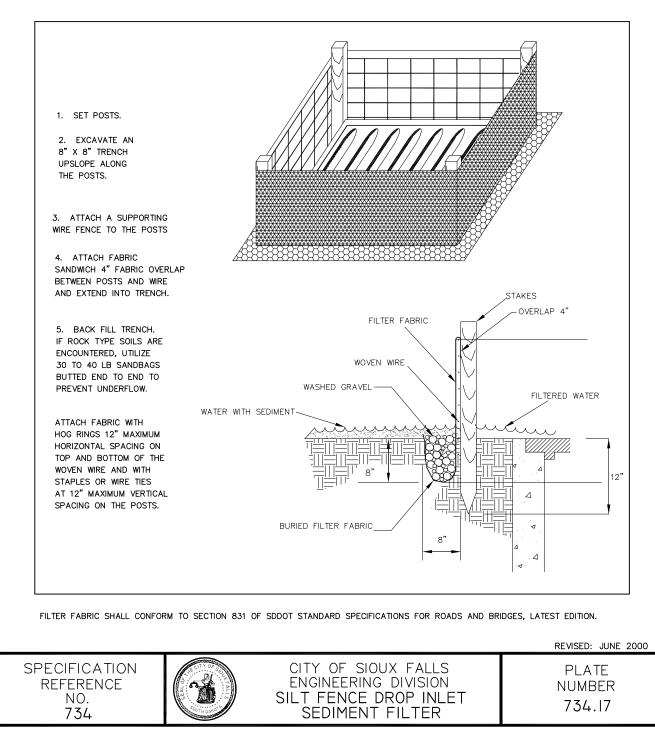


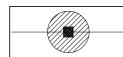


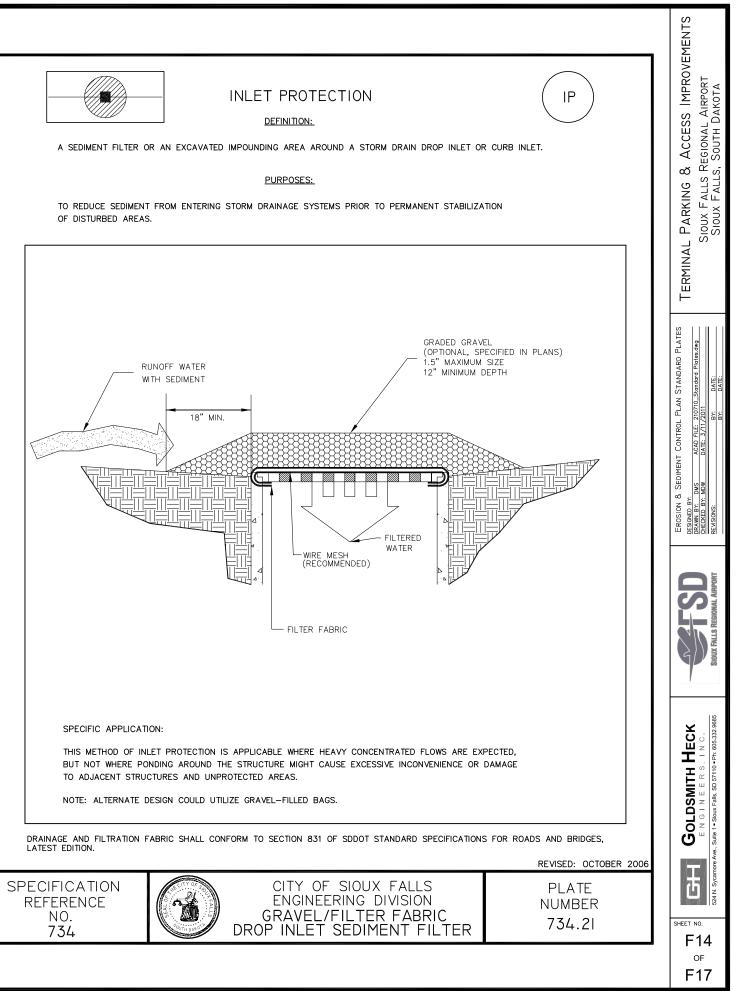

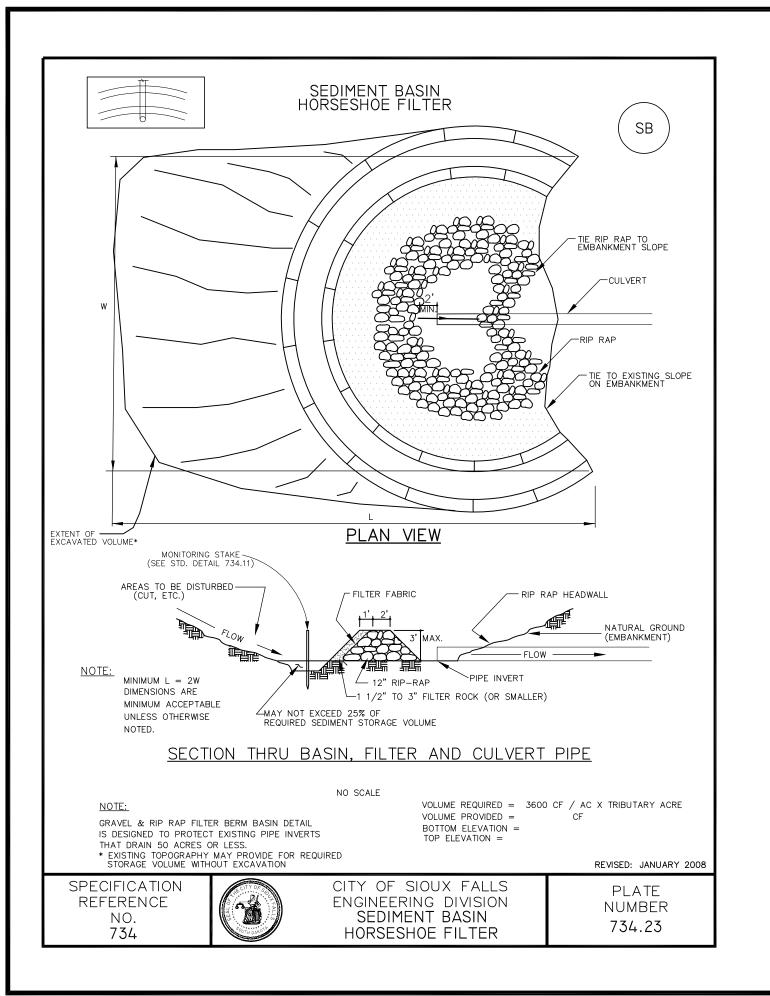

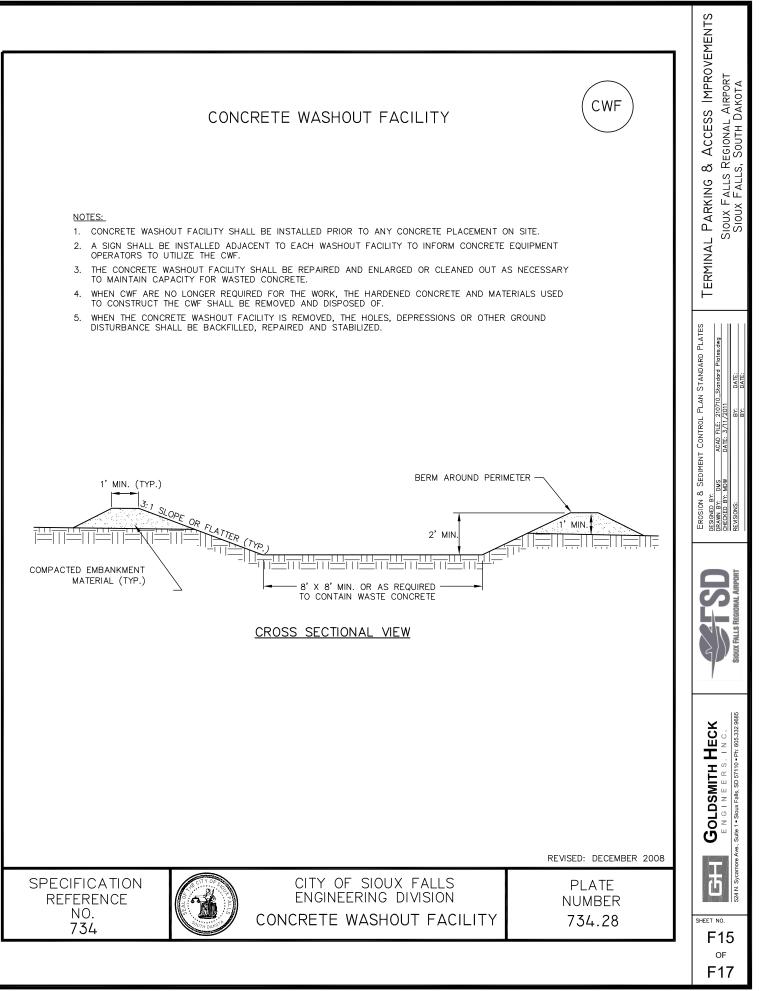

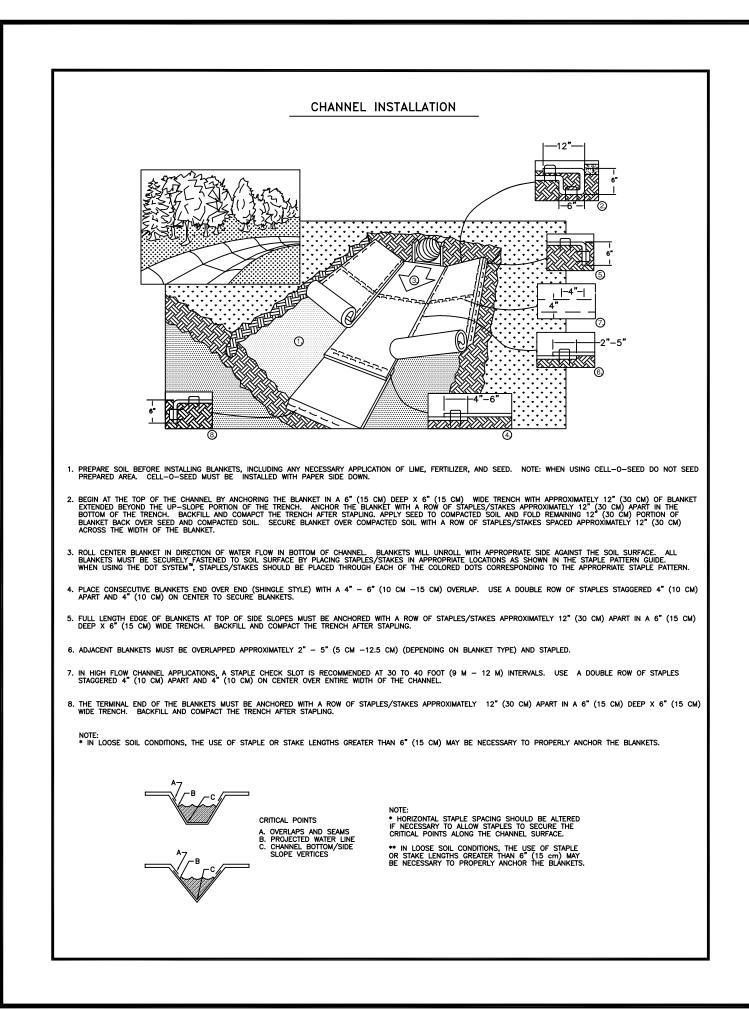


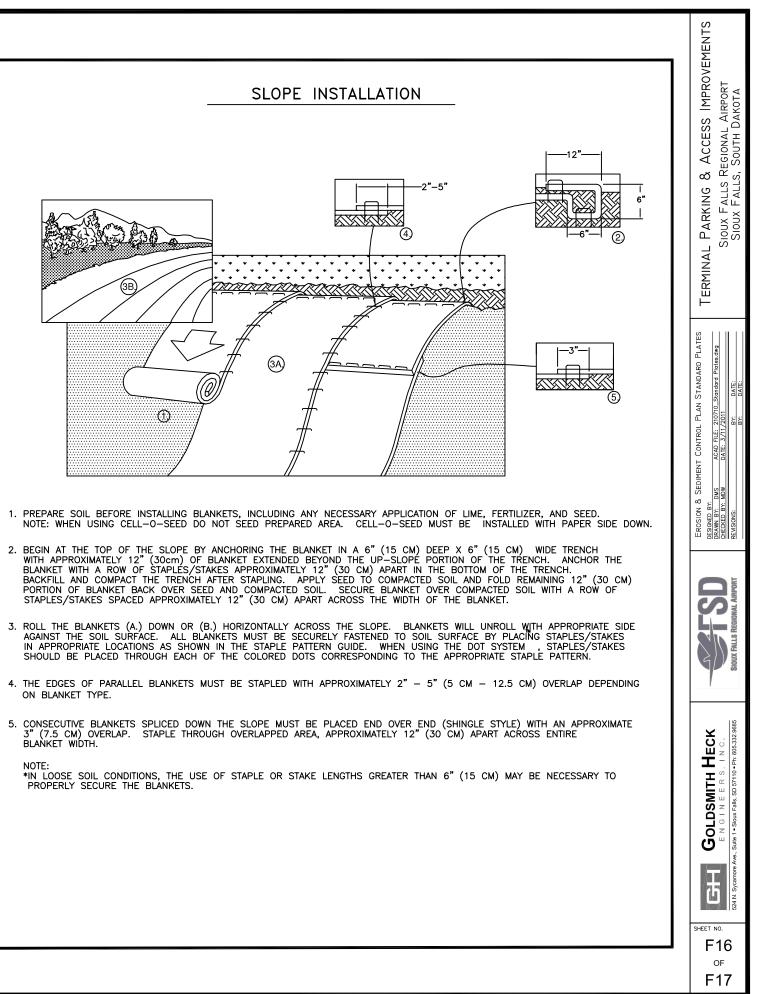



- ON BLANKET TYPE.
- BLANKET WIDTH.


NOTE


PROPERLY SECURE THE BLANKETS.

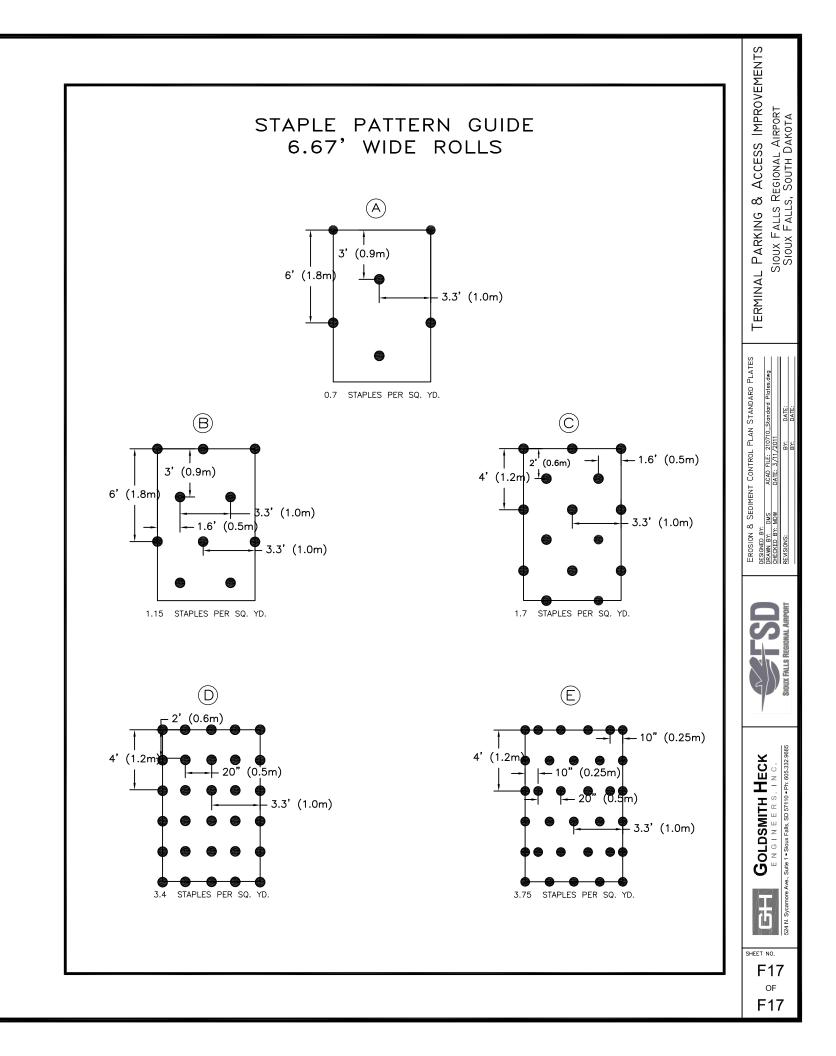


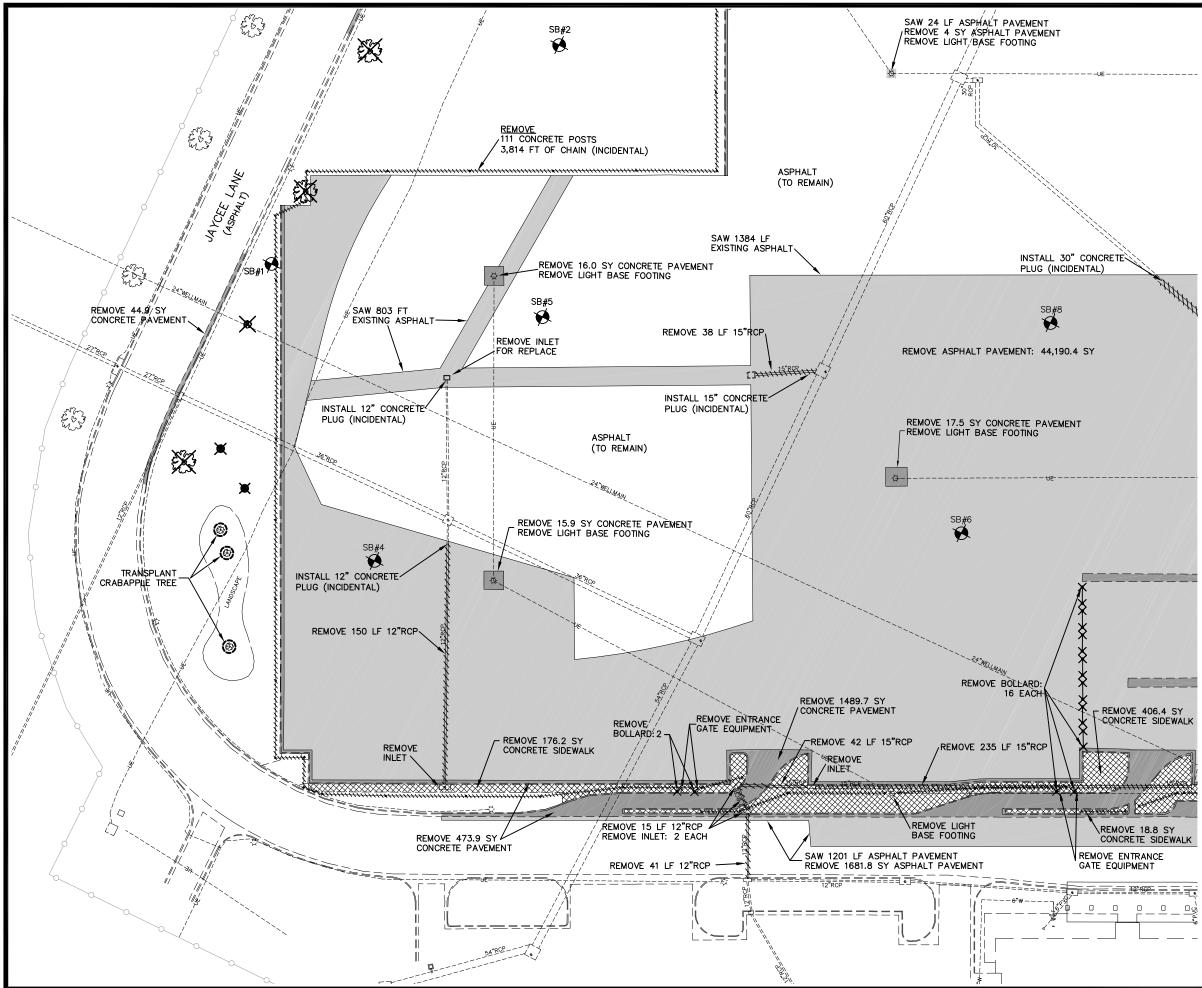

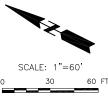


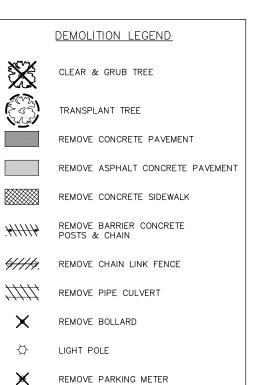


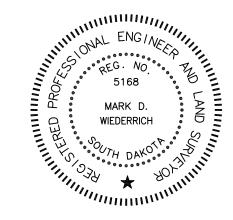


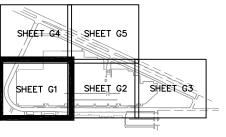




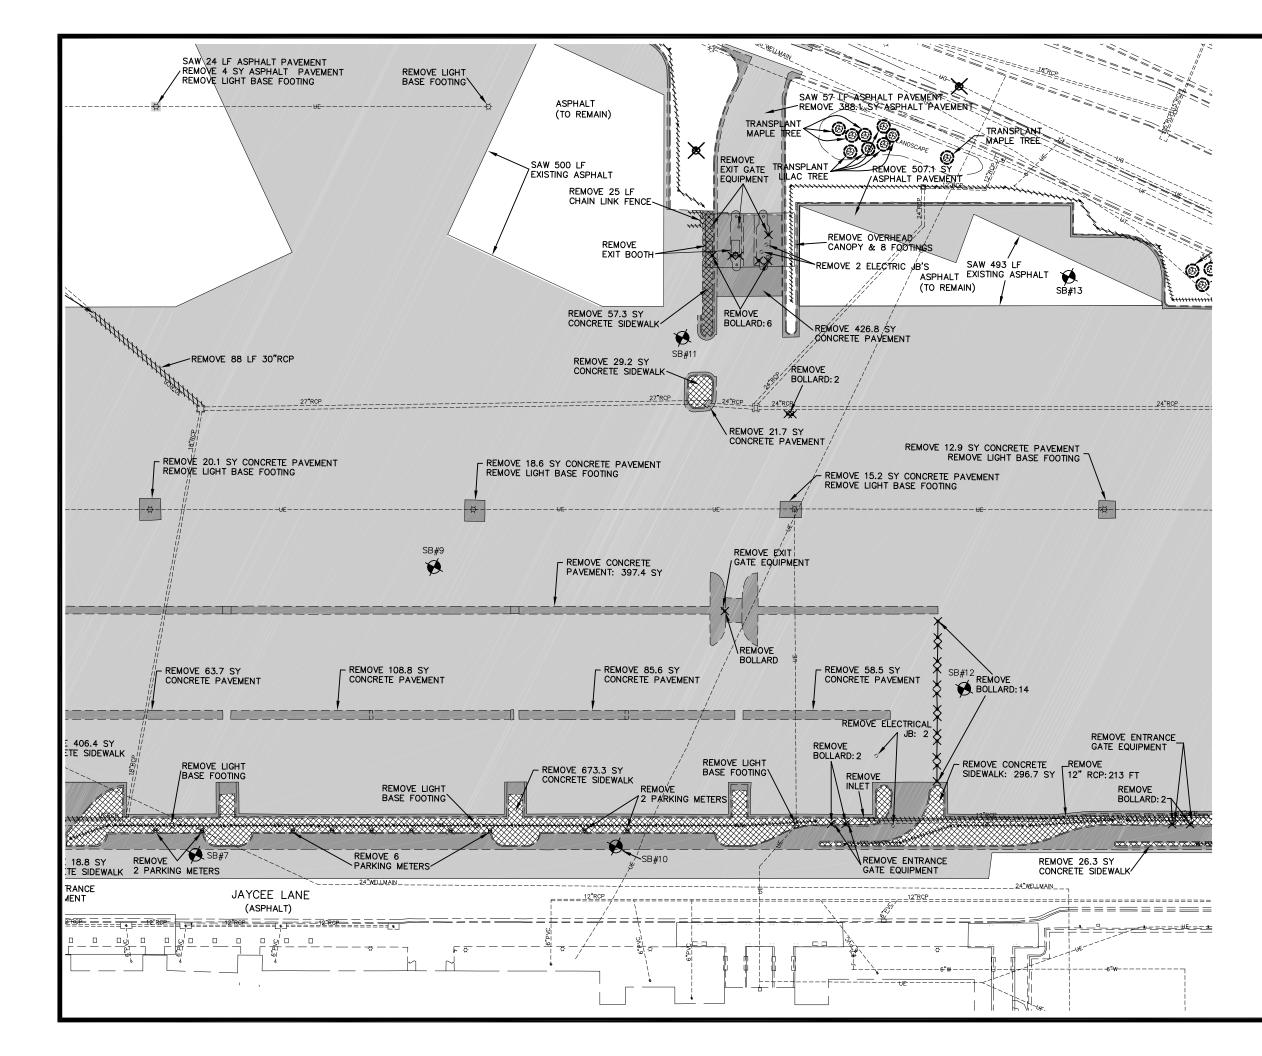


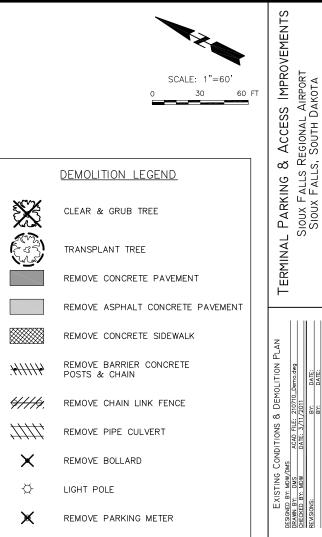


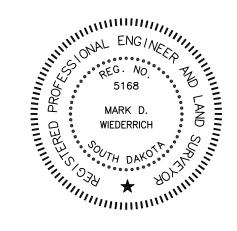


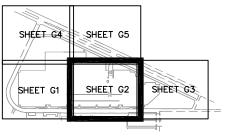





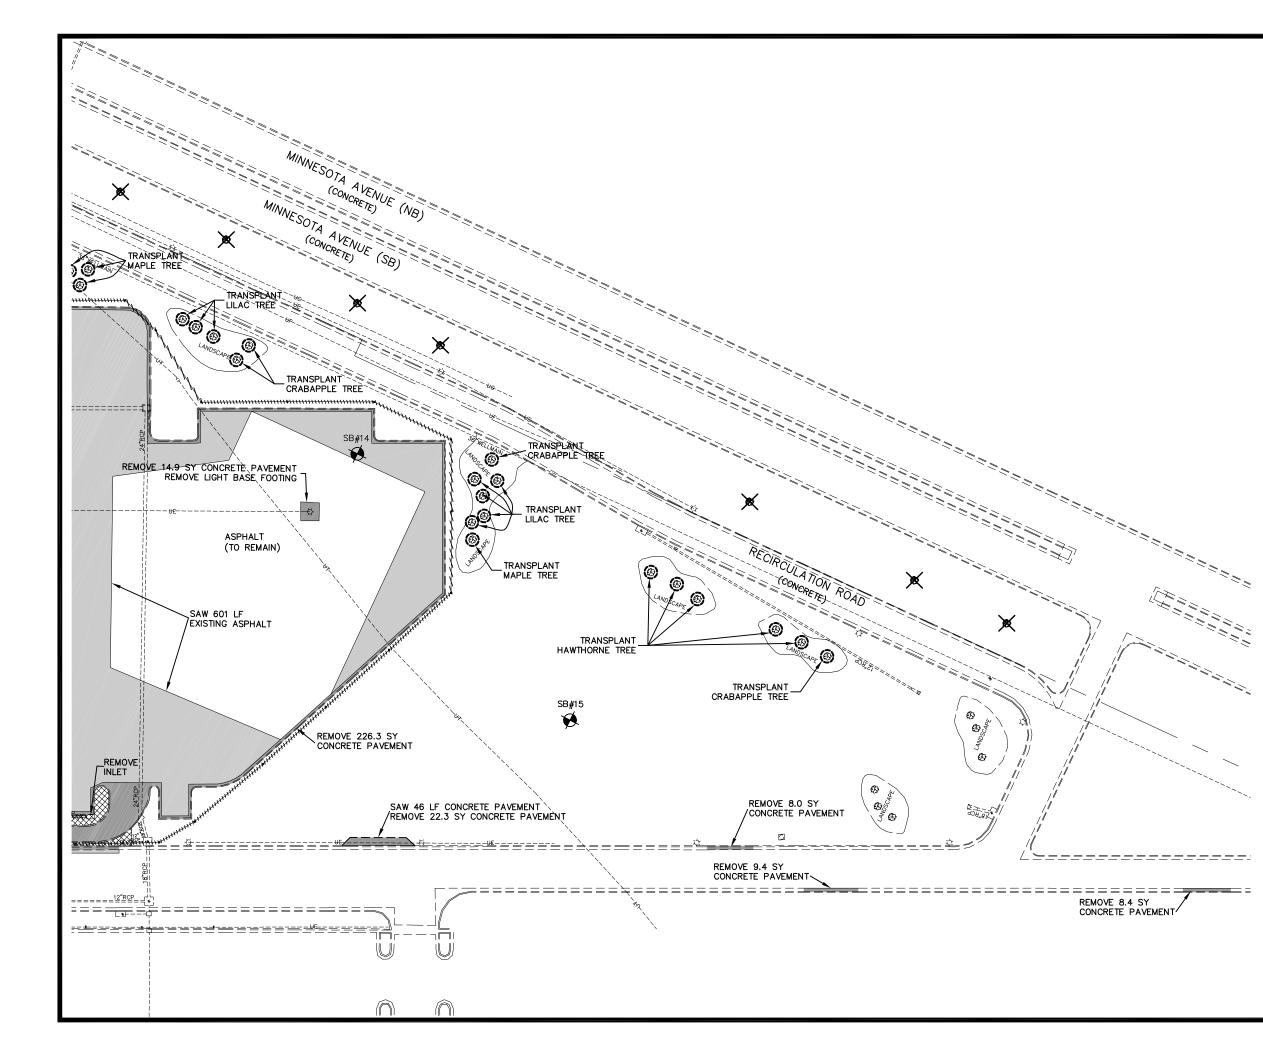

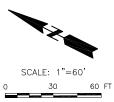

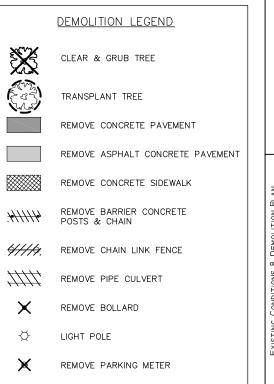


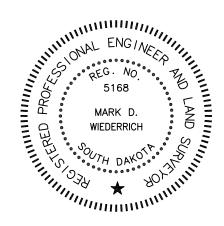


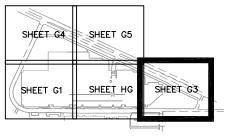






G3 <sub>OF</sub> G5

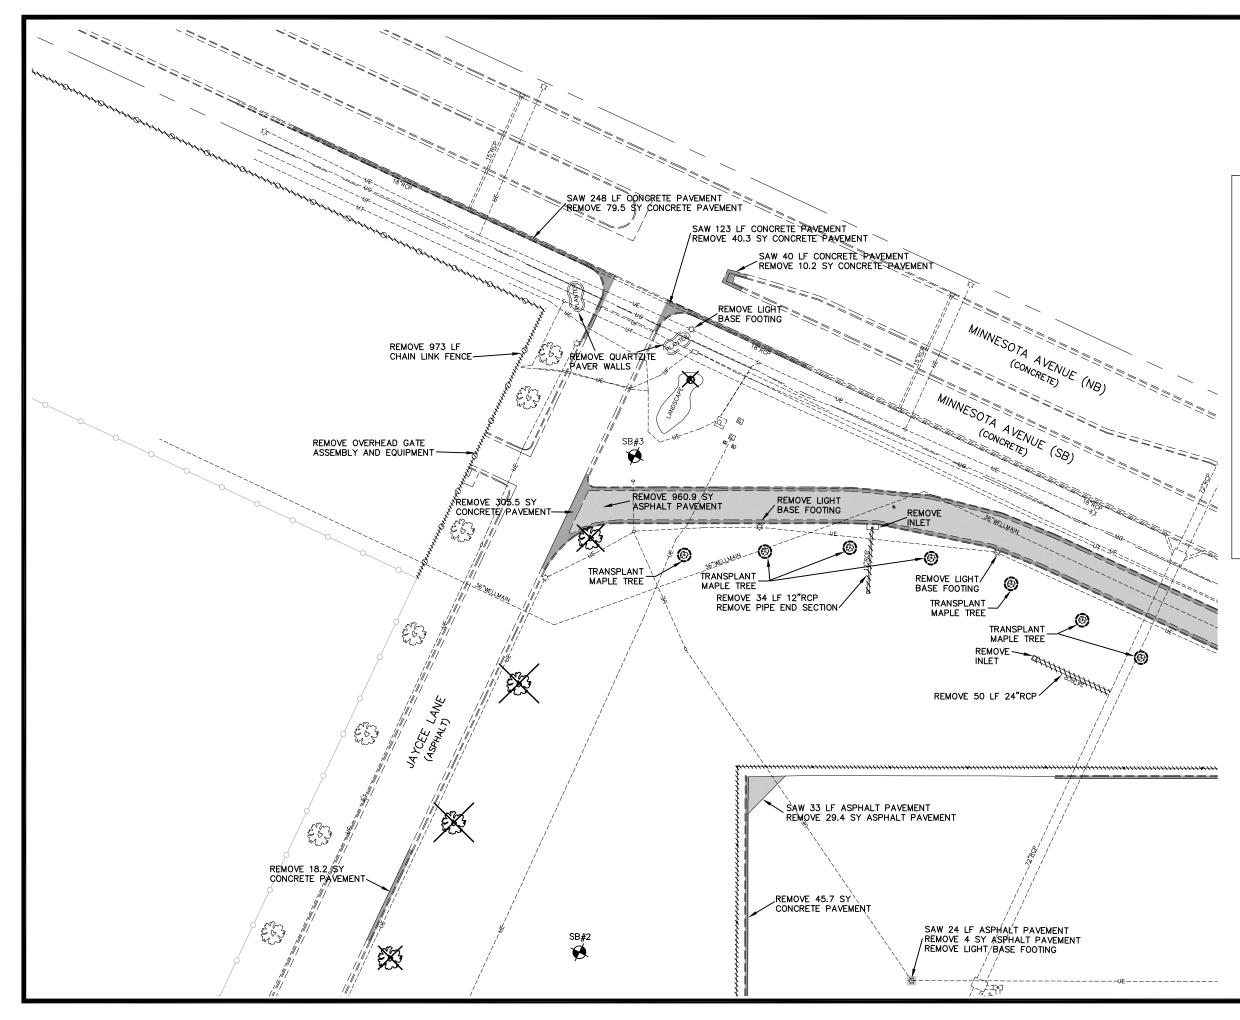

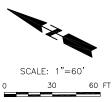

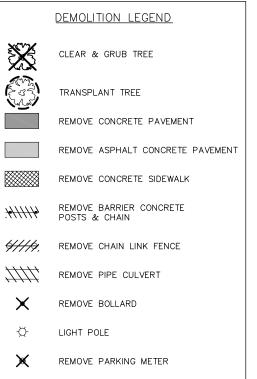


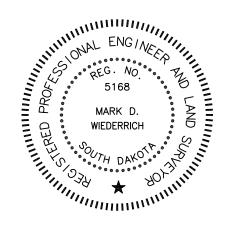


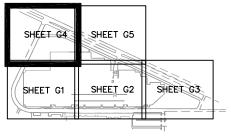





	<b></b>			
	REMOVAL QUAN	TITIES		
	ITEM	UNIT	QUANT.	
	Remove Asphalt Concrete Pavement	SqYd	47,802	
	Remove Concrete Pavement	SqYd	4,569	
	Remove Concrete Sidewalk	SqYd	1,685	
	Saw Existing PCC Concrete	Ft	715	
	Saw Existing Asphalt	Ft	5,181	
	Remove Pipe Culvert	Ft	906	
	12IN. RCP, 453 Ft			
	15IN. RCP, 315 Ft			
	24IN. RCP, 50 Ft			
	30IN. RCP, 88 Ft			
	Remove Pipe End Section	Each	1	
	Remove Drop Inlet	Each	9	
	Remove Fence	Ft	998	
	Remove Overhead Gate Assembly & Equip	LS	1	
	Remove Barrier Concrete Posts	Each	111	
	Remove Bollard	Each	45	
	Remove Entrance & Exit Lane Equipment	LS	1	
	Transplant Tree	Each	44	
	Clear and Grub Tree	Each	18	
	Remove Exit Plaza Canopy	LS	1	
	Remove Exit Plaza Canopy Footings	Each	8	
	Remove Exit Plaza Booth	Each	2	
	Remove Parking Meters	Each	10	
	Remove Luminaire Pole Footing	Each	18	
	Remove Quartzite Paver Planter Wall	Each	2	
	Remove Electric Junction Box	Each	4	
TRANSPLANT MAPLE TREE				
REMOVE 160 SY CONCRETE PAVEMENT TRANSPLANT MAPLE TREE	CONCRETE PAVEMENT 5.3 SY CONCRETE PAVEMENT			
SAW43	CONCRETE PAVEMENT .5 SY CONCRETE PAVEMENT ELASPHALT PAVEMENT			
SAW 24 LF ASPHALT PAVEMENT REMOVE 4 SY ASPHALT PAVEMENT REMOVE LIGHT BASE FOOTING BASE FOOTING ASPHALT (TO REMAIN)	T PAVEMENT			

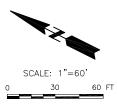

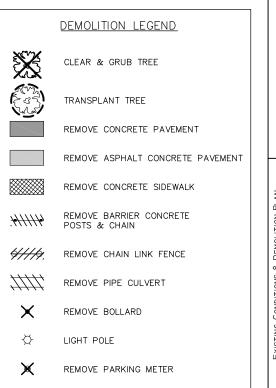

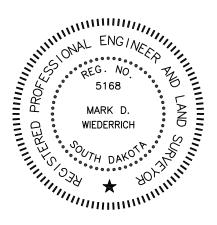



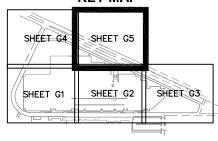






SHEET NO.


G5


₀ G5

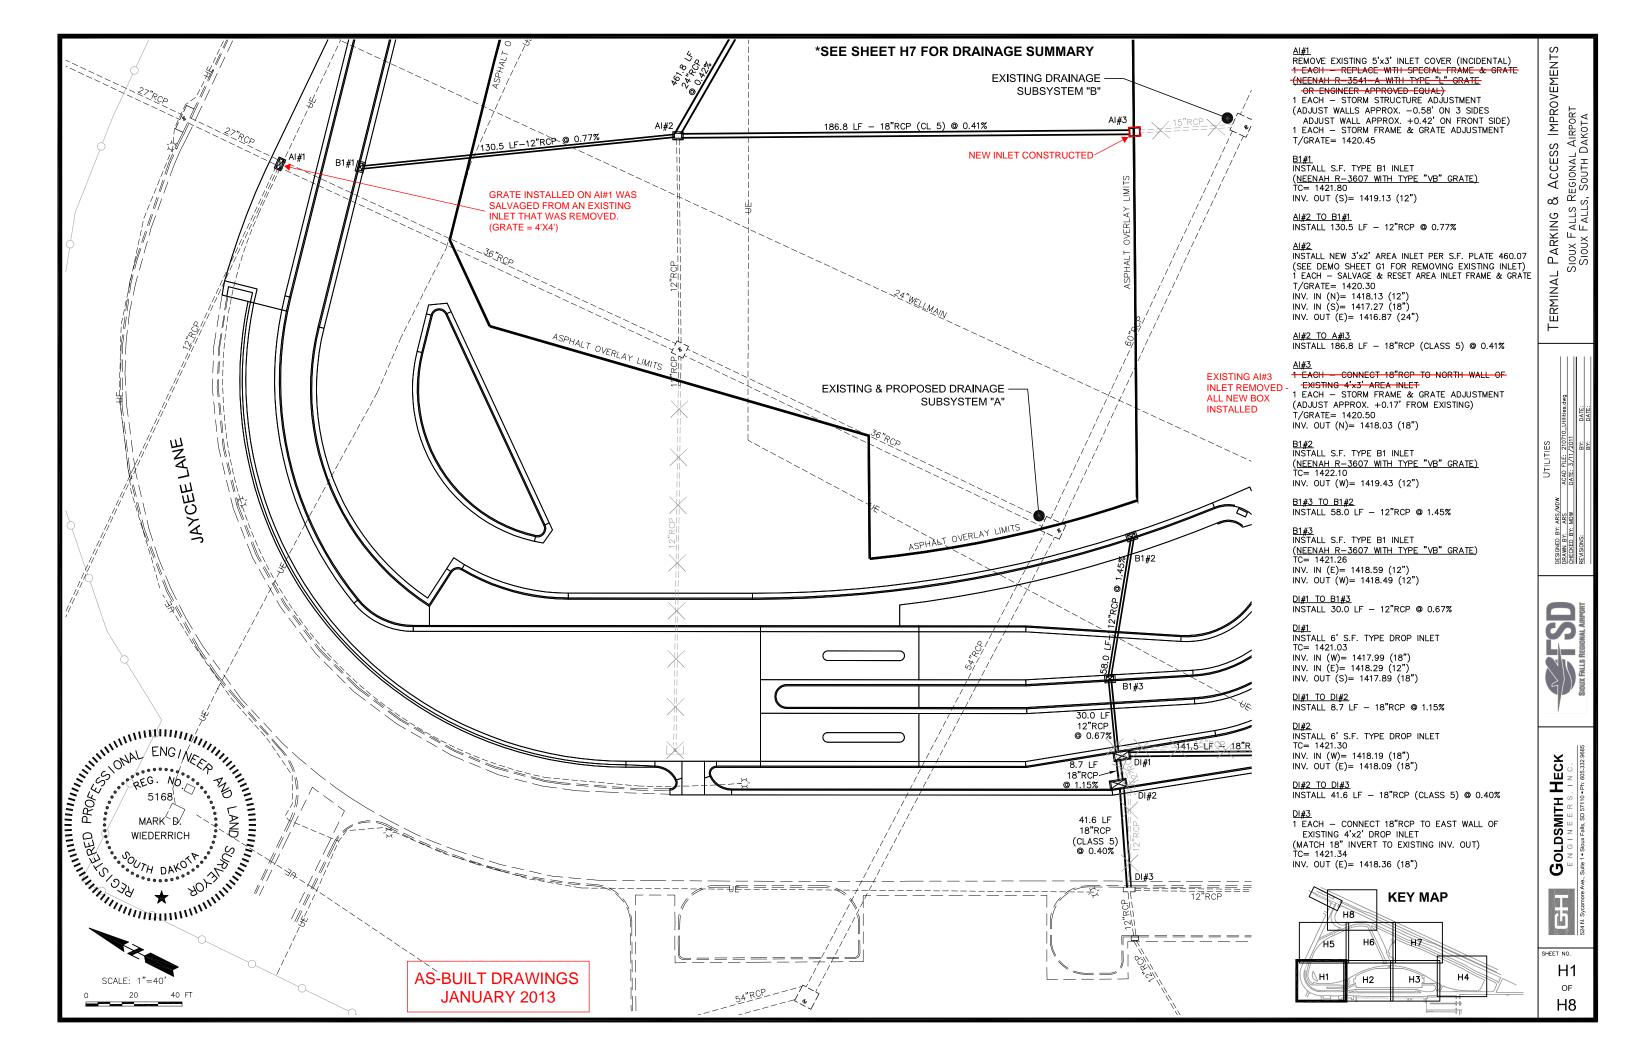


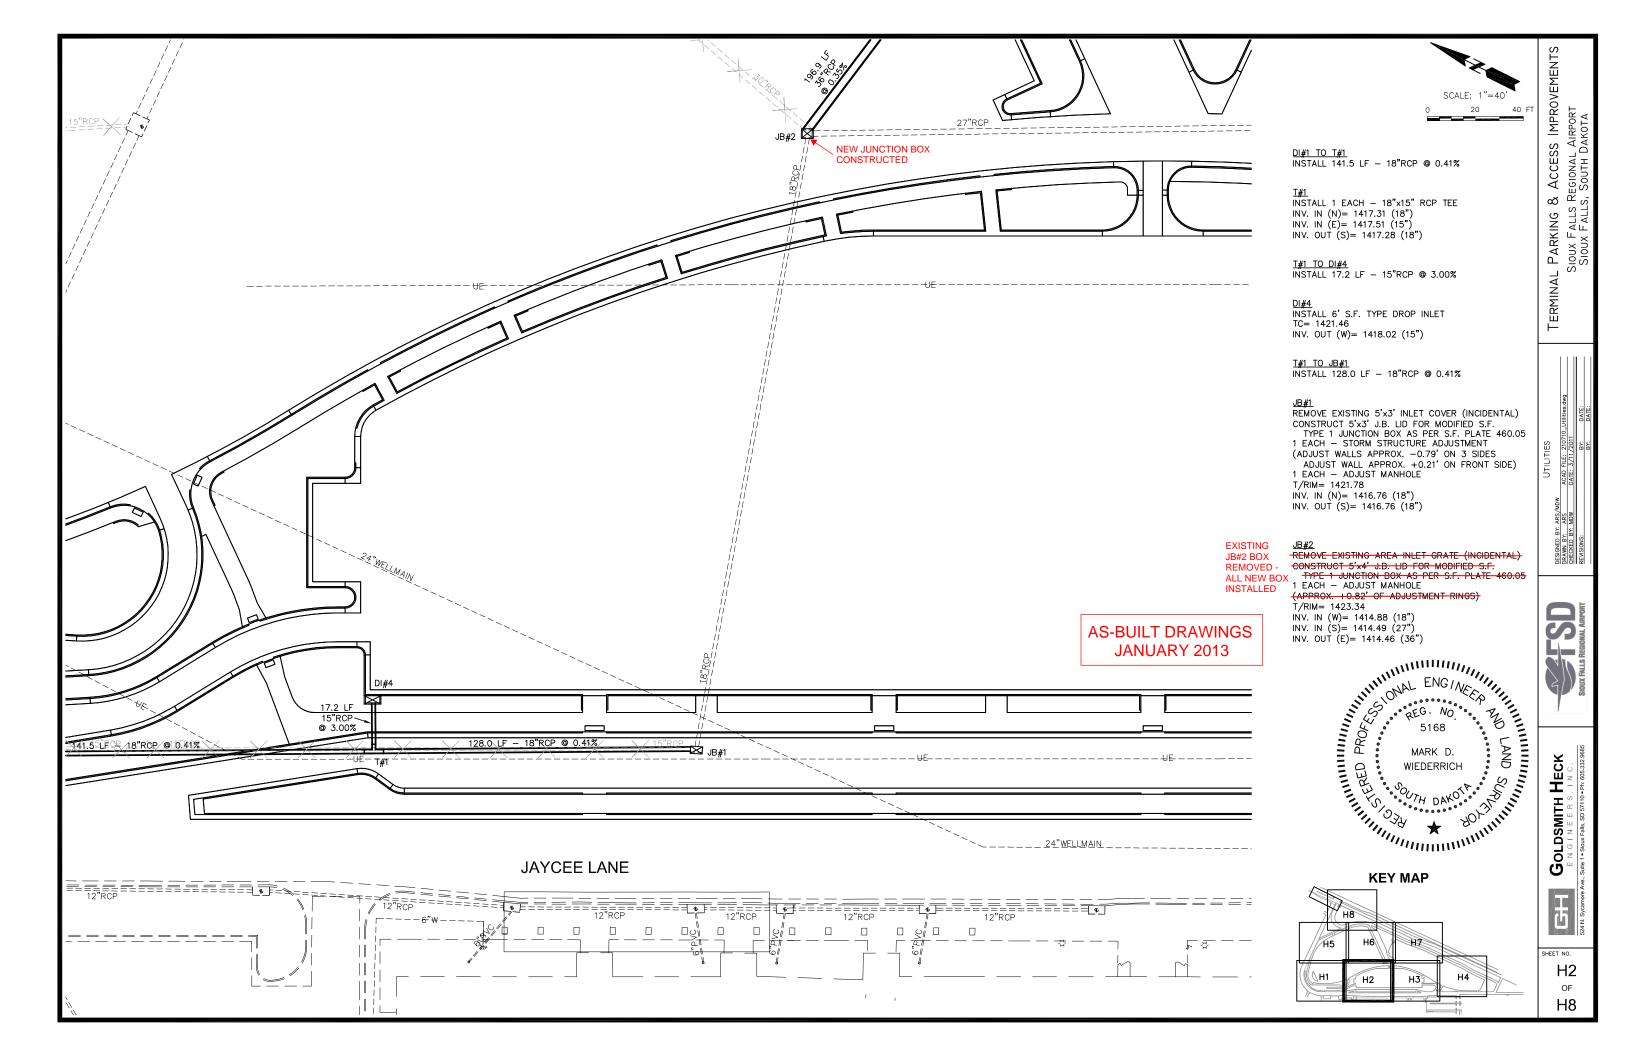


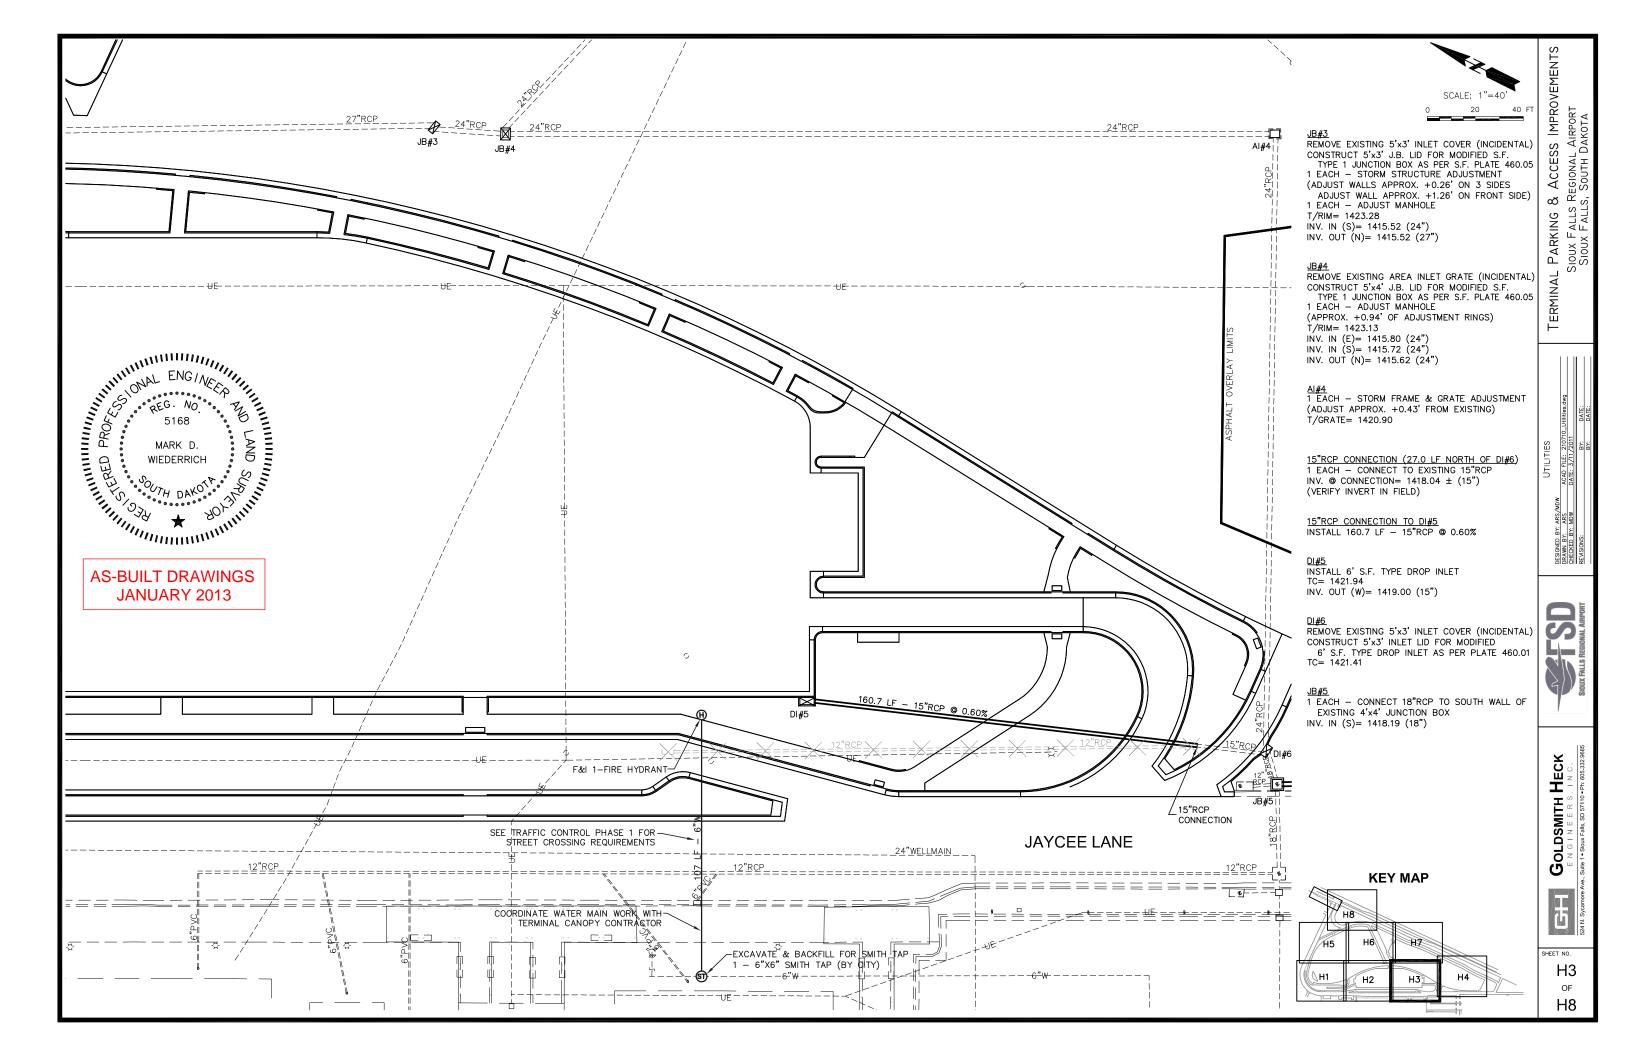


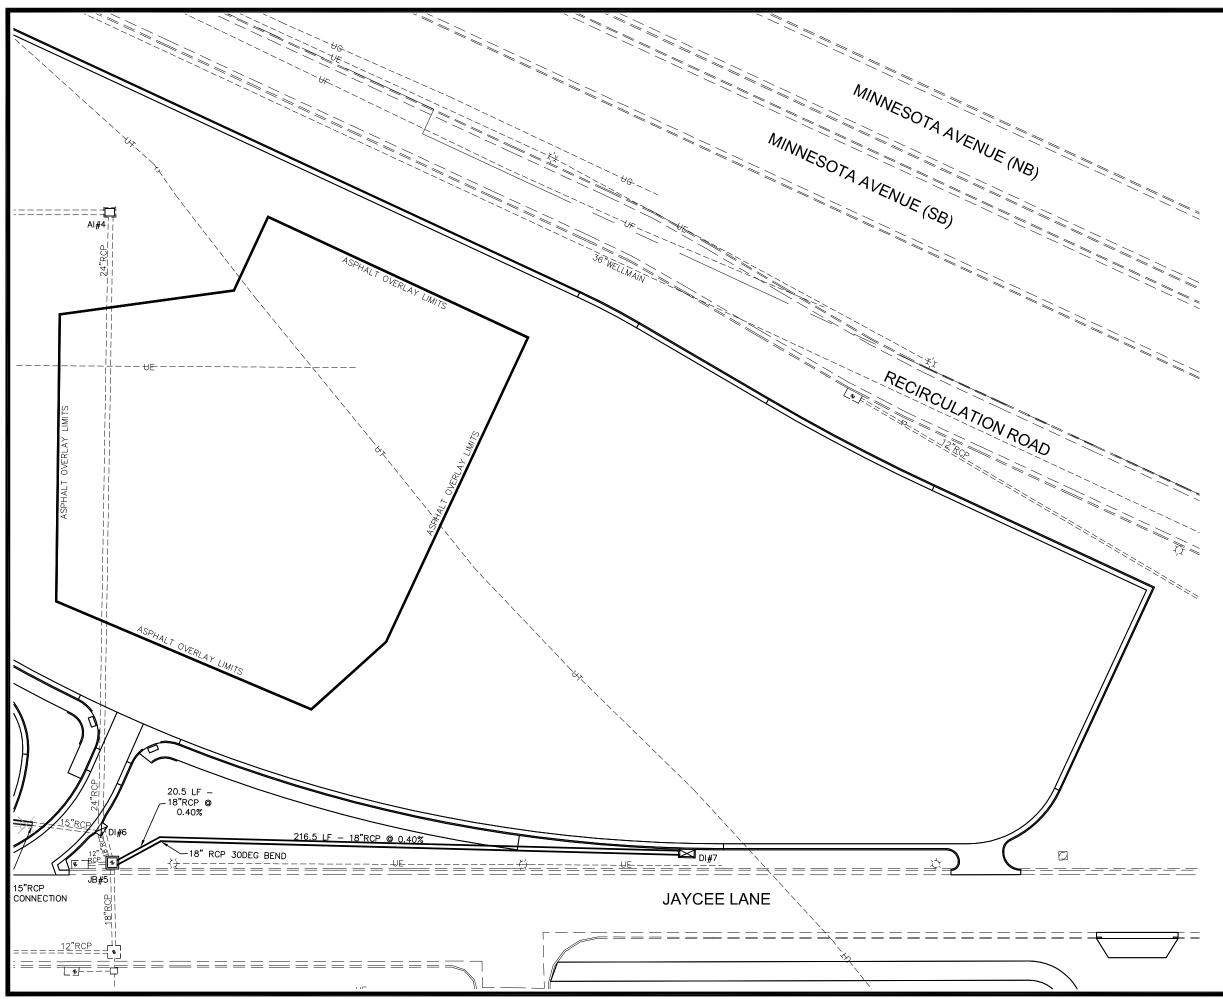


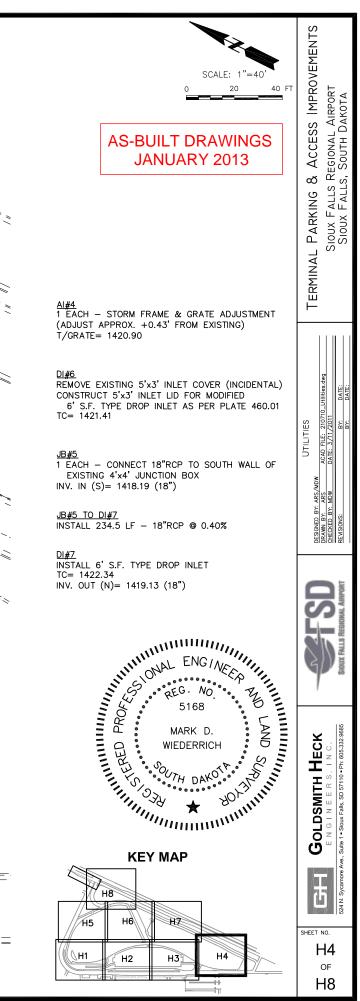


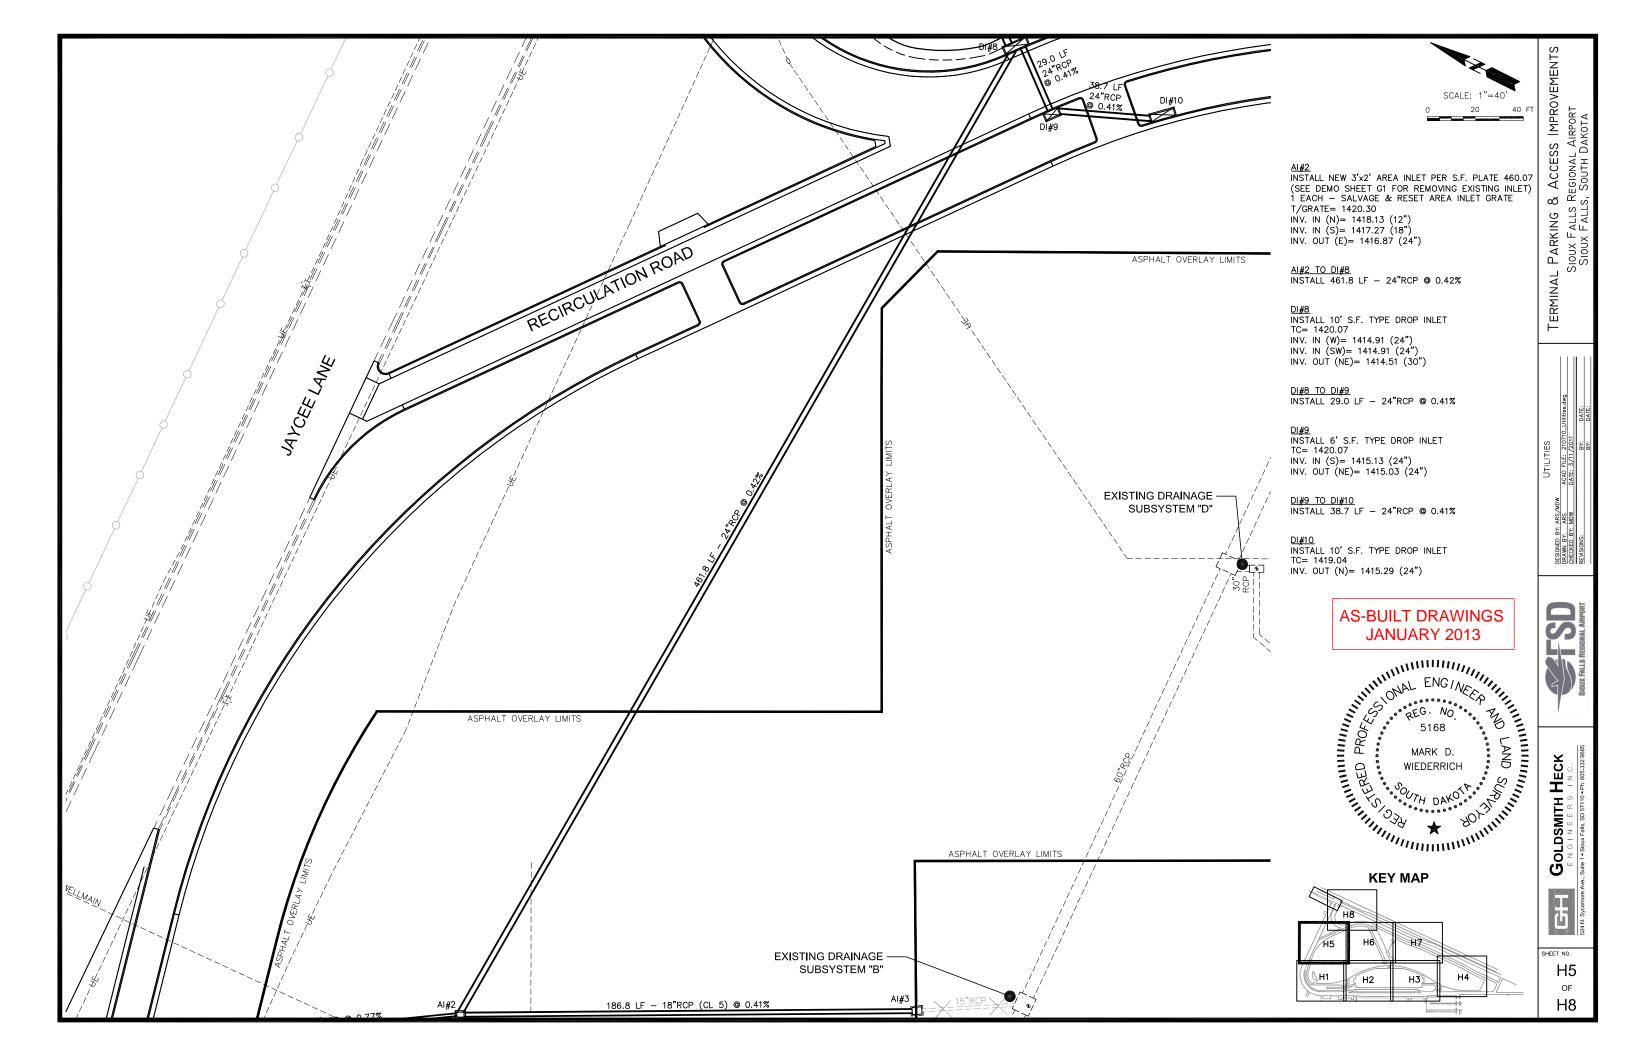


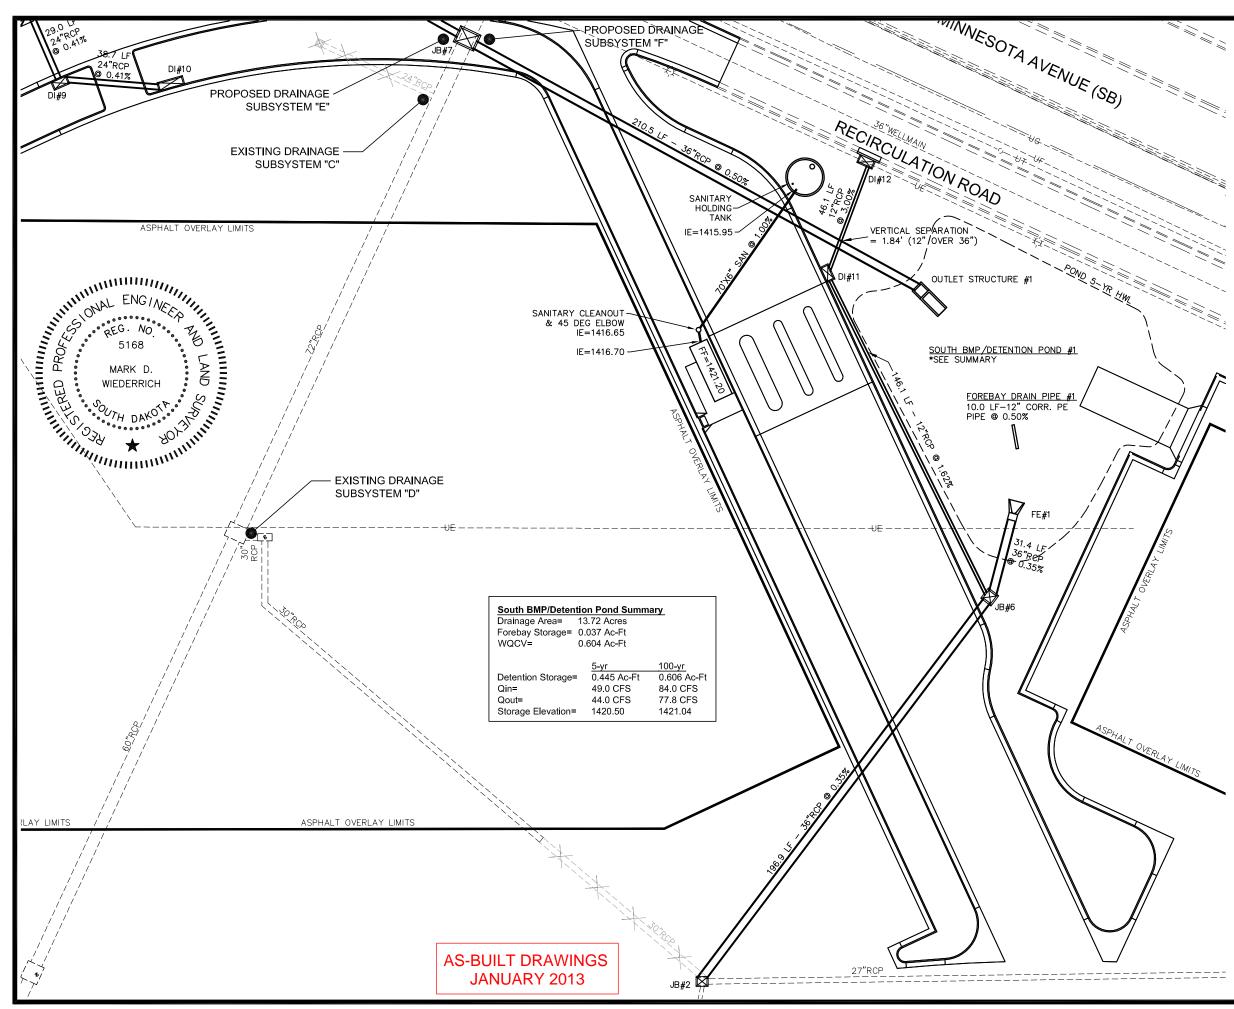


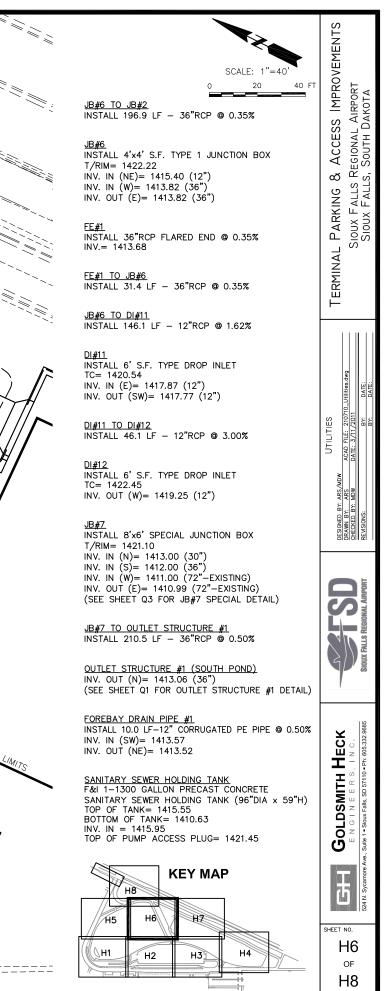


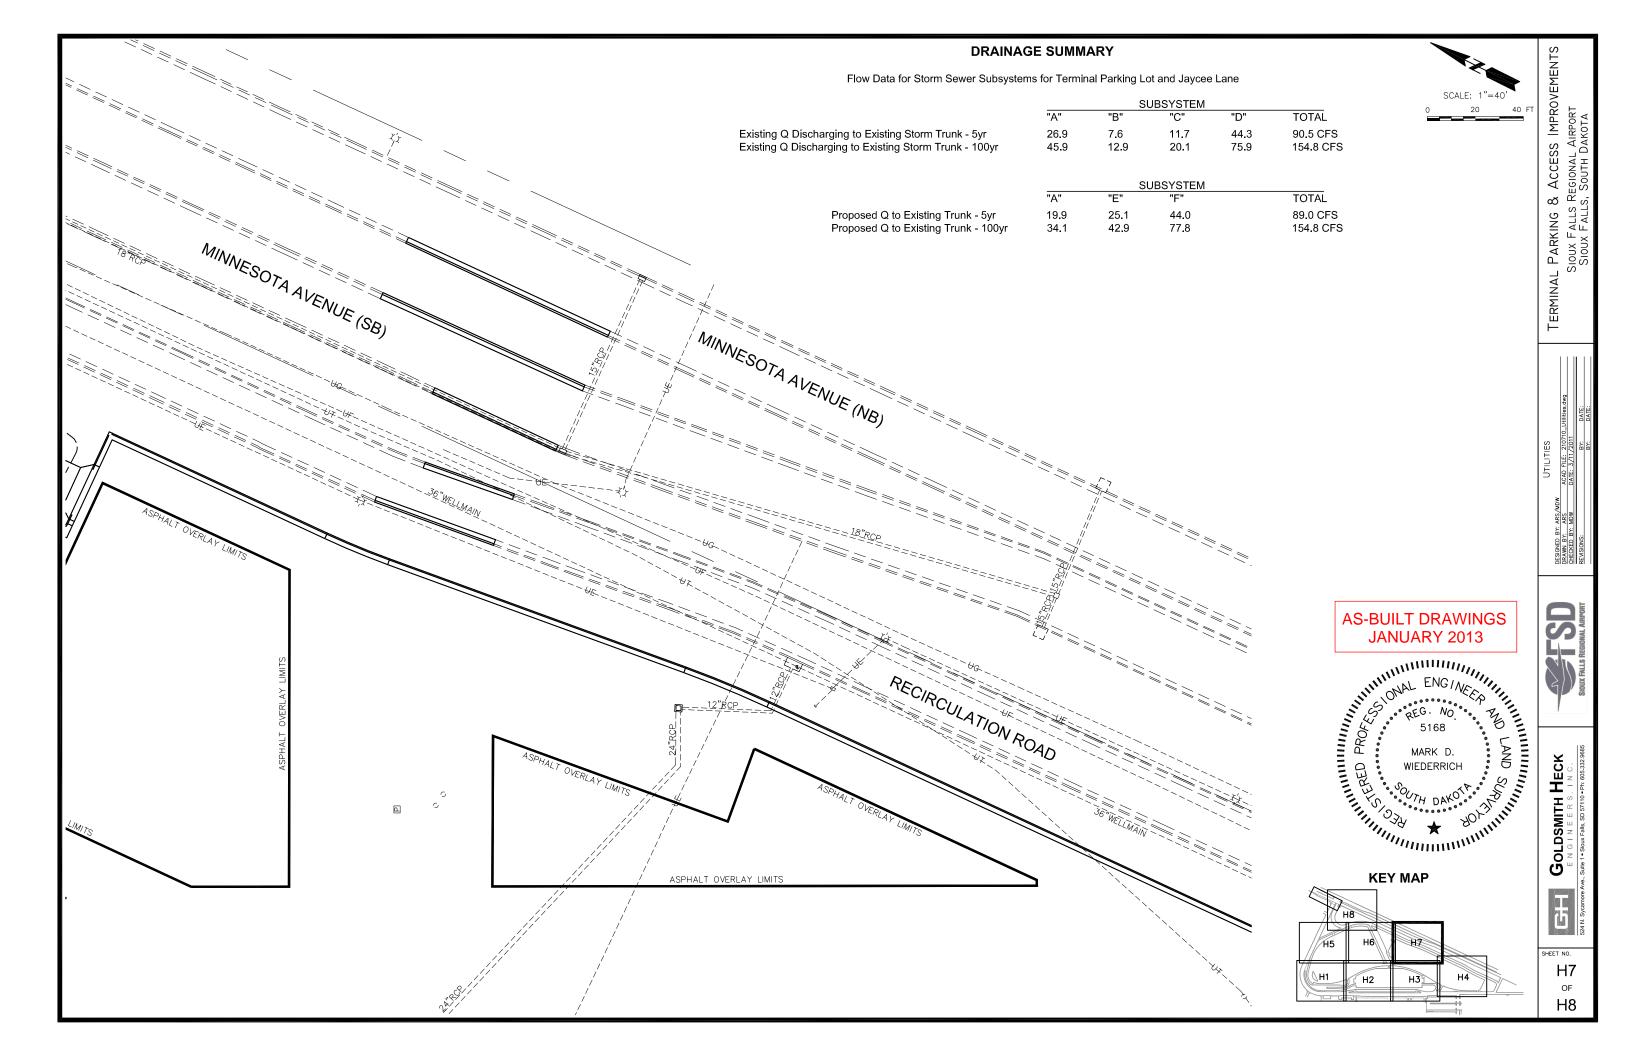


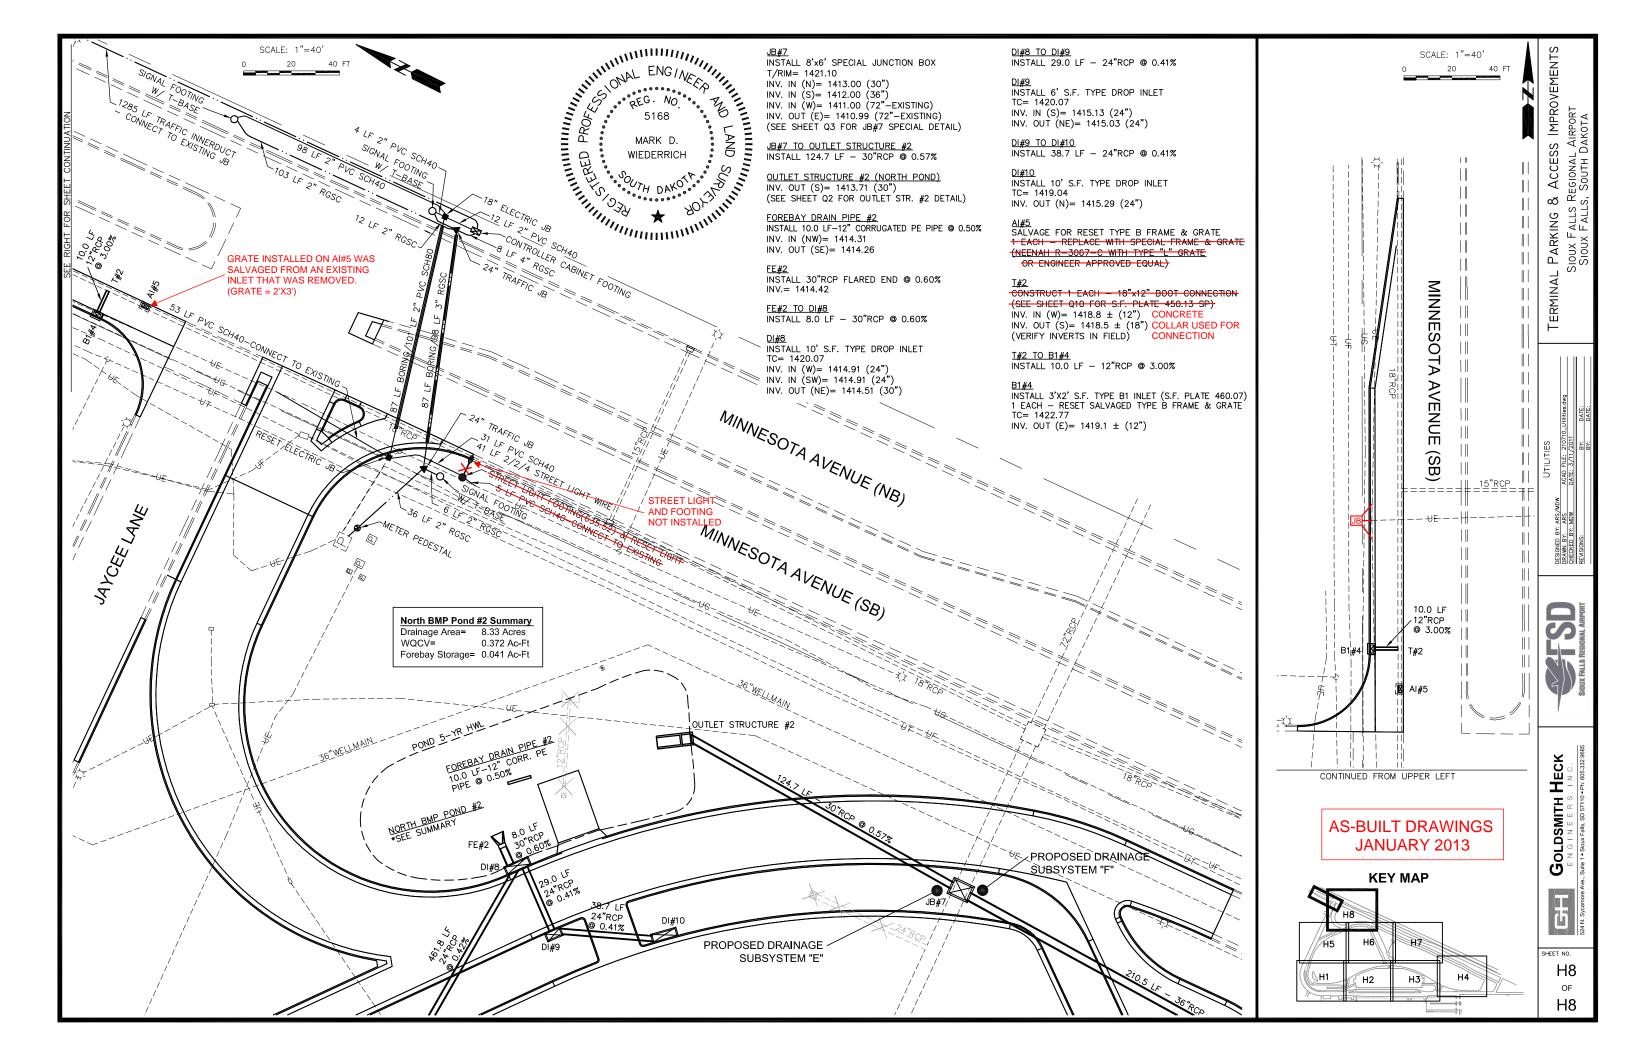

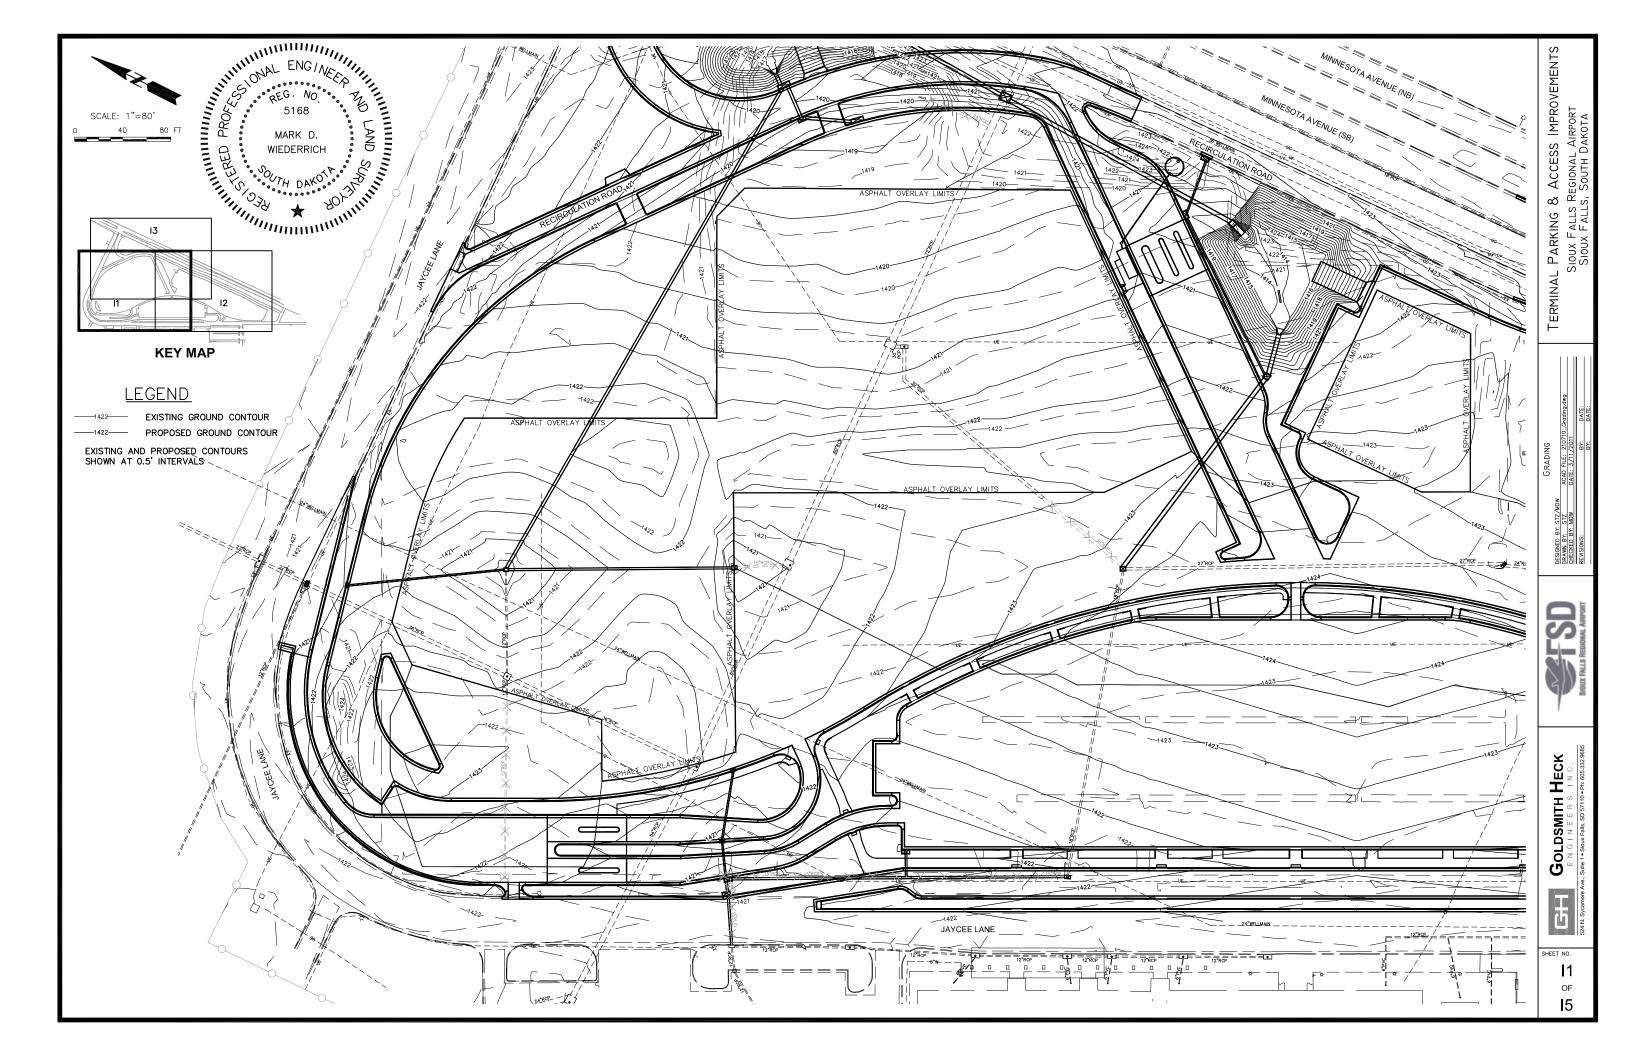

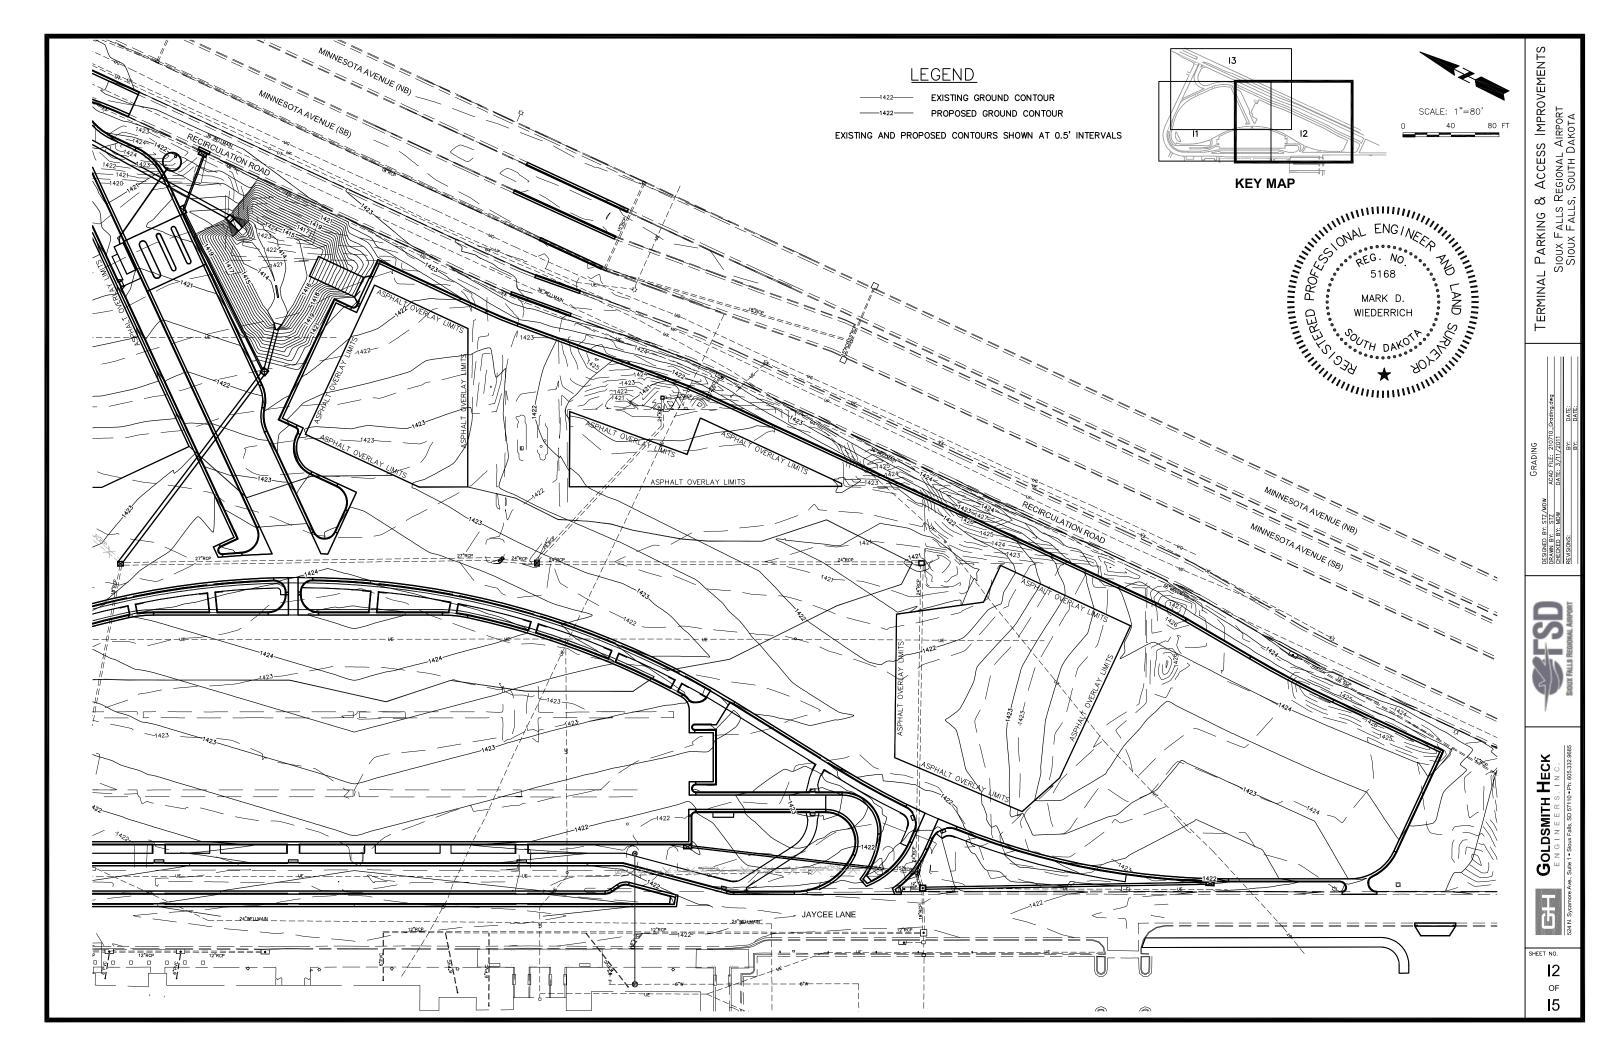

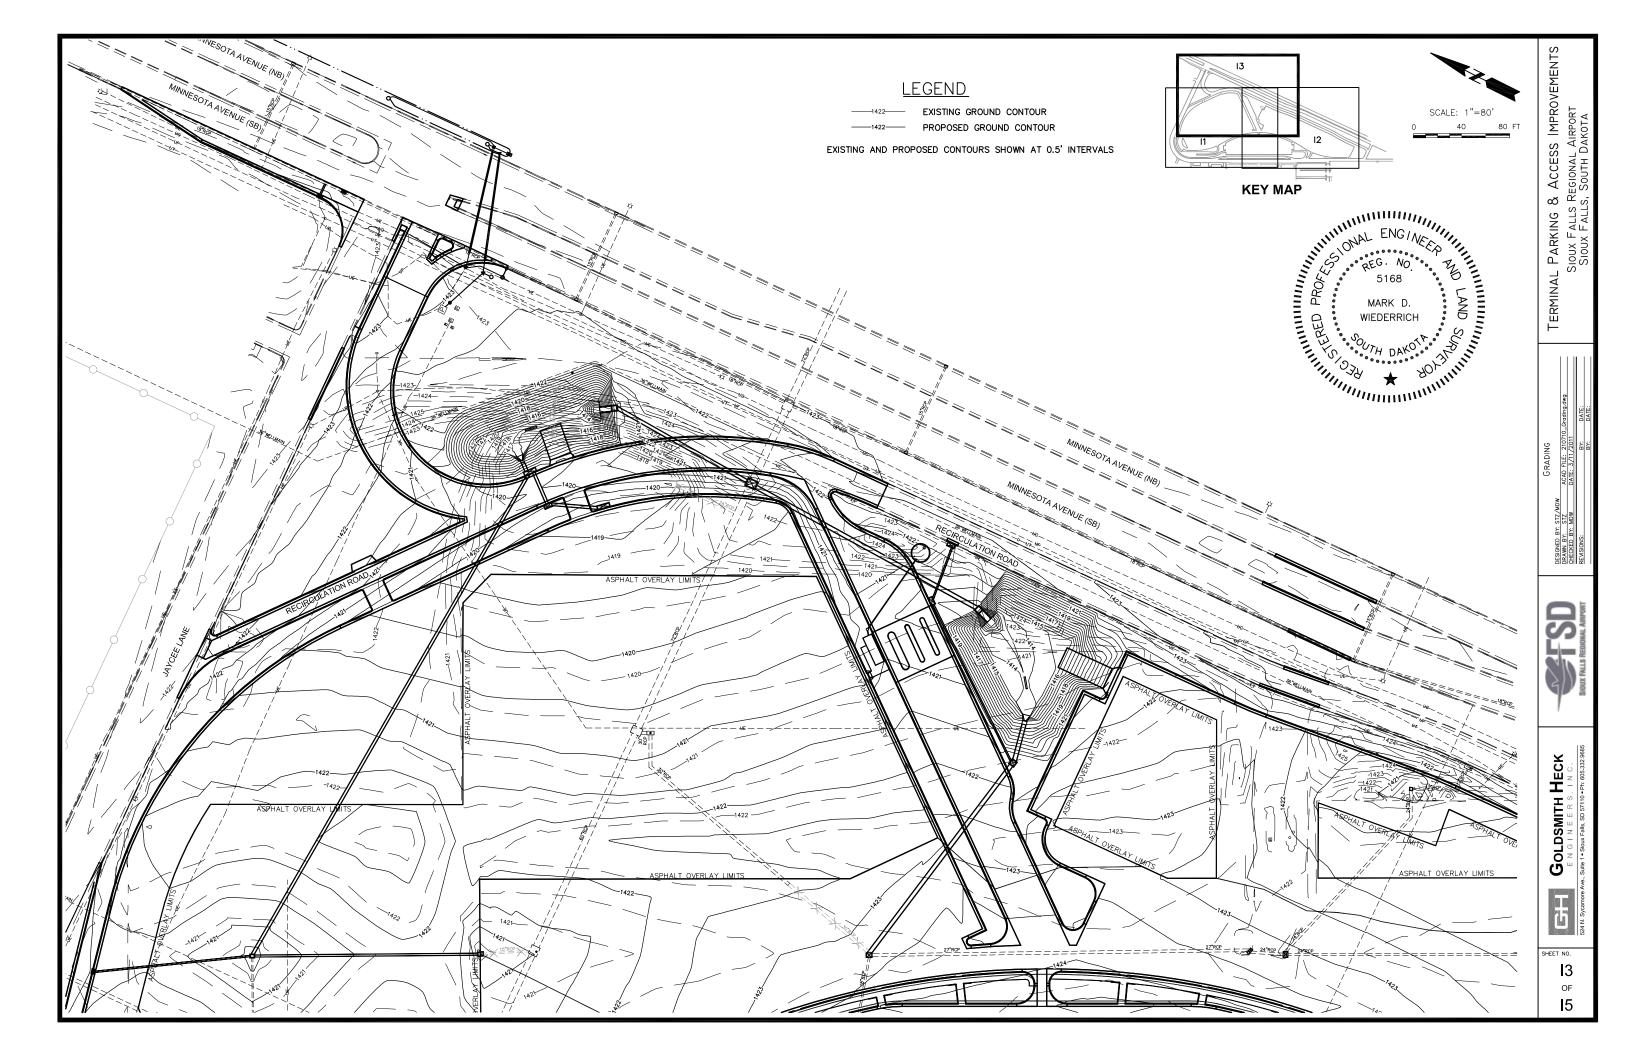

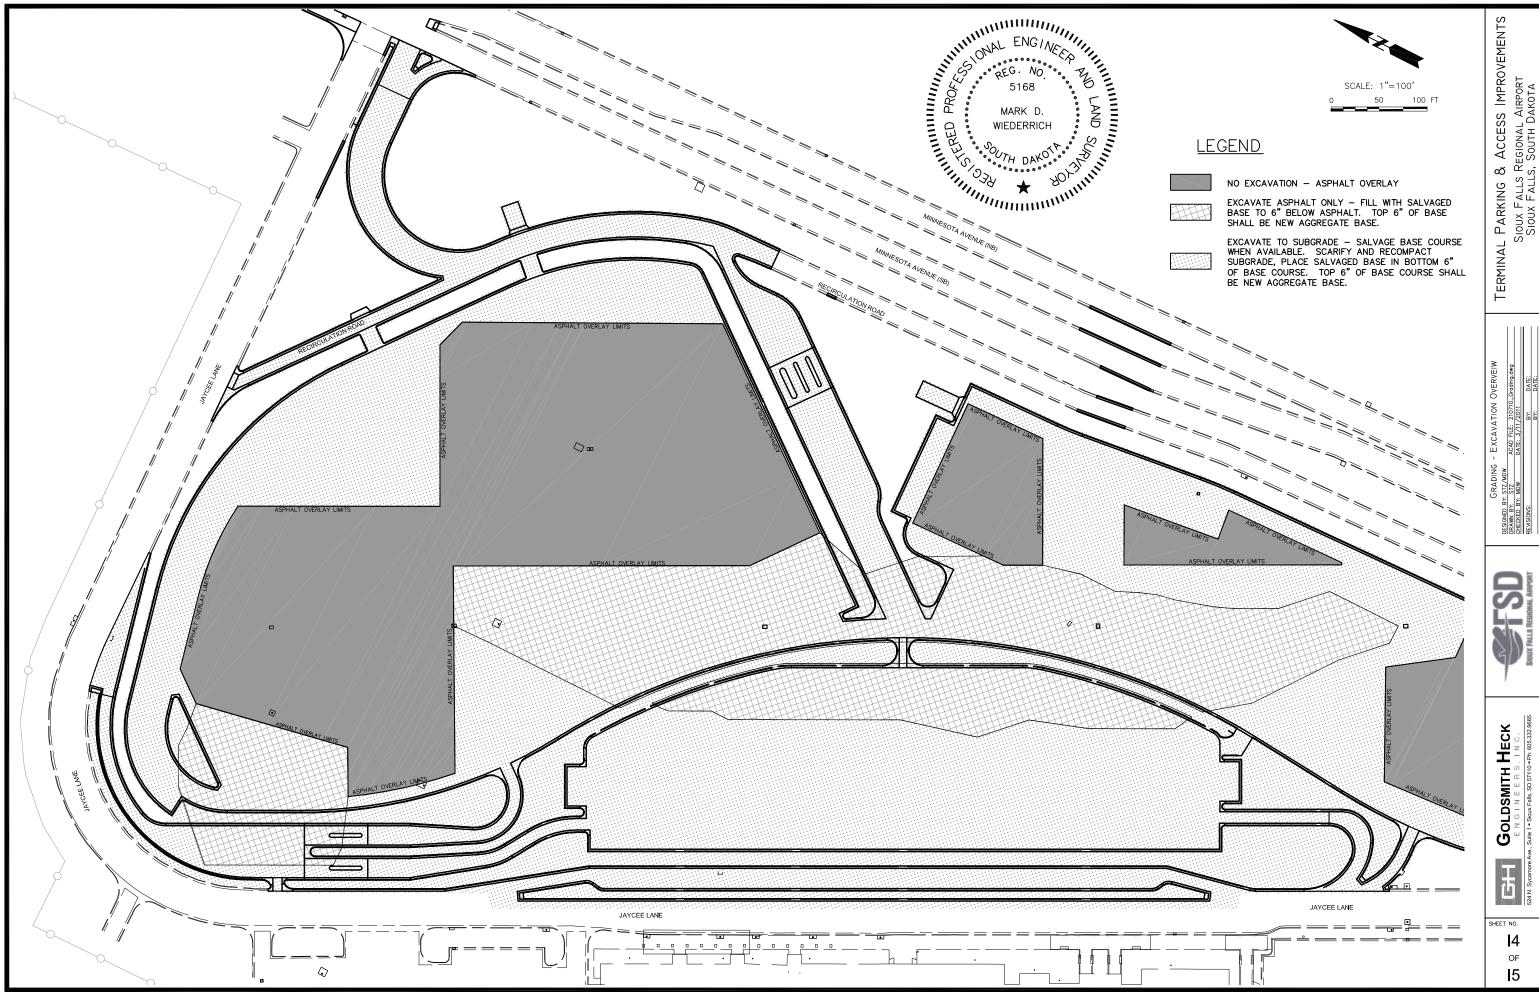



ACAD FILE: DATE: 3/1


E b

4

OF

5




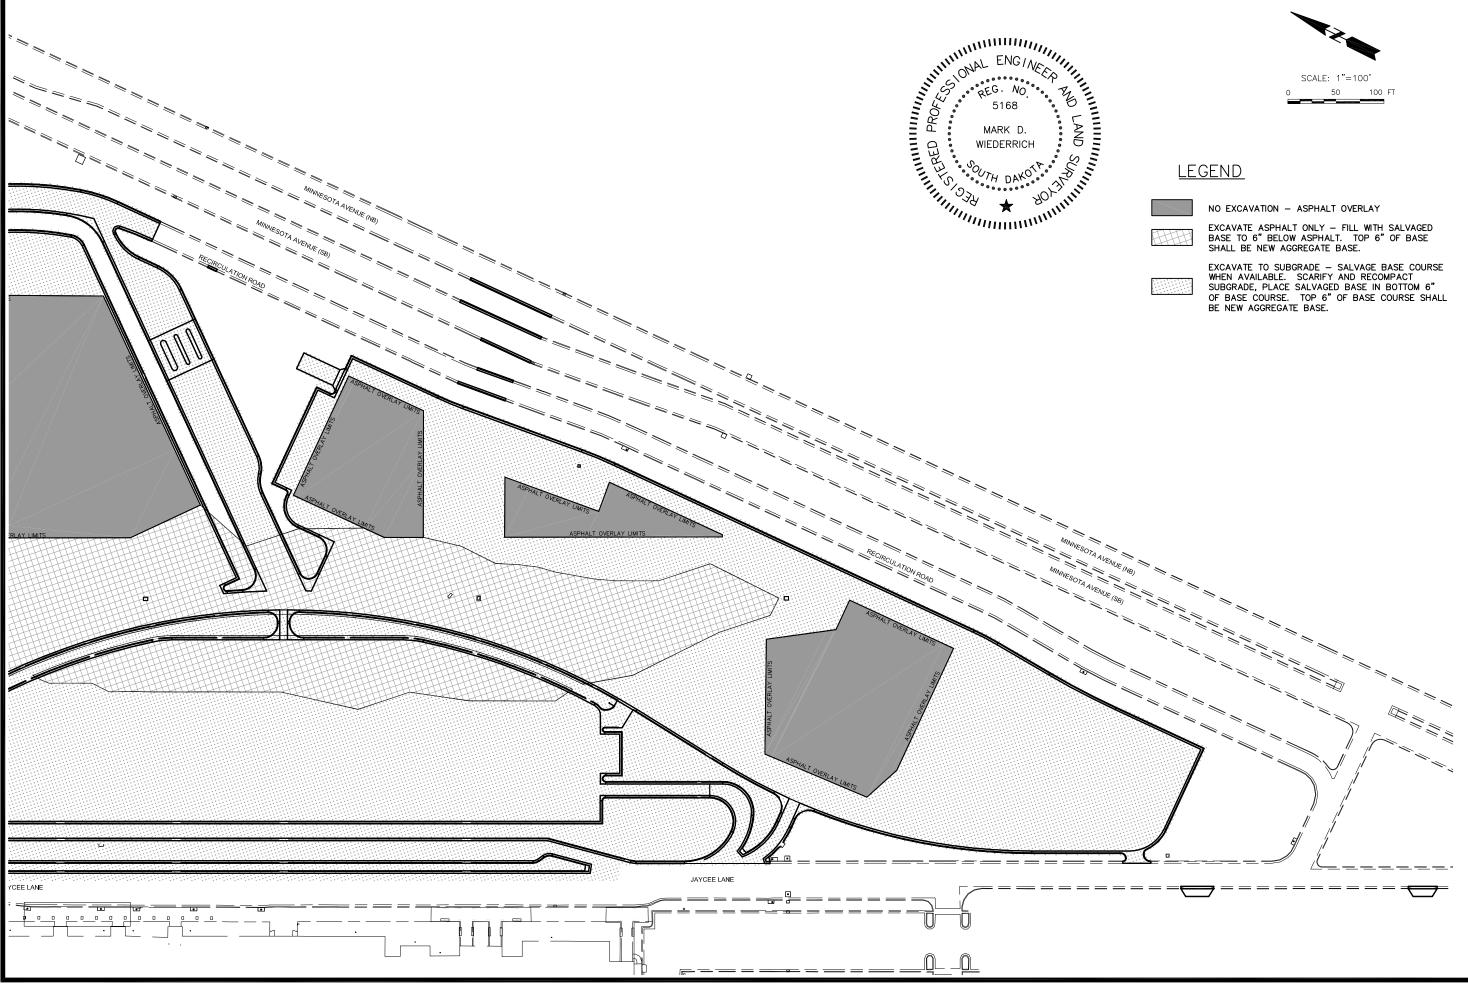











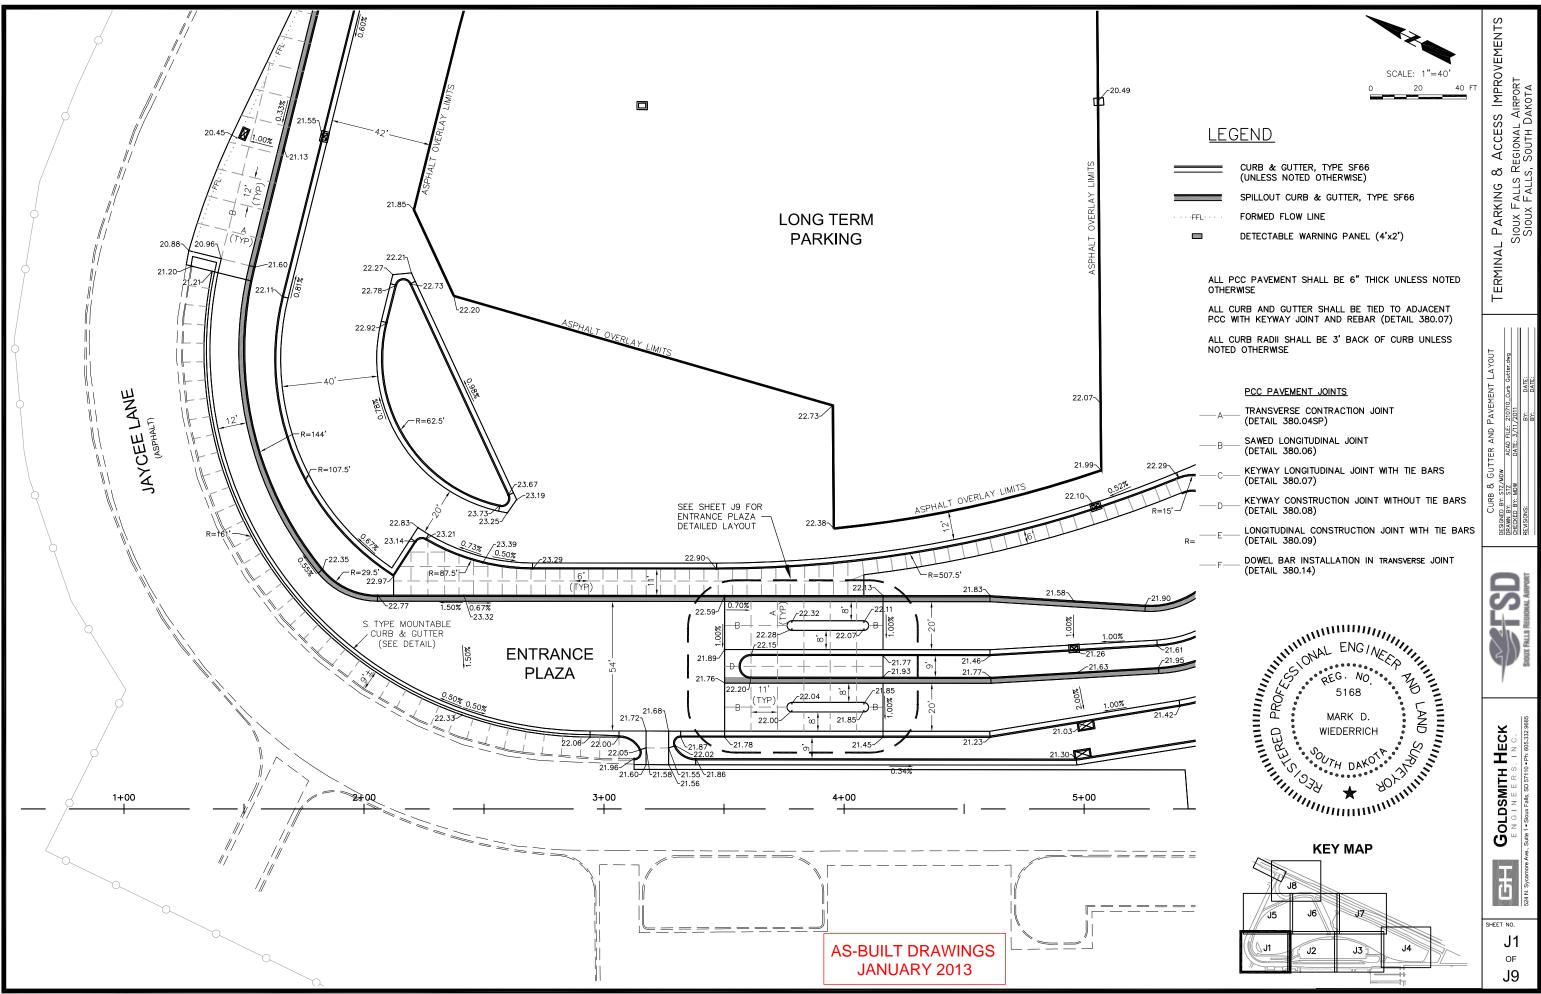

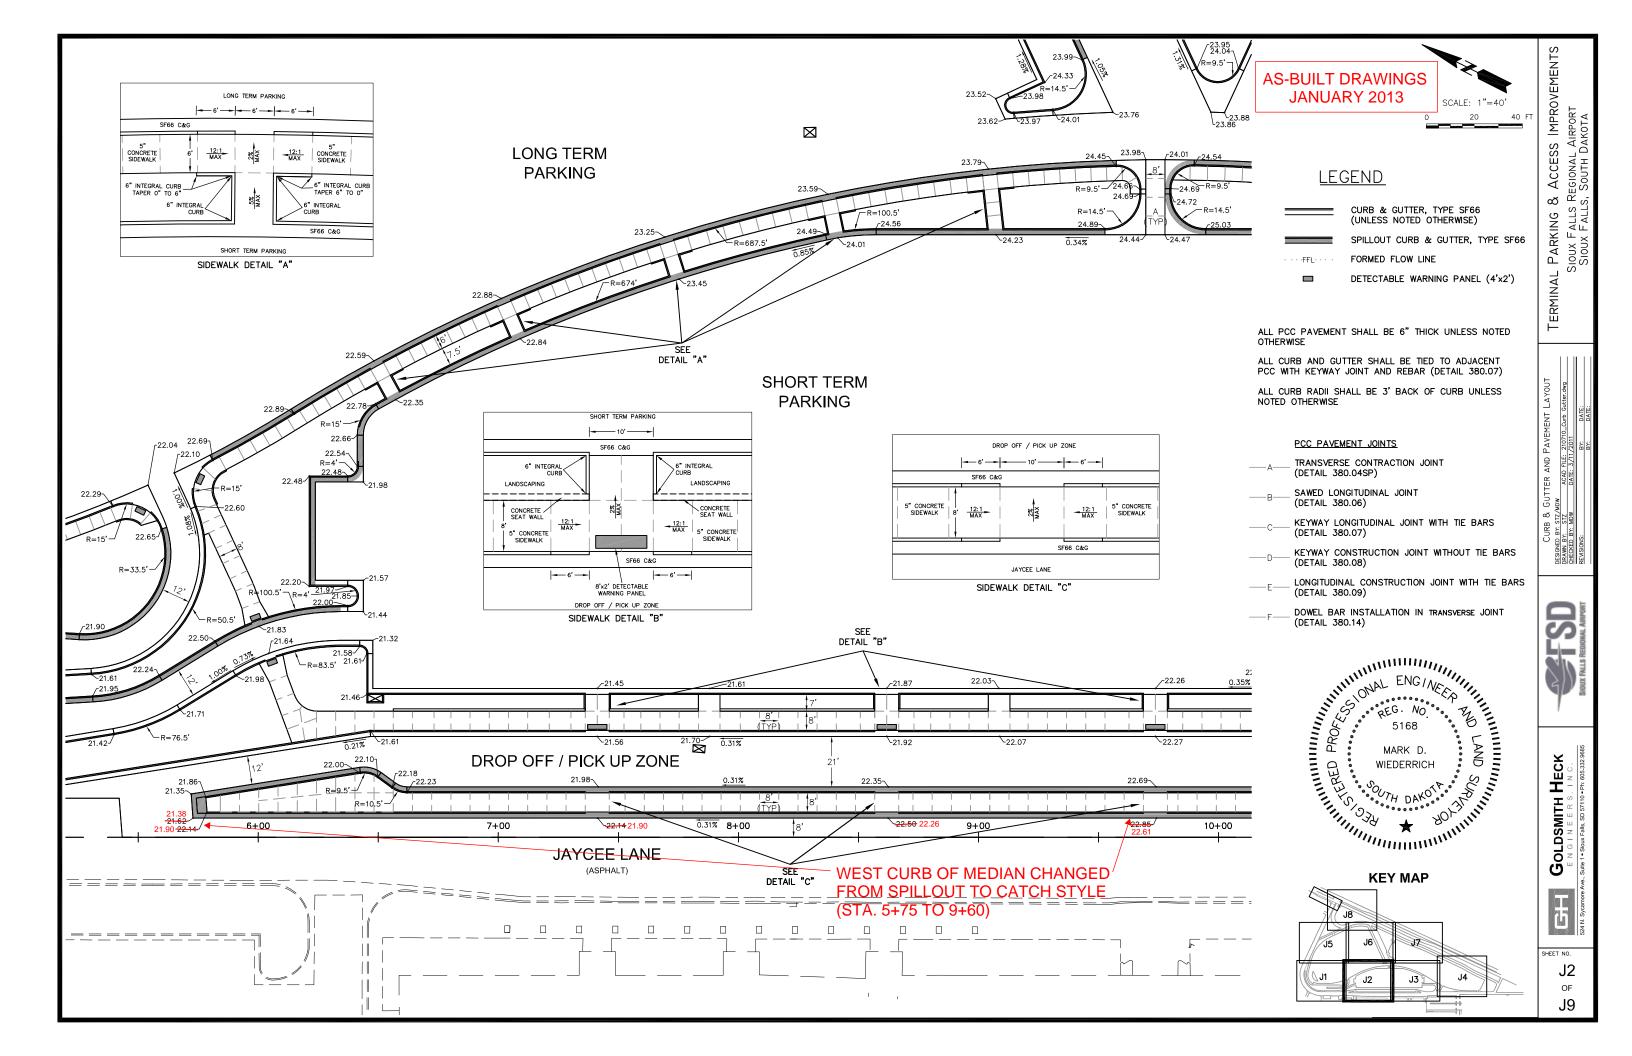


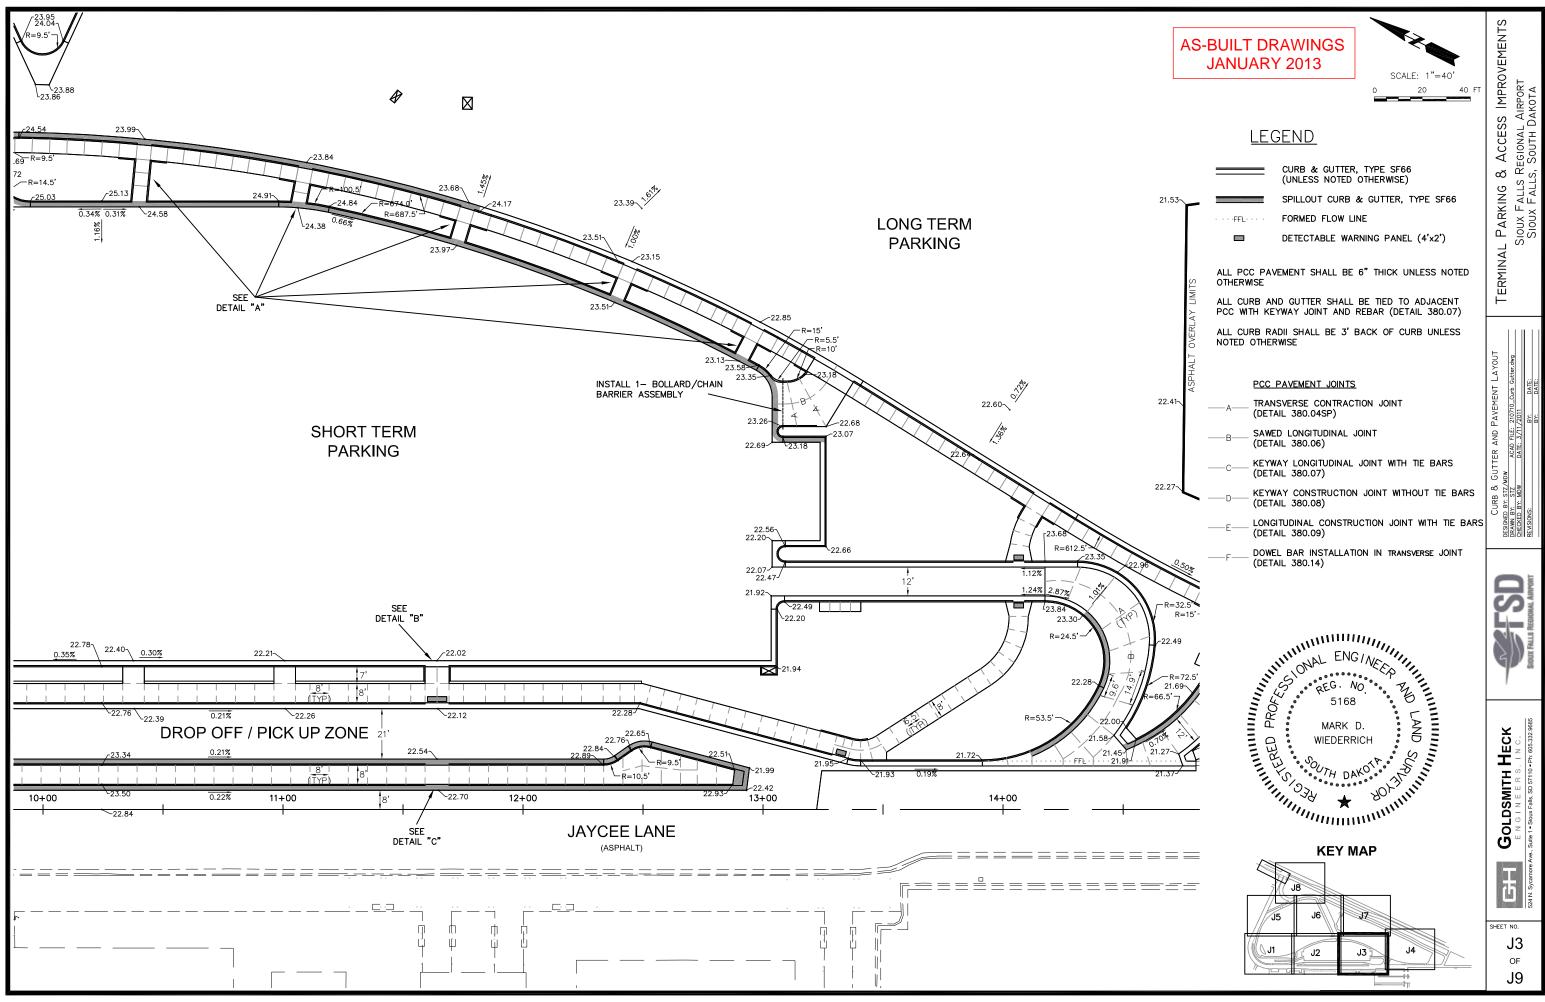


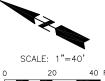

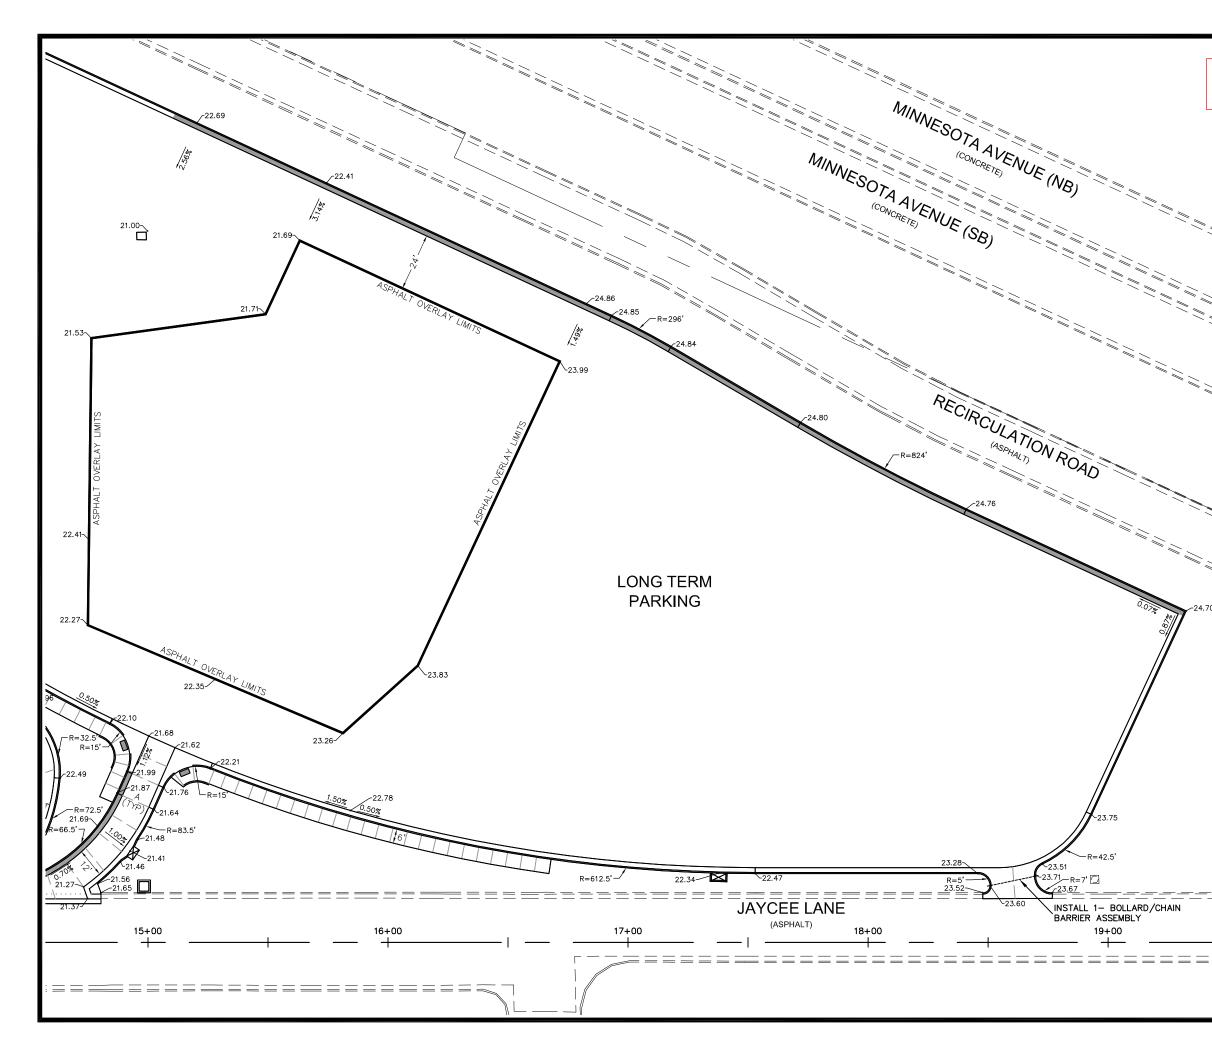



## **AS-BUILT DRAWINGS JANUARY 2013**

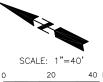

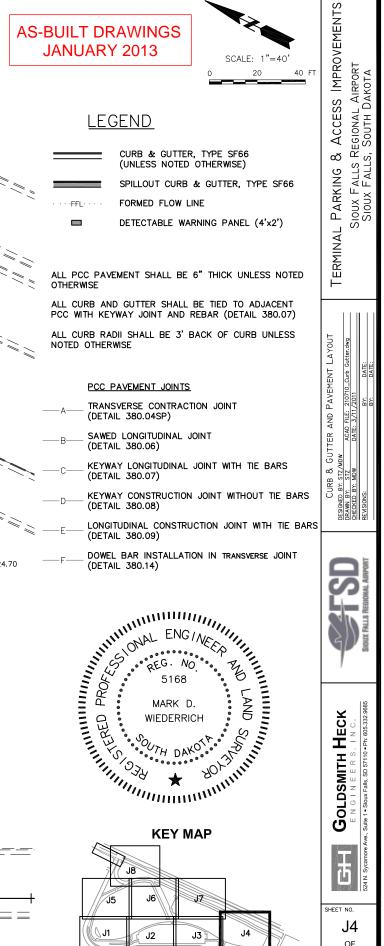

J9

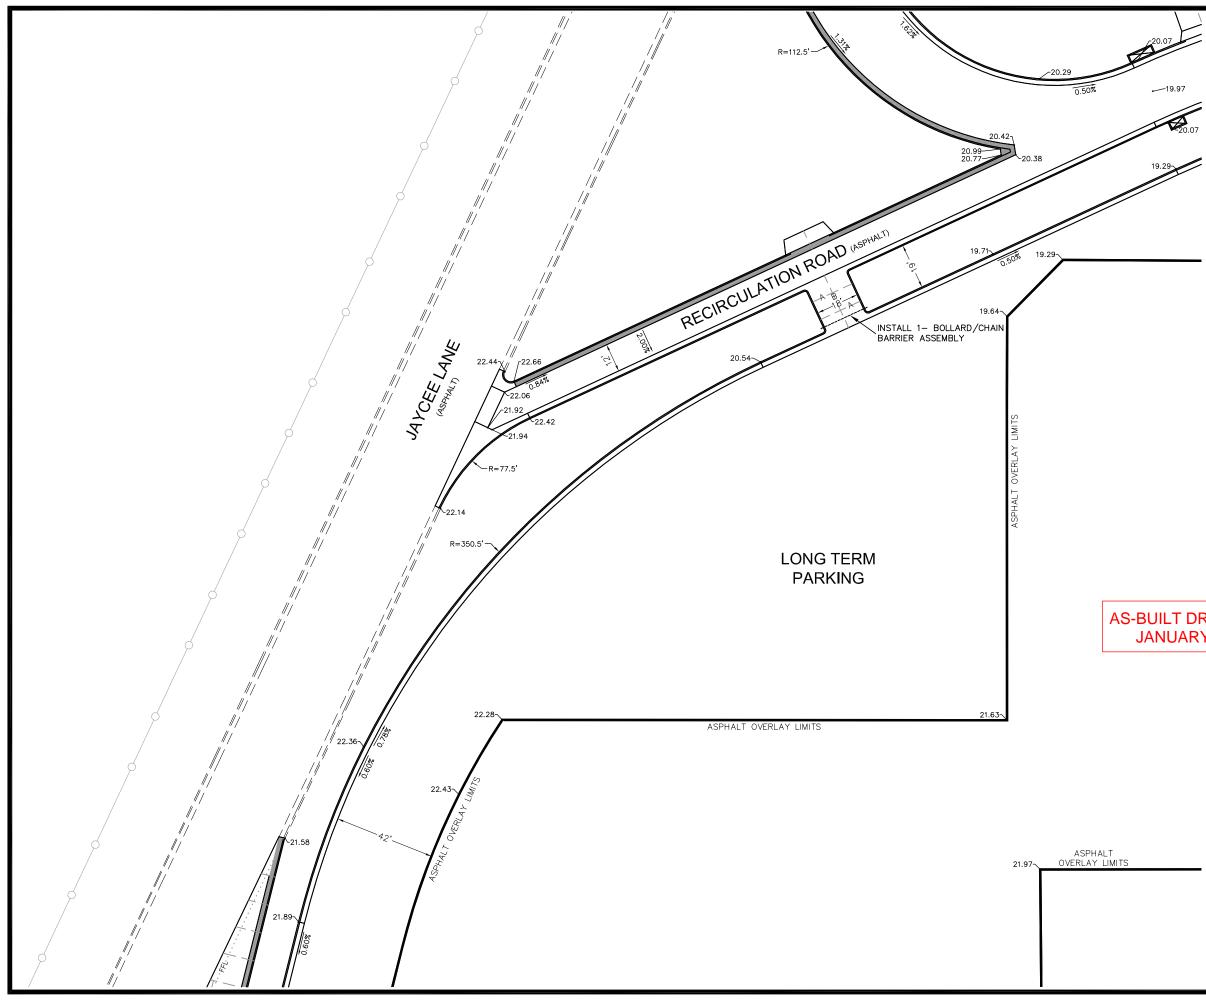

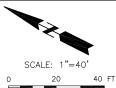

# <u>LEGEND</u>

FFL

~

CURB & GUTTER, TYPE SF66 (UNLESS NOTED OTHERWISE) SPILLOUT CURB & GUTTER, TYPE SF66 FORMED FLOW LINE

DETECTABLE WARNING PANEL (4'x2')

ALL PCC PAVEMENT SHALL BE 6" THICK UNLESS NOTED OTHERWISE


ALL CURB AND GUTTER SHALL BE TIED TO ADJACENT PCC WITH KEYWAY JOINT AND REBAR (DETAIL 380.07)

ALL CURB RADII SHALL BE 3' BACK OF CURB UNLESS NOTED OTHERWISE


### PCC PAVEMENT JOINTS

- TRANSVERSE CONTRACTION JOINT (DETAIL 380.04SP)
- SAWED LONGITUDINAL JOINT (DETAIL 380.06) ——B
- KEYWAY LONGITUDINAL JOINT WITH TIE BARS (DETAIL 380.07) \_\_\_\_C-
- KEYWAY CONSTRUCTION JOINT WITHOUT TIE BARS —\_\_\_\_D-(DETAIL 380.08)
- \_ LONGITUDINAL CONSTRUCTION JOINT WITH TIE BARS (DETAIL 380.09) \_\_\_\_\_F
- DOWEL BAR INSTALLATION IN TRANSVERSE JOINT (DETAIL 380.14) — F-

## **AS-BUILT DRAWINGS JANUARY 2013**

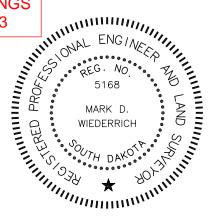



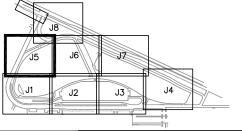

ACCESS IMPROVEMENTS SIOUX FALLS REGIONAL AIRPORT SIOUX FALLS, SOUTH DAKOTA ø Terminal Parking РАУЕМЕНТ LAYOU AND





ШĽ




b SHEET NO. J5 OF

J9

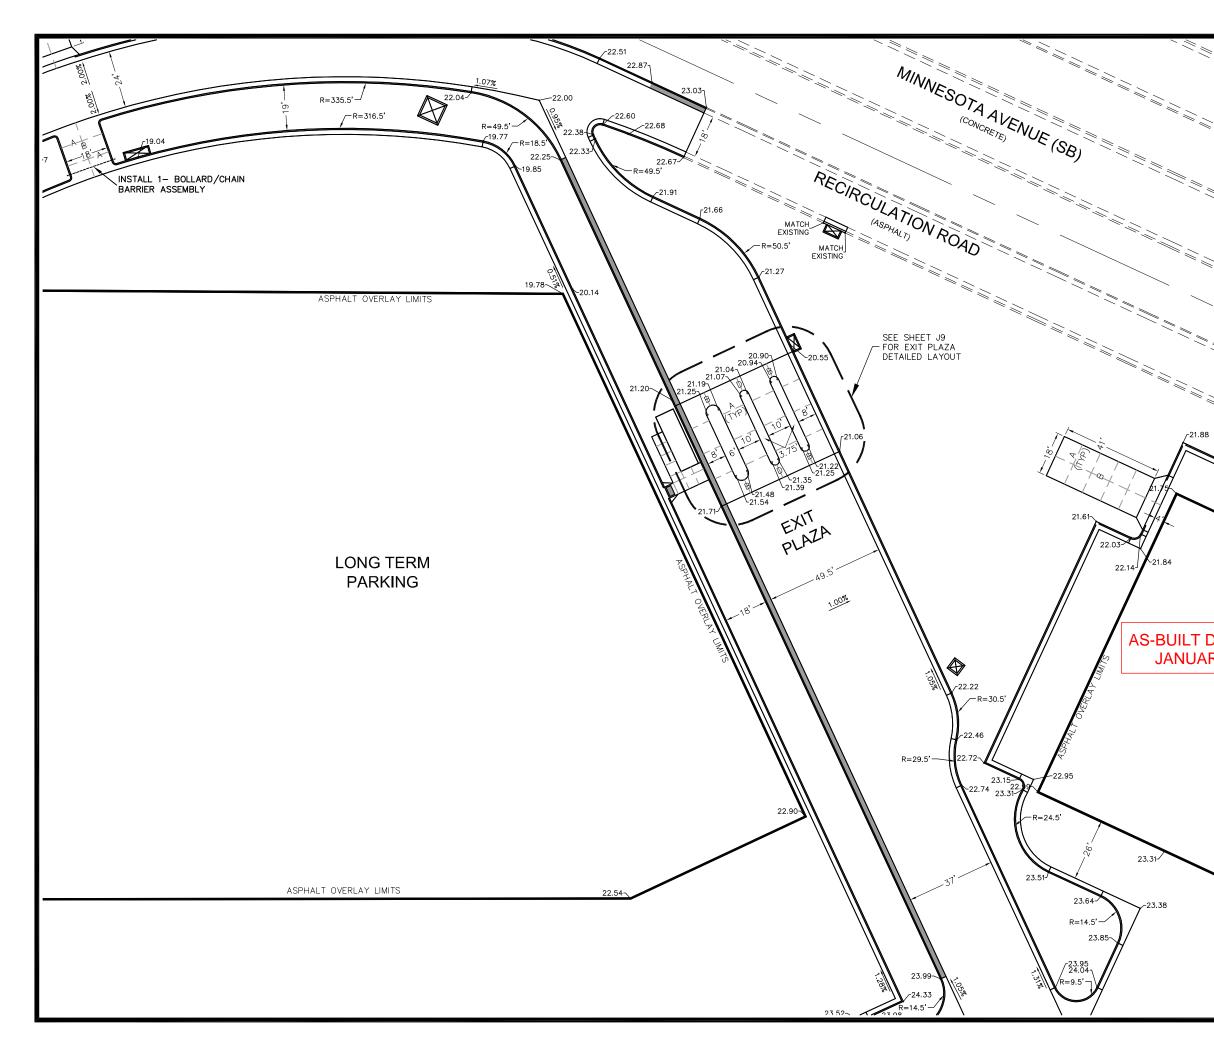

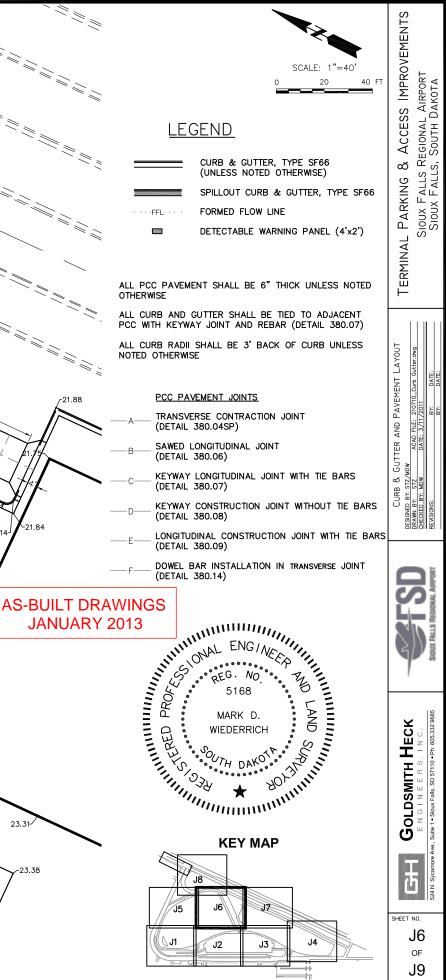

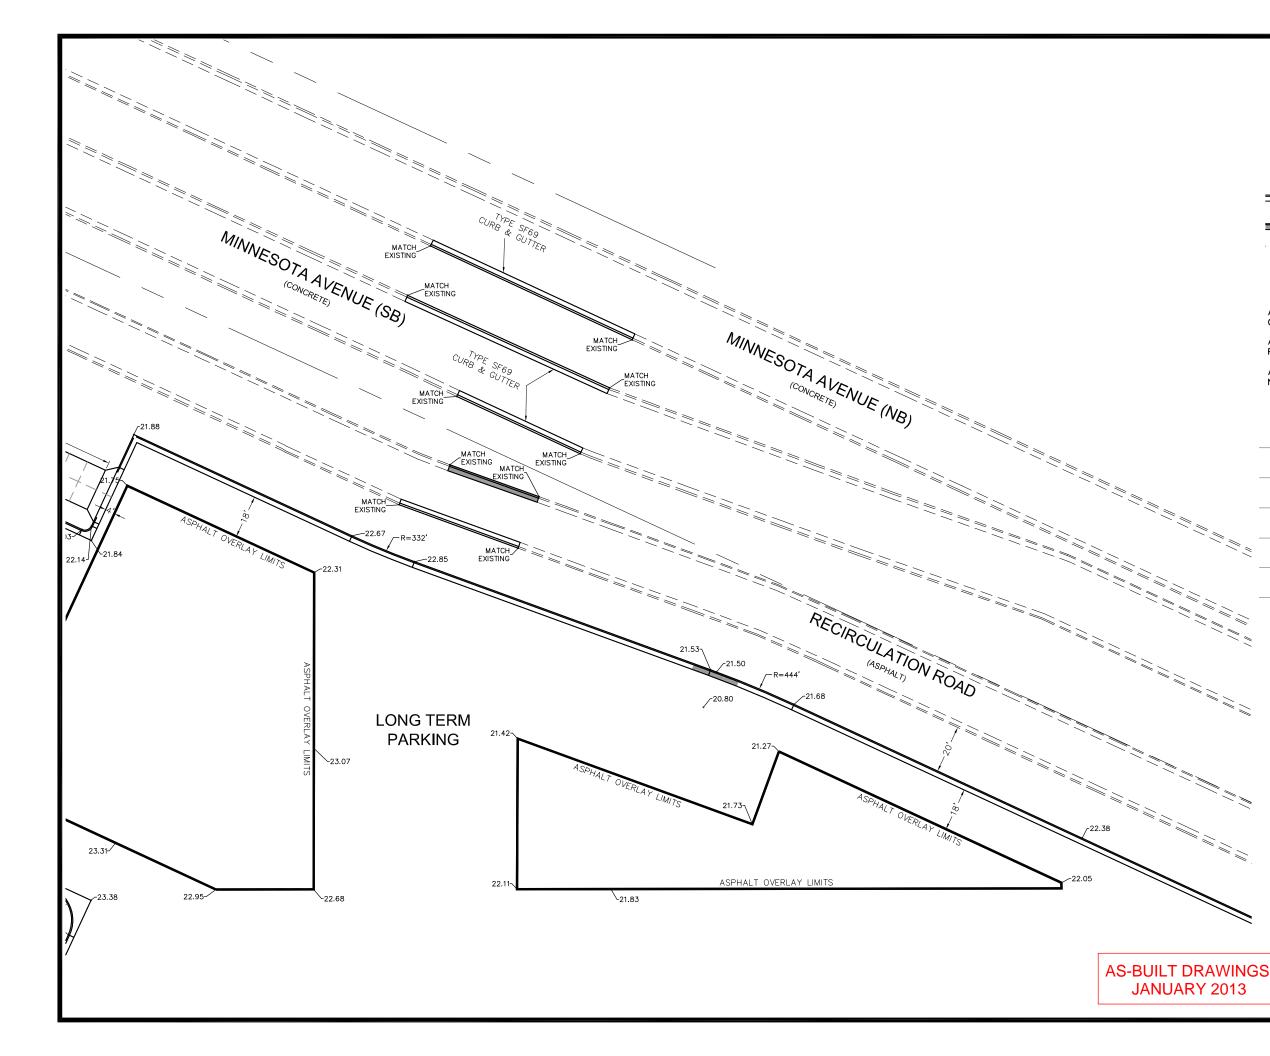



**MPROVEMENTS** 

- PARKING & ACCESS IMPR SIOUX FALLS REGIONAL AIRPORT SIOUX FALLS, SOUTH DAKOTA

Terminal

LAYOUT

PAVEMENT |

AND

ЦШ

URB & BY: STZ/ SY: STZ BY: MDW

 $\overline{\mathbf{S}}$ 

GOLDSMITH HECK

H.

Ð

SHEET NO. J7

> ₀ J9

DESIGNED E DRAWN BY: CHECKED B REVISIONS:

# <u>LEGEND</u>

	CURB & GUTTER, TYPE SF66 (UNLESS NOTED OTHERWISE)
	SPILLOUT CURB & GUTTER, TYPE SF66
· · · ·FFL· · · ·	FORMED FLOW LINE
	DETECTABLE WARNING PANEL (4'x2')


ALL PCC PAVEMENT SHALL BE 6" THICK UNLESS NOTED OTHERWISE


ALL CURB AND GUTTER SHALL BE TIED TO ADJACENT PCC WITH KEYWAY JOINT AND REBAR (DETAIL 380.07)


ALL CURB RADII SHALL BE 3' BACK OF CURB UNLESS NOTED OTHERWISE


### PCC PAVEMENT JOINTS


- A TRANSVERSE CONTRACTION JOINT (DETAIL 380.04SP)
- B-B-BAWED LONGITUDINAL JOINT (DETAIL 380.06)
- \_\_\_\_C\_\_\_ KEYWAY LONGITUDINAL JOINT WITH TIE BARS (DETAIL 380.07)
- E---- LONGITUDINAL CONSTRUCTION JOINT WITH TIE BARS (DETAIL 380.09)
- F----- DOWEL BAR INSTALLATION IN TRANSVERSE JOINT (DETAIL 380.14)

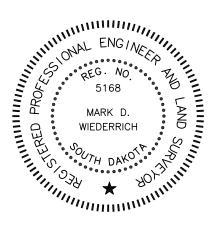


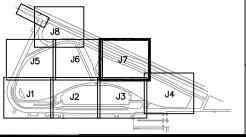


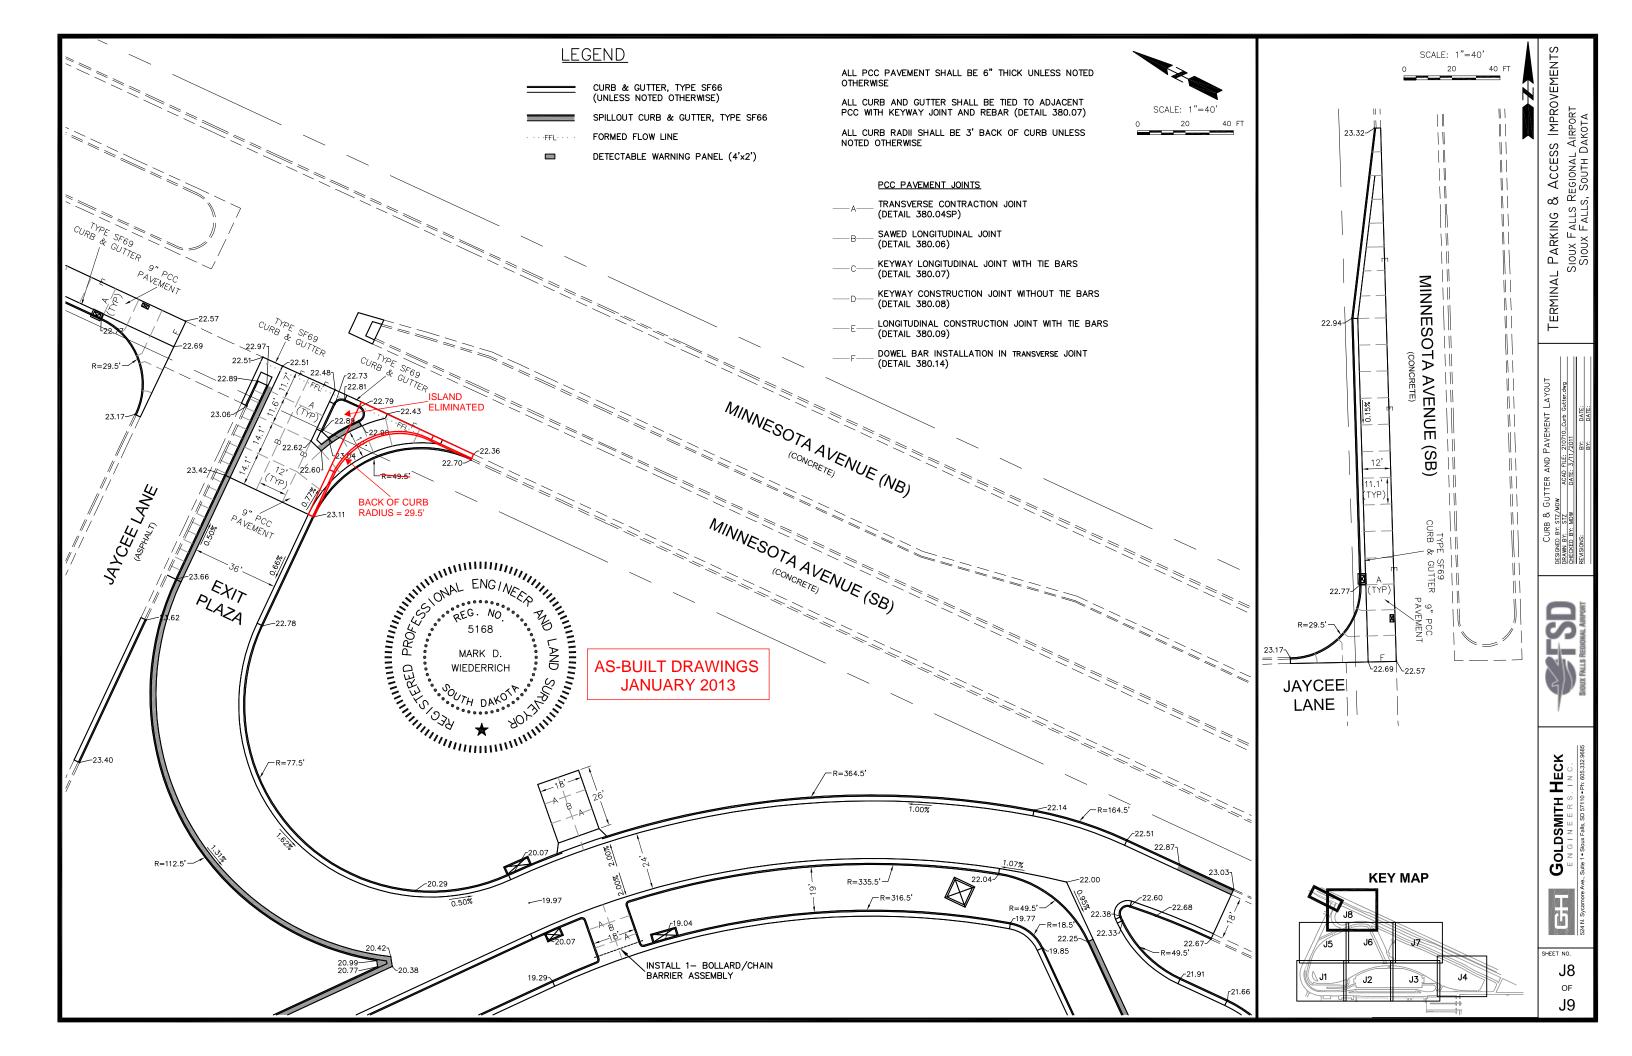

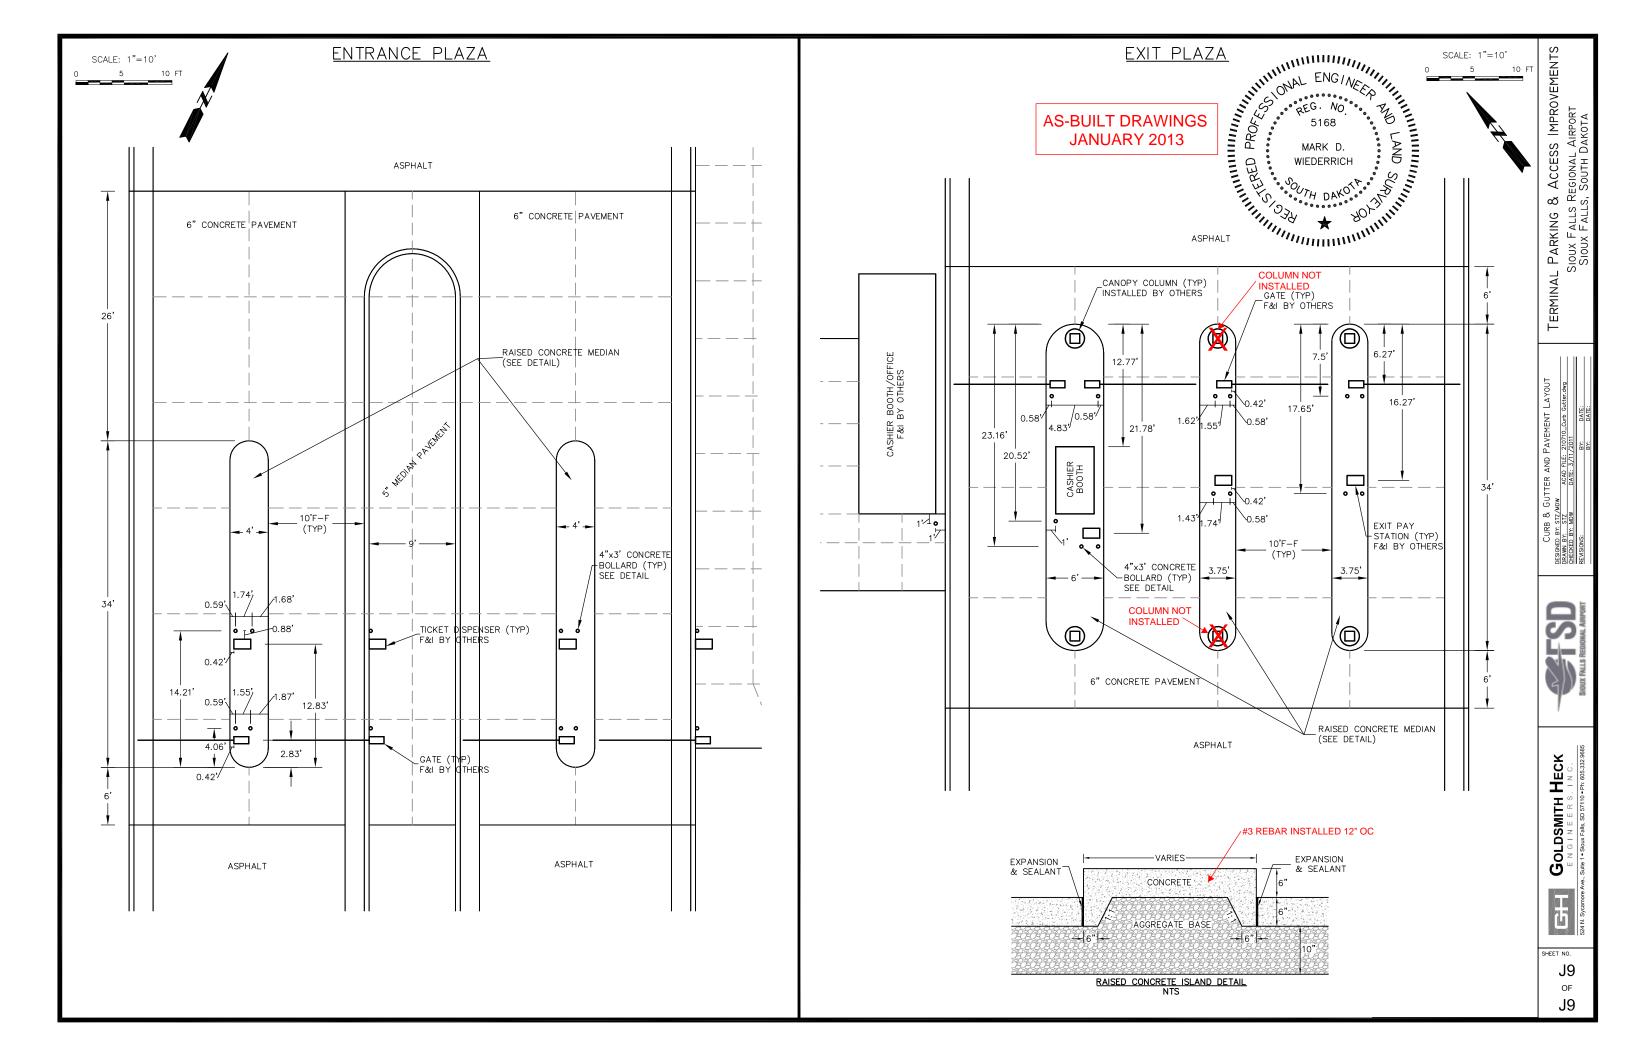

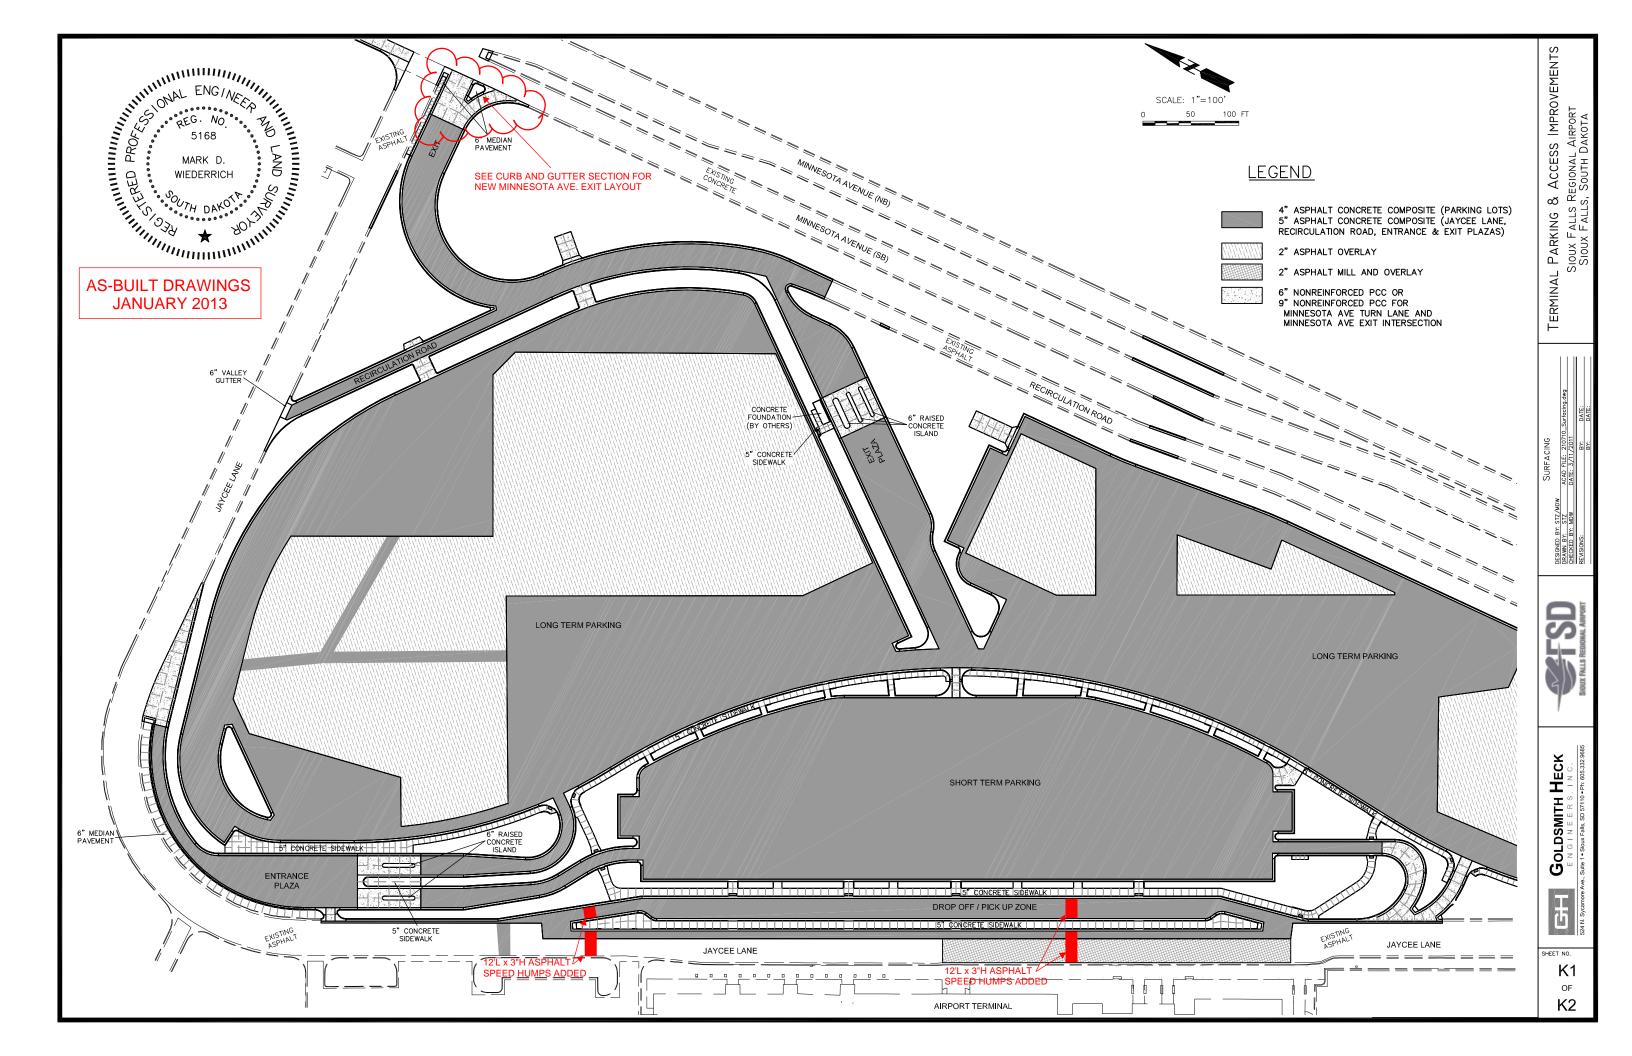


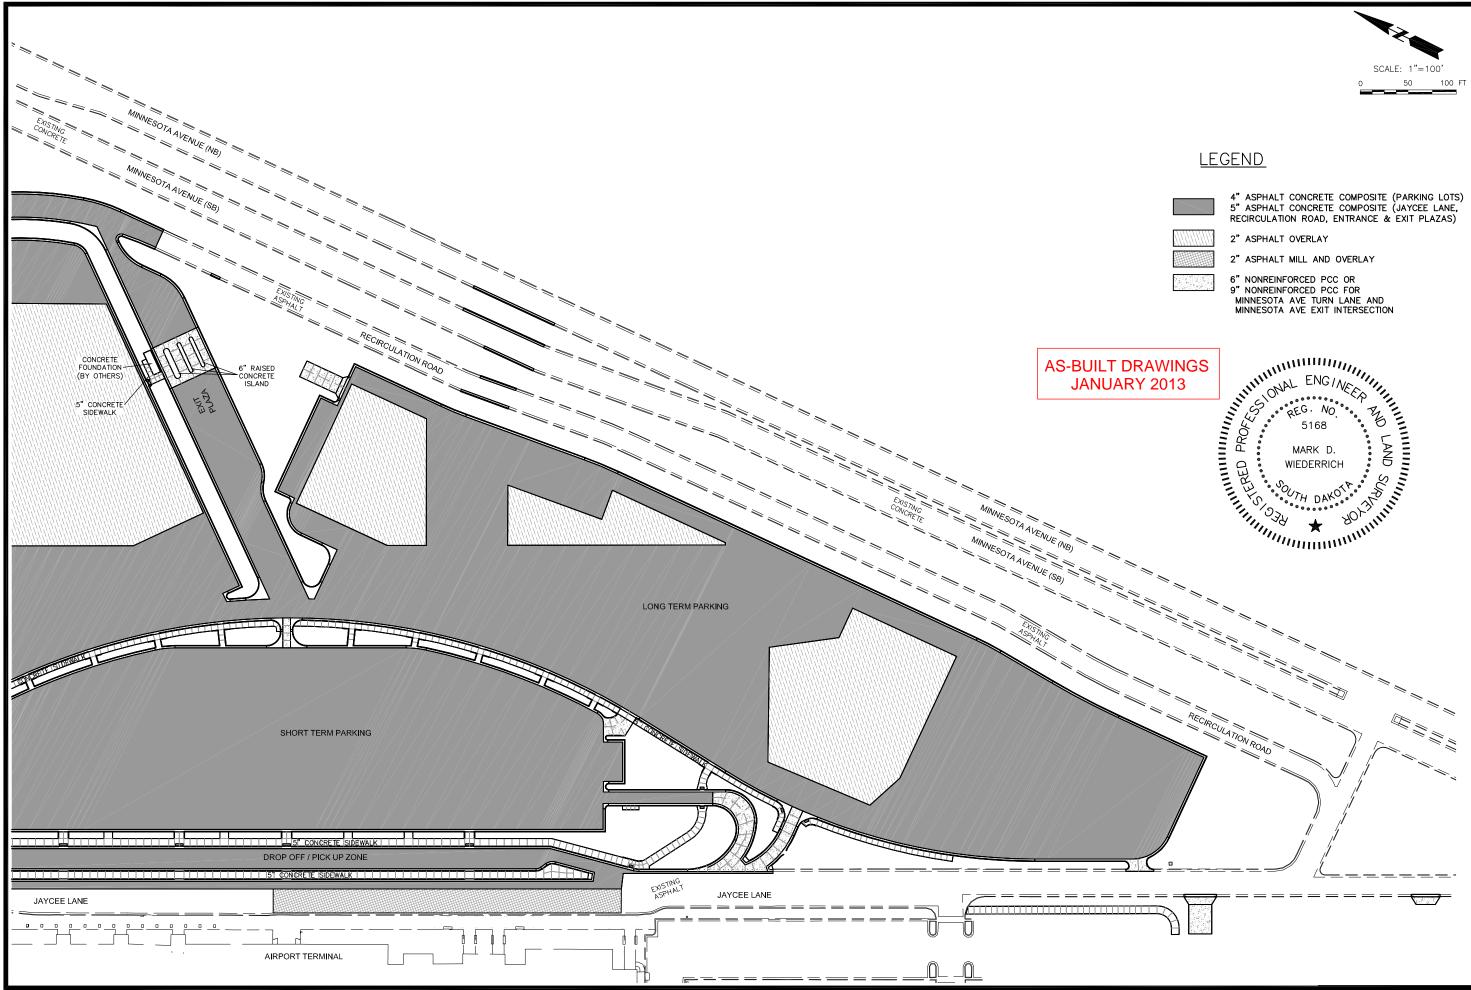

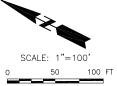





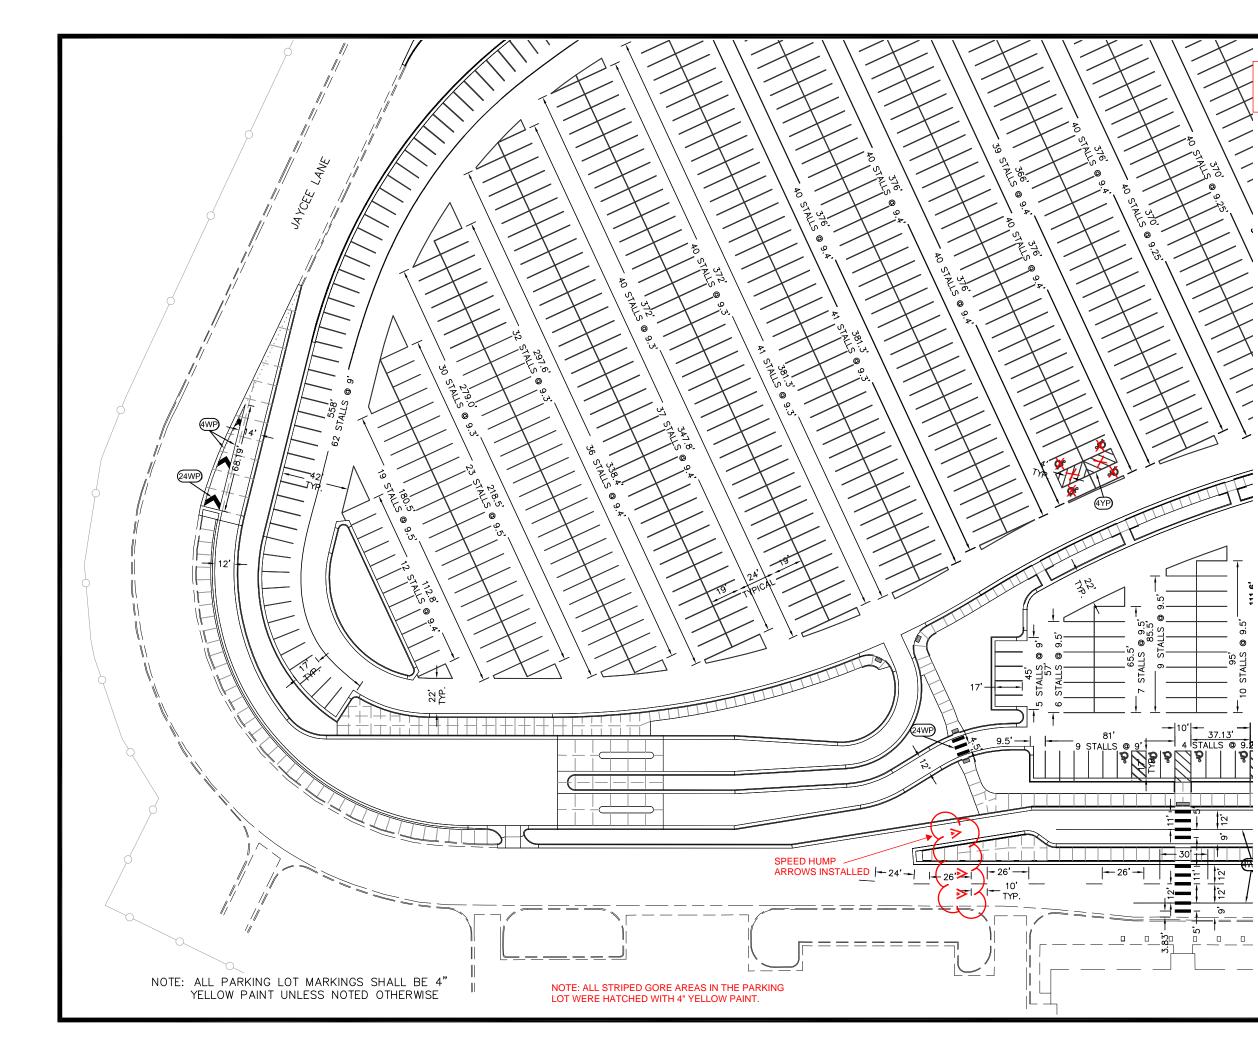







SCALE: 1"=60' 30 60 FT

PAVEMENT MARKING ESTIMATE OF QUANTITIES					
KEY	ITEM	UNIT	QUANT.		
(The second seco	PAVEMENT MARKING PAINT 4" YELLOW	L. FT	44,087		
4WP	PAVEMENT MARKING PAINT 4" WHITE	L. FT	2,150		
24WP	PAVEMENT MARKING PAINT 24" WHITE	L. FT	625		
(24W)	COLD PLASTIC PAVEMENT MARKING L. FT		101		
Ġ	PAVEMENT MARKING PAINT HANDICAP	EACH	29		
5	PAVEMENT MARKING PAINT ARROW	EACH	6		

PAR	KING SUMMARY
TOTAL STALLS REQUI	RED = N/A (AP ZONING)
TOTAL STALLS PROVID	DED = 1702
ACCESSIBLE STALLS R	EQUIRED = 28
ACCESSIBLE STALLS P	ROVIDED = 29
VAN ACCESSIBLE STA	LLS REQUIRED = 2 (AIRPORT) = 1 (EXIT PLAZA)
VAN ACCESSIBLE STA	LLS PROVIDED = 10 (AIRPORT) = 1 (EXIT PLAZA)

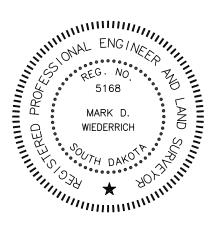

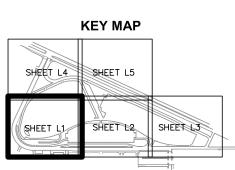





SHEET NO.


L1


OF


L5

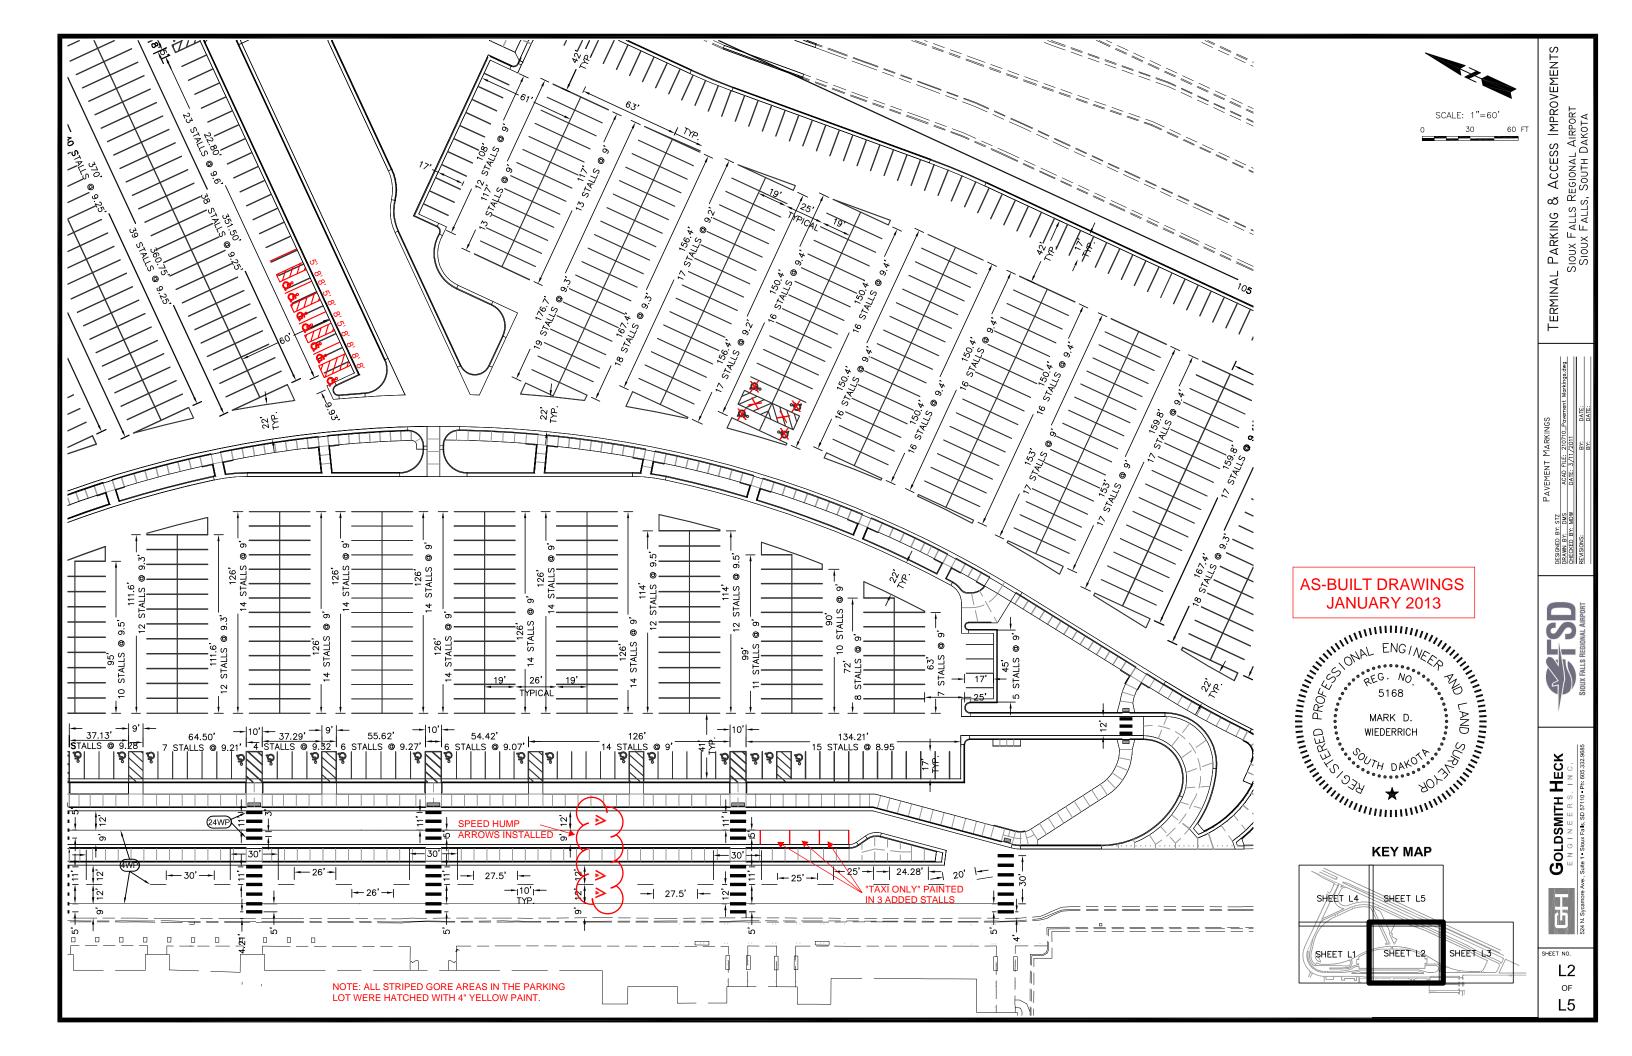

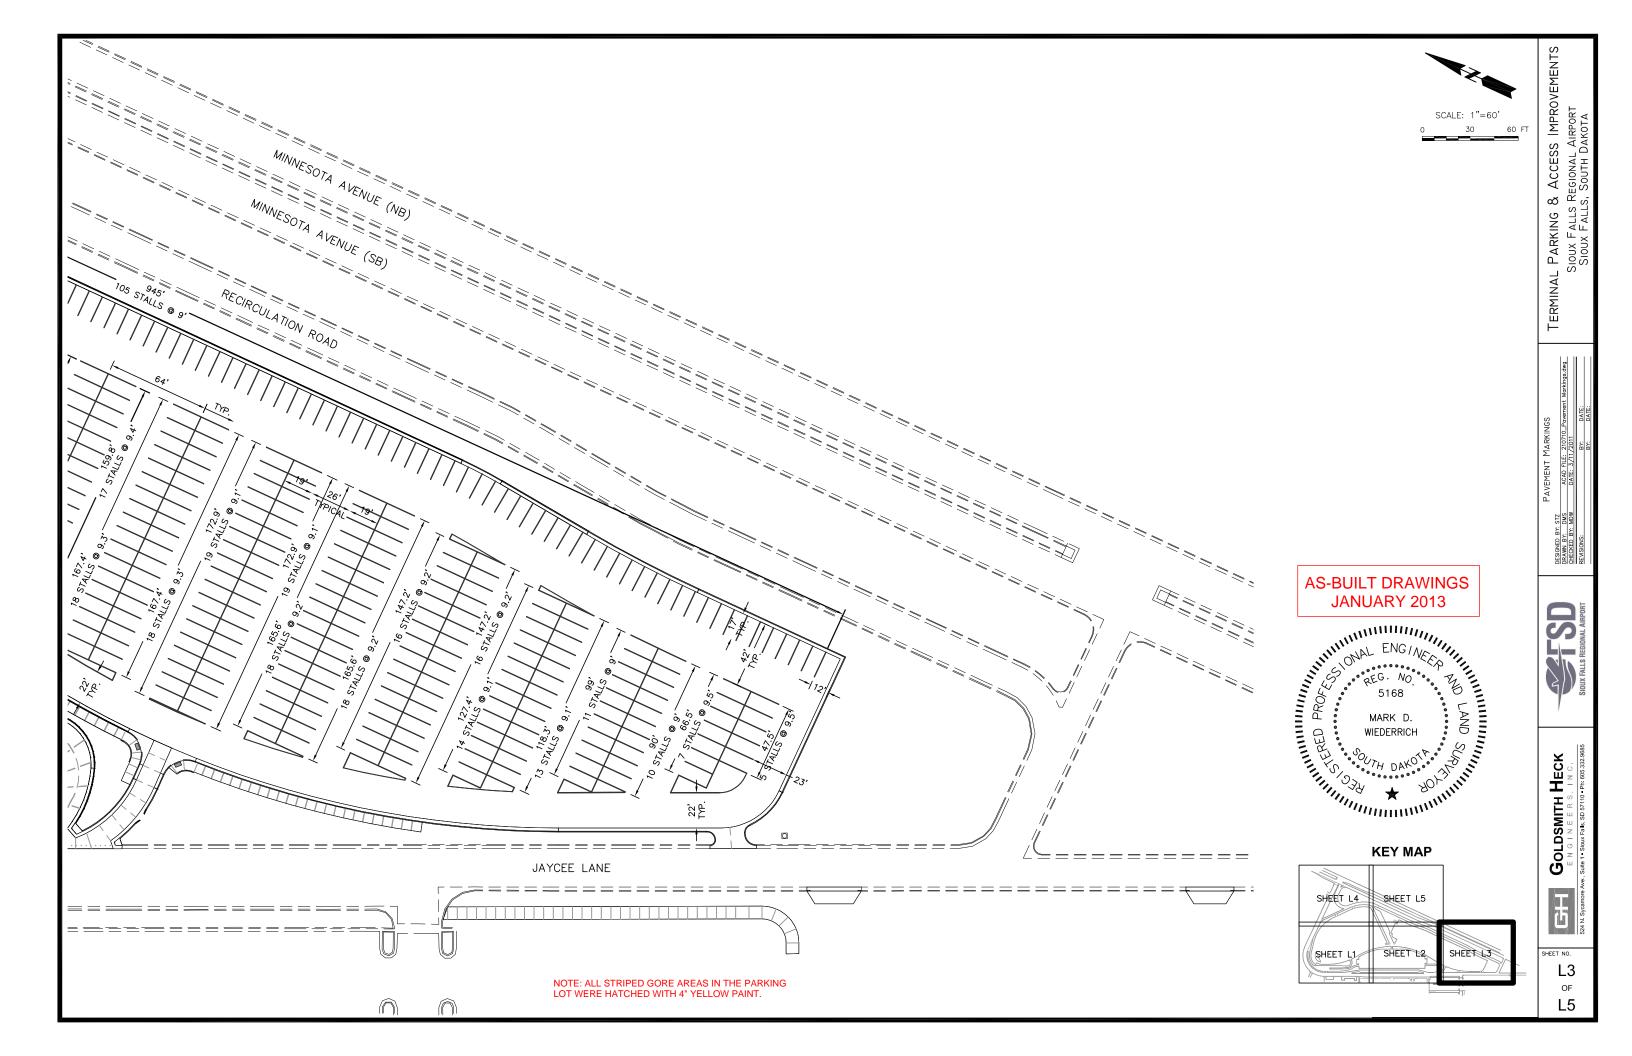

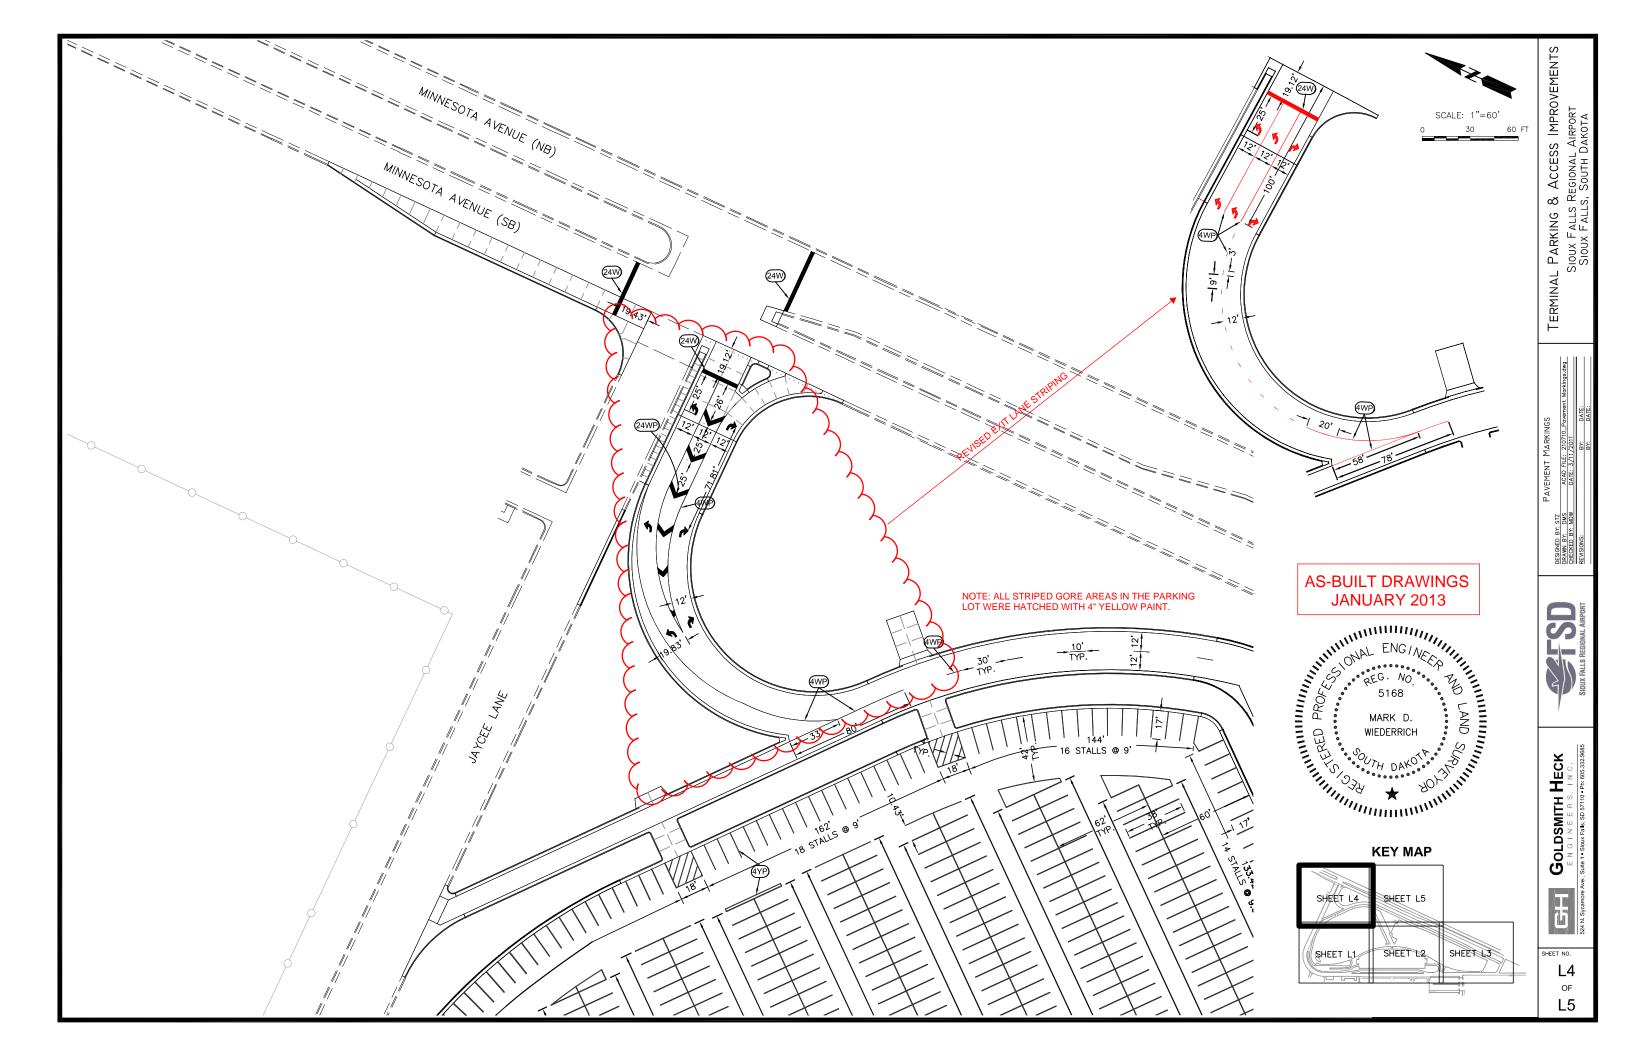

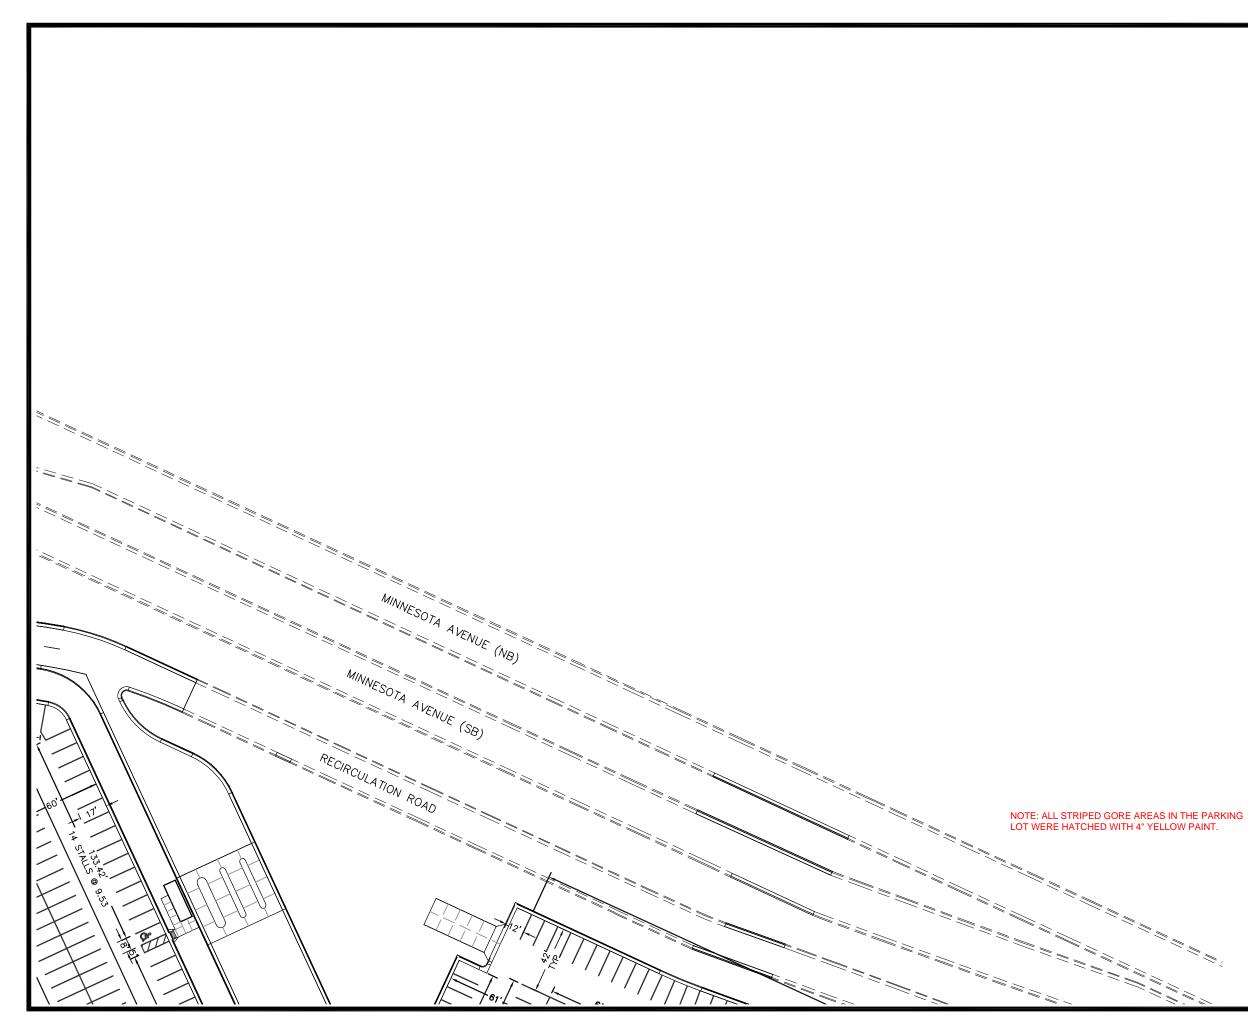

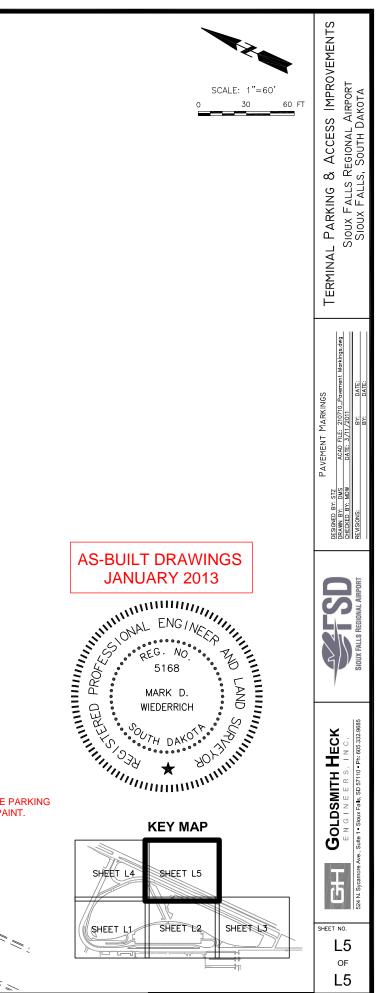

# PERMANENT SIGN NOTES

#### SPECIFICATIONS TO BE USED

The City of Sioux Falls current edition of "General Conditions for Public Improvements and Supplemental Standard Specifications", the South Dakota Department of Transportation (SDDOT) "Standard Specifications for Roads and Bridges" Current Edition, and the "Manual on Uniform Traffic Control Devices" (MUTCD) are all hereby made a part of these specifications in their entirety unless otherwise revised, deleted, or supplemented herein.

The City of Sioux Falls Engineer's Office will provide a copy of the standard specifications free of charge to all prospective bidders upon request. The standard specifications can also be downloaded from the City of Sioux Falls web site at address http://www.siouxfalls.org/publicworks/bidtabsdocs.asp.

## ORDER OF PRECEDENCE

If conflicts arise, the order of precedence of the contract documents shall be as follows: Plans, Special Provisions over City of Sioux Falls Supplemental Standard Specifications over Sioux Falls General Conditions and Standard Specifications over South Dakota Department of Transportation Standard Specifications.

#### SEQUENCING

See Sheet F-1 for Sequence of Operations.

#### SCOPE OF WORK

This work consists of the installation of Contractor furnished and installed signs and the removal and reset of any existing signs.

The Permanent Sign Table addresses which signs are to be new and which signs are to be removed and reset.

All signs are to be installed in accordance with Sections 632 and 982 of the SDDOT Standard Specifications.

#### **REMOVE TRAFFIC SIGN**

The Contractor shall be responsible to remove the existing traffic signs as specified in the plans. The signs, posts, bases and all hardware shall be removed and disposed of by the contractor. Multiple signs removed from the same post will be measured individually and paid for on a per each basis. All costs required including labor, equipment and materials to remove sign with post, anchor post, stiffener sleeve, and concrete footings (if present) and disposal of said items are considered incidental to the contract unit price per each for "Remove Traffic Sign"

## SALVAGE TRAFFIC SIGN FOR RESET

This bid item includes all costs necessary to salvage the existing traffic signs for reset and to remove and dispose of the existing post, anchor post and stiffener sleeve at the locations specified in the plans. All signs must be removed from the post prior to the removal of the post and base and the Contractor is to take extreme care in handling and storing the signs to prevent damage to the reflective sheeting of signs. Signs that are damaged (i.e. scratched and/or bent) will be replaced by the Contractor at no expense to the Airport Authority.

Multiple signs removed from the same post will be measured individually and paid for on a per each basis. All costs required including labor, equipment and materials to salvage and store the sign until reset and to remove and dispose of the post, anchor post and stiffener sleeve are considered incidental to the contract unit price per each for "Salvage Traffic Sign for Reset"

# INSTALL TRAFFIC SIGN ON POST

This bid item includes all costs necessary to mount new signs or signs previously removed and salvaged by the Contractor on perforated tube posts. Signs shall be mounted as per the Typical Sign Post Detail. The Contractor is to take extreme care in handling the signs to prevent damage. Signs that are damaged (i.e. scratched and/or bent) will be replaced by the Contractor at no expense to the Airport Authority. Multiple signs placed on the same post will be measured separately.

All costs required including labor, equipment and materials, including mounting hardware, to mount signs, are considered incidental to the contract unit price per each for "Install Traffic Sian on Post"

## INSTALL TRAFFIC SIGN ON STREET LIGHT

This bid item includes all costs necessary to mount new signs or signs previously removed and salvaged by the Contractor on steel street light poles. The Contractor shall use stainless steel sign mounting brackets with stainless steel 3/4" clips and straps, as manufactured by "Band-It" or equivalent. The sign shall be secured to the pole using the appropriate number of bracket, clips and straps as recommended by the manufacturer. The Contractor is to take extreme care in handling the signs to prevent damage. Signs that are damaged (i.e. scratched and/or bent) will be replaced by the Contractor at no expense to the Airport Authority. Multiple signs placed on the same street light will be measured separately.

All costs required including labor, equipment and materials to mount signs, are considered incidental to the contract unit price per each for "Install Traffic Sign on Street Light".

# SIGNS

The signs listed on the Permanent Sign Table in the plans shall be furnished by the Contractor for the locations specified. All signs shall be flat sheet aluminum Type III, also known as High Intensity Prismatic (HIP).

The costs of the signs shall be incidental to the contract unit price per square foot for Flat Aluminum Sign, Non-removable Copy Type III. See Permanent Sign Table.

# PLACEMENT

For signs erected in business, commercial, and residential districts, the clearance to the bottom of the sign shall be 7'-7.5'. The height to the bottom of a secondary sign mounted below another sign may be 1' less than the appropriate height specified above.

Generally, all signs shall be placed as noted in the Permanent Signing Tables located on sheet K-3. Typically, the sign shall be 2'-2.5' behind the face of the curb in areas where the sidewalk is not adjacent to the curb.

All signs shall be installed facing traffic at a 90 degree angle to the direction of travel.

# TUBE POSTS

The Contractor shall provide perforated square (breakaway) sign supports for each sign as listed in the Permanent Sign Table in these plans.

Signposts shall be of length adequate to provide the proper height above the roadway and to extend to the top of the sign. The signpost shall not extend past the top of the sign. The Contractor shall verify the required posts' lengths prior to obtaining these materials.

The 42" anchor post shall be installed so that 1-2" is above the ground line. The sign post shall be attached to the anchor post with 2-5/16" stainless steel bolts installed 90 degrees to each other. Refer to the standard detail signpost detail.

Sleeves or boxouts for the sign anchors in the concrete median pavement shall be considered incidental to the contract unit price for the Perforated Tube Posts.

The plan post lengths shall be field verified by the Contractor prior to Installation. The 2.0" x 2.0" perforated square sign supports will be measured to the nearest 0.10' and paid for at the contract unit price per foot for 2.0" x 2.0" Perforated Tube Post. The 2.25" x 2.25" x 42" perforated square anchor post will be measured to the nearest 0.10' and paid for at the contract unit price per foot for 2.25" x 2.25" Perforated Tube Post. The 2.5" x 2.5" x 18" perforated square (post) stiffener sleeve will be measured to the nearest 0.10' and paid for at the contract unit price per foot for 2.5" x 2.5" Perforated Tube Post.

#### HARDWARE

2.0" Perforated Tube Post.

breakdown

otherwise shown in the plans.

in height shall be 2" wide.

herein.

The Contractor shall use 3/8" rust proof machine sign bolts, flat metal washers, nylon washers (against the sign sheeting), lock washers and nuts to fasten the sign to the Perforated Tube Post. A minimum of two bolts shall extend through the post.

The cost for all hardware items shall be incidental to the contract unit price per foot for 2.0" x

# SIGN LEGEND. BORDER AND BACKGROUND


All sign materials shall comply with Section 982 of the SDDOT Standard Specifications.

All sign legend, border and background sheeting shall be hi-intensity encapsulated lens reflectorized Type III or Diamond Grade VIP Series Type IX See Permanent Sign Table for

All upper case letters, lower case letters and all numerals shall be Series "E" Modified unless

The border on all signs 3' or less in height shall be 1" wide. The border on all signs 4' or more

The corner radii on all signs 3' or less in height shall be 3". The corner radii on all signs greater than 3' and less than 6' in height shall be 6". The corner radii on all signs 6' or more in height shall be 12". The sign height, sign width, letter height and symbol sizes are specified

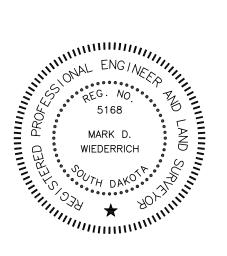



TERMINAL PARKING & ACCESS IMPROVEMENTS	CIDILY FALLS DECIDIAL ALBORT	CICUM I ALLO INCOUNTL AINI ONI CICIM EALLO COULTU DAKATA	SIUUN I ALLS, SUULA DANULA	
	DRAWN BY: EJL ACAD FILE: 210710_Sign Plan.dwg CHECKED RY: MDW DATE: 3/11/2011		BY: DATE:	
<b>UDICU</b>		STOLIN FALLS REGIONAL ARPORT		
GOLDSMITH HECK	ENGINEERS. INC.	524 N Sveamore Ave Suite 1 - Sioux Fails SD 57110 - Ph. 605 332 9685		
	∩ <sup>of</sup> ∕!			


MUTOD			FLAT ALUMINUM SIGN AREA	NUMBER OF SIGNS	TOTAL AREA	SALVAGE TRAFFIC SIGN FOR RESET	INSTALL TRAFFIC SIGN ON POST	INSTALL TRAFFIC SIGN ON STREET LIGHT	TUBE POST 2"x2"	TUBE POST 2.25"x2.25"	TUBE POST 2.5%
MUTCD NUMBER	SIGN SIZE WxH	DESCRIPTION	SQFT/ SIGN	EACH	SQFT	EACH	EACH	EACH	L.FT	L.FT	L.FT
M1-1	EXISTING	INTERSTATE 29, INTERSTATE 90				2	2				
M4-5	EXISTING	то				1	1		21.00	7	3
M6-1	EXISTING	DIRECTIONAL ARROW (L)				1	1				
R1-1	EXISTING	STOP				3	3		9.67	3.5	1.5
R1-2	18"x18"x18"	YIELD	1.0	1	1		1		8.50	3.5	1.5
R1-2	36"x36"x36"	YIELD	3.90	2	7.8		2		19.17	7	3
R2-1	EXISTING	SPEED LIMIT 15				1		1			
R3-5R	30"X36"	Right Turn (Symbol) Only	7.5	2	15		2		20.33	7	
R3-5L	30"X36"	Left Turn (Symbol) Only	7.5	2	15		2		20.33	7	
R4-7R	24"x30"	KEEP RIGHT (SYMBOL)	5	1	5	1	2		9.67	3.5	6
R5-1	EXISTING	DO NOT ENTER				2	2		9.67	3.5	1.5
R6-1L	36"x12"	ONE WAY (LEFT ARROW)	3	1	3	3	3	1	24.50	10.5	4.5
R6-1R	EXISTING	ONE WAY (RIGHT ARROW)				1	1		8.17	3.5	1.5
R6-3a	30"x24"	DIVIDED HIGHWAY	5	2	10		2		10.75	7	3
R8-3	24"x24"	NO PARKING (SYMBOL)	4	7	28			7			
W11-2	18"x18"	PEDESTRIAN TRAFFIC	2.25	2	4.5		2		18.50	7	3
W11-2	24"x24"	PEDESTRIAN TRAFFIC	4	9	36		5	4 COLUMN MOUNT	49.58	17.5	7.5
SPECIAL	EXISTING	Minnesota Av				2		2			
SPECIAL	EXISTING	Jaycee Ln				2		2			
SPECIAL	EXISTING	SHORT TERM PARKING RATES				2	2	2 POLE MOUNT			
SPECIAL	EXISTING	LONG TERM PARKING RATES				2	2	2 POLE MOUNT			
SPECIAL	12"X18"	RESERVED PARKING	1.5	29	43.5		29				
SPECIAL	12"x9"	STATE PERMIT OR LICENSE REQUIRED	0.75	29	21.8		29		224.00	101.5	43.5
SPECIAL	12"x6"	VAN ACCESSIBLE	0.5	13	6.5		13				
SPECIAL	12"X18"	WHEELCHAIR ACCESS AISLE	1.5	7	10.5		7		47.25	24.5	10.5
SPECIAL	30"x24"	CELL PHONE LOT - FREE	5	1	5		1		9.17	3.5	1.5
SPECIAL	18"x24"	NO PARKING - INCREASED SECURITY	3	3	9		3		27.50	10.5	4.5
SPECIAL	24"x24"	SHUTTLE BUS/VAN - LEFT ARROW	4	2	8		2		49.50	7	
SPECIAL	24"x24"	SHUTTLE BUS/VAN - RIGHT ARROW	4	1	4		1		18.50	/	3
SPECIAL	24"x24"	TAXI SERVICE - LEFT ARROW	4	1	4		1		18.50	7	3
SPECIAL	24"x24"	TAXI SERVICE - RIGHT ARROW	4	2	8		2		18.50	r	5
SPECIAL	42"x24"	TERMINAL/EXIT (Special #1)	7	1	7		1		18.33	7	3
SPECIAL	54"x24"	EXIT AIRPORT - Right Arrow (Special #2)	9	1	9		1		18.33	7	3
SPECIAL SPECIAL SPECIAL SPECIAL PREG-NO 5168 MARK D. WIEDERRICH SOUTH DAKOF SOUTH DAKOF SOUTH DAKOF	54"x36"	RETURN TO TERMINAL - Left Arrow (Special #3)	13.5	1	13.5		1		20.33	7	3
	1111			Totals:	275.1	23	126	21	632	263	111


# TABLE OF PERMANENT SIGNS



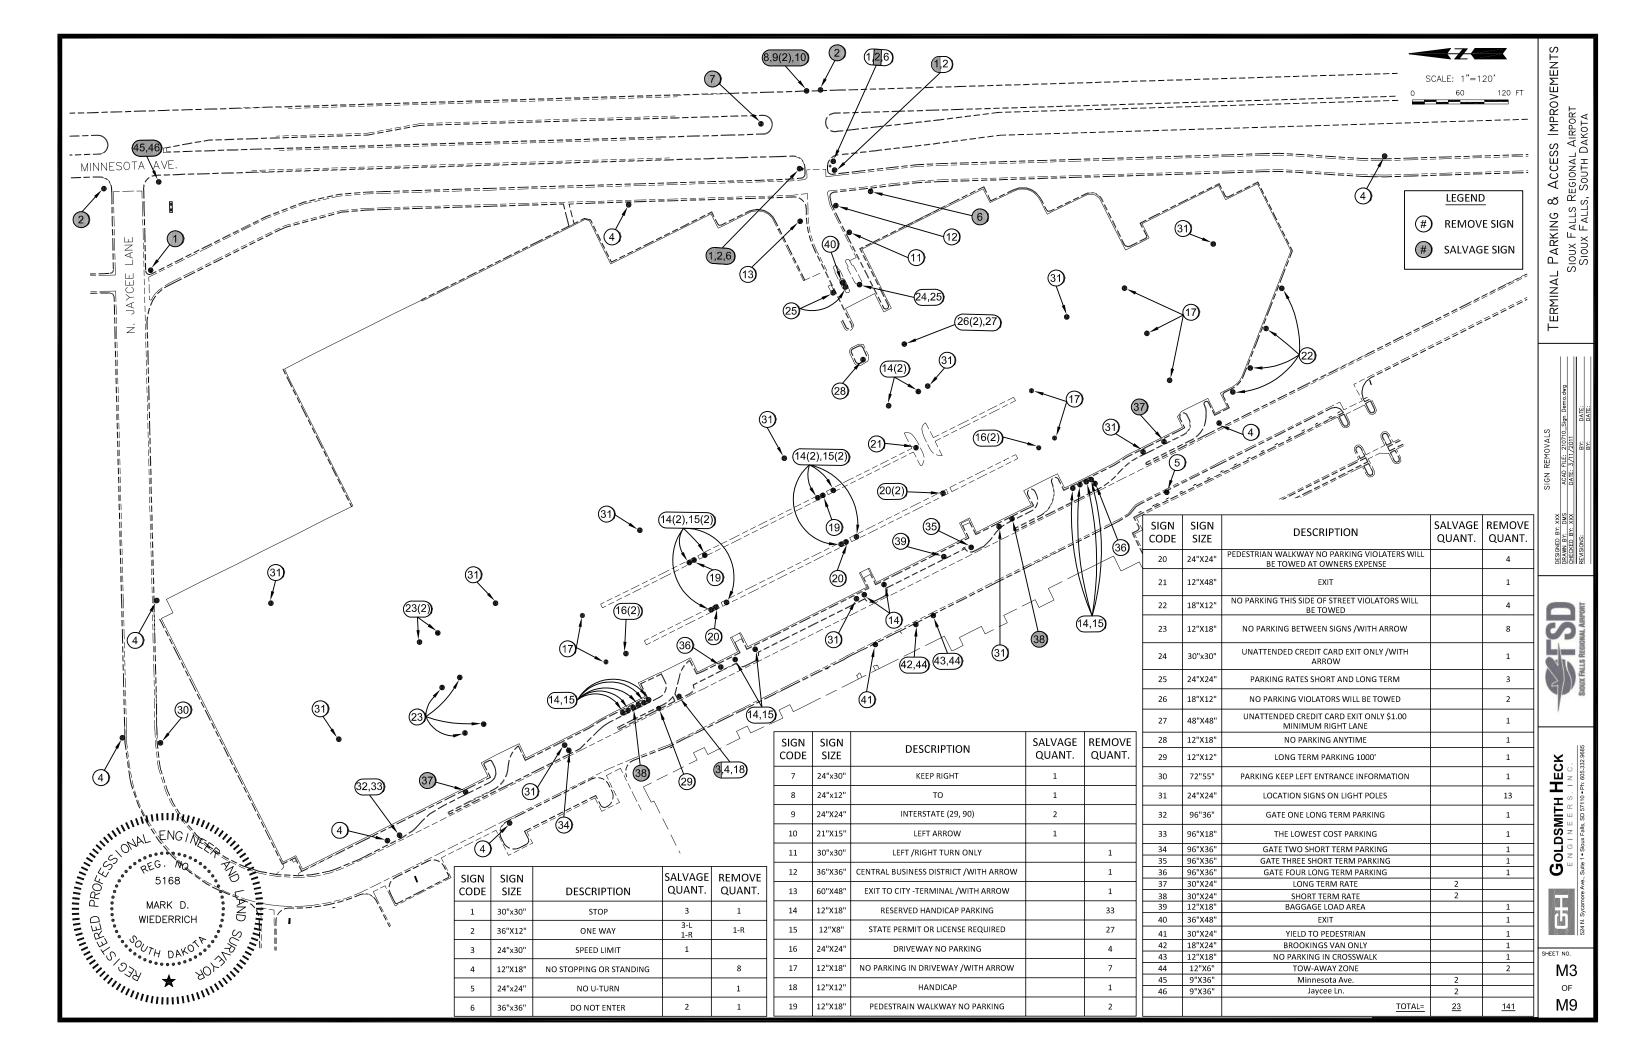


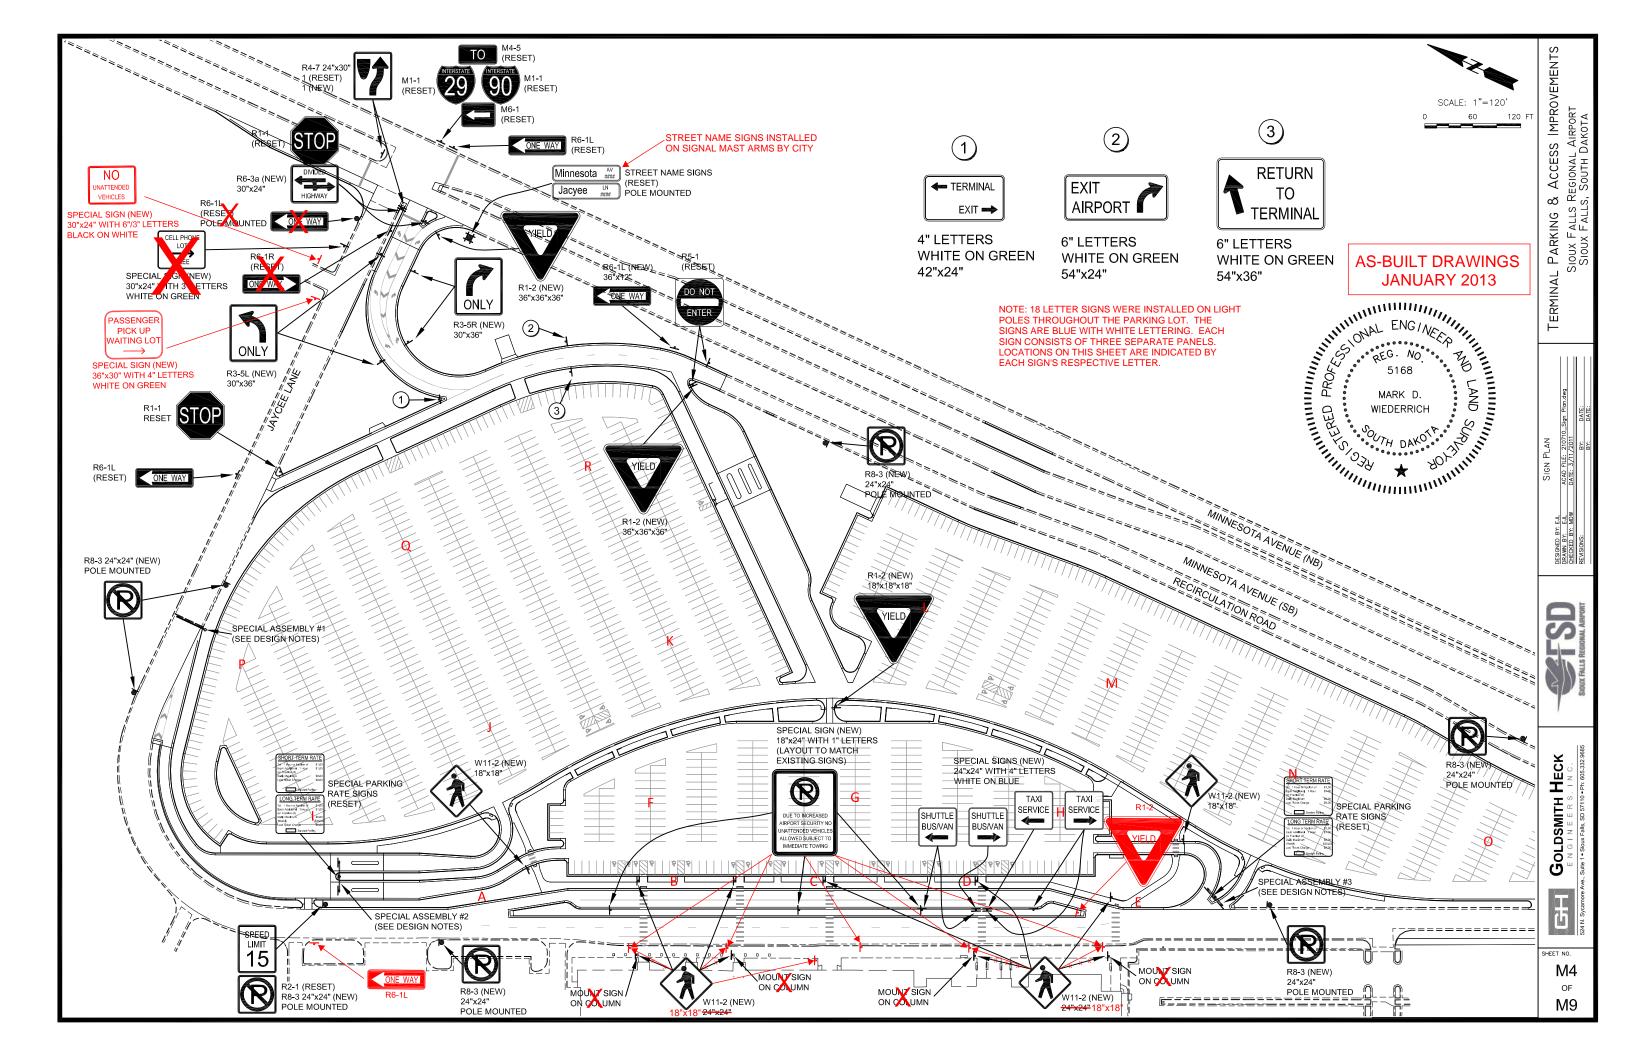

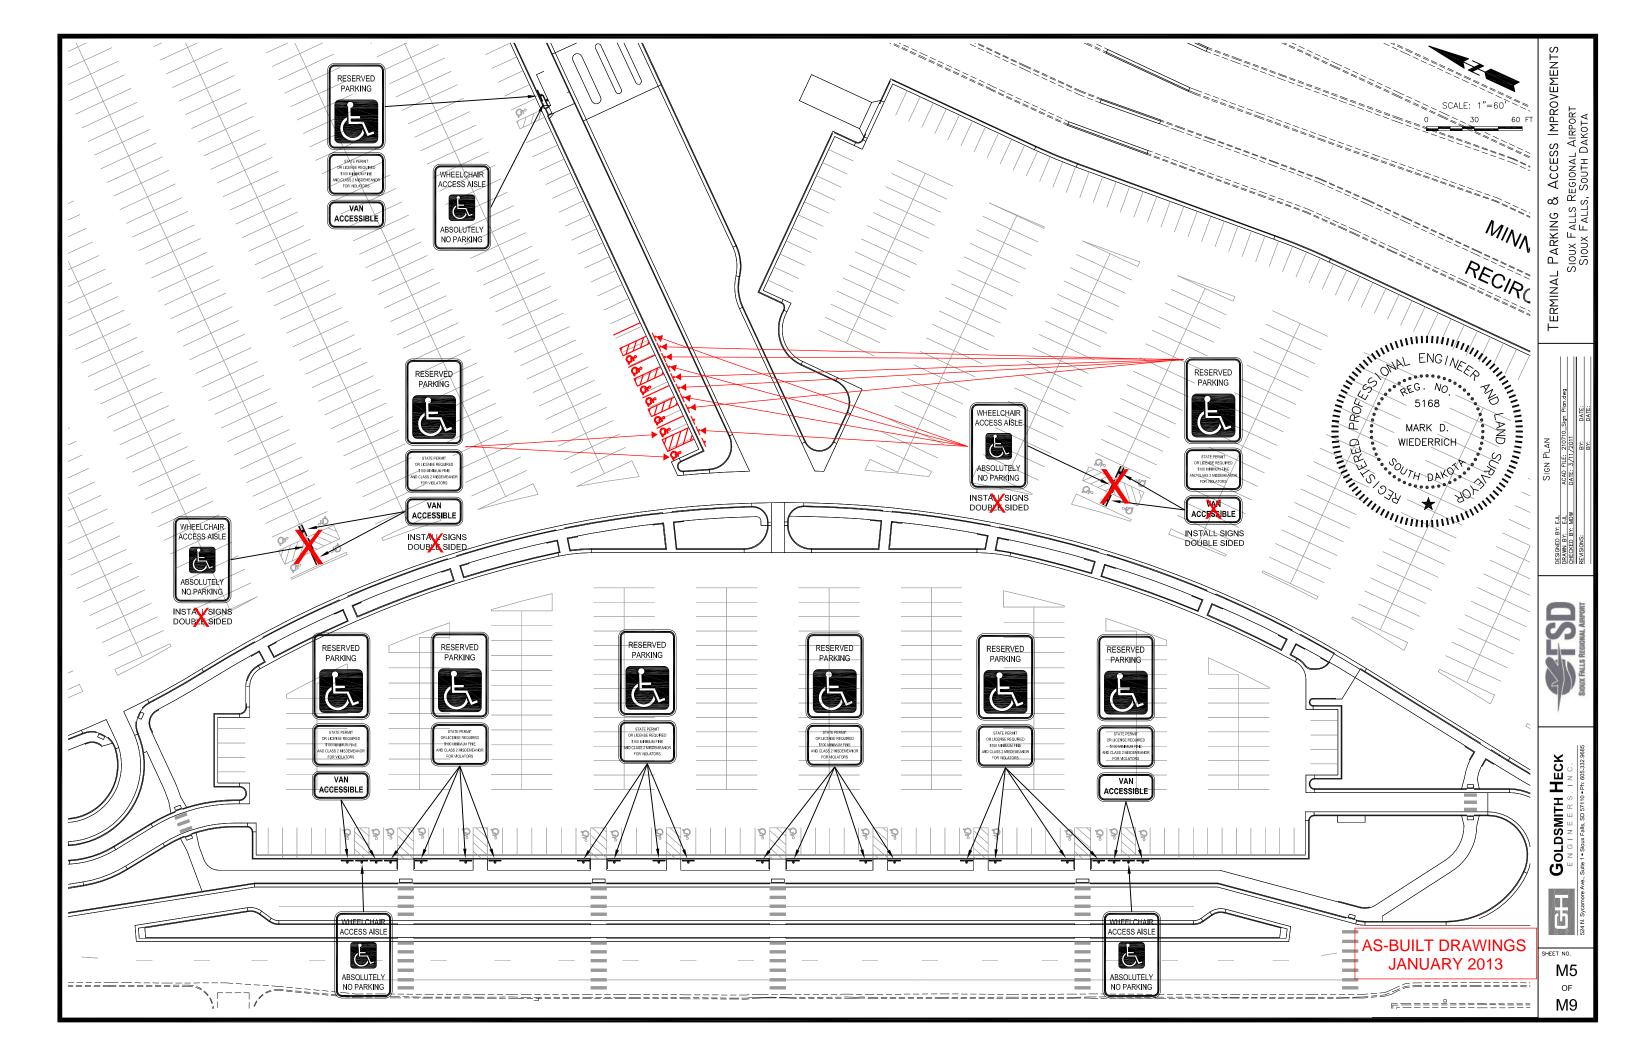


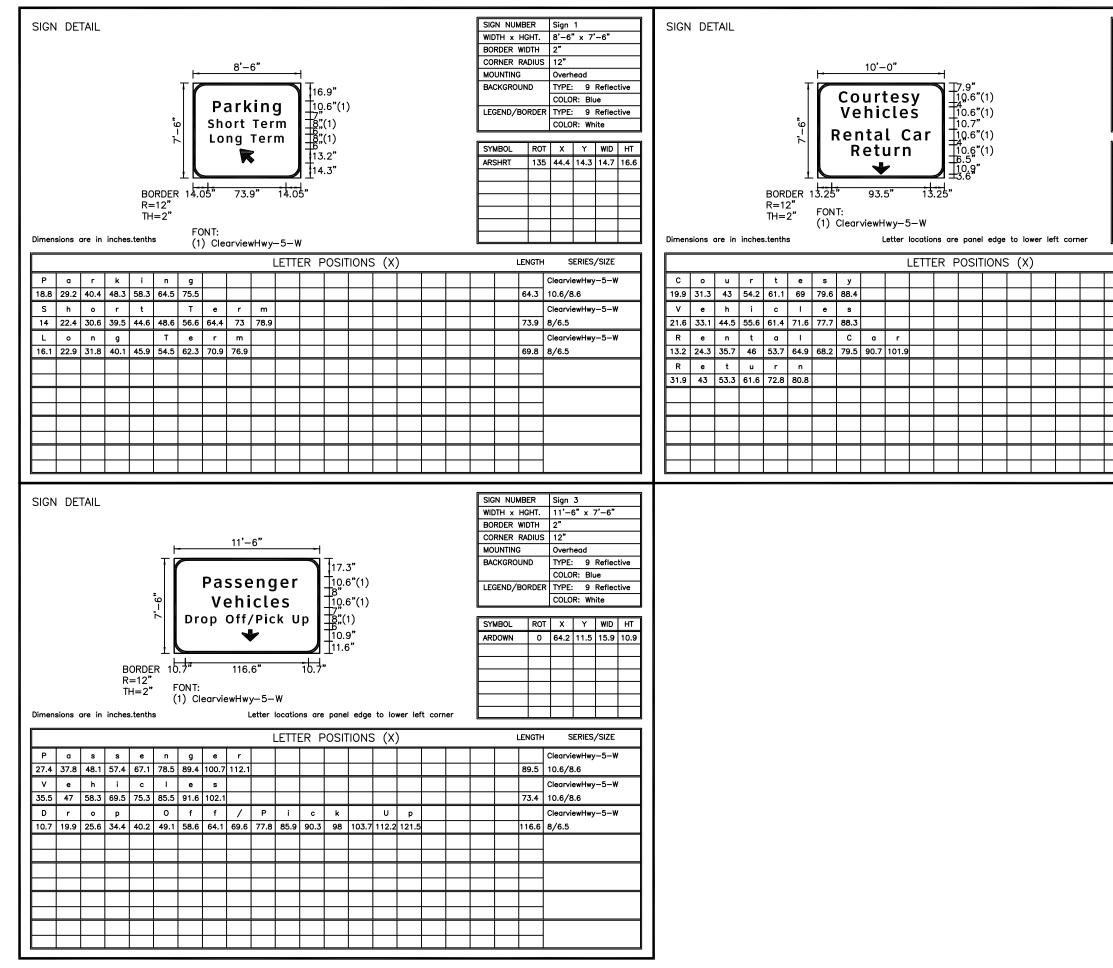


SIGN NUMB	FR	Sign	2				
WIDTH X HG			10'-0" x 7'-6"				
BORDER WIL		2"					
CORNER RA		12"					
MOUNTING		Overh	ead				
BACKGROUN	D			Reflec	tive		
			R: Blu				
LEGEND/BO	RDER		9	Reflec	tive		
		COLO	R: Wh				
SYMBOL	ROT	X	Y	WID	HT		
ARDOWN	0	52.1	3.6	15.9	10.9		
LEN	IGTH	S	ERIES,	/SIZE			
		ClearviewHwy-5-W					
7	6.8	10.6/8.6					
	_		ClearviewHwy-5-W				
	_	10.6/8	=				
	_	Clearvi		-5-W			
9.	_	10.6/8					
		Clearvi	-	-5-W			
5	6.2	10.6/8	.6				
	-						

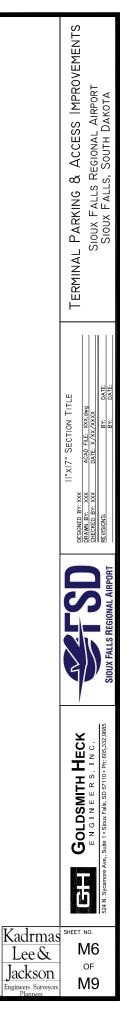



# AS-BUILT DRAWINGS JANUARY 2013

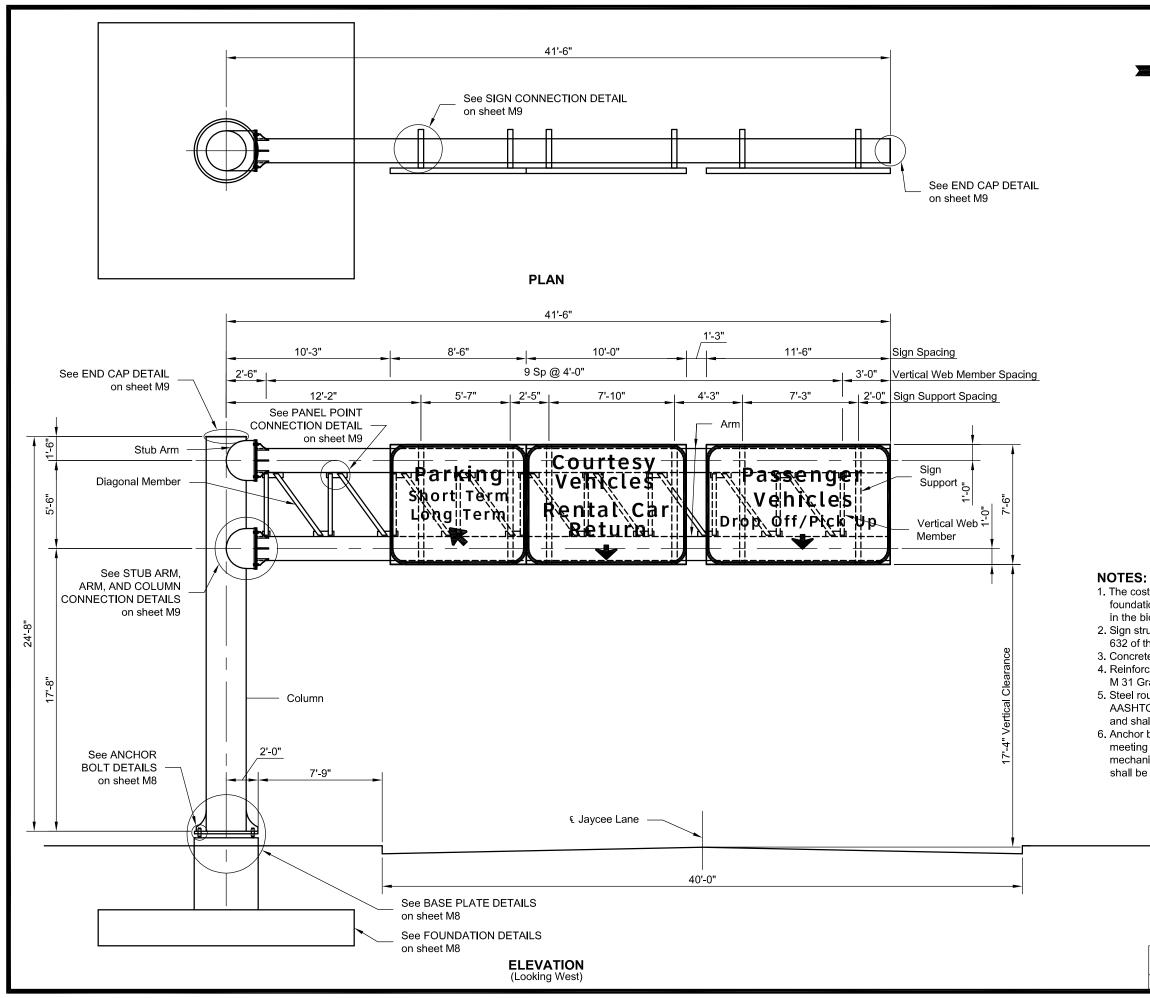


			TERMINAL PARKING & ACCESS IMPROVEMENTS SIOUX FALLS REGIONAL AIRPORT SIOUX FALLS, SOUTH DAKOTA
			CANTILEVER OVERHEAD SIGN STRUCTURE (A) (b) (c) (c) (c) (c) (c) (c) (c) (c) (c) (c
ion, sign support structure, id item "Cantilevered Sign fucture shall be constructed he SDDOT Standard Spec- te shall have a 28-day com cing steel shall conform to rade 60. Fund tubes and standard pi O 270 Grade 36, M161, or all be galvanized according bolts, nuts, and washers sign ASTM A307 and meet AA	I in accordance with Section ifications for Roads & Bridges. pressive strength of 3,000 psi. the requirements of AASHTO be members shall meet ASTM A53 (Grade B Steel) to AASHTO M111. nall be fabricated of steel SHTO M314 Grade 55 for bolts, nuts, and washers	the	GOLDSMITH HECK E N 0 I N E E R S, I N C. Sidt 1 - Seux Falls, SD 57110 - Ph. 606.332.0685 SIQUX FALLS REGIONAL AIRPORT
_	AS-BUILT DRAWING JANUARY 2013	S	CH GOLDSN E N G I N E 524 N. Sycamore Ave., Sdie 1 - Spox Falls,
QU/ CANTILEVERED SIGN S	ANTITIES TRUCTURE 1 L SUM	Kadrmas Lee & Jackson Engineers Surveyors Planners	M7 OF M9

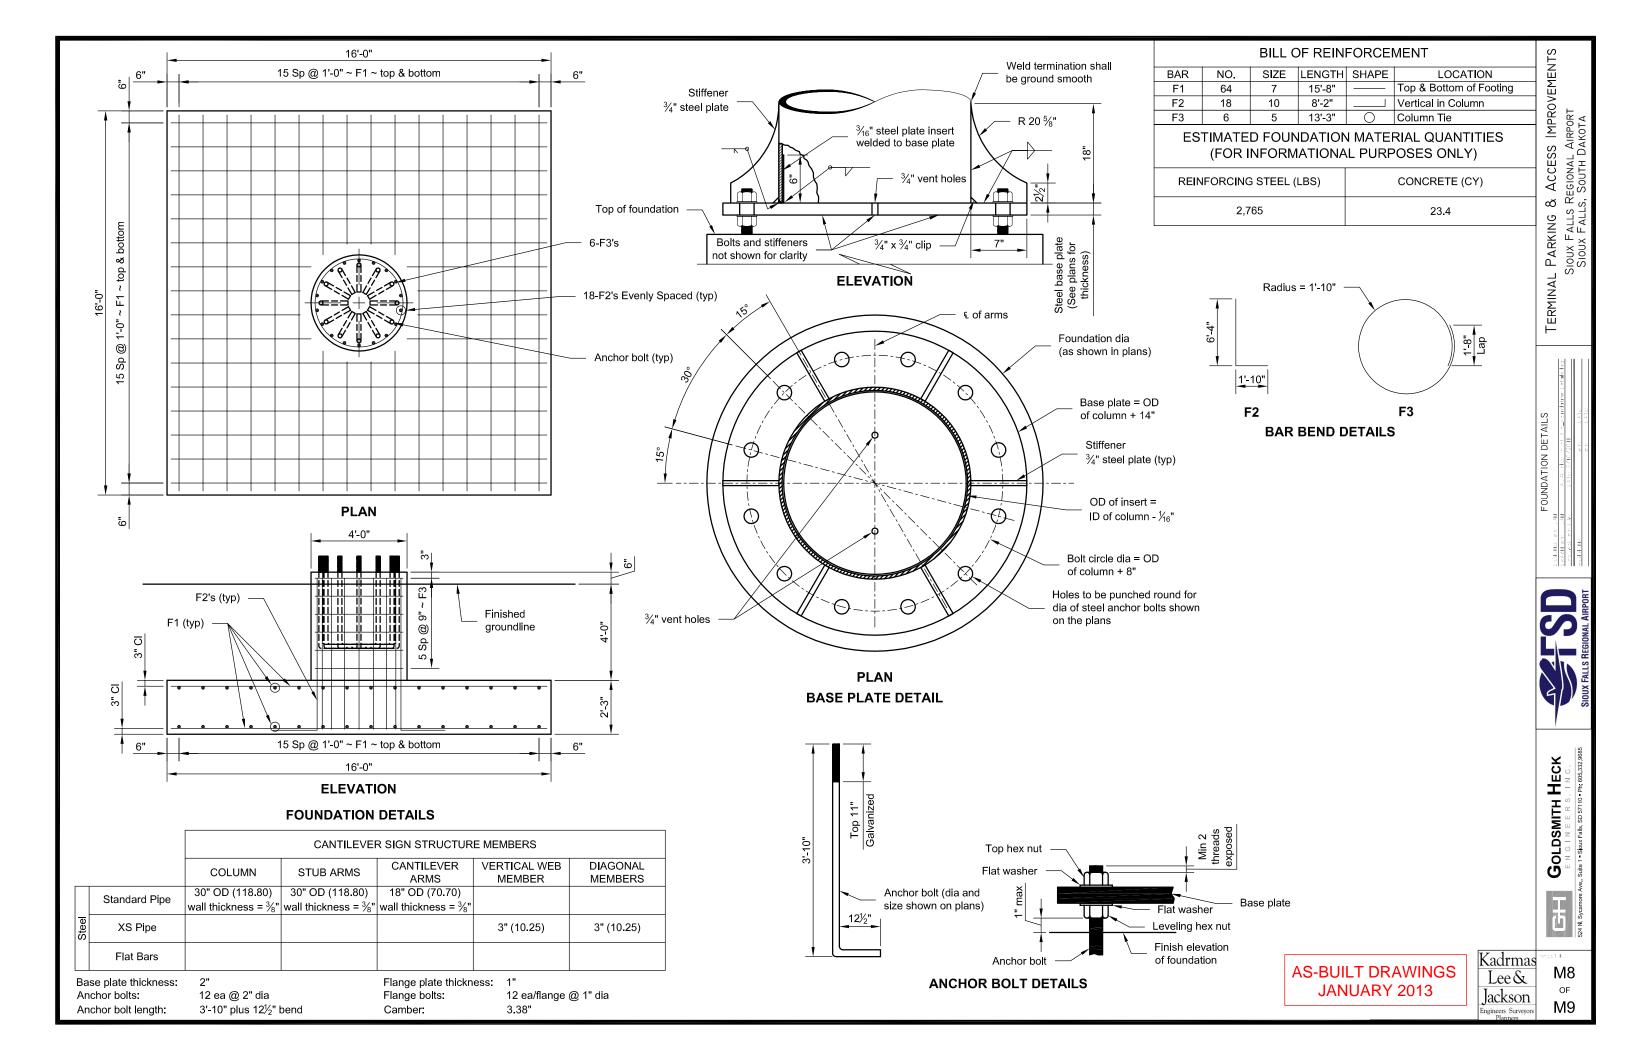


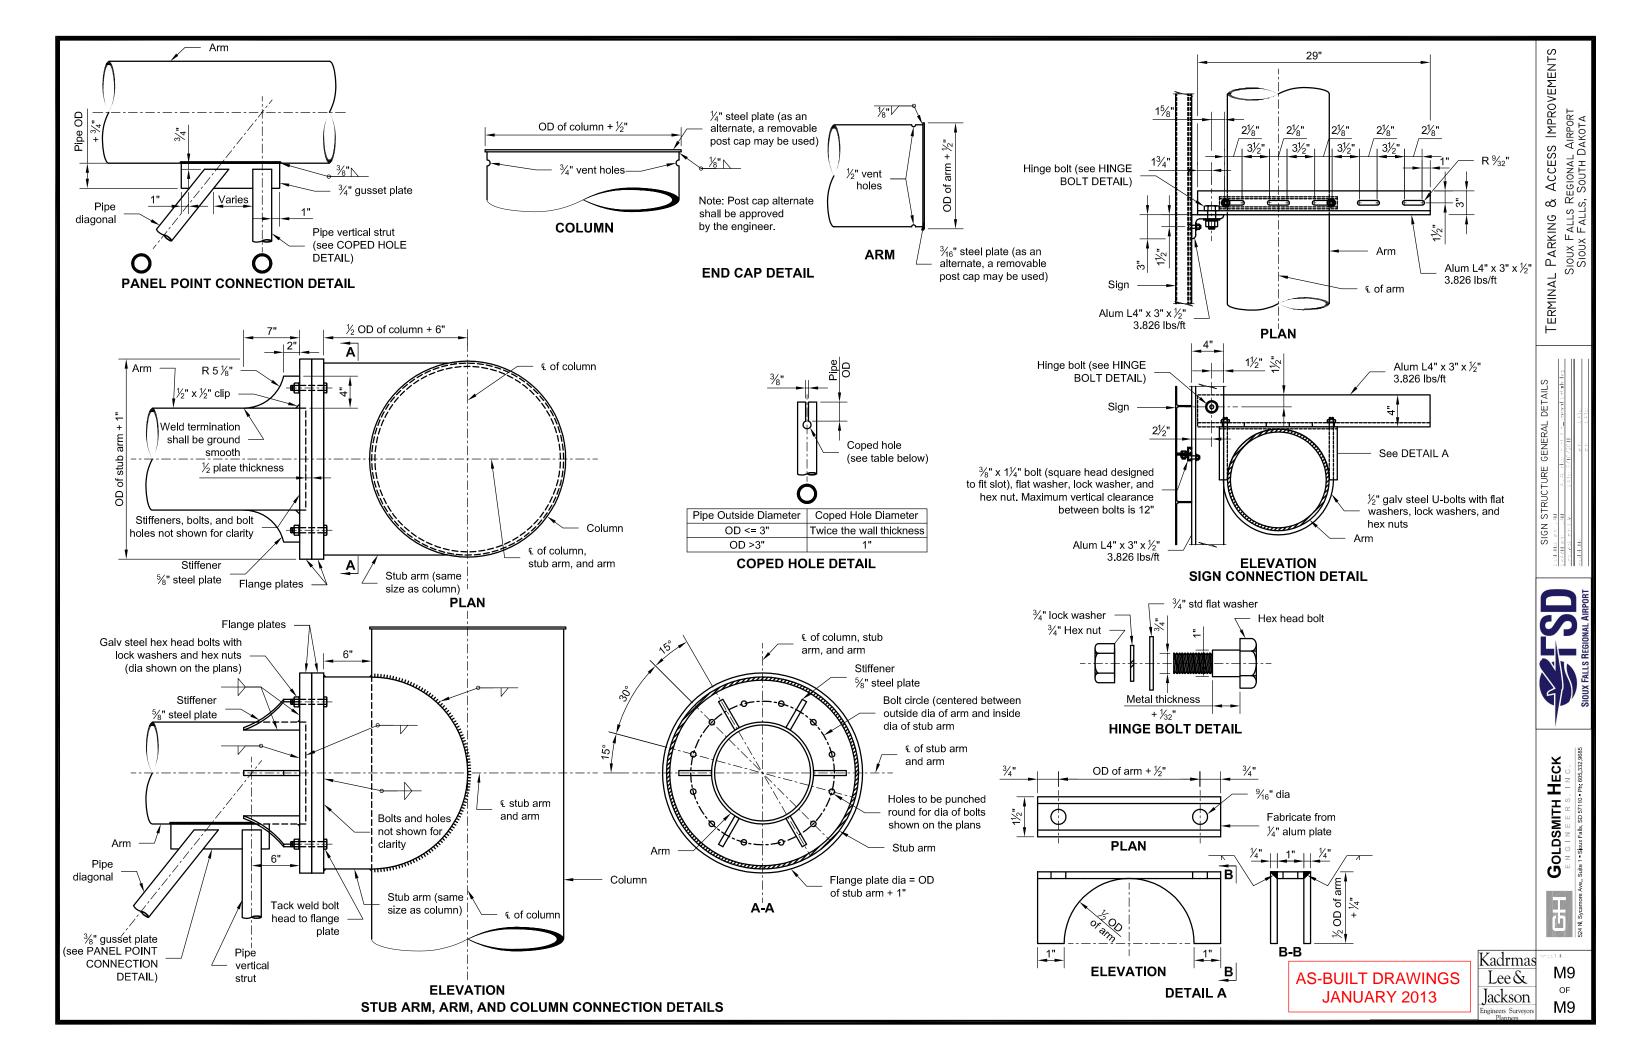

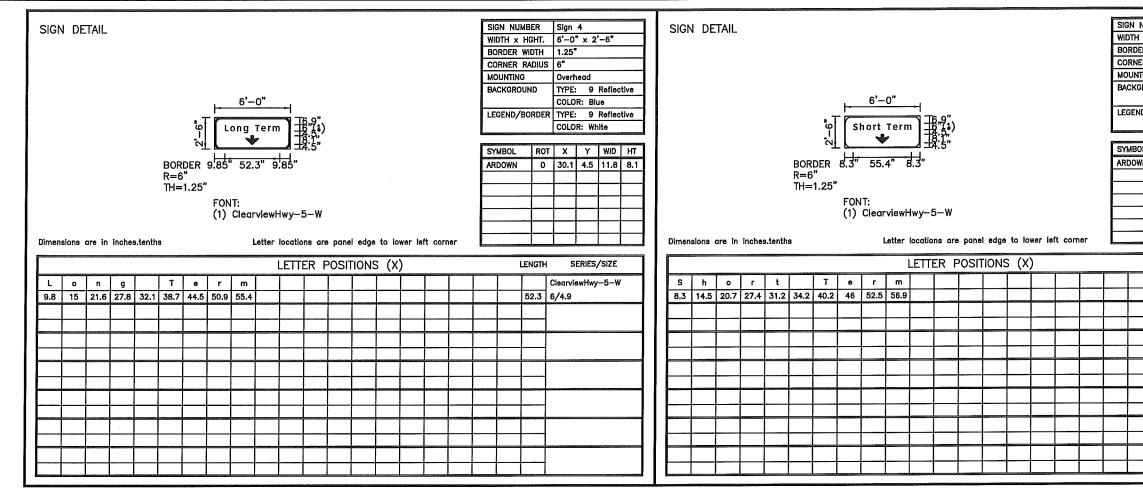

I NUMBER H x Hght. Der Width Ner Radius	Sign 5 6'-0" x 2'-6" 1.25" 6"			DVEMENTS
NTING (GROUND	Overhead TYPE: 9 Reflective COLOR: Blue TYPE: 9 Reflective COLOR: White			CESS IMPR Val Airport Th Dakota
BOL ROT DWN O 	X         Y         WID         HT           30.1         4.5         11.8         8.1			TERMINAL PARKING & ACCESS IMPROVEMENTS Sioux Falls Regional Airport Sioux Falls, South Dakota
	ClearviewHwy-5-W 6/4.9			II"X17" SECTION TITLE AC40 FLE: 50510108 Signativent dive DATE: 3718, 2011 BY: DATE BY: DATE
				LITX DESCAED BY. 4K DESCAED BY. 4K M. 14 M. 14 REVISIONS
				SIOUX FALLS REGIONAL
	Profes PEG. P PEG. P	vo.		GOLDSMITH HECK E N G I N E E R S, I N C. 524 N. Sysamore Ave., Suite 1 - Slour Falls, SD 57110 - Pt. 605.332.9665
NGS 3	218		Kadrmas Lee & Jackson Engineers Surveyors Planners	sheet no. M10 of M12

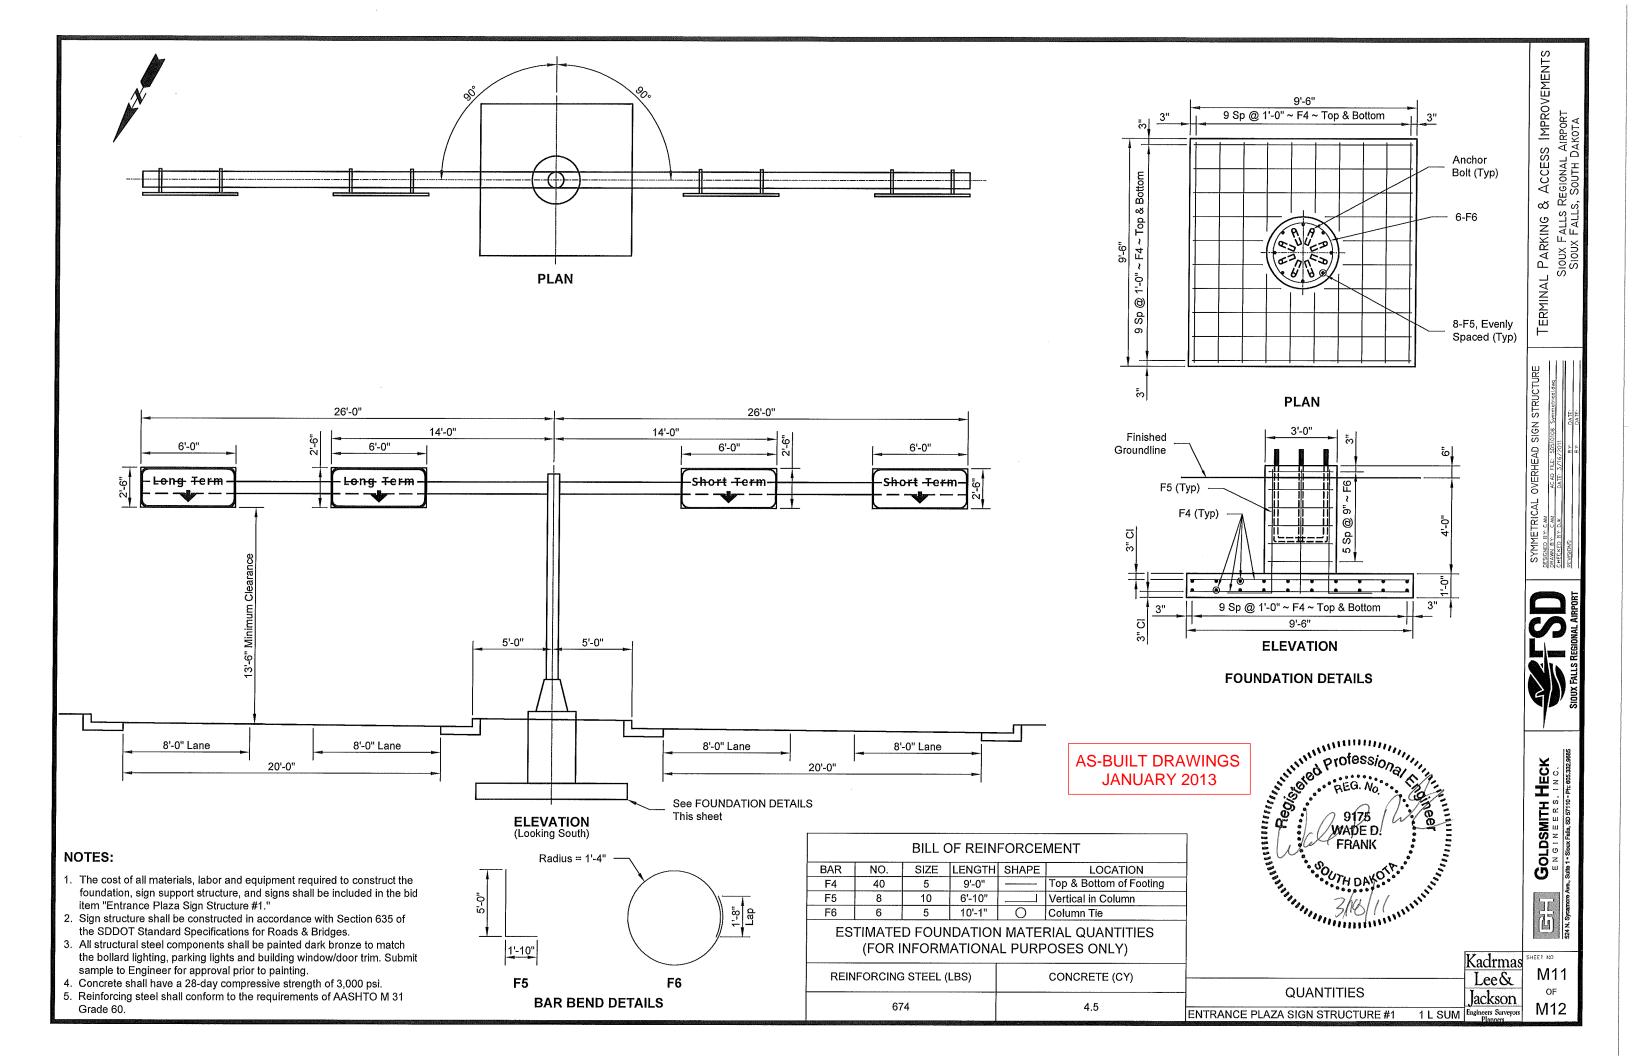

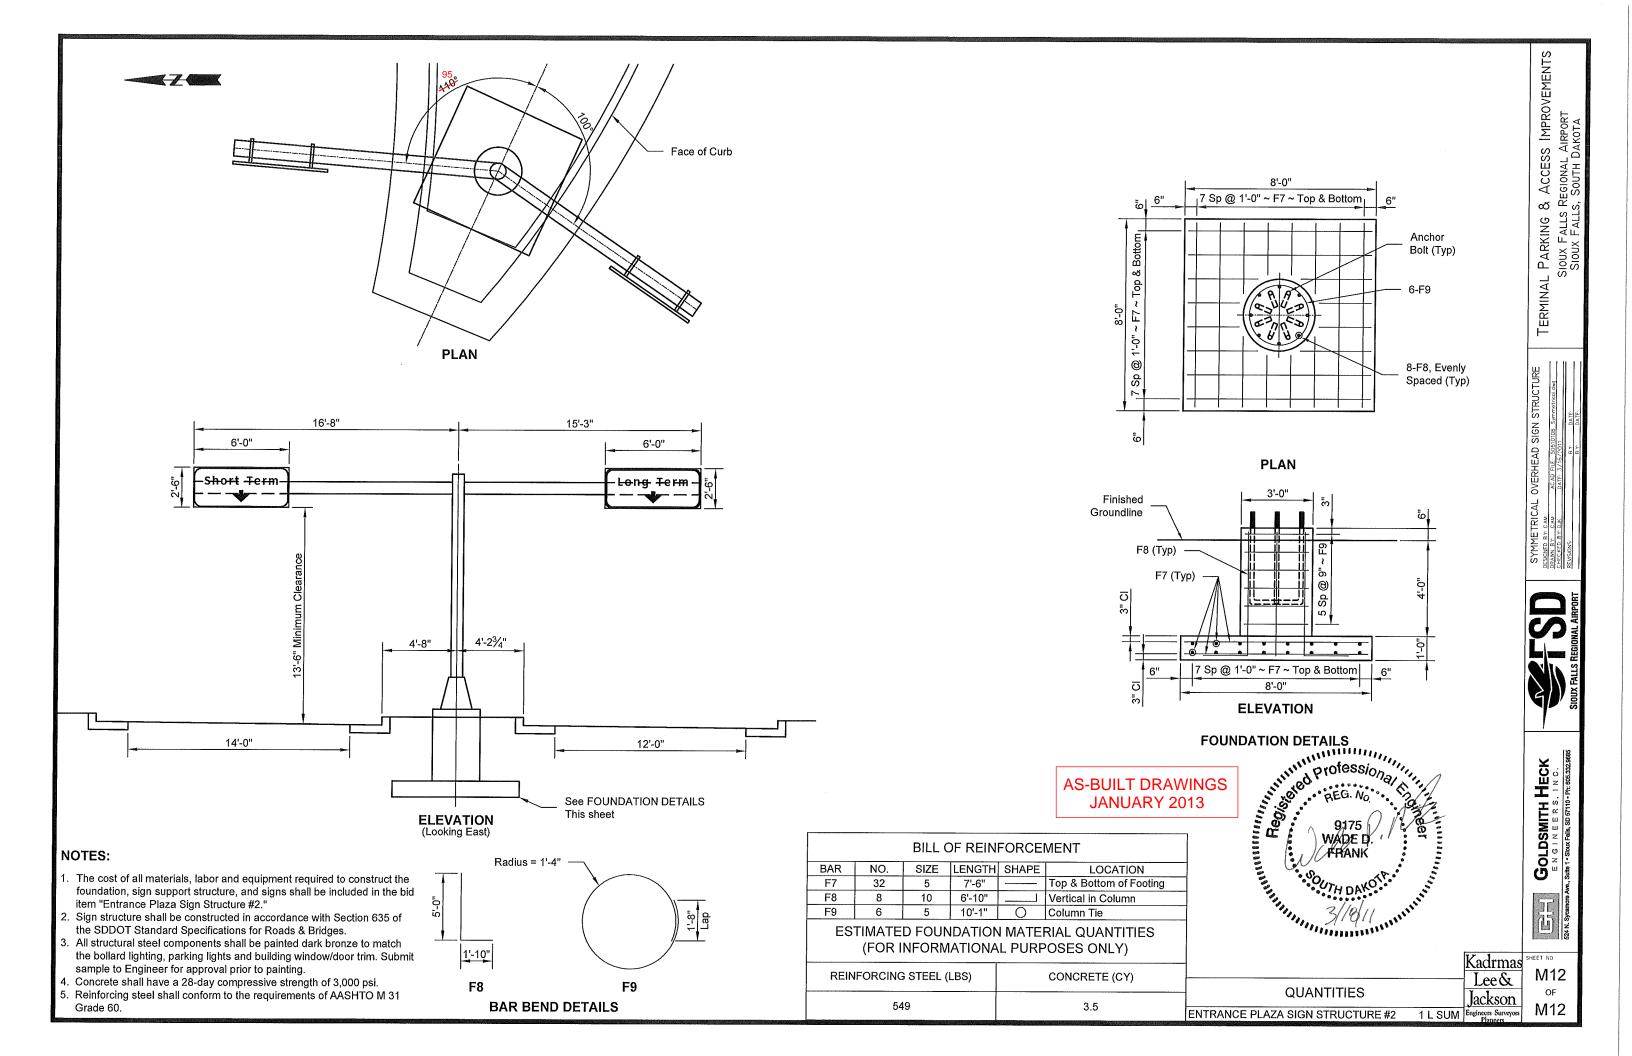

# SECTION N LIGHTING NOTES

### **GENERAL ELECTRICAL CONDITIONS**

The most current edition of the City of Sioux Falls General Conditions for Public Improvements and Supplemental Standard Specifications, together with the most current edition of the South Dakota Department of Transportation Standard Specifications for Roads and Bridges with Supplemental Specifications and Errata and required provisions. supplemental specifications, and/or special provisions as included in the Project Manual are hereby made a part of these specifications in its entirety unless otherwise revised, deleted, or supplemented herein

Electrical installation shall adhere to the most recent National Electrical Code edition adopted by the State of South Dakota along with the City of Sioux Falls electrical codes and requirements.

# **LUMINAIRES**

Luminaires shall be as specified in the lighting schedule including flood lights, area parking lot lights, roadway cobra heads, and pedestrian bollards. Each luminaire shall have internal fusing and ballast rated at the voltages indicated.

Each luminaire shall be provided and installed by the Contractor according to the project's plans and specifications along with the manufacturer's recommendations and requirements.

Contractor shall provide a lamp along with each luminaire. The Contractor shall align the fixtures as directed by the Field Engineer. In the case of the flood light the Contractor shall field adjust the aiming angle at night in the presence of the Owner and/or Field Engineer for optimal coverage

All costs in providing and installing each luminaire shall be measured and paid for on a per each basis for each different type of luminaire provided. Included in the cost shall be the luminaire, lamp, ballast, internal fusing, and all other incidental items needed to complete the installation

# REMOVE CONCRETE FOUNDATION

The Contractor shall completely remove existing concrete foundations for any removed or relocated light standard. Any voids shall be backfilled and compacted to the same density as the adjoining ground.

#### **REMOVE JUNCTION BOX**

The Contractor shall remove junction box as indicated in the plans. Any voids shall be backfield and compacted to the same density as the adjoining ground.

#### MODIFICATION TO FEED POINT

Contractor shall modify existing feed point to provide power to the existing circuits as well as the propose circuits. Modification shall include but not limited to providing new circuit breakers sized as shown on the panel schedule. Contractor shall be permitted to reuse existing circuit breakers if in working condition and sized as per the NEC. The Contractor shall be responsible for balancing the loads to be within 10% of each phase.

The modification to the feed point shall be paid on a lump sum basis under "Feed Point Modification" to connect the indicated circuits including new circuit breakers and balancing of the phases.

# MODIFICATION TO PANEL BOARD

Contractor shall modify existing panel board inside the terminal. Modification shall include disconnecting of existing parking lot lighting circuits and connecting up proposed circuits. The Contractor shall be permitted to reuse the existing circuit breakers as needed. Any additional circuit breakers needed shall be provide and installed by the Contractor as part of the "Panel Board Modification" bid item. The Contractor shall be responsible for balancing the loads to be within 10% of each phase.

The modification to the panel board inside the terminal shall be paid on a lump sum basis under "Panel Board Modification" to disconnect and connect up indicated circuits, circuit breakers, along with balancing of loads between the phases.

#### LIGHT POLE

The Contractor shall provide and install new light poles as indicated by the layout sheets and lighting schedule. The poles shall match existing parking lot and roadway poles in type, style, shape, and finish. Roadway light poles shall have transformer bases to match existing.

The light poles shall be installed with factory installed vibration dampening systems. Contractor shall provide and install all the necessary anchor bolts as required by the light pole manufacturer.

Contractor shall provide and install a 5/8"x10' ground rod adjacent to each concrete foundation. The ground rod shall be bonded to the light pole by means of a #6 AWG bare copper wire through a  $\frac{1}{2}$ " pvc conduit sleeve.

The light pole shall be designed and installed per SDDOT Standard Specifications. All the necessary calculations and drawings used in the design of these poles shall be furnished with the shop drawing submittal. Calculations and work drawings used in the design of the lighting poles shall be signed, sealed, and dated by a Professional Engineer duly registered in the State of South Dakota.

## JUNCTION BOXES

The Contractor shall provide and install junction boxes at locations shown and be the size as indicated in the plans. The Junction box shall be installed as shown in the detail and as per the manufacturer's installation instructions.

Contractor shall provide and install junction box dividers as needed to maintain separation between different systems as required by the NEC.

Electrical junction boxes shall be non metallic and as shown in the detail. Junction box shall be of the open bottom type with conduit entering through the bottom. Coarse aggregate shall be installed as bases as shown in the detail and as specified in the City of Sioux Falls and SDDOT standard specifications.

Junction boxes shall be measured and paid for at the contract price for each different size provided and installed. The appropriate designation of the lid of the junction box shall indicate ELECTRICAL or COMMUNICATION.

# CONDUIT

Conduit shall be installed at a minimum depth of 24" as indicated in the City of Sioux Falls standard specifications. All spare conduit ends shall be capped and sealed for future use. All conduit installed shall bear the Underwriter's Laboratory's label.

The cost of the method of installation shall be included in the contract price of the associated conduit, this shall include all boring, trenching, backfilling, compaction, and all restoration.

All connections to existing conduit, including any necessary fittings shall be included in the contract unit price per foot for the conduit.

#### CONDUCTORS

Electrical conductors shall be provided and installed in conduit. All conductors shall be the type and size indicated meeting City of Sioux Falls and NEC standards and requirements.

All conductors shall be paid for per linear foot for each separate size indicated. Included in the bid price shall be all labor to provide and install conductor in conduit along with making connection and/or splices.

#### **TEMPORARY LIGHTING**

The Contractor shall disconnect the existing lighting services that correspond to project construction phases. Parking lots and roadway sections that are not under construction and open to the public for use the lighting shall remain in operation. Areas that are closed off due to construction may be disabled. The Contractor shall provide all the necessary temporary lighting conductors, trenching, and connections needed as directed by the Field Engineer.

The cost of maintaining the temporary lighting for the designated sections shall be measured and paid for on a lump sum price for all work, labor, and materials needed to maintain the lighting system operational in open/active areas.

## UTILITY COORDINATION

The Contractor shall coordinate with Mike Burkard with Municipal Light & Power on providing a new electrical service for the proposed exit plaza. The electrical service shall be rated at 200 amps, 120/240V single phase.

The Utility Company shall supply primary along with a pad mounted transformer and meter at an approximate location shown. The Contractor shall be responsible for a new meter socket with a bypass lever, service disconnect, all secondary conductors, trenching, and conduit sweep from the transformer to the meter location. The meter shall be located on the side of the building. The Contractor shall coordinate with the exit plaza contractor on mounting and installed the electrical service.

Falls electrical codes.

The Contractor shall be responsible for any additional fees imposed by the Utility Company for providing the new transformer and primary service to the new exit plaza.

The utility coordination for the new electrical service shall be measured and paid for on lump sum basis under "Utility Electrical Service". Included shall be all materials, labor, and incidental items including any imposed fees by the Utility to install the new service complete.

# REMOVE AND RESET LUMINAIRE POLE

Existing luminaire poles as indicated in the plans shall be removed and reset to new locations as shown on the plan sheets. Luminaire poles and luminaires damaged during relocation shall be repaired or replaced by the Contractor at no cost to the Owner. It shall be the Contractor's responsibility to obtain the bolt circle pattern and anchor bolts for the relocated poles from the pole manufacturer.

All costs involved with removing and resetting the existing luminaire poles shall be incidenta to the contract unit price per each for "Remove and Reset Luminaire Pole".

# PULL WIRES

#### **EXIT SIGN CONNECTION**

circuit

# WELL PUMP CONNECTION

The Contractor shall install the well pump and well pump controls. The well pump an controls are being providing by the well contractor. The electrical contractor shall b responsible for providing all the necessary conduit, conductors, connections, and require disconnects. The well pump controls shall be located and powered from the exit plaza Contractor shall coordinate with exit plaza contractor on exact location and entrances int the plaza building.

The well pump is rated for 5hp at 240 volt single phase, all the required disconnects an circuit breakers shall be sized as required by the NEC and as recommended by the pum manufacturer

Included in the cost of the well pump connection shall be all underground conductors an conduit needed from the exit plaza to well pump location.

#### LOOP DETECTOR

The Contractor shall install preformed loop detectors for each gate arm. The preforme loops shall be provided by the gate supplier and installed by the Contractor. The loops sha be installed per the manufacturer's recommendations and requirements.

The cost of installing the loops shall be measured and paid for on a per each basis for each loop installed.




The meter socket shall be meet the requirements of the Utility Company. The new electrica service shall meet the requirements of the NEC and State of South Dakota and City of Sioux

Provide a #10 AWG pull wire in all spare conduits. The cost of providing and installing pu wires shall be included in the contract price per foot for 1/C #10 AWG Copper Wire.


The Contractor shall connect the internally lit exit signs up to the designated circuit. The Contractor shall coordinate with the sign supplier and the prime contractor on providing conduit sweeps for the entering/exiting conductors. The connection of the exit signs shall b considered incidental to the cost of providing and installing the underground conductors. N additional payment shall be made for connecting the internally lit signs to the appropriate

The cost of connecting up the well pump and controls shall be measured and paid for on lump sum basis including disconnects, circuit breakers, conduit, conductors, connections and installation of controls to complete the well water system.

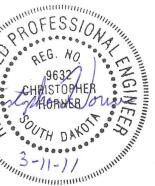



-		and a fact of			
al IX	ENTS				
y	ROVEM	RT	4		
a d	ACCESS IMP	GIONAL AIRPOI	SOUTH DAKOTA		
w ig ie ie	TERMINAL PARKING & ACCESS IMPROVEMENTS	SIOUX FALLS REGIONAL AIRPORT	SIOUX FALLS, SOUTH DAKOTA		
al	ERMINAL F	ŝ	0)	1	
ıll	-				
a a lo te	GENERAL NOTES	FILE: 210710_General Notes.doc DATE: 3/11/2011	BY: DATE:	BY: DATE:	
nd be ed a. to	DESIGNED BY: CH	DRAWN BY: CH CHECKED BY: CH	REVISIONS:		
nd 1p			NAL AIRPORT		
nd			ALLS REGION.		
a s,	2	D	SIOUX F		
ed all	HECK	INC.	- Ph: 605.332.9685		
ch	SOI DSMITH HECK	с С С С С	alls, SD 57110 -		
			., Suite 1 - Sioux I		
-	C		524 N. Sycamore Ave., Suite 1 - Sioux Falls, SD 57110 - Ph: 605.332.9685		
ŝ		ю. N1 оғ			
	1	₀⊧ 11:	3		A REAL PROPERTY AND INC.

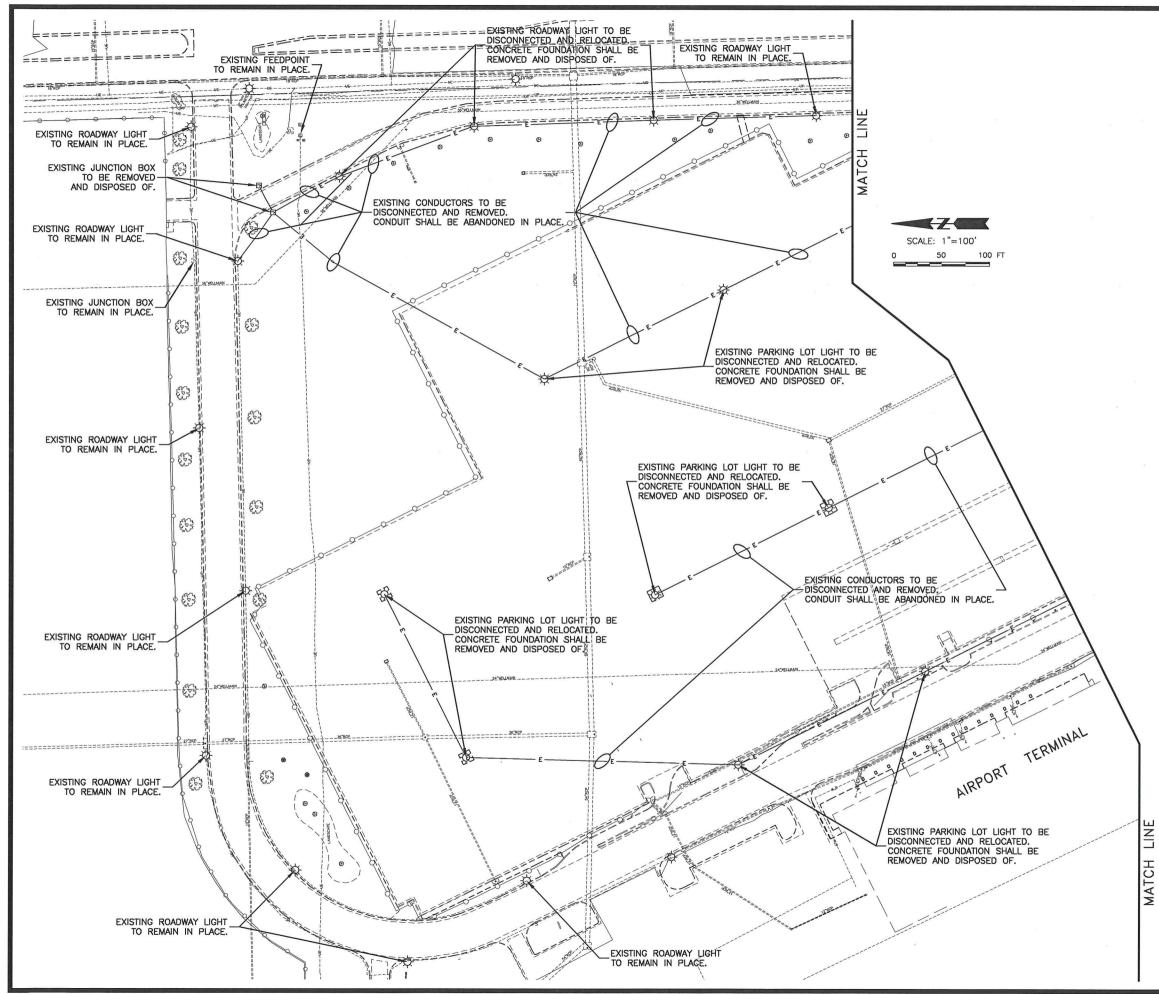

J:\airport\50509106\CAD\work\Terminal\_Parking\_Lot\210710\_Elec\_Layout2.dwg

<u>GENERAL NOTES:</u> 1. FIELD VERIFY THE EXACT LOCATIONS OF EXISTING UNDERGROUND UTILITIES BEFORE COMMENCING WORK, CONTRACTOR SHALL BE FULLY RESPONSIBLE FOR ANY AND ALL DAMAGES WHICH MIGHT OCCUR BY FAILURE TO EXACTLY LOCATE AND PRESERVE ANY AND ALL UNDERGROUND UTILITIES.


2. CONTRACTOR SHALL REMOVE AND DISPOSE OF CONCRETE FOUNDATIONS INDICATED TO BE REMOVED.

3. CONTRACTOR SHALL DISCONNECT AND RELOCATE EXISTING ROADWAY AND PARKING LOT LIGHTS AS INDICATED. THE DISCONNECTED LIGHTS SHALL BE SALVAGED AND STORED PRIOR TO RELOCATION. ANY DAMAGE TO THE REMOVED LIGHT FIXTURES AND STANDARDS DURING THE REMOVAL OR RELOCATING SHALL BE THE RESPONSIBILITY OF THE CONTRACTOR.

4. CONTRACTOR SHALL DISCONNECT EXISTING CIRCUITS AS NEEDED FROM THE FEED POINT AND FROM THE PANEL INSIDE OF THE TERMINAL. CONTRACTOR SHALL VERIFY WHICH LIGHTS AND CIRCUITS NEED TO BE DISCONNECTED.

5. CONTRACTOR SHALL MAINTAIN EXISTING LIGHTS IN OPERATION AS NEEDED WITHIN AREAS NOT BEING AFFECTED BY CONSTRUCTION. REFER TO SPECIFICATIONS FOR ADDITIONAL REQUIREMENTS.



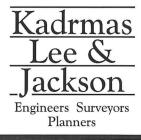

- PARKING & ACCESS IMPROVEMENTS SIOUX FALLS REGIONAL AIRPORT SIOUX FALLS, SOUTH DAKOTA TERMINAL AL ACAD FILE: XXX.d DATE: 3/11/2011 DESIGNED BY: C.H. DRAWN BY: C.A.S. CHECKED BY: C.H. REVISIONS:



**GOLDSMITH HECK** 

524 N. Sycamo

SHEET NO.


N2


OF

N13

505

E.

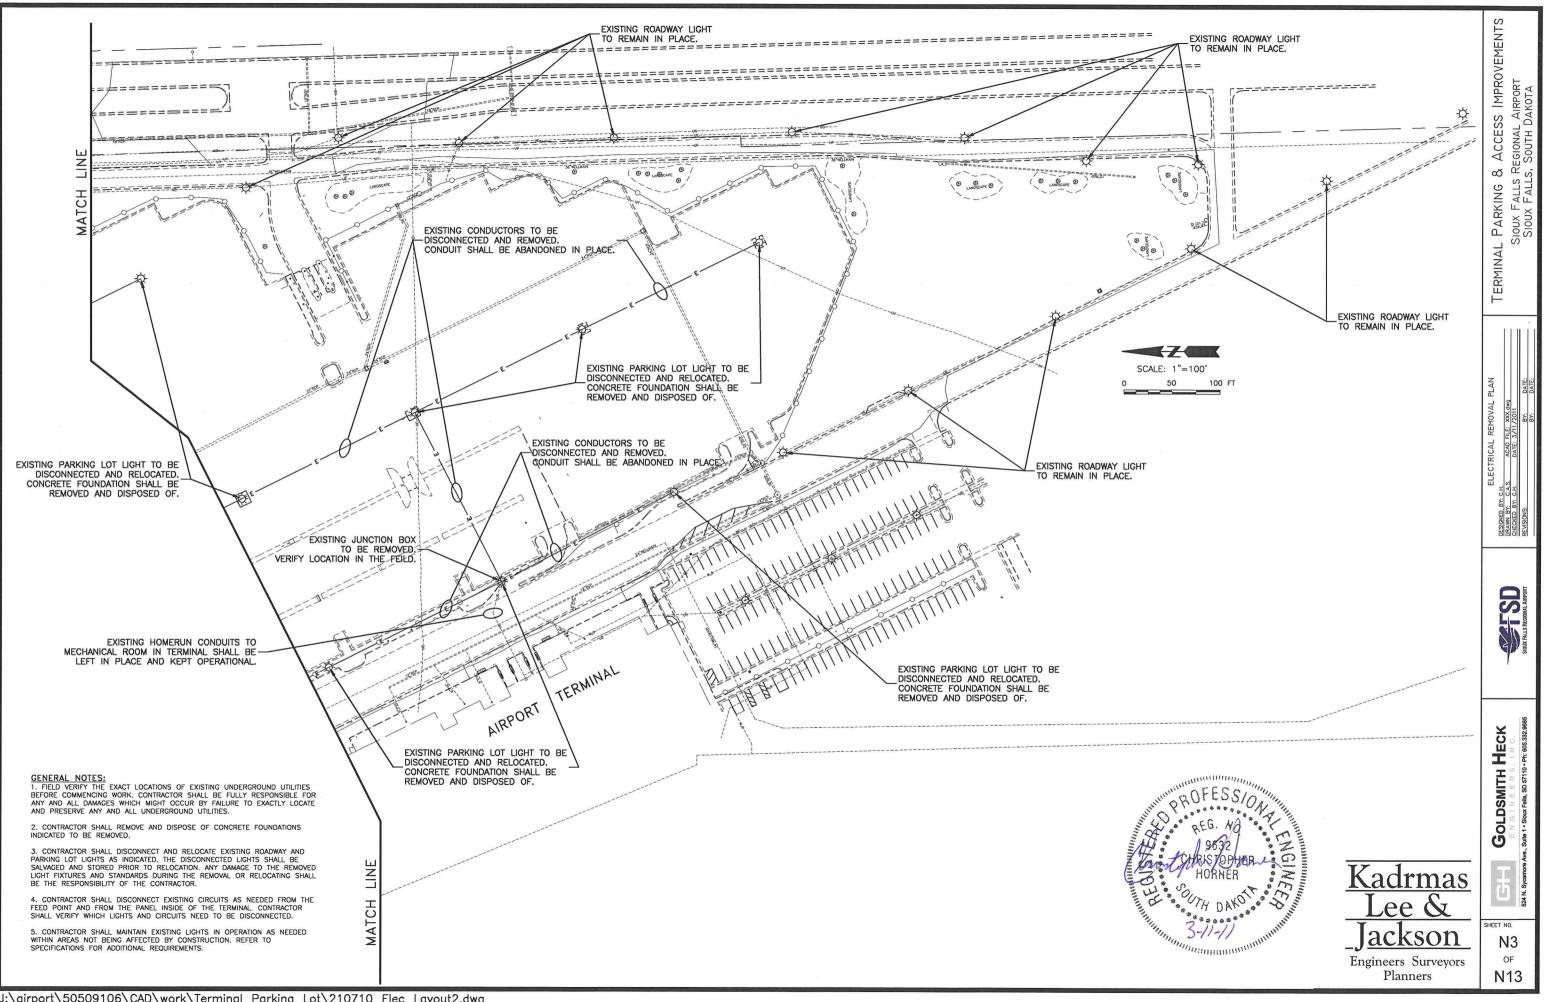

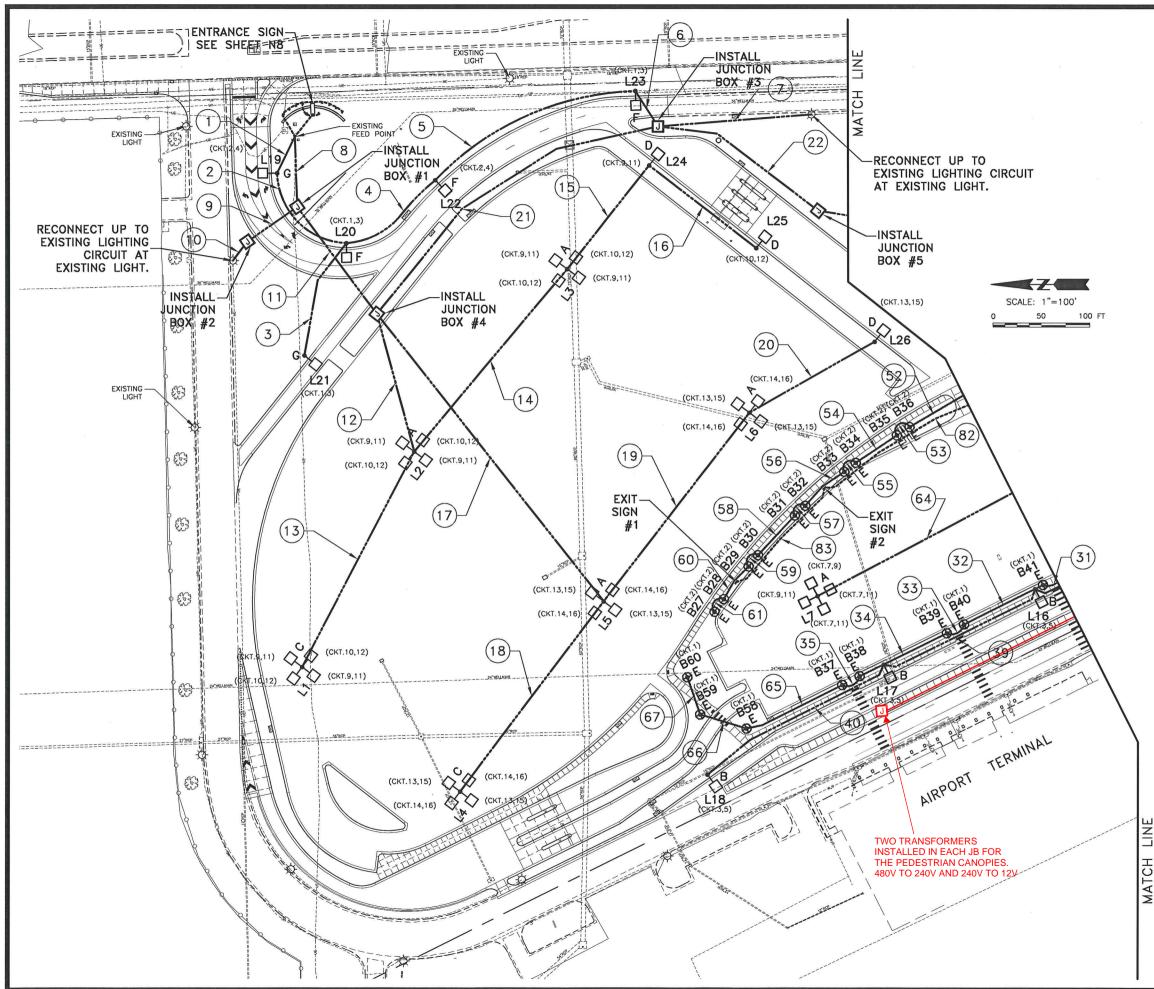

J:\airport\50509106\CAD\work\Terminal\_Parking\_Lot\210710\_Elec\_Layout2.dwg

<u>GENERAL NOTES:</u> 1. FIELD VERIFY THE EXACT LOCATIONS OF EXISTING UNDERGROUND UTILITIES BEFORE COMMENCING WORK. CONTRACTOR SHALL BE FULLY RESPONSIBLE FOR ANY AND ALL DAMAGES WHICH MIGHT OCCUR BY FAILURE TO EXACTLY LOCATE AND PRESERVE ANY AND ALL UNDERGROUND UTILITIES.

S

VEMENT

IMPR0

Access

8 ACUL

ALLS FALLS

FERMINAL PARKING 8 SIOUX FALLS SIOUX FALLS

OF

N13

**Engineers** Surveyors

Planners

P O

2 CONTRACTOR SHALL MAINTAIN TEMPORARY LIGHTING DURING THE SEPARATE 2. CONTINUE OF STALL MAINTAIN TEMPORARY LIGHTING DURING THE SEPAR PHASES OF CONSTRUCTION. LIGHTS IN AREAS THAT ARE INDICATED TO BE OPENED FOR PUBLIC USE SHALL REMAIN CONNECTED AND IN OPERATION. COORDINATE WITH THE FIELD ENGINEER ON WHICH LIGHTS AND AREAS THAT ARE TO REMAIN IN OPERATION OR BE DISABLED

3. CONTRACTOR SHALL RECONNECT CIRCUITS TO EXISTING LIGHTS AS SHOWN. BE INCIDENTAL TO THE COST OF THE UNDERGROUND CONDUCTORS.

4 CONTRACTOR SHALL RELISE EXISTING PANEL INSIDE TERMINAL FOR THE 4. CONTRACTOR SHALL REUSE EASTING PAREL INSIDE TERMINAL FOR THE PROPOSED EXIT SIGNS, SHORT TERM PARKING LOT, PEDESTRIAN BOLLARDS, AND WELCOME SIGN LIGHTS. CONTRACTOR SHALL BE PERMITTED TO REUSE EXISTING CIRCUIT BREAKERS AS NEEDED. ANY ADDITIONAL CIRCUIT BREAKERS SHALL BE PROVIDED AND INSTALLED BY THE CONTRACTOR.


5. ALL PROPOSED LIGHTS SHALL BE TIED INTO THE EXISTING LIGHTING SO ALL PROPOSED LIGHTS SHALL BE INTO THE EXISTING LIGHTING CONTROL CIRCUIT AT THE FEED POINT AND INSIDE THE TERMINAL. CONTRACTOR SHALL BE PERMITED TO REUSE THE EXISTING LIGHTING CONTACTORS. IF ADDITIONAL POLES ARE NEEDED, THE CONTRACTOR SHALL PROVIDE A NEW CONTACTOR WITH A MINIMUM OF 8 POLES AND RATED FOR 60AMPS.


6. COORDINATE EXACT LOCATIONS OF PEDESTRIAN BOLLARDS WITH THE LANDSCAPE ARCHITECT PRIOR TO INSTALLATION.

7. PARKING LOT LIGHTS SHALL BE INSTALLED AT THE INTERSECTIONS OF THE PARKING STRIPES. IF PROPOSED LOCATIONS CONFLICT WITH UNDERGROUND UTILITIES THE CONTRACTOR SHALL INFORM THE ENGINEER FOR APPROVAL OF SHIFTING OF THE LIGHT TO THE NEXT PARKING STALL.


8. CONTRACTOR SHALL UTILIZE EXISTING CONDUIT RUNS FROM THE TERMINAL FOR THE PROPOSED LIGHTING. ADDITIONAL CONDUIT STUBS ARE BEING PROVIDED UNDER THE TERMINAL BUILDING ADDITION PROJECT.

9. SEE SHEET H8 FOR SIGNAL UNDERGROUND AND MINNESOTA AVENUE STREET LIGHTING WORK

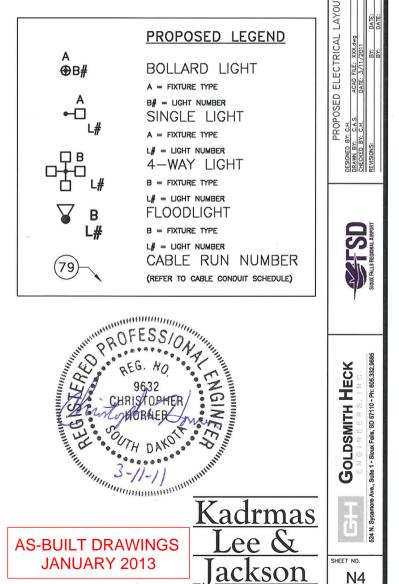

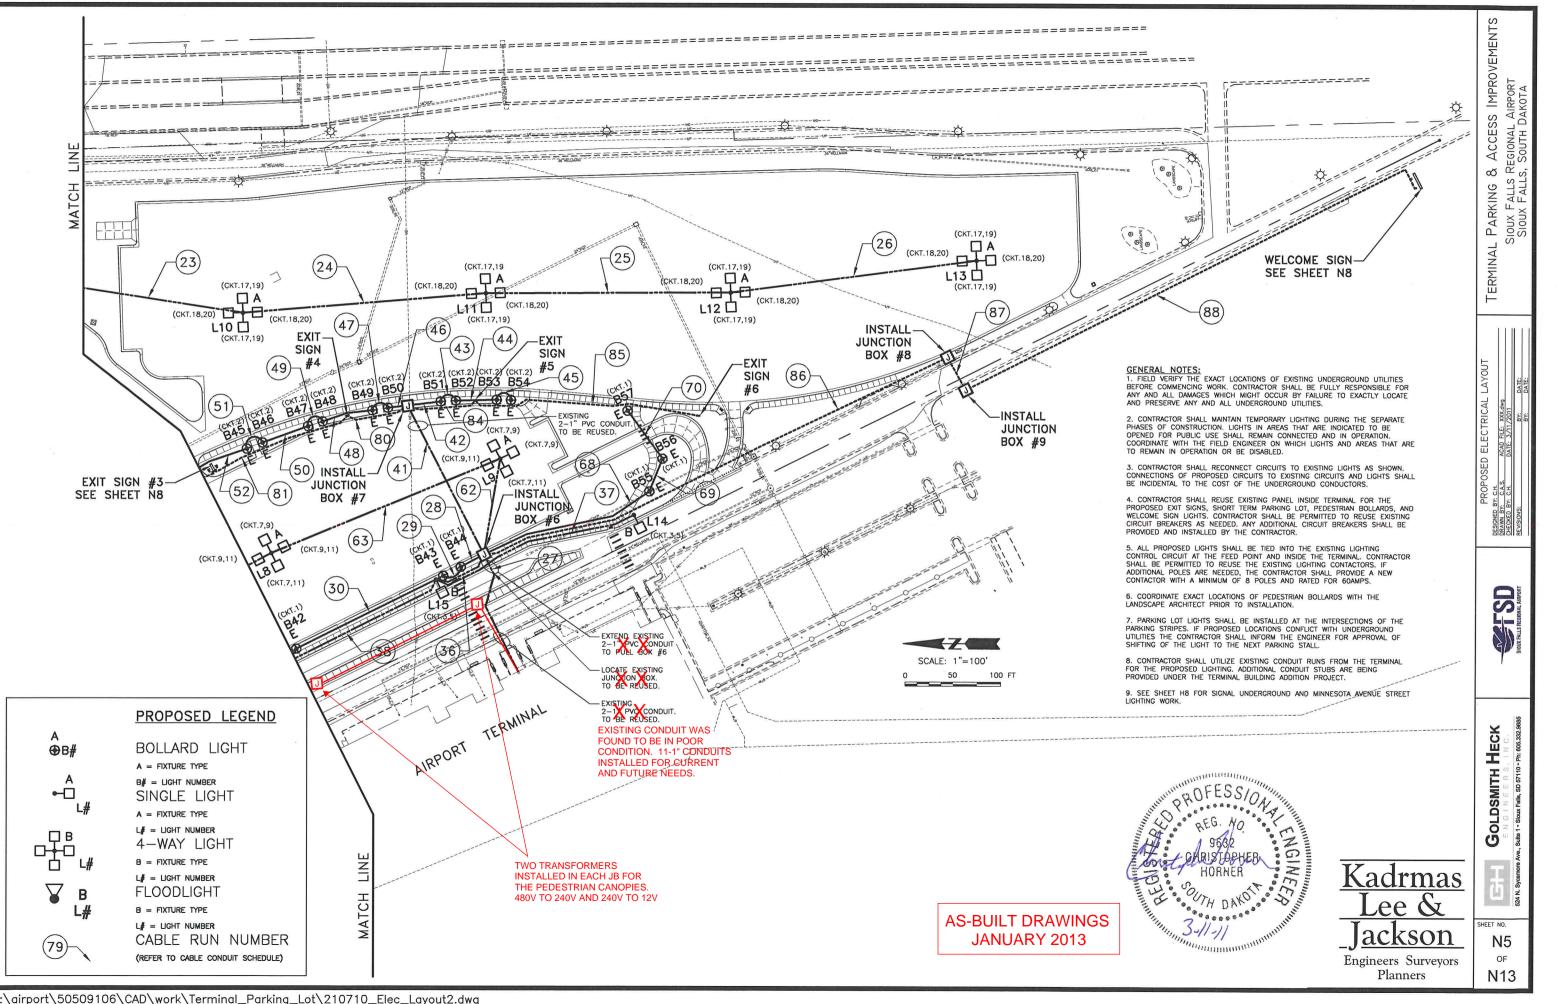


J:\airport\50509106\CAD\work\Terminal\_Parking\_Lot\210710\_Elec\_Layout2.dwg

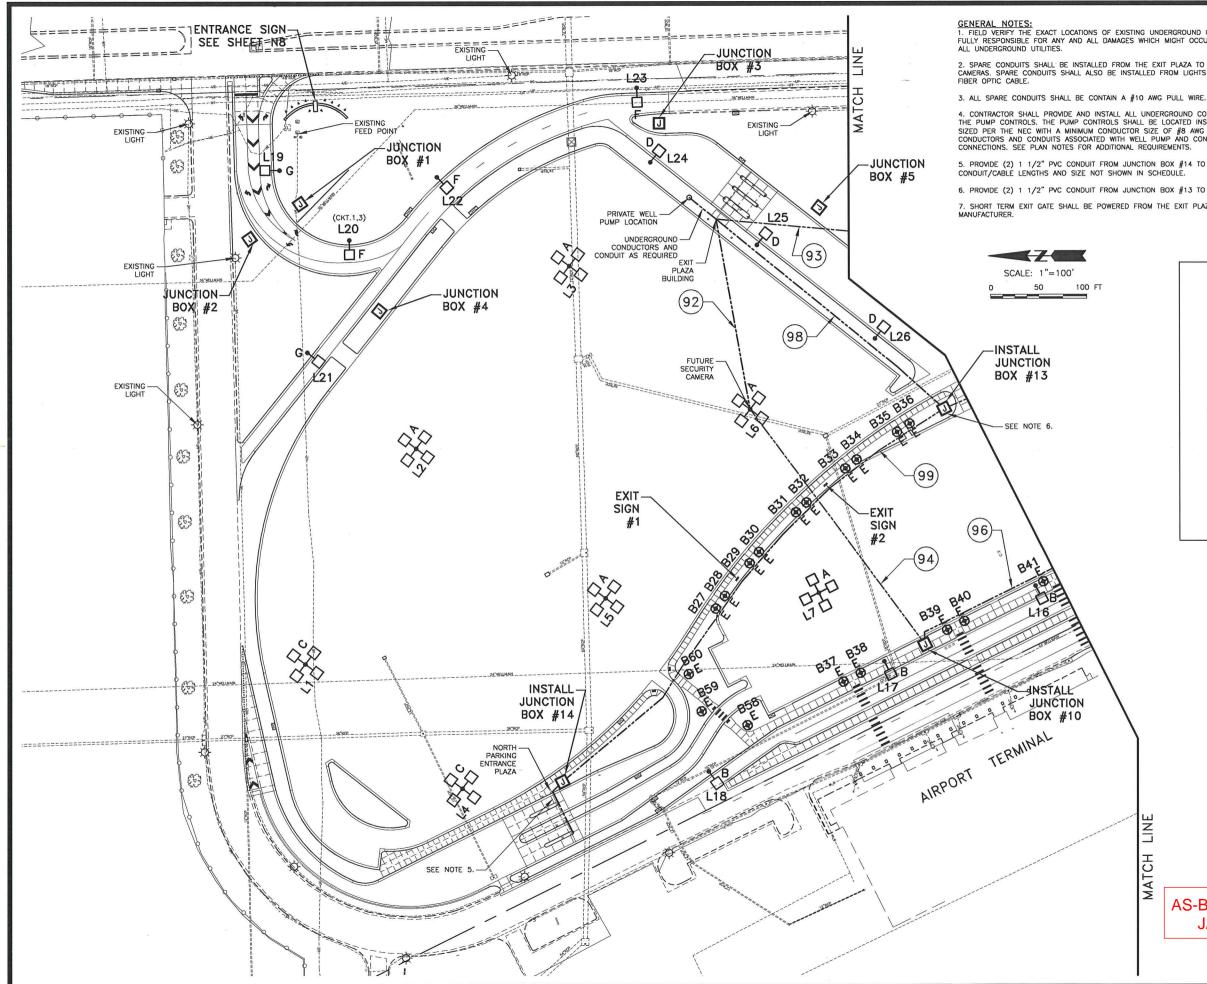



J:\airport\50509106\CAD\work\Terminal\_Parking\_Lot\210710\_Elec\_Layout2.dwa


ACCESS IMPROVEMENTS GENERAL NOTES: 1. FIELD VERIFY THE EXACT LOCATIONS OF EXISTING UNDERGROUND UTILITIES BEFORE COMMENCING WORK. CONTRACTOR SHALL BE FULLY RESPONSIBLE FOR ANY AND ALL DAMAGES WHICH MIGHT OCCUR BY FAILURE TO EXACTLY LOCATE AND PRESERVE ANY AND 2. SPARE CONDUITS SHALL BE INSTALLED FROM THE EXIT PLAZA TO LIGHTS L6 AND L12 FOR FUTURE POWERING OF SECURITY FIRE OPTIC CABLES. SPARE CONDUCTS SHALL ALSO BE INSTALLED FROM LIGHTS L6 AND L12 ROUTED BACK TO THE TERMINAL FOR FUTURE FIBER OPTIC CABLE. SIOUX FALLS REGIONAL AIRPORT SIOUX FALLS, SOUTH DAKOTA 4. CONTRACTOR SHALL PROVIDE AND INSTALL ALL UNDERGROUND CONDUIT AND CONDUCTORS FROM THE PRIVATE WELL PUMP TO THE PUMP CONTROLS. THE PUMP CONTROLS SHALL BE LOCATED INSIDE THE EXIT PLAZA. ALL CONDUCTORS AND CONDUIT SHALL BE SIZED PER THE NEC WITH A MINIMUM CONDUCTOR SIZE OF #8 AWG AND CONDUCTORS ISZE OF 1" PVC. ALL UNDERGROUND CONDUCTORS AND CONDUITS ASSOCIATED WITH WELL PUMP AND CONTROLS SHALL BE INCIDENTAL TO THE COST OF THE WELL PUMP 5. PROVIDE (2) 1 1/2" PVC CONDUIT FROM JUNCTION BOX #14 TO THE GATE #1 TO GATE #2 TO GATE #3 TO GATE #4. CONDUIT/CABLE LENGTHS AND SIZE NOT SHOWN IN SCHEDULE. ð PARKING { 6. PROVIDE (2) 1 1/2" PVC CONDUIT FROM JUNCTION BOX #13 TO GATE. CONDUIT/CABLE NOT SHOWN IN SCHEDULE. 7. SHORT TERM EXIT GATE SHALL BE POWERED FROM THE EXIT PLAZA. PROVIDE NECESSARY CIRCUIT BREAKERS AS REQUIRED BY ERMINAL PROPOSED LEGEND Α BOLLARD LIGHT **⊕**B# A = FIXTURE TYPE B# = LIGHT NUMBER -SINGLE LIGHT A = FIXTURE TYPEL# = LIGHT NUMBER ПВ 4-WAY LIGHT ACAD FILE: DATE: 3/11/ B = FIXTURE TYPE Ċ. L# = LIGHT NUMBER  $\nabla$ FLOODLIGHT В B = FIXTURE TYPE C.H. L# = LIGHT NUMBER CABLE RUN NUMBER DESIGNED B DRAWN BY: CHECKED B (79) (REFER TO CABLE CONDUIT SCHEDULE) STSD ST 9632 GOLDSMITH HECK ISTORHE HORNER OUTH DAKO Kadrmas 66 N **AS-BUILT DRAWINGS** HEET NO. **JANUARY 2013** lackson N6 OF Engineers Surveyors Planners N13

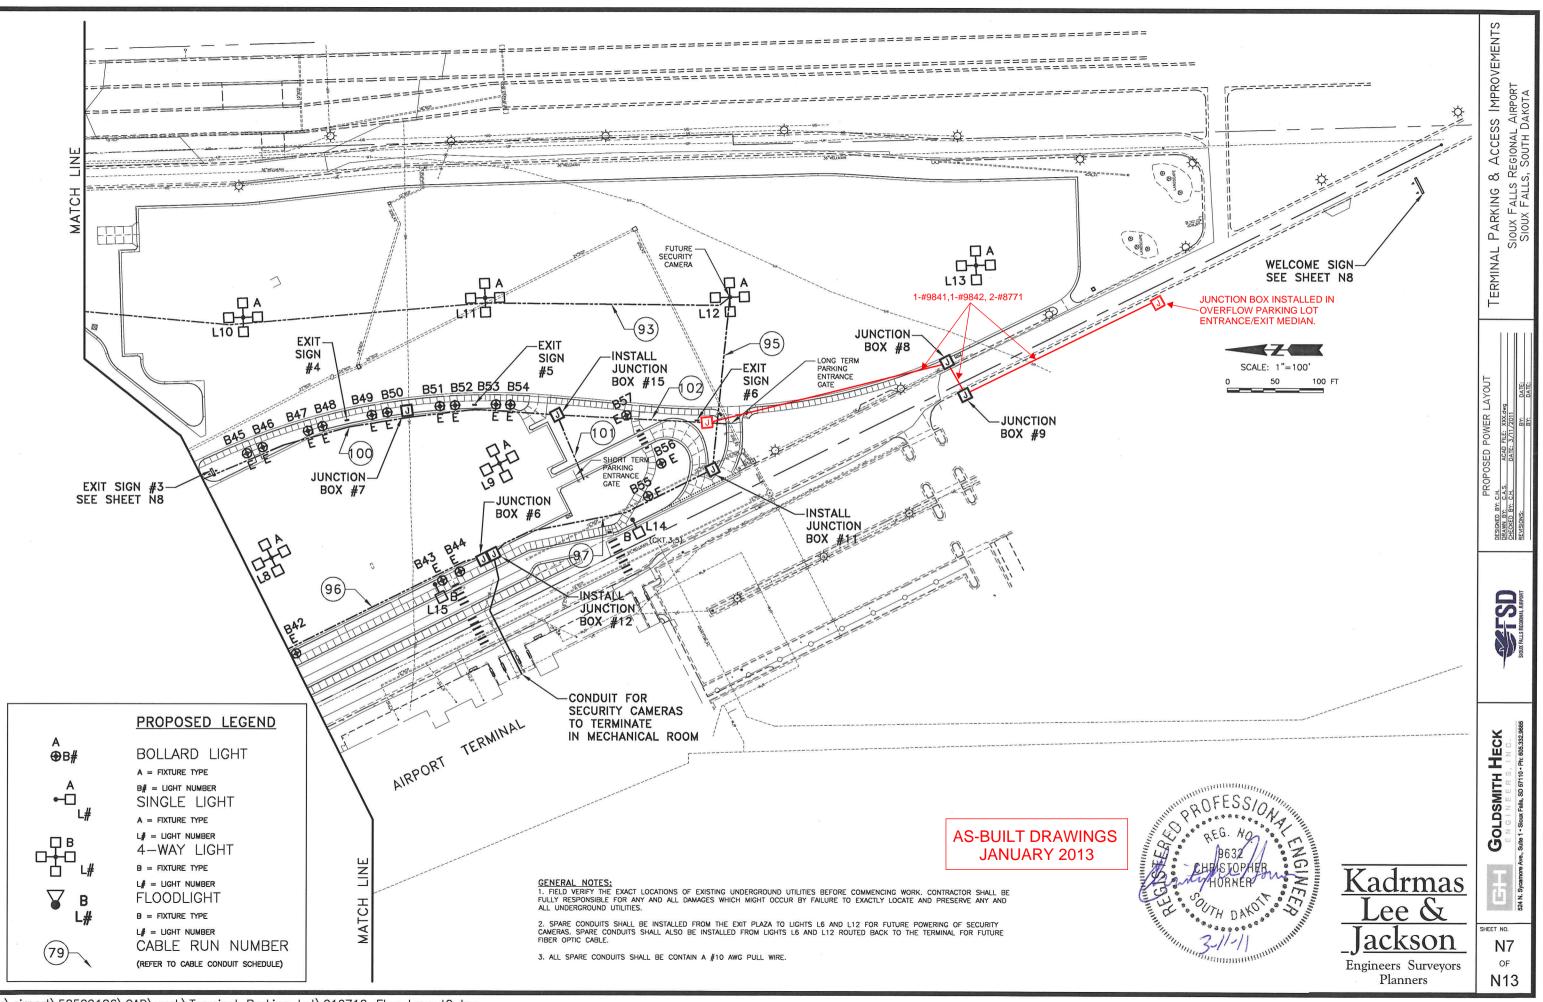

J:\airport\50509106\CAD\work\Terminal\_Parking\_Lot\210710\_Elec\_Layout2.dwg

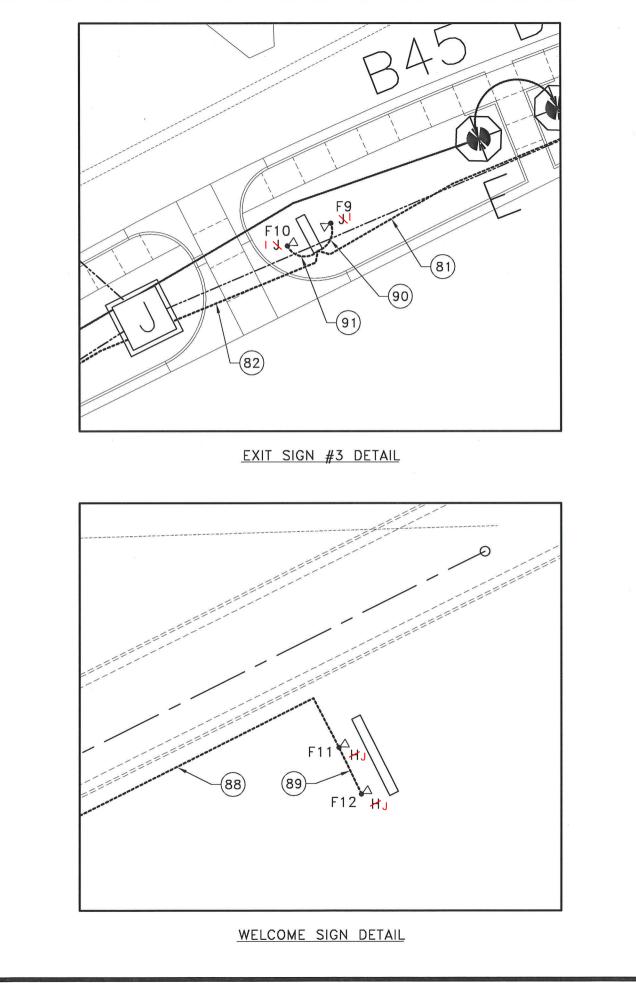


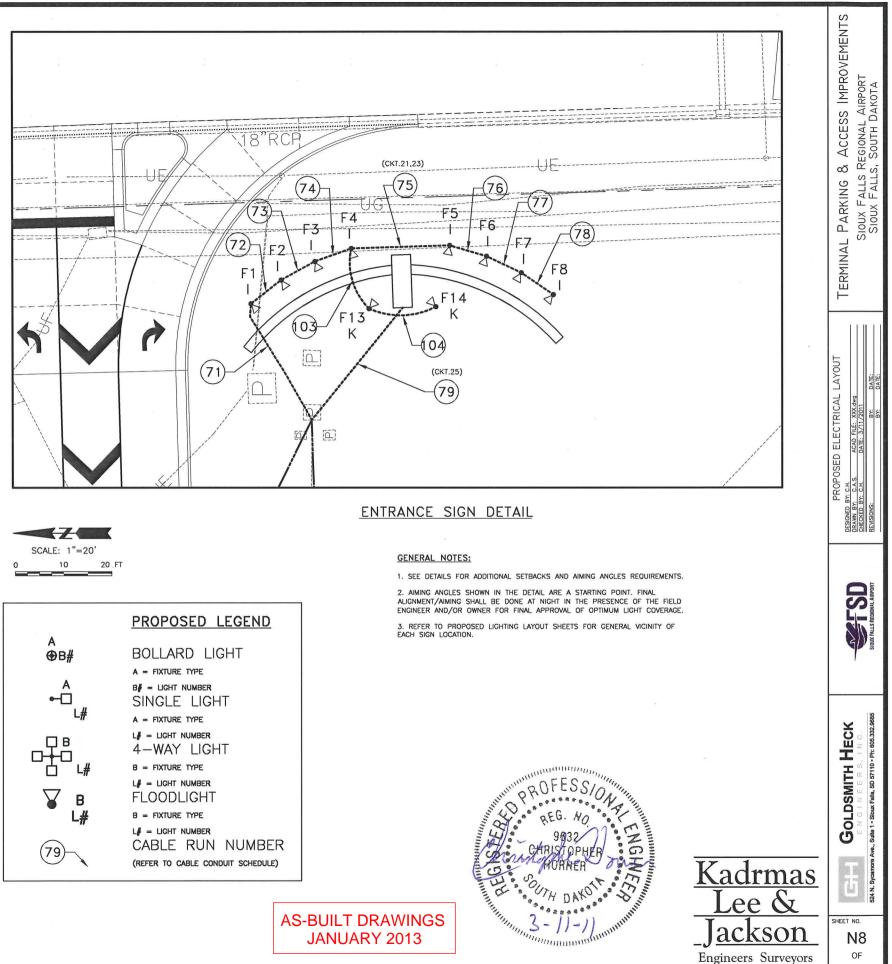

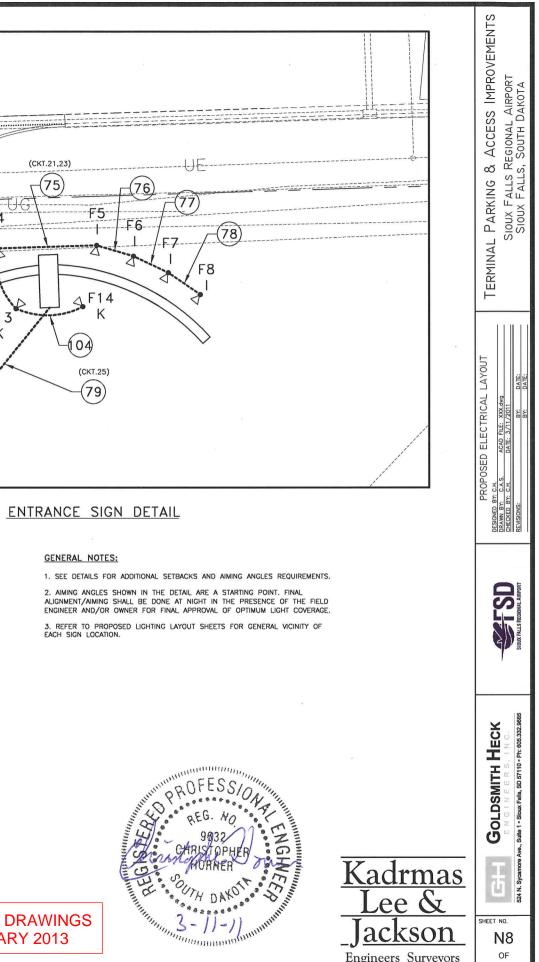


Planners

N13

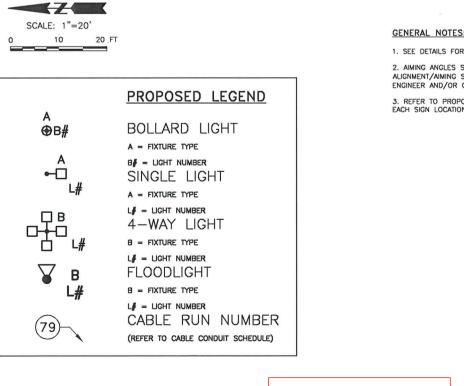

J:\airport\50509106\CAD\work\Terminal\_Parking\_Lot\210710\_Elec\_Layout2.dwg

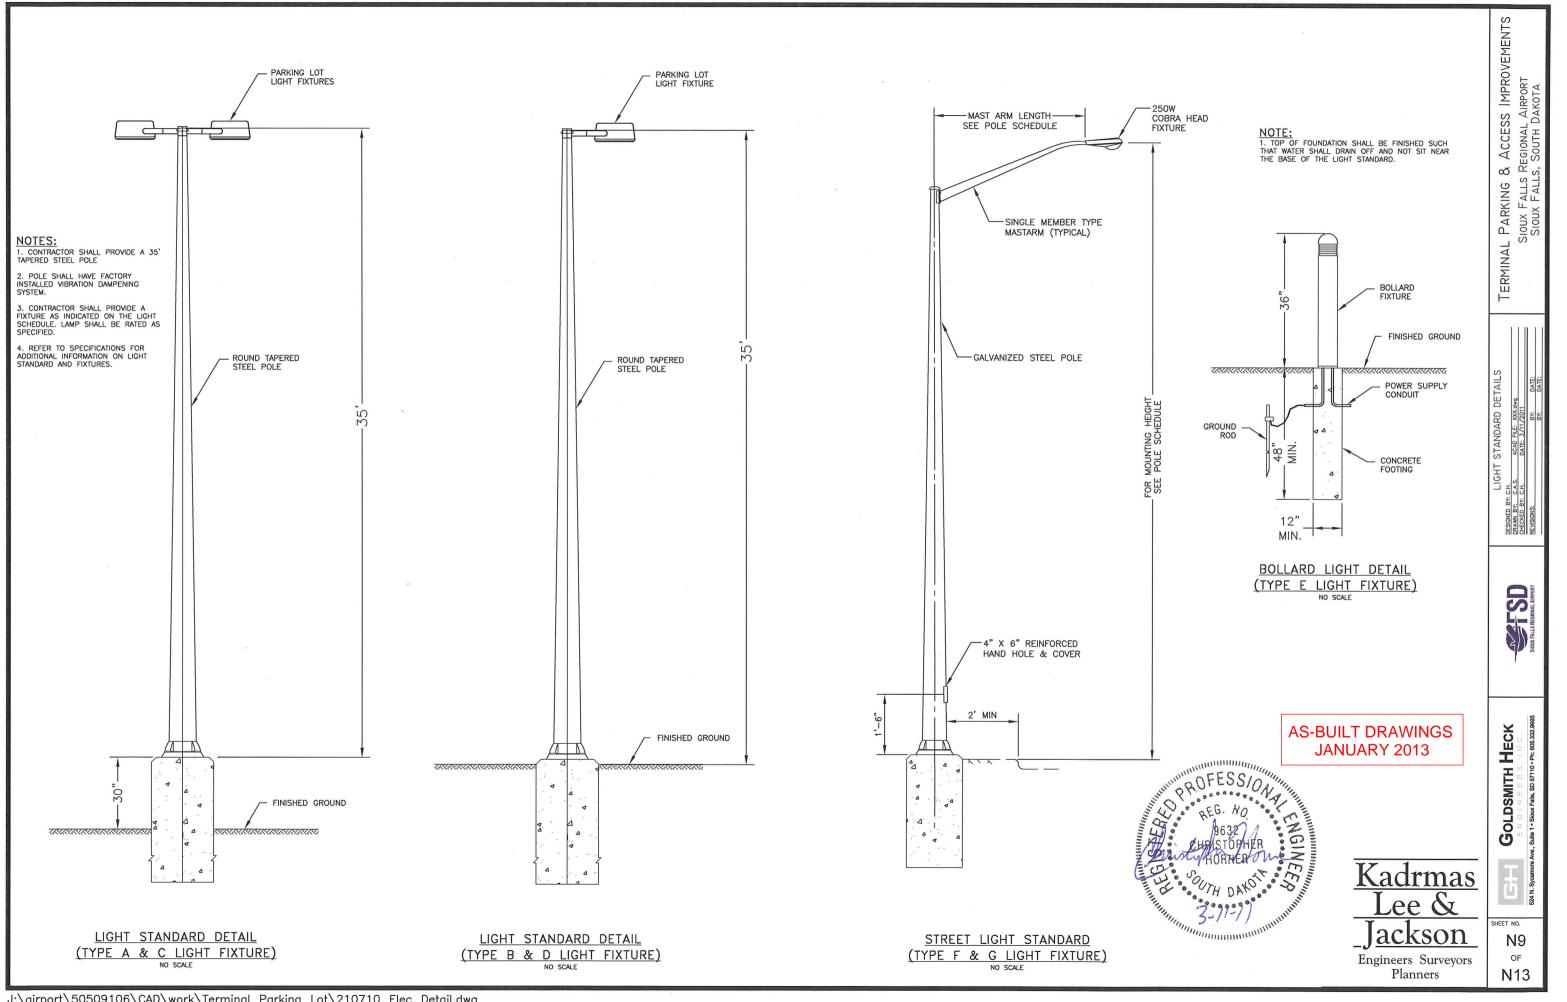

J:\airport\50509106\CAD\work\Terminal\_Parking\_Lot\210710\_Elec\_Detail.dwg

"and

UN	ITEM		UIT RUN SIZE (IN)	TOTAL LF	CABLE RUN SIZE/TYPE
	Feed Point #1			236	(4) UNDERGROUND CONDUCTOR NO. 6 THW (CKT 1,3 & CKT 2,4)
1	to Light L19	43	1-1/2"	59	UNDERGROUND CONDUCTOR NO. 8 GROUND
,	Light L19	140	1 1/0"	500 125	(4) UNDERGROUND CONDUCTOR NO. 6 THW (CKT 1,3 & CKT 2,4) UNDERGROUND CONDUCTOR NO. 8 GROUND
2	to Light L20	113	1-1/2"	125	
3	Light L20 to	129	1-1/2"	282 141	(2) UNDERGROUND CONDUCTOR NO. 6 THW (CKT 1,3) UNDERGROUND CONDUCTOR NO. 8 GROUND
ĭ.	Light L21	129	1-1/2		
4	Light L20 to	117	1-1/2"	516 129	(4) UNDERGROUND CONDUCTOR NO. 6 THW (CKT 1,3 & CKT 2,4) UNDERGROUND CONDUCTOR NO. 8 GROUND
<u> </u>	Light L22				
5	Light L22 to	234	1-1/2"	984 246	(4) UNDERGROUND CONDUCTOR NO. 6 THW (CKT 1,3 & CKT 2,4) UNDERGROUND CONDUCTOR NO. 8 GROUND
° .	Light L23				
6	Light L23 to	44	1-1/2"	224 56	(4) UNDERGROUND CONDUCTOR NO. 6 THW (CKT 1,3 & CKT 2,4) UNDERGROUND CONDUCTOR NO. 8 GROUND
	Junction Box #3				
7	Junction Box #3 to	160	1-1/2"	688 172	(4) UNDERGROUND CONDUCTOR NO. 6 THW (CKT 1,3 & CKT 2,4) UNDERGROUND CONDUCTOR NO. 6 GROUND
	Existing Light E2				
	Feed Point #1 to	296	(4) 1-1/2"	720 360	<ul> <li>(8) UNDERGROUND CONDUCTOR NO. 6 THW (CKT 9,11 CKT 10,12 CKT 13,15 &amp; CKT 14,16)</li> <li>(4) UNDERGROUND CONDUCTOR NO. 2 THW (CKT 17,19 &amp; CKT 18,20)</li> </ul>
8	Junction Box #1			360	(4) UNDERGROUND CONDUCTOR NO. 10 THW (CKT 5,7 & CKT 6,8)
				270 90	(3) UNDERGROUND CONDUCTOR NO. 8 GROUND UNDERGROUND CONDUCTOR NO. 10 GROUND
9	Junction Box #1	400	(2) 4 4 (2)	304	(4) UNDERGROUND CONDUCTOR NO. 10 THW (CKT 5,7 & CKT 6,8)
9	to Junction Box #2	128	(2) 1-1/2"	76	UNDERGROUND CONDUCTOR NO. 10 GROUND
10	Junction Box #2	25	1-1/2"	148 37	(4) UNDERGROUND CONDUCTOR NO. 10 THW (CKT 5,7 & CKT 6,8) UNDERGROUND CONDUCTOR NO. 10 GROUND
10	to Existing Light E1	25	1-1/2	N 20	
11	Junction Box #1 to	556	(4) 1-1/2"	1208 604	<ul> <li>(8) UNDERGROUND CONDUCTOR NO. 6 THW (CKT 9,11 CKT 10,12 CKT 13,15 &amp; CKT 14,16)</li> <li>(4) UNDERGROUND CONDUCTOR NO. 2 THW (CKT 17,19 &amp; CKT 18,20)</li> </ul>
~	Junction Box #4		(-) - 1/2	453	(3) UNDERGROUND CONDUCTOR NO. 8 GROUND
12	Junction Box #4 to	149	1-1/2"	644 161	(4) UNDERGROUND CONDUCTOR NO. 6 THW (CKT 9,11 & CKT 10,12) UNDERGROUND CONDUCTOR NO. 8 GROUND
	Light L2	1-10	1 112		
13	Light L2 to	253	1-1/2"	1060 265	(4) UNDERGROUND CONDUCTOR NO. 6 THW (CKT 9,11 & CKT 10,12) UNDERGROUND CONDUCTOR NO. 8 GROUND
	Light L1	200			
14	Light L2 to	248	1-1/2"	1040 260	(4) UNDERGROUND CONDUCTOR NO. 6 THW (CKT 9,11 & CKT 10,12) UNDERGROUND CONDUCTOR NO. 8 GROUND
	Light L3			10000000	
15	Light L3 to	138	1-1/2"	600 150	(4) UNDERGROUND CONDUCTOR NO. 6 THW (CKT 9,11 & CKT 10,12) UNDERGROUND CONDUCTOR NO. 8 GROUND
	Light L24				
16	Light L24 to	141	1-1/2"	612 153	(2) UNDERGROUND CONDUCTOR NO. 6 THW (CKT 10,12) UNDERGROUND CONDUCTOR NO. 8 GROUND
	Light L25	-	0		
17	Junction Box #4 to	381	1-1/2"	1572 393	(4) UNDERGROUND CONDUCTOR NO. 6 THW (CKT 13,15 & CKT 14,16) UNDERGROUND CONDUCTOR NO. 8 GROUND
	Light L5	1000		1040	(4) UNDERGROUND CONDUCTOR NO. 6 THW (CKT 13, 15 & CKT 14, 16)
18	Light L5 to	248	1-1/2"	260	UNDERGROUND CONDUCTOR NO. 6 THW (CK 1 13, 15 & CK 1 14, 16) UNDERGROUND CONDUCTOR NO. 8 GROUND
	Light L4 Light L5			1040	(4) UNDERGROUND CONDUCTOR NO. 6 THW (CKT 13,15 & CKT 14,16)
19	to	248	1-1/2"	260	UNDERGROUND CONDUCTOR NO. 8 GROUND
	Light L6 Light L6			648	(2) UNDERGROUND CONDUCTOR NO. 6 THW (CKT 13,15)
20	to	150	1-1/2"	162	UNDERGROUND CONDUCTOR NO. 8 GROUND
	Light L26 Junction Box #4			1508	(4) UNDERGROUND CONDUCTOR NO. 2 THW (CKT 17,19 & CKT 18,20)
21	to	365	1-1/2"	377	UNDERGROUND CONDUCTOR NO. 8 GROUND
	Junction Box #3 Junction Box #3			824	(4) UNDERGROUND CONDUCTOR NO. 2 THW (CKT 17,19 & CKT 18,20)
22	to Junction Box #5	194	1-1/2"	206	UNDERGROUND CONDUCTOR NO. 8 GROUND
	Junction Box #5			840	(4) UNDERGROUND CONDUCTOR NO. 2 THW (CKT 17,19 & CKT 18,20)
23	to Light L10	198	1-1/2'	210	UNDERGROUND CONDUCTOR NO. 8 GROUND
~	Light L10	-		1060	(4) UNDERGROUND CONDUCTOR NO. 2 THW (CKT 17, 19 & CKT 18, 20)
24	to Light L11	253	1-1/2"	265	UNDERGROUND CONDUCTOR NO. 8 GROUND
25	Light L11			1064	(4) UNDERGROUND CONDUCTOR NO. 2 THW (CKT 17, 19 & CKT 18, 20)
25	to Light L12	254	1-1/2"	266	UNDERGROUND CONDUCTOR NO. 8 GROUND
26	Light L12	258	1-1/2"	1080 270	(4) UNDERGROUND CONDUCTOR NO. 2 THW (CKT 17,19 & CKT 18,20) UNDERGROUND CONDUCTOR NO. 8 GROUND
20	to Light L13	236	1-1/2		
71	Feed Point #1 to	30	1"	92 46	(2) UNDERGROUND CONDUCTOR NO. 10 THW (CKT 21,23) UNDERGROUND CONDUCTOR NO. 10 GROUND
even).	Light F1				
72	Light F1 to	9	1"	42 21	(2) UNDERGROUND CONDUCTOR NO. 10 THW (CKT 21,23) UNDERGROUND CONDUCTOR NO. 10 GROUND
	Light F2				
73	Light F2 to	9	1"	42 21	(2) UNDERGROUND CONDUCTOR NO. 10 THW (CKT 21,23) UNDERGROUND CONDUCTOR NO. 10 GROUND
	Light F3				nak watani mananakanakan kana mananakan kana kana
74	Light F3 to	9	1"	42 21	(2) UNDERGROUND CONDUCTOR NO. 10 THW (CKT 21,23) UNDERGROUND CONDUCTOR NO. 10 GROUND
	Light F4				(2) UNDERGROUND CONDUCTOR NO. 10 THW (CKT 21,23)
75	Light F4 to	9	1"	42 21	(2) UNDERGROUND CONDUCTOR NO. 10 THW (CK1 21,23) UNDERGROUND CONDUCTOR NO. 10 GROUND
	Light F5 Light F5			42	(2) UNDERGROUND CONDUCTOR NO. 10 THW (CKT 21,23)
76	to	9	1"	42 21	UNDERGROUND CONDUCTOR NO. 10 THW (CR1 21,23)
	Light F6			42	(2) UNDERGROUND CONDUCTOR NO. 10 THW (CKT 21,23)
77	Light F6 to	9	1"	42 21	UNDERGROUND CONDUCTOR NO. 10 THW (CKT 21,23)
	Light F7 Light F7			42	(2) UNDERGROUND CONDUCTOR NO. 10 THW (CKT 21,23)
78	to	9	1"	42	UNDERGROUND CONDUCTOR NO. 10 THW (CRT 21,23)
	Light F8 Feed Point #1		-	92	(2) UNDERGROUND CONDUCTOR NO. 10 THW (CKT 25)
79	to	30	1"	92 46	UNDERGROUND CONDUCTOR NO. 10 THW (CR125)
13 1	Entrance Sign			60	(2) UNDERGROUND CONDUCTOR NO. 10 THW (CKT 21,23)
15	Light F4		1		
103	Light F4 to	14	1"	30	UNDERGROUND CONDUCTOR NO. 10 GROUND
		14	1"	30 60	UNDERGROUND CONDUCTOR NO. 10 GROUND (2) UNDERGROUND CONDUCTOR NO. 10 THW (CKT 21,23)

E	ELECTRICAL J	UNCTION	N BOX	
		DIME	NSIONS	
TYPE	DESCRIPTION	Α	В	С
1 a	OPEN BOTTOM	11"-15"	18"-21"	24" MIN.
	WITH GASKET			
2	OPEN BOTTOM	13"-18"	24"-28"	24" MIN.
	WITH GASKET			
3	OPEN BOTTOM	17"-22"	24"-30"	24" MIN.
	WITH GASKET			
4	OPEN BOTTOM	28"-33"	36"-48"	24" MIN.
	WITH GASKET			

# GENERAL NOTES:

1. THE COVER SHALL BE GASKETED WITH A MINIMUM OF TWO STAINLESS STEEL BOLTS AND WASHERS.


2, THE COVER SHALL HAVE A LIFTING EYE.


3. THE SURFACE OF THE COVER SHALL HAVE A MINIMUM WET AND DRY COEFFICIENT OF FRICTION VALUE OF 0.5 AS DETERMINED BY ASTM F 609.

4. THE COVER OF THE JUNCTION BOX SHALL HAVE THE APPROPRIATE LOGO IN ONE INCH SIZE LETTERS AND SHALL BE RECESSED, WHEN THE JUNCTION BOX CONTAINS CABLES OR WIRES FOR COMMUNICATION CIRCUIT THEN THE LOGO SHALL BE "COMMUNICATION". WHEN THE JUNCTION BOX CONTAINS LIGHTING CONDUCTORS THEN THE LOGO SHALL BE "LIGHTING".


5. THE ELECTRICAL JUNCTION BOXES SHALL COMPLY WITH THE AMERICAN NATIONAL STANDARDS INSTITUTE (ANSI)/SOCIETY OF CABLE UNDERGROUND ENCLOSURE INTEGRITY. THE LOADING REQUIREMENT FOR ALL THE ELECTRICAL JUNCTION BOXES SHALL BE TIER 8 OF ANSI/SCTE 22 2007.


6. THE ELECTRICAL JUNCTION BOXES SHALL BE UL LISTED.

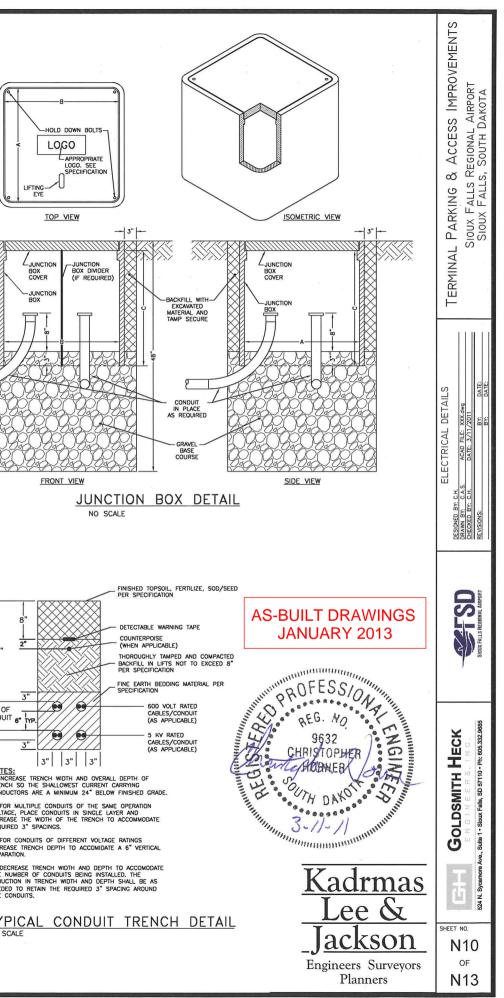

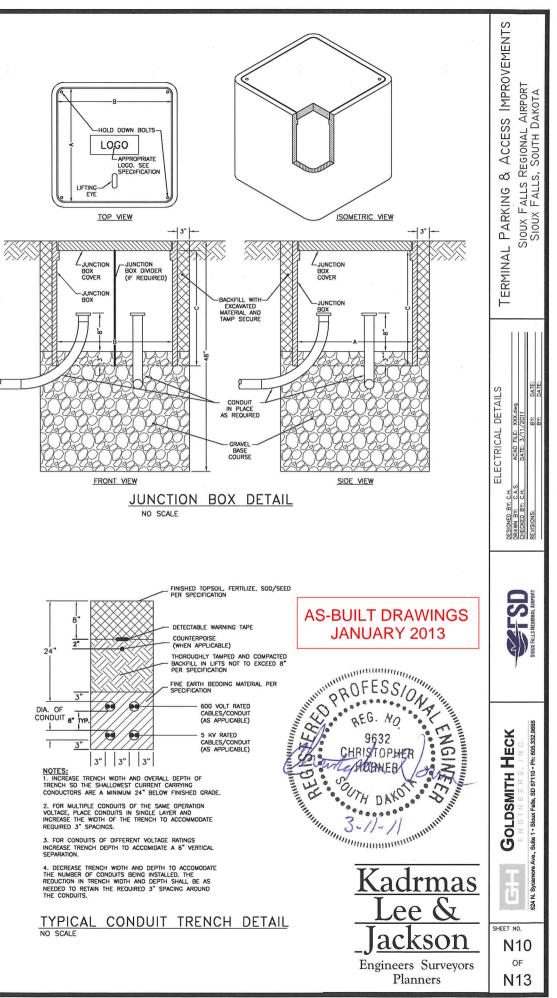

JUNCTI	ON BOX
NUMBER	TYPE
# 1	4
#2	2
#3	2
#4	4
#5	1
#6	4
#7	2
#8	1
#9	1
#1O	1
<i>#</i> 11	1
#12	1
#13	3
#14	3
#15	3

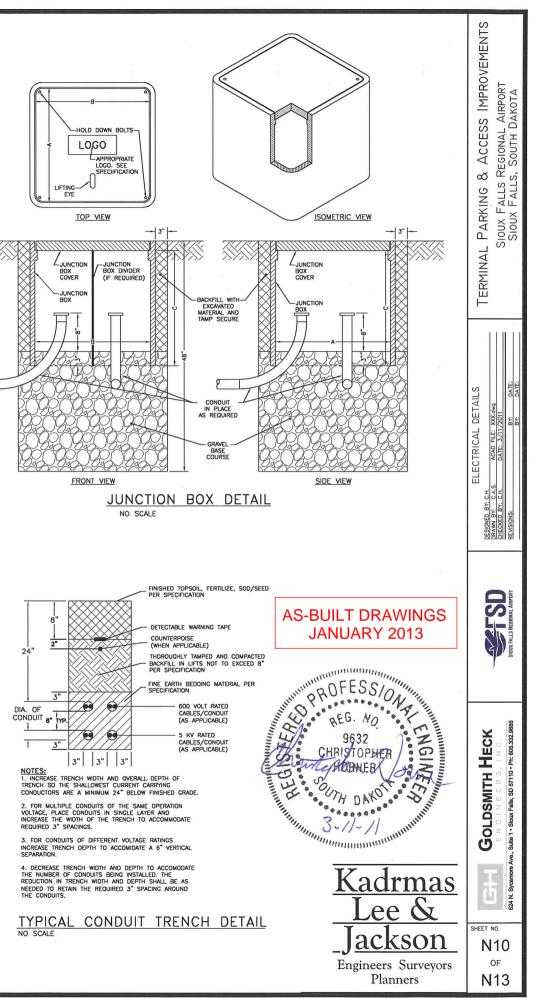

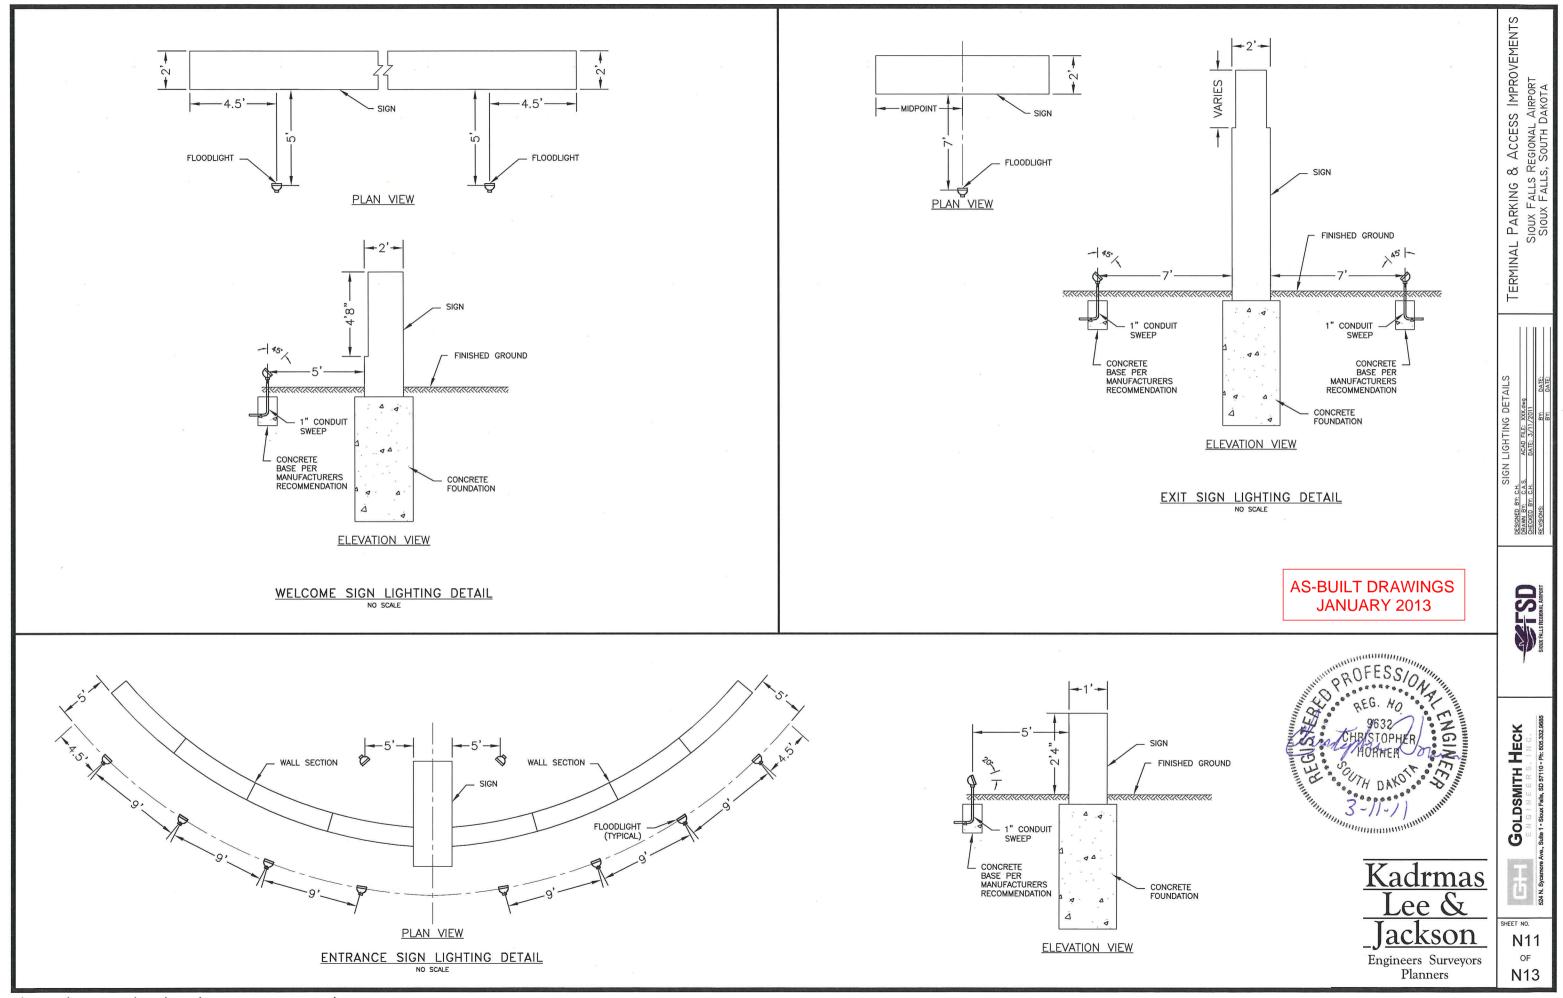


J:\airport\50509106\CAD\work\Terminal Parkina Lot\210710 Elec Detail.dwa

	2	2			LIGHTING SCHEDULE	8		6	. 8
DEGLONIATION		LIGHT FIXTURE			LIGHT STANDARD			DECORDETION	7511.7%
DESIGNATION	MANUFACTURER	MODEL	LAMPS PER FIXTURE & TYPE	MANUFACTURER	MODEL	POLE HEIGHT	FOUNDATION TYPE	DESCRIPTION	REMARKS
A	EXISTING LIGHT FIXTURE	N/A	4-1000W MH	EXISTING LIGHT STANDARD	NA	35'	TYPE AA	NA	RELOCATED 4 LIGHT FIXTURES ON A 35' LIGHT STANDARD
В	EXISTING LIGHT FIXTURE	N/A	1-1000W MH	EXISTING LIGHT STANDARD	NA	35'	TYPE BB	NA	RELOCATE SINGLE LIGHT FIXTURES ON A 35' LIGHT STANDARD
с	SPAULDING OR APPROVED EQUIVALENT	CE2-H1K-H4-F-5-DB-F5/ARM-S-10-T45-DB	4-1000W MH	VALMONT OR APPROVE EQUIVALENT	DS210-850A350-DRILLED-AB-HH-FBC- FP/F264AL/OVER GALVANIZED STEEL POLE W/ ALUMINUM FINISH	35'	TYPE BB	METAL HALIDE, 480V, POLE MOUNTED SHOE BOX STYLE SINGLE ARM MOUNT, TYPE 4 DISTRIBUTION FLAT LENS, ALUMINUM HOUSING, DARK BRONZE COLOR	NEW 4 LIGHT FIXTURE ON A 35' LIGHT STANDARD. FINISH SHALL MATCH EXISTING
D	SPAULDING OR APPROVED EQUIVALENT	CE2-P45-H3-F-5-DB-F5/ARM-S-10T45-DB	1-400W MH	VALMONT OR APPROVE EQUIVALENT	DS210-850A350-DRILLED-AB-HH-FBC- FP/F264AL/OVER GALVANIZED STEEL POLE W/ ALUMINUM FINISH	N/A	ТҮРЕ ВВ	METAL HALIDE, 480V, POLE MOUNTED SHOE BOX STYLE QUAD MOUNT, TYPE 4 DISTRIBUTION FLAT LENS, ALUMINUM HOUSING, DARK BRONZE COLOR	NEW SINGLE LIGHT FIXTURE ON 35' LIGHT STANDARD. FINISH SHALL MATCH EXISITING
E	VISIONAIRE LIGHTING OR APPROVED EQUIVALENT	OWK-2-8R36-COG-60L-LED-4K-UNV-AB-BZ-SF277	60W LED UNIT	N/A	NA	N/A	N∕A	BOLLARD FINISH SHALL MATCH EXISTING DARK BRONZE COLOR. PROVIDE COLOR CHIP FOR REVIEW AND ACCEPTANCE	NEW BÓLLARD LIGHT UNIT
F	EXISTING LIGHT FIXTURE	N/A	1-250W HPS	EXISTING LIGHT STANDARD	NA	30'	TYPE BB	NA	RELOCATE SINGLE LIGHT FIXTURES ON A 30' LIGHT STANDARD
G	COOPER LIGHTING OR APPROVE EQUIVALENT	OVZ25SW823	1-250W HPS	MILLERBERND OR APPROVED EQUIVALENT	VA8-309S-GV	30'	TYPE BB	HIGH PRESSURE SODIUM, 480V, COBRA HEAD STANDARD GRAY POLVESTER POWDER COAT FINISH WITH MSIL DISTRIBUTION WITH A 30' STEEL GALVANIZED POLE WITH 8' MAST ARM	NEW STREET LIGHT COBRA HEAD FIXTURE ON 30' LIGHT STANDARD . STYLE AND FINISH SHALL MATCH EXISTING
H	GARDCO LIGHTING OR APPROVED EQUIVALENT	DF7-ST-HFL-175MH-277-BRP-F	1-175W MH	N/A	N/A	N/A	N/A	175W MH FLOOD LIGHT TILTED AT 45 DEGREES. FINISH TO BE DARK BRONZE MATCHING EXISTING FIXTURE FINISH.	NEW FLOOD LIGHT FIXTURE FOR MONUMENT SIGNS
l	GARDCO LIGHTING OR APPROVED EQUIVALENT	DF7-ST-HFL-100MH-480-BRP-F	1-100W MH	N/A	NA	N/A	N/A	100W MH FLOOD LIGHT TILTED AT 20 DEGREES. FINISH TO BE DARK BRONZE MATCHING EXISTING FIXTURE FINISH.	NEW FLOOD LIGHT FIXTURE FOR MONUMENT SIGNS
J	GARDCO LIGHTING OR APPROVED EQUIVALENT	DF12-ST-VFL-250MH-277-BRP-F	1-250W MH	N/A	N/A	N/A	N/A	250W MH FLOOD LIGHT STATION MOUNTED TILTED AT 60 DEGREES. FINISH TO BE DARK BRONZE MATCHING EXISTING FIXTURE FINISH	NEW FLOOD LIGHT FIXTURE FOR MONUMENT SIGNS
к	GARDCO LIGHTING OR APPROVED EQUIVALENT	DF12-ST-HSL-100MH-277-BRP-F	1-100W MH	N/A	N/A	N/A	N/A	100W MH FLOOD LIGHT STATION MOUNTED TILTED AT 60 DEGREES. FINISH TO BE DARK BRONZE MATCHING EXISTING FIXTURE FINISH	NEW FLOOD LIGHT FIXTURE FOR MONUMENT SIGNS

KT DESCRIPTION	BRK	V-A	AMPS	WIRE AND CONDUIT	Φ	WIRE AND CONDUIT	AMPS	V-A	BRK	DESCRIPTION	CK
Existing Roadway Lighting	30	2880	10.000	2-#6 AWG Cu THHN/THWN & #8 AWG THHN/THWN GROUND IN 1-1/2" PVC		2-#10 AWG Cu THHN/THWN & #10 AWG THHN/THWN GROUND IN 1-1/2" PVC	5.4 5.4	2,592	30	Existing Roadway Lighting	2
5 Existing Roadway Lighting	30	1152		2-#6 AWG Cu THHN/THWN & #8 AWG THHN/THWN GROUND IN 1-1/2" PVC		2-#10 AWG Cu THHN/THWN & #10 AWG THHN/THWN GROUND IN 1-1/2" PVC	3.0 3.0		30	Existing Roadway Lighting	6
9 North Long Term Parking Lot	30	7680		2-#6 AWG Cu THHN/THWN & #8 AWG THHN/THWN GROUND IN 1-1/2" PVC		2-#6 AWG Cu THHN/THWN & #8 AWG THHN/THWN GROUND IN 1-1/2" PVC	16.0 16.0		30	North Long Term Parking Lot	1
3 5 North Long Term Parking Lot	30	7680		2-#6 AWG Cu THHN/THWN & #8 AWG THHN/THWN GROUND IN 1-1/2" PVC		2-#6 AWG Cu THHN/THWN & #8 AWG THHN/THWN GROUND IN 1-1/2" PVC	15.0 15.0		30	North Long Term Parking Lot	1
7 9 South Long Term Parking Lot	30	9600		2-#6 AWG Cu THHN/THWN & #8 AWG THHN/THWN GROUND IN 1-1/2" PVC		2-#6 AWG Cu THHN/THWN & #8 AWG THHN/THWN GROUND IN 1-1/2" PVC	20.0		30	South Long Term Parking Lot	1
Entrance Sign Flood Lighting	20	1296		2-#10 AWG Cu THHN/THWN & #10 AWG THHN/THWN GROUND IN 1" PVC	AB			0			2
25 Entrance Dactronix Sign	30	3600	15.0	3-#10 AWG Cu THHN/THWN in 1" PVC	A			0			2
27					В			0			2
29		0			A			0			3

J:\airport\50509106\CAD\work\Terminal\_Parking\_Lot\210710\_Elec\_Detail.dwg



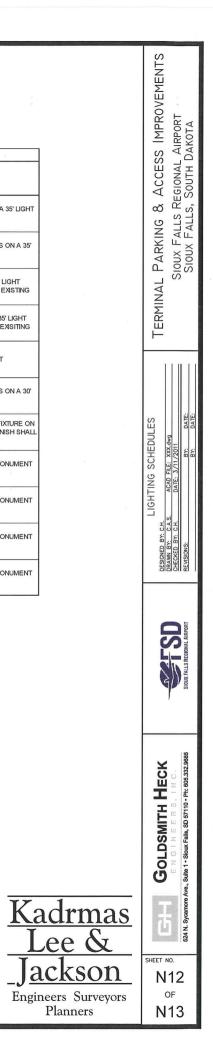



RUN	ITEM	CONDUIT		CABLE	NDUIT SCHEDULE - PANEL LP
	Existing Panel LP	TOTAL LF	SIZE (IN)	TOTAL LF 1120	SIZE/TYPE (7) UNDERGROUND CONDUCTOR NO. 6 THW (CKT 2,3,5,7,9,11 Panel LP)
27	to Junction Box #6	804	(6) 1"	800 960 160	(5) UNDERGROUND CONDUCTOR NO. 8 THW (CRT 2,5,7,9,1) Haire LT ) (6) UNDERGROUND CONDUCTOR NO. 8 THW (CRT 1,4,6 Panel LP) (0) UNDERGROUND CONDUCTOR NO. 8 GROUND UNDERGROUND CONDUCTOR NO. 10 (PULL WIRE)
28	Junction Box #6 to	28	1"	80 40	(2) UNDERGROUND CONDUCTOR NO. 8 THW (CKT 1 Panel LP) UNDERGROUND CONDUCTOR NO. 8 GROUND
29	Light B44 Light B44 to	21	1"	66 33	(2) UNDERGROUND CONDUCTOR NO. 8 THW (CKT 1 Panel LP) UNDERGROUND CONDUCTOR NO. 8 GROUND
30	Light B43 Light B43 to	170	1"	364 182	(2) UNDERGROUND CONDUCTOR NO. 8 THW (CKT 1 Panel LP) UNDERGROUND CONDUCTOR NO. 8 GROUND
31	Light B42 Light B42 to	21	1"	66 33	(2) UNDERGROUND CONDUCTOR NO. 8 THW (CKT 1 Panel LP) UNDERGROUND CONDUCTOR NO. 8 GROUND
32	Light B41 Light B41 to	92	1"	208 104	(2) UNDERGROUND CONDUCTOR NO. 8 THW (CKT 1 Panel LP) UNDERGROUND CONDUCTOR NO. 8 GROUND
33	Light B40 Light B40 to	21	1"	66 33	(2) UNDERGROUND CONDUCTOR NO. 8 THW (CKT 1 Panel LP) UNDERGROUND CONDUCTOR NO. 8 GROUND
34	Light B39 Light B39 to	101	1"	226 113	(2) UNDERGROUND CONDUCTOR NO. 8 THW (CKT 1 Panel LP) UNDERGROUND CONDUCTOR NO. 8 GROUND
35	Light B38 Light B38 to	21	1"	66 33	(2) UNDERGROUND CONDUCTOR NO. 8 THW (CKT 1 Panel LP) UNDERGROUND CONDUCTOR NO. 8 GROUND
36	Light B37 Junction Box #6 to	62	1"	148 74	(2) UNDERGROUND CONDUCTOR NO. 6 THW (CKT 3,5 Panel LP) UNDERGROUND CONDUCTOR NO. 8 GROUND
37	Light L15 Light L15 to	223	1"	470 235	(2) UNDERGROUND CONDUCTOR NO. 6 THW (CKT 3,5 Panel LP) UNDERGROUND CONDUCTOR NO. 8 GROUND
38	Light L14 Light L15 to	198	ं भ	420 210	(2) UNDERGROUND CONDUCTOR NO. 6 THW (CKT 3,5 Panel LP) UNDERGROUND CONDUCTOR NO. 8 GROUND
39	Light L16 Light L16 Light L16 to	182	· 	388 194	(2) UNDERGROUND CONDUCTOR NO. 6 THW (CKT 3,5 Panel LP) UNDERGROUND CONDUCTOR NO. 8 GROUND
40	Light L17 Light L17		1"	462 231	(2) UNDERGROUND CONDUCTOR NO. 6 THW (CKT 3,5 Panel LP) UNDERGROUND CONDUCTOR NO. 8 GROUND
40	to Light L18 Junction Box #6	350		374 187	(2) UNDERGROUND CONDUCTOR NO. 6 THW (CKT 2 Panel LP) (2) UNDERGROUND CONDUCTOR NO. 6 THW (CKT 2 Panel LP) (2) UNDERGROUND CONDUCTOR NO. 8 THW (CKT 4 Panel LP)
	to Junction Box #7 Junction Box #7		(2) 1"	187 94	(2) UNDERGROUND CONDUCTOR NO. 8 GROUND (2) UNDERGROUND CONDUCTOR NO. 6 THW (CKT 2 Panel LP)
42	to Light B51 Light B51	35	1"	47 56	UNDERGROUND CONDUCTOR NO. 8 GROUND (2) UNDERGROUND CONDUCTOR NO. 6 THW (CKT 2 Panel LP)
43	to Light B52 Light B52	16	1"	28 110	UNDERGROUND CONDUCTOR NO. 8 GROUND (2) UNDERGROUND CONDUCTOR NO. 6 THW (CKT 2 Panel LP)
44	to Light B53 Light B53	43	1"	55	UNDERGROUND CONDUCTOR NO. 8 GROUND (2) UNDERGROUND CONDUCTOR NO. 6 THW (CKT 2 Panel LP)
45	to Light B54 Junction Box #7	15	1"	27	UNDERGROUND CONDUCTOR NO. 8 GROUND (2) UNDERGROUND CONDUCTOR NO. 6 THW (CKT 2 Panel LP)
46	to Light B50 Light B50	55	1"	67 58	UNDERGROUND CONDUCTOR NO. 8 GROUND (2) UNDERGROUND CONDUCTOR NO. 6 THW (CKT 2 Panel LP)
47	to Light B49 Light B49	17	1"	29 130	UNDERGROUND CONDUCTOR NO. 8 GROUND (2) UNDERGROUND CONDUCTOR NO. 6 THW (CKT 2 Panel LP)
48	to Light B48 Light B48	53	1"	65 56	UNDERGROUND CONDUCTOR NO. 8 GROUND (2) UNDERGROUND CONDUCTOR NO. 6 THW (CKT 2 Panel LP)
49	to Light B47 Light B47	16	1"	28	(2) UNDERGROUND CONDUCTOR NO. 8 GROUND (2) UNDERGROUND CONDUCTOR NO. 6 THW (CKT 2 Panel LP)
50	to Light B46	51	1"	63 60	UNDERGROUND CONDUCTOR NO. 8 GROUND
51	Light B46 to Light B45	18	1"	30	(2) UNDERGROUND CONDUCTOR NO. 6 THW (CKT 2 Panel LP) . UNDERGROUND CONDUCTOR NO. 8 GROUND
52	Light B45 to Light B36	118	1"	260 130	(2) UNDERGROUND CONDUCTOR NO. 6 THW (CKT 2 Panel LP) UNDERGROUND CONDUCTOR NO. 8 GROUND
53	Light B36 to Light B35	16	1"	56 28	(2) UNDERGROUND CONDUCTOR NO. 6 THW (CKT 2 Panel LP) UNDERGROUND CONDUCTOR NO. 8 GROUND
54	Light B35 to Light B34	51	1"	126 63	(2) UNDERGROUND CONDUCTOR NO. 6 THW (CKT 2 Panel LP) UNDERGROUND CONDUCTOR NO. 8 GROUND
55	Light B34 to Light B33	15	1"	54 27	(2) UNDERGROUND CONDUCTOR NO. 6 THW (CKT 2 Panel LP) UNDERGROUND CONDUCTOR NO. 8 GROUND
56	Light B33 to Light B32	54	1"	132 66	(2) UNDERGROUND CONDUCTOR NO. 6 THW (CKT 2 Panel LP) UNDERGROUND CONDUCTOR NO. 8 GROUND
57	Light B32 to Light B31	15	1"	54 27	(2) UNDERGROUND CONDUCTOR NO. 6 THW (CKT 2 Panel LP) UNDERGROUND CONDUCTOR NO. 8 GROUND
58	Light B31 to Light B30	57	1"	138 69	(2) UNDERGROUND CONDUCTOR NO. 6 THW (CKT 2 Panel LP) UNDERGROUND CONDUCTOR NO. 8 GROUND
59	Light B30 to Light B29	16	1"	56 28	(2) UNDERGROUND CONDUCTOR NO. 6 THW (CKT 2 Panel LP) UNDERGROUND CONDUCTOR NO. 8 GROUND
60	Light B29 to Light B28	43	1"	110 55	(2) UNDERGROUND CONDUCTOR NO. 6 THW (CKT 2 Panel LP) UNDERGROUND CONDUCTOR NO. 8 GROUND


61	Light B28 to	17	1"	58 29	(2) UNDERGROUND CONDUCTOR NO. 6 THW (CKT 2 Panel UNDERGROUND CONDUCTOR NO. 8 GROUND
62	Light B27 Junction Box #6 to	102	1"	342 114	(3) UNDERGROUND CONDUCTOR NO. 6 THW (CKT 7,9,11 F UNDERGROUND CONDUCTOR NO. 8 GROUND
63	Light L9 Light L9 to	257	1"	807 269	(3) UNDERGROUND CONDUCTOR NO. 6 THW (CKT 7,9,11 F UNDERGROUND CONDUCTOR NO. 8 GROUND
64	Light L8 Light L8 to	256	1"	804 268	(3) UNDERGROUND CONDUCTOR NO. 6 THW (CKT 7,9,11 F UNDERGROUND CONDUCTOR NO. 8 GROUND
65	Light L7 Light B35 to	110	1"	244 122	(2) UNDERGROUND CONDUCTOR NO. 8 THW (CKT 1 Panel UNDERGROUND CONDUCTOR NO. 8 GROUND
66	Light B58 Light B58 to	51		126 63	(2) UNDERGROUND CONDUCTOR NO. 8 THW (CKT 1 Panel UNDERGROUND CONDUCTOR NO. 8 GROUND
67	Light B59 Light B59	42	1"	108 54	(2) UNDERGROUND CONDUCTOR NO. 8 THW (CKT 1 Panel UNDERGROUND CONDUCTOR NO. 8 GROUND
	to Light B60 Junction Box #6			396	(2) UNDERGROUND CONDUCTOR NO. 8 THW (CKT 1 Panel
68	to Light B55 Light B55	186	1"	198 98	UNDERGROUND CONDUCTOR NO. 8 GROUND (2) UNDERGROUND CONDUCTOR NO. 8 THW (CKT 1 Panel
69	to Light B56 Light B56	37	1"	49	UNDERGROUND CONDUCTOR NO. 8 GROUND (2) UNDERGROUND CONDUCTOR NO. 8 THW (CKT 1 Panel
70	to Light B57 Junction Box #7	62	1"	74	UNDERGROUND CONDUCTOR NO. 8 GROUND (2) UNDERGROUND CONDUCTOR NO. 8 THW (CKT 4 Pane
80	to Exit Sign #4	63	1"	75	UNDERGROUND CONDUCTOR NO. 8 GROUND
81	Exit Sign #4 to Exit Sign #3	150	1"	324 162	(2) UNDERGROUND CONDUCTOR NO. 8 THW (CKT 4 Pane UNDERGROUND CONDUCTOR NO. 8 GROUND
82	Exit Sign #3 to Exit Sign #2	185	1"	394 197	(2) UNDERGROUND CONDUCTOR NO. 8 THW (CKT 4 Pane UNDERGROUND CONDUCTOR NO. 8 GROUND
83	Exit Sign #2 to Exit Sign #1	134	1"	292 146	(2) UNDERGROUND CONDUCTOR NO. 8 THW (CKT 4 Pane UNDERGROUND CONDUCTOR NO. 8 GROUND
84	Junction Box #7 to Exit Sign #5	71	1"	166 83	(2) UNDERGROUND CONDUCTOR NO. 8 THW (CKT 4 Pane UNDERGROUND CONDUCTOR NO. 8 GROUND
85	Exit Sign #5 to Exit Sign #6	235	- 1"	494 247	(2) UNDERGROUND CONDUCTOR NO. 8 THW (CKT 4 Pane UNDERGROUND CONDUCTOR NO. 8 GROUND
86	Junction Box #6 to Junction Box #8	525	1"	1074 537	(2) UNDERGROUND CONDUCTOR NO. 8 THW (CKT 6 Pane UNDERGROUND CONDUCTOR NO. 8 GROUND
87	Junction Box #8 to Junction Box #9	40	1"	104 52	(2) UNDERGROUND CONDUCTOR NO. 8 THW (CKT 6 Pane UNDERGROUND CONDUCTOR NO. 8 GROUND
88	Junction Box #9 to Light F11	525	1"	1074 537	(2) UNDERGROUND CONDUCTOR NO. 8 THW (CKT 6 Pane UNDERGROUND CONDUCTOR NO. 8 GROUND
89	Light F11 to	11	1"	46 23	(2) UNDERGROUND CONDUCTOR NO. 8 THW (CKT 4 Pane UNDERGROUND CONDUCTOR NO. 8 GROUND
90	Light F12 Exit Sign #3 to	8	1"	40 20	(2) UNDERGROUND CONDUCTOR NO. 8 THW (CKT 4 Pane UNDERGROUND CONDUCTOR NO. 8 GROUND
91	Light F9 Exit Sign #3 to	8	1"	40 20	(2) UNDERGROUND CONDUCTOR NO. 8 THW (CKT 4 Pane UNDERGROUND CONDUCTOR NO. 8 GROUND
92	Light F10 Exit Plaza to	202	1"	214	UNDERGROUND CONDUCTOR NO. 10 (PULL WIRE)
93	Light L6 Exit Plaza to	813	1"	825	UNDERGROUND CONDUCTOR NO. 10 (PULL WIRE)
94	Light L12 Light L6 to	306	1"	318	UNDERGROUND CONDÜCTOR NO. 10 (PULL WIRE)
	Junction Box #10 Light L12			192	UNDERGROUND CONDUCTOR NO. 10 (PULL WIRE)
95	to Junction Box #11 Junction Box #10	180	1"	410	UNDERGROUND CONDUCTOR NO. 10 (PULL WIRE)
96	to Junction Box #12 Junction Box #11	398	1"	260	UNDERGROUND CONDUCTOR NO. 10 (PULL WIRE)
97	to Junction Box #12 Exit Plaza	248	1"	648	(2) UNDERGROUND CONDUCTOR NO. 2 THW (CKT FROM
98	to Junction #13 Junction Box #13	616	(2) 2"	324 324 1156	UNDERGROUND CONDUCTOR NO. 8 GROUND UNDERGROUND CONDUCTOR NO. 10 (PULL WIRE) (2) UNDERGROUND CONDUCTOR NO. 10 (PULL WIRE)
99	to Junction Box #14	1124	(2) 2"	200300	2-#9841 BELDEN, 2-#9842 BELDEN, 4-#8771 BELDEN
100	Junction Box #14 to Junction Box #15	810	(2) 2"	834	(2) UNDERGROUND CONDUCTOR NO, 10 (PULL WIRE) 1-#9841 BELDEN, 2-#9842 BELDEN, 4-#8771 BELDEN, 1-#9455 BELDEN
101	Junction Box #15 to Short Term Parking Gate	146	(2) 2"	175	(2) UNDERGROUND CONDUCTOR NO. 10 (PULL WIRE)
102	Junction Box #16 to	350	(2) 2"	374	(2) UNDERGROUND CONDUCTOR NO. 10 (PULL WIRE)


# NOTE:


1. RUN 87 SHALL BE BORED UNDER EXISTING ROADWAY.

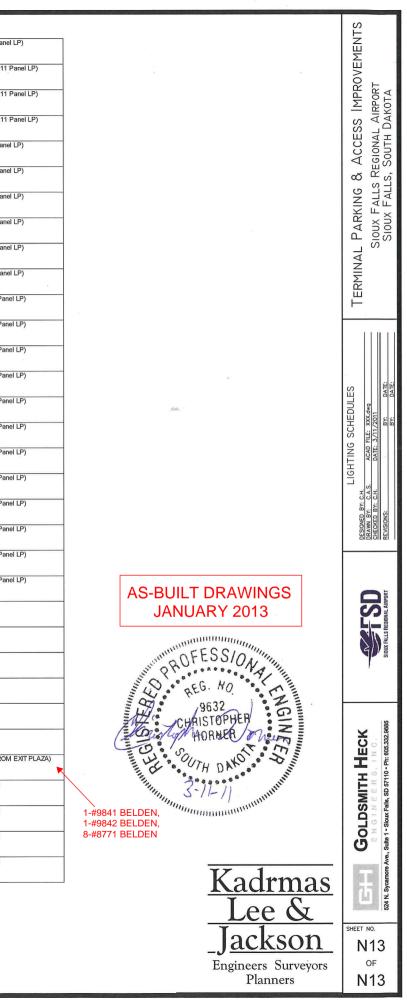

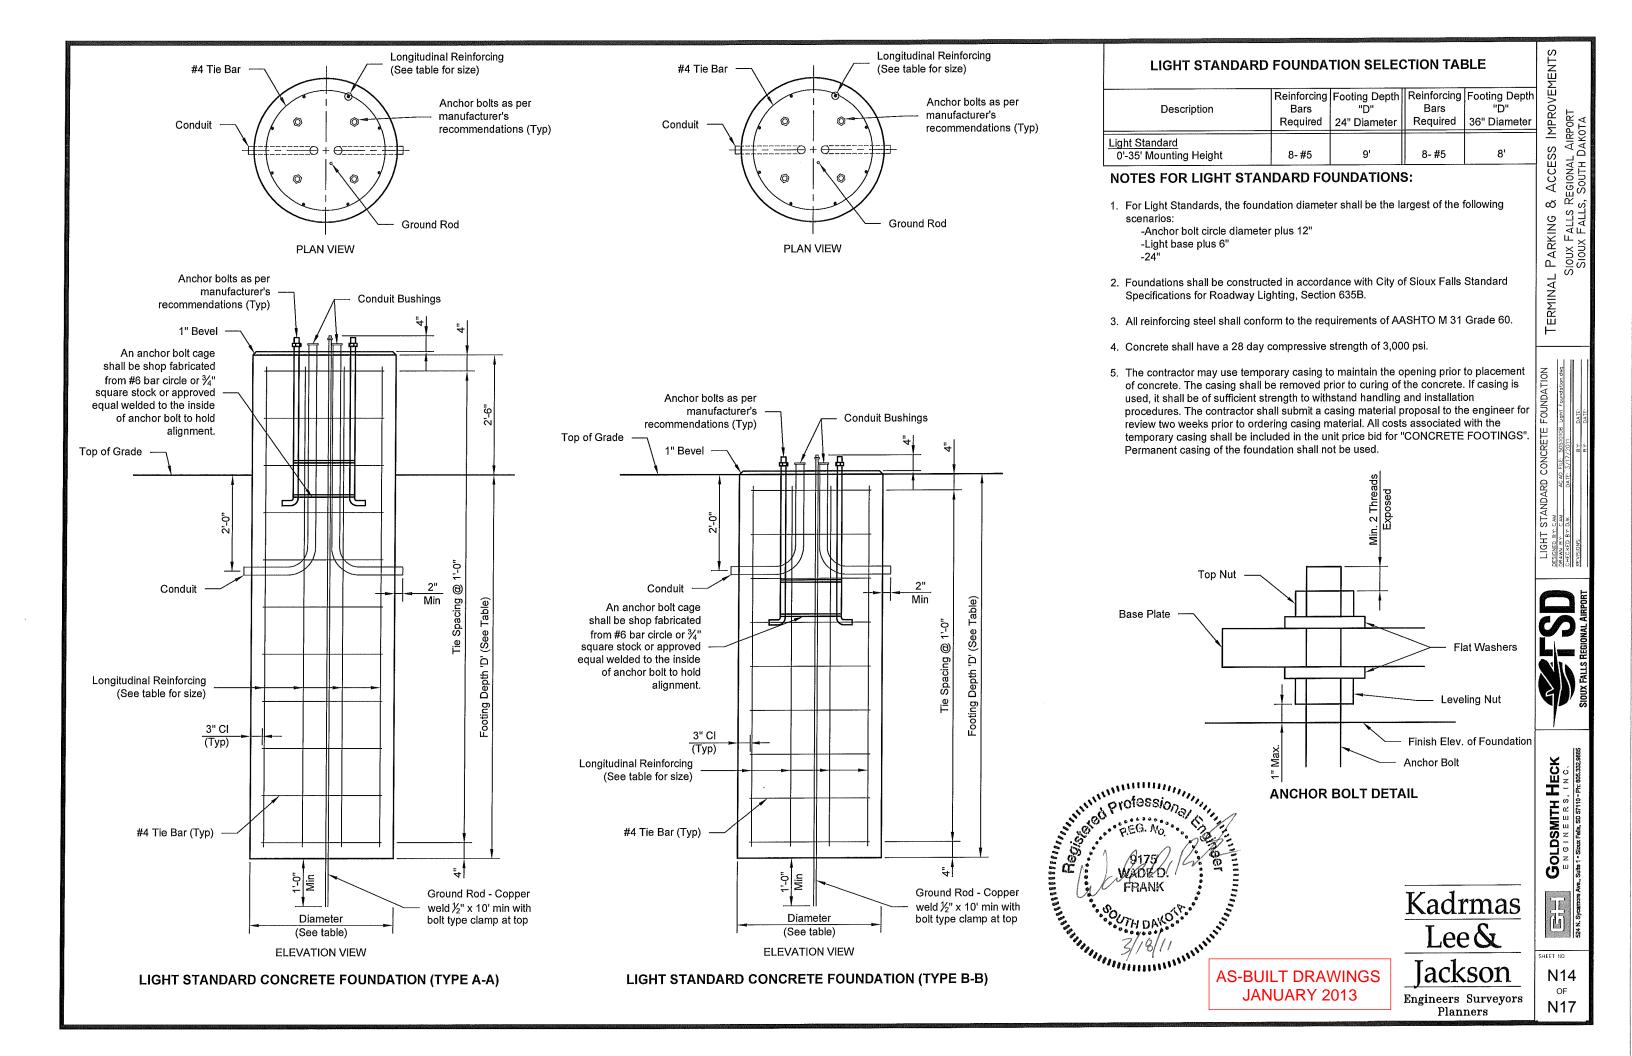

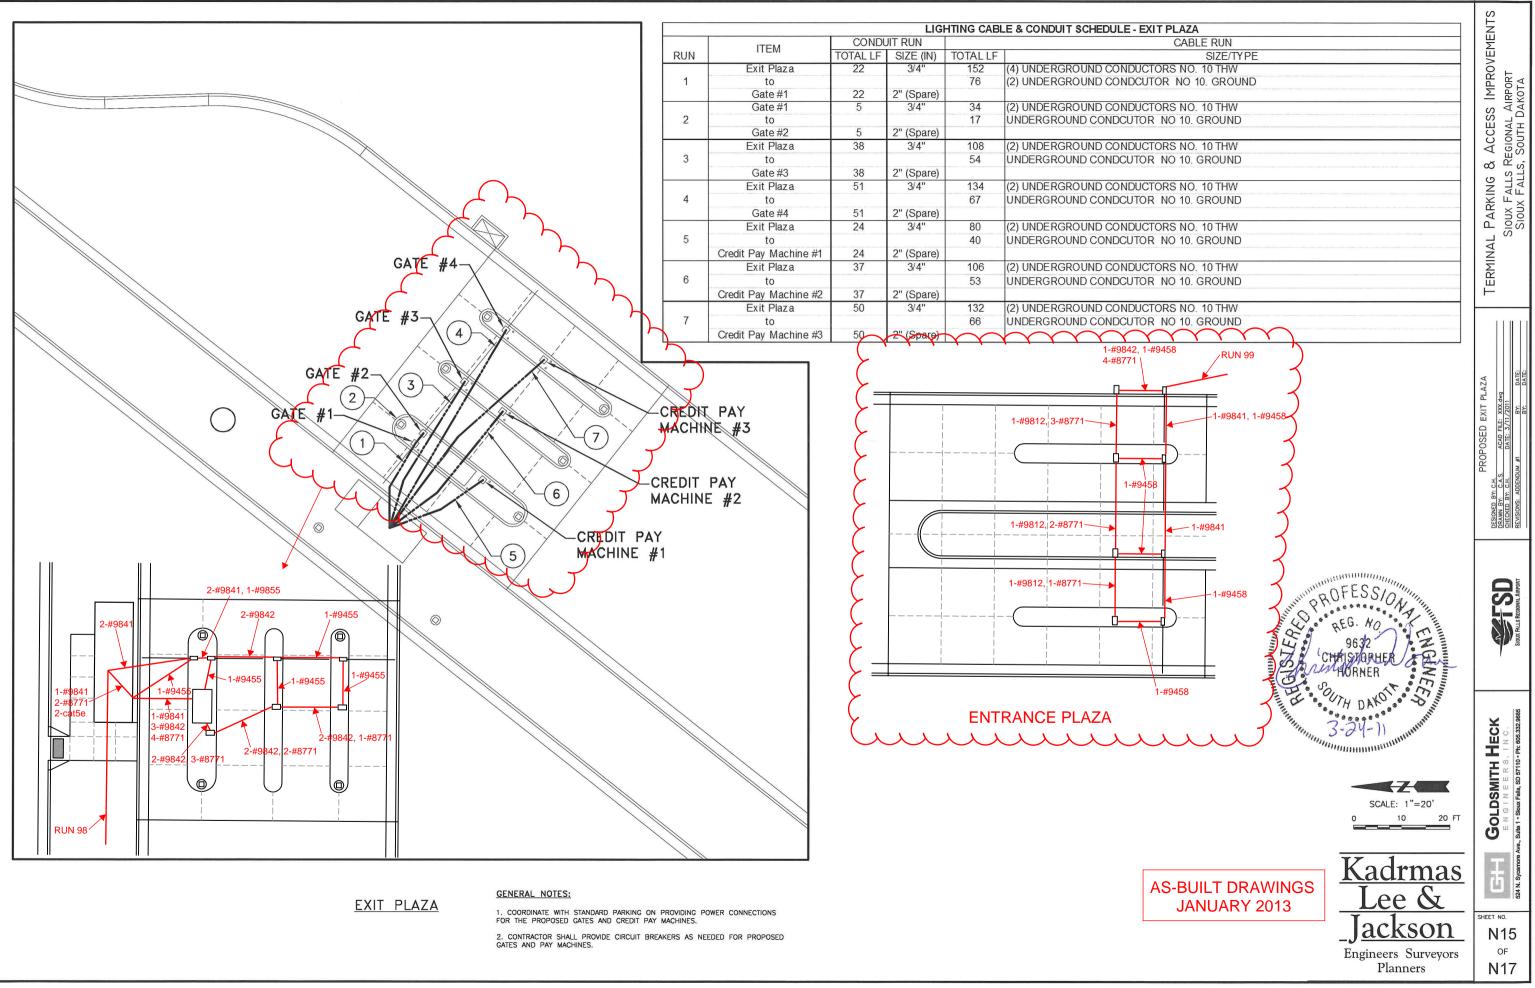


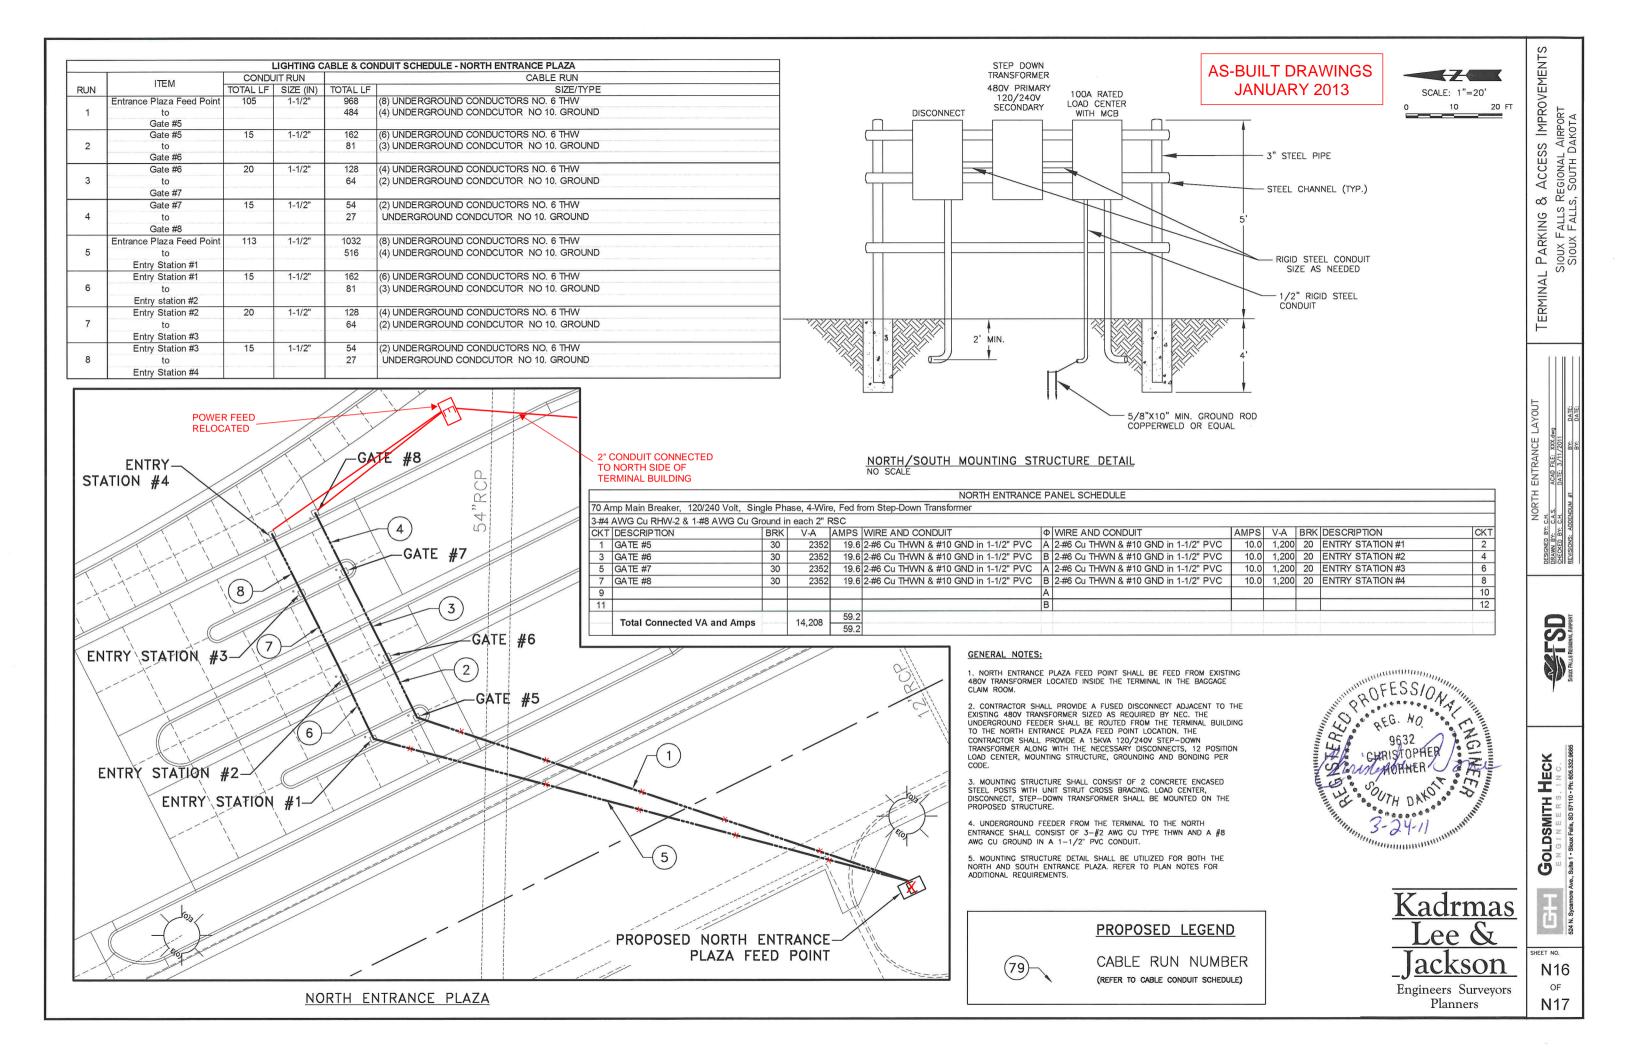


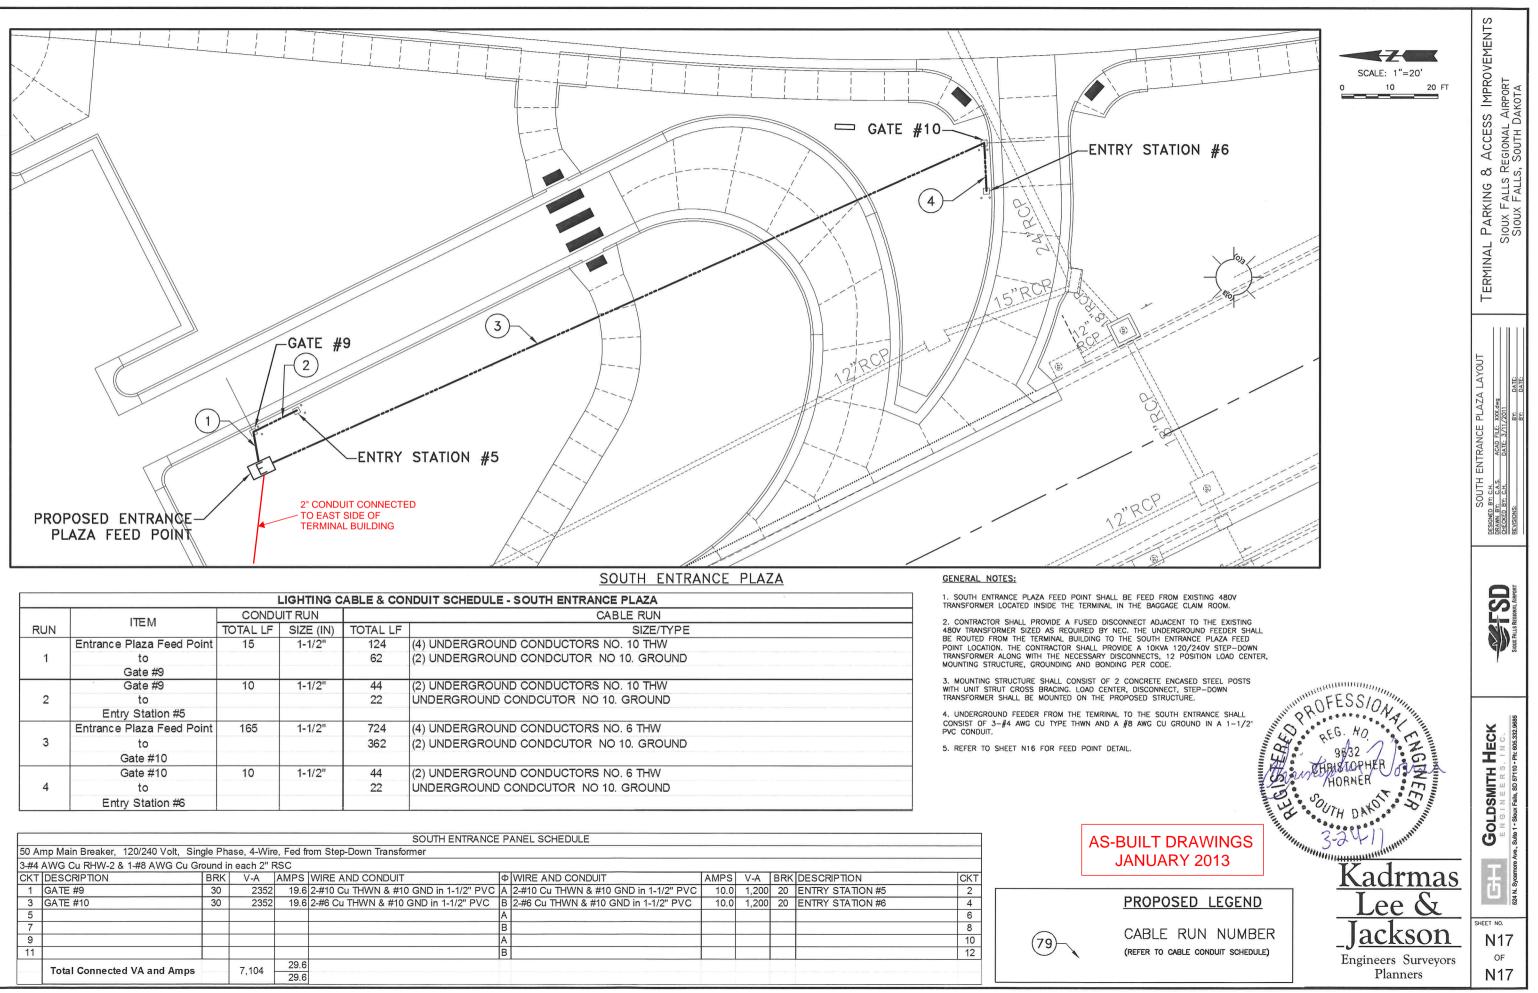



			LIGHTING C	ABLE & CO	NDUIT SCHEDULE - SOUTH ENTRANCE PLAZA	1. TI
	ITEM	CONDU	JIT RUN			
RUN		TOTAL LF	SIZE (IN)	TOTAL LF	SIZE/TYPE	4
	Entrance Plaza Feed Point	15	1-1/2"	124	(4) UNDERGROUND CONDUCTORS NO. 10 THW	B
1	to		- 10 - 11 - 10 - 11	62	(2) UNDERGROUND CONDCUTOR NO 10. GROUND	TI
	Gate #9					
	Gate #9	10	1-1/2"	44	(2) UNDERGROUND CONDUCTORS NO. 10 THW	3. W
2	to			22	UNDERGROUND CONDCUTOR NO 10. GROUND	TI
	Entry Station #5					4.
	Entrance Plaza Feed Point	165	1-1/2"	724	(4) UNDERGROUND CONDUCTORS NO. 6 THW	C P'
3	to			362	(2) UNDERGROUND CONDCUTOR NO 10. GROUND	5
	Gate #10					
4	Gate #10	10	1-1/2"	44	(2) UNDERGROUND CONDUCTORS NO. 6 THW	
	to			22	UNDERGROUND CONDCUTOR NO 10. GROUND	
	Entry Station #6					


	SOUTH ENTRANCE PANEL SCHEDULE										AS		
50 A	mp Main Breaker, 120/240 Volt, Sing	gle Pha	ase, 4-Wire	e, Fed fi	from Step-Down Transformer	2							
3-#4	AWG Cu RHW-2 & 1-#8 AWG Cu Gr	ound ir	n each 2" F	SC									
CKT	DESCRIPTION	BRK	V-A	AMPS	WIRE AND CONDUIT		Φ WIRE AND CONDUIT	AMPS	V-A	BRK	DESCRIPTION	CKT	
1	GATE #9	30	2352	19.6	2-#10 Cu THWN & #10 GN	D in 1-1/2" PVC	A 2-#10 Cu THWN & #10 GND in 1-1/2" PVC	10.0	1,200	20	ENTRY STATION #5	2	
3	GATE #10	30	2352	19.6	2-#6 Cu THWN & #10 GNE	) in 1-1/2" PVC	B 2-#6 Cu THWN & #10 GND in 1-1/2" PVC	10.0	1,200	20	ENTRY STATION #6	4	
5							A					6	
7							В					8	
9						,	A					10	(79)-
11							В					12	
	Total Connected VA and Amps		7,104	29.6	3								
	Total Connected VA and Amps		7,104	29.6	5								

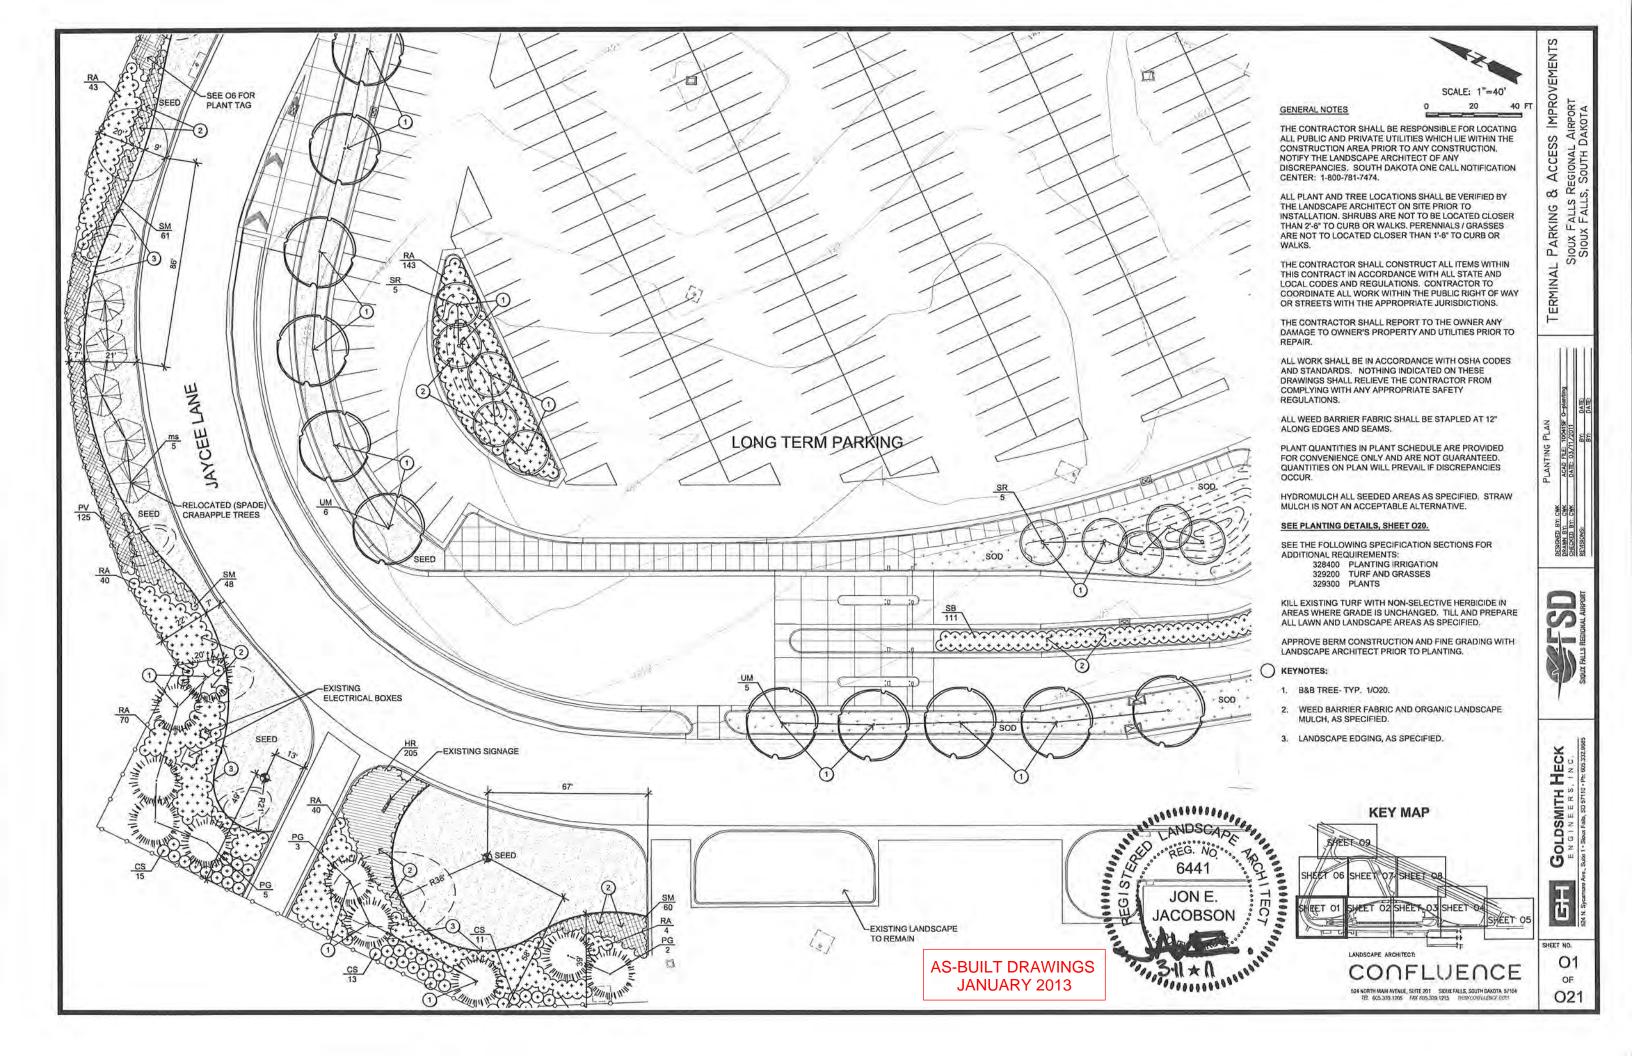

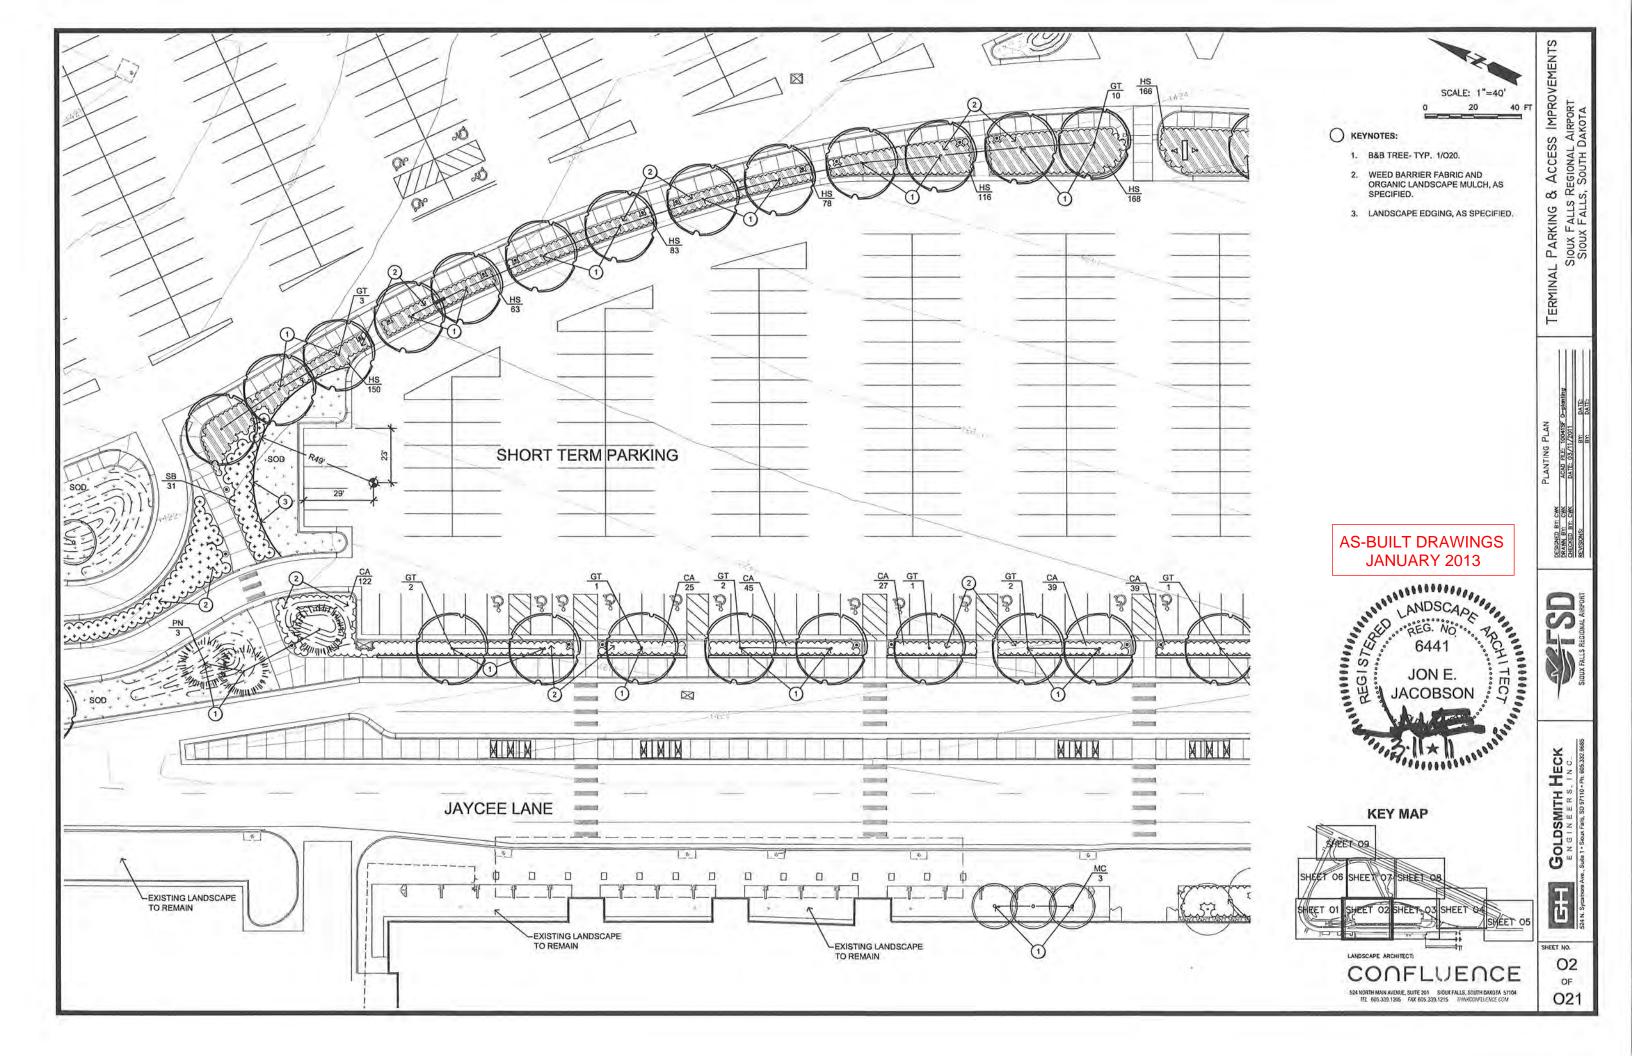


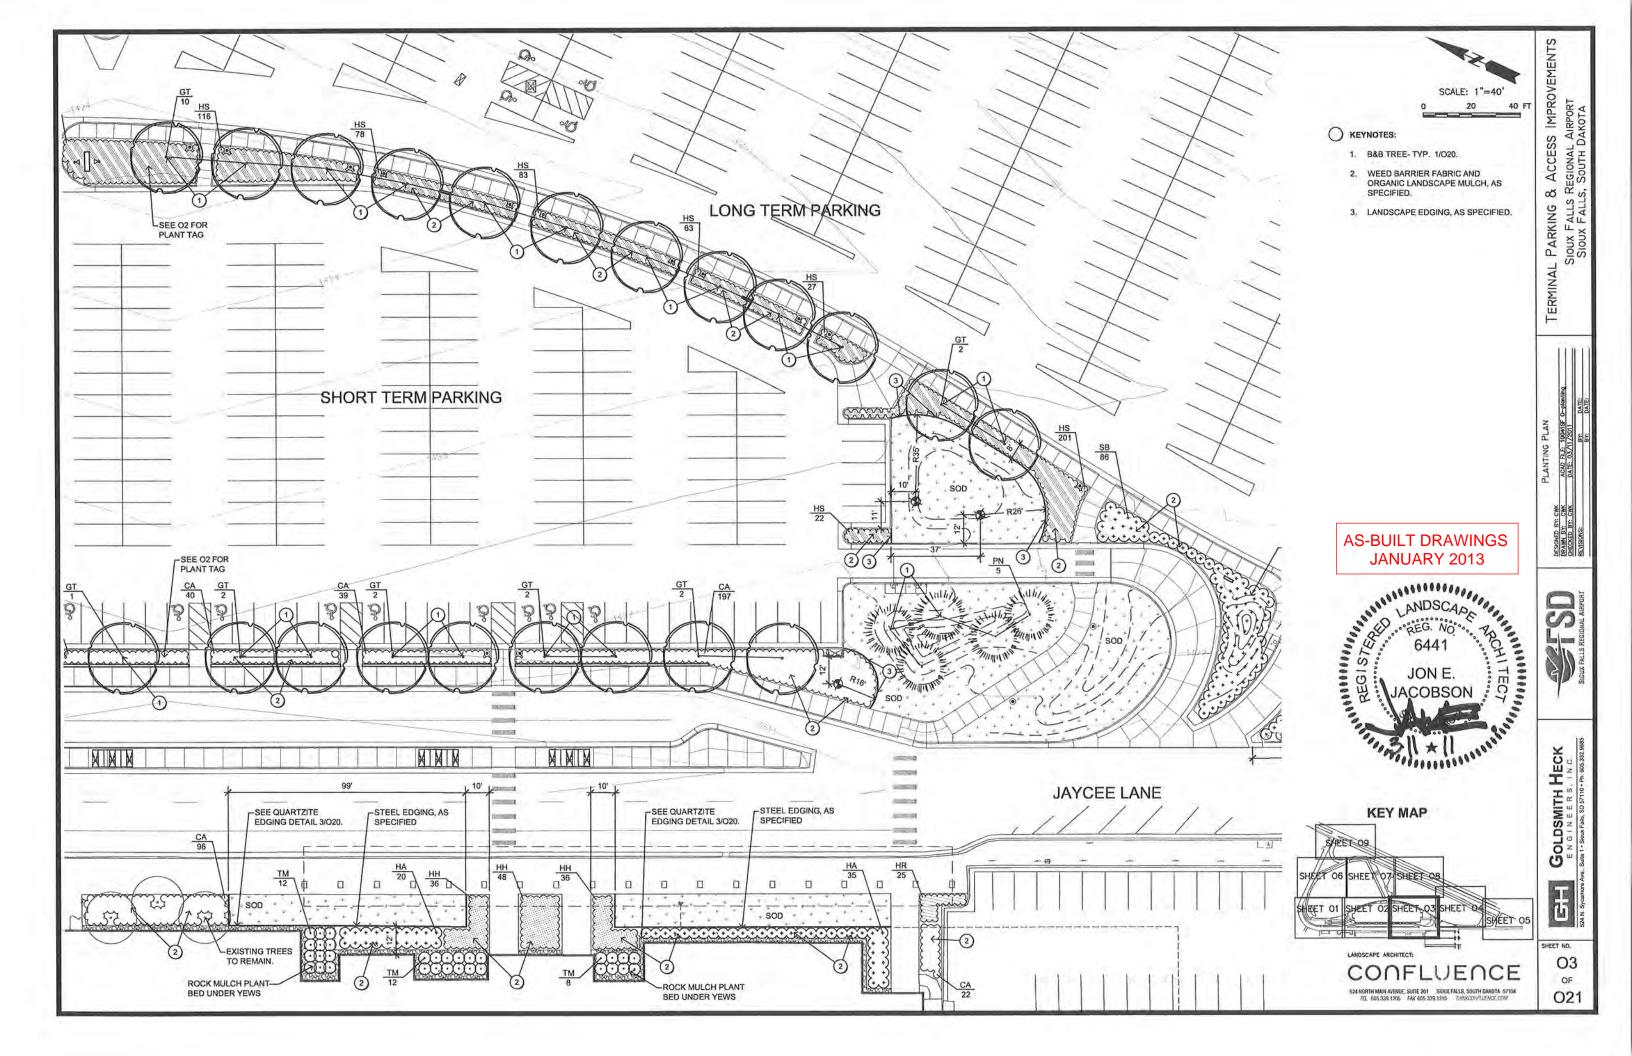


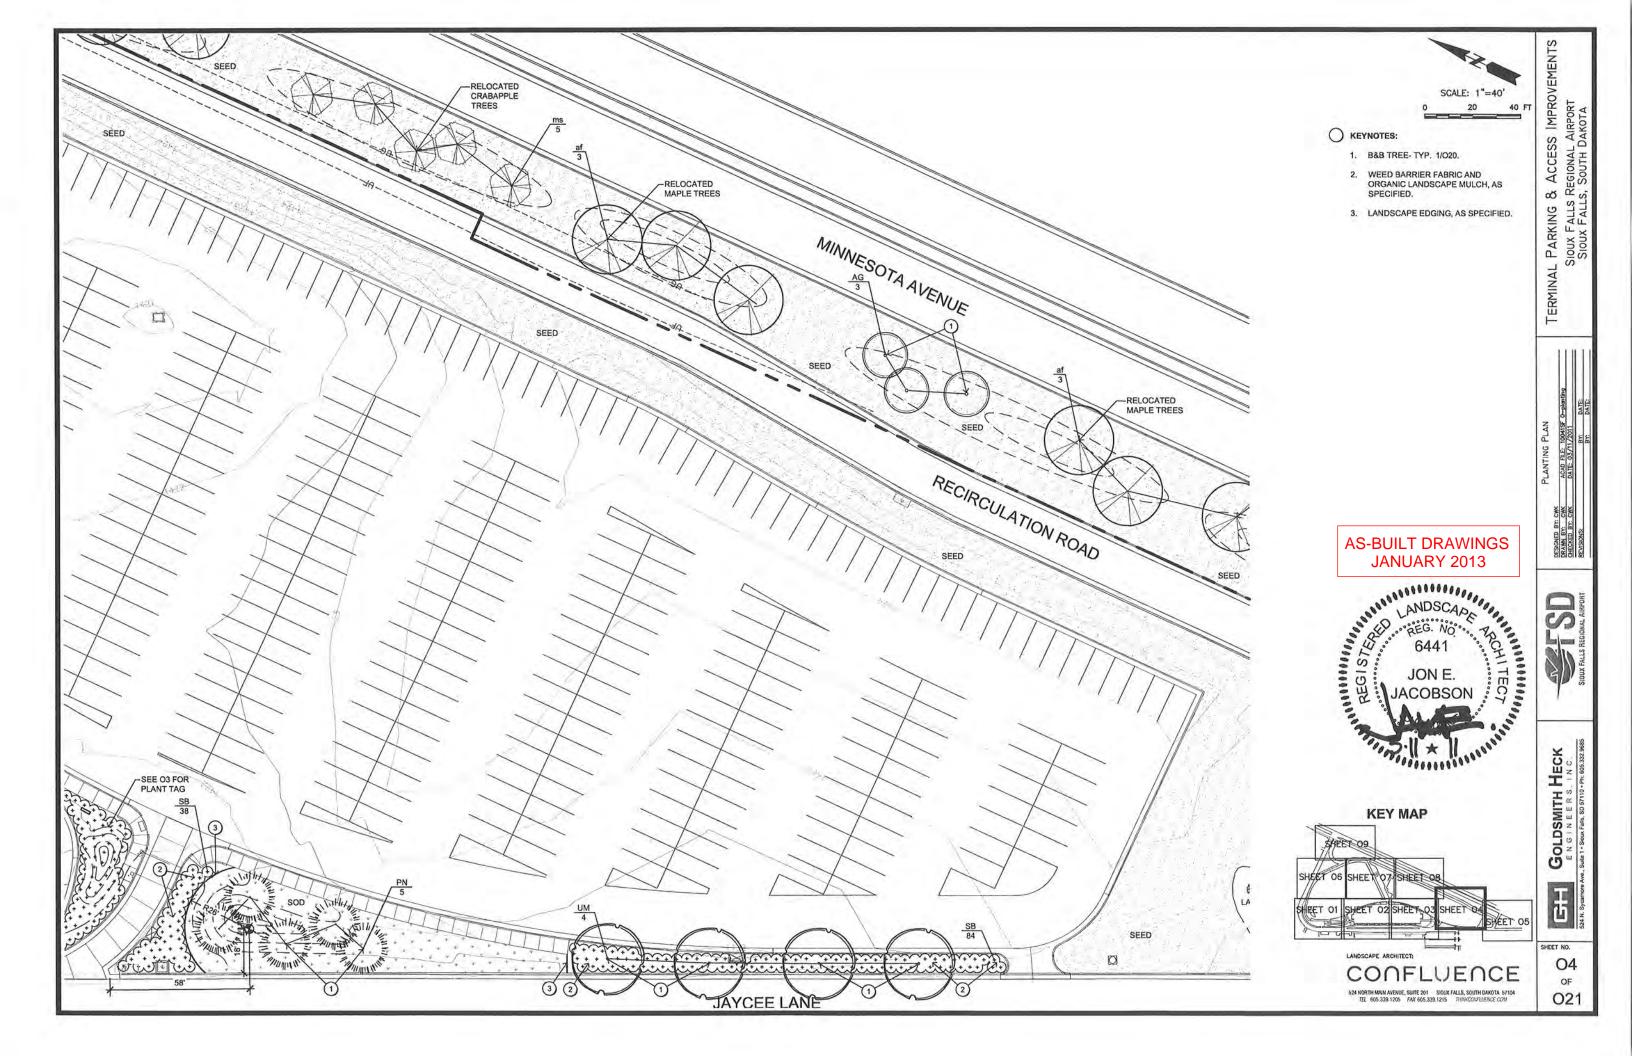


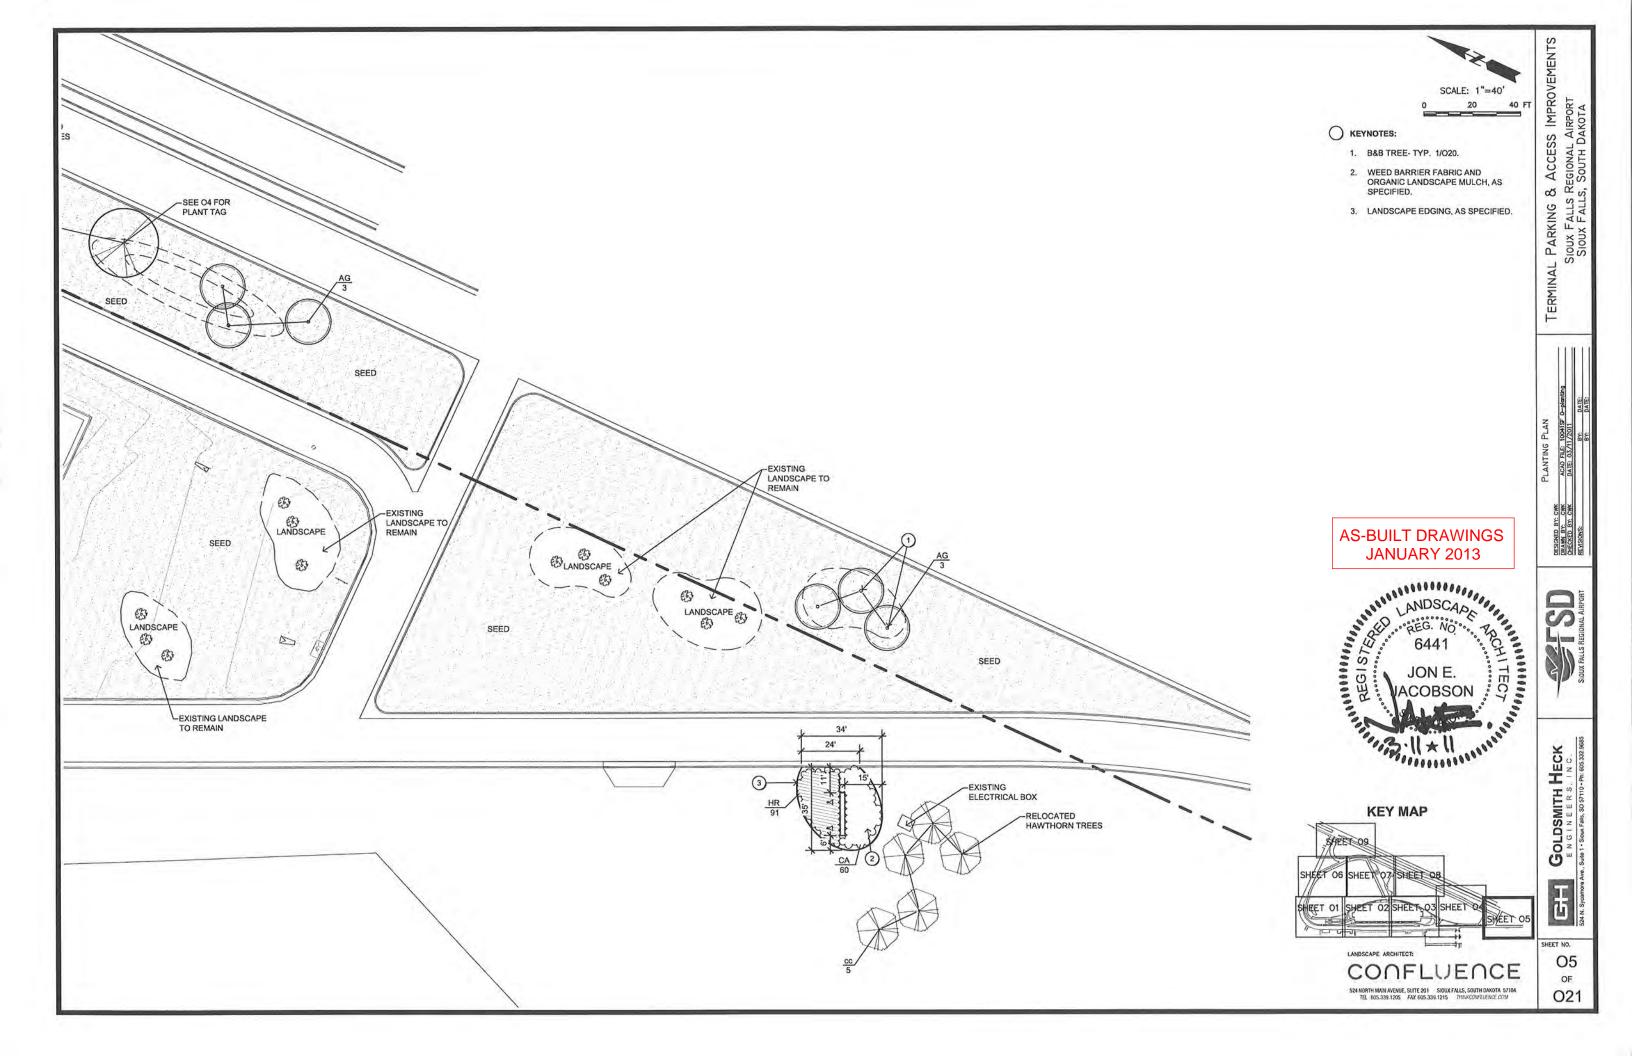



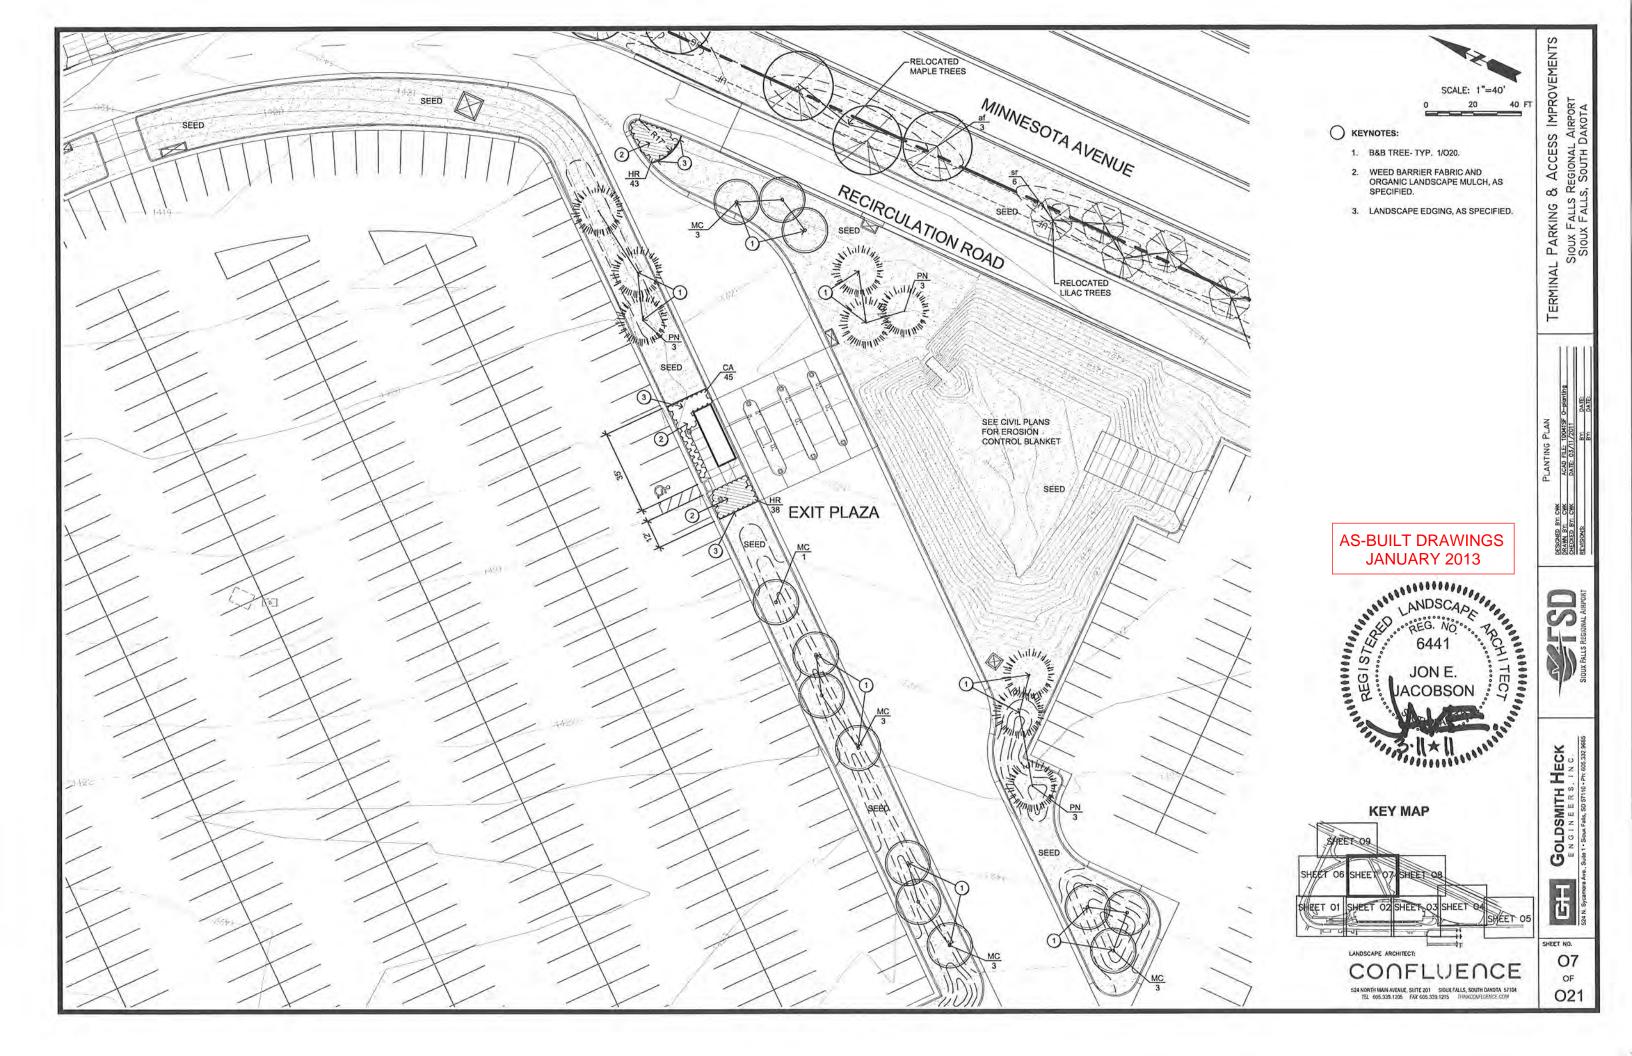

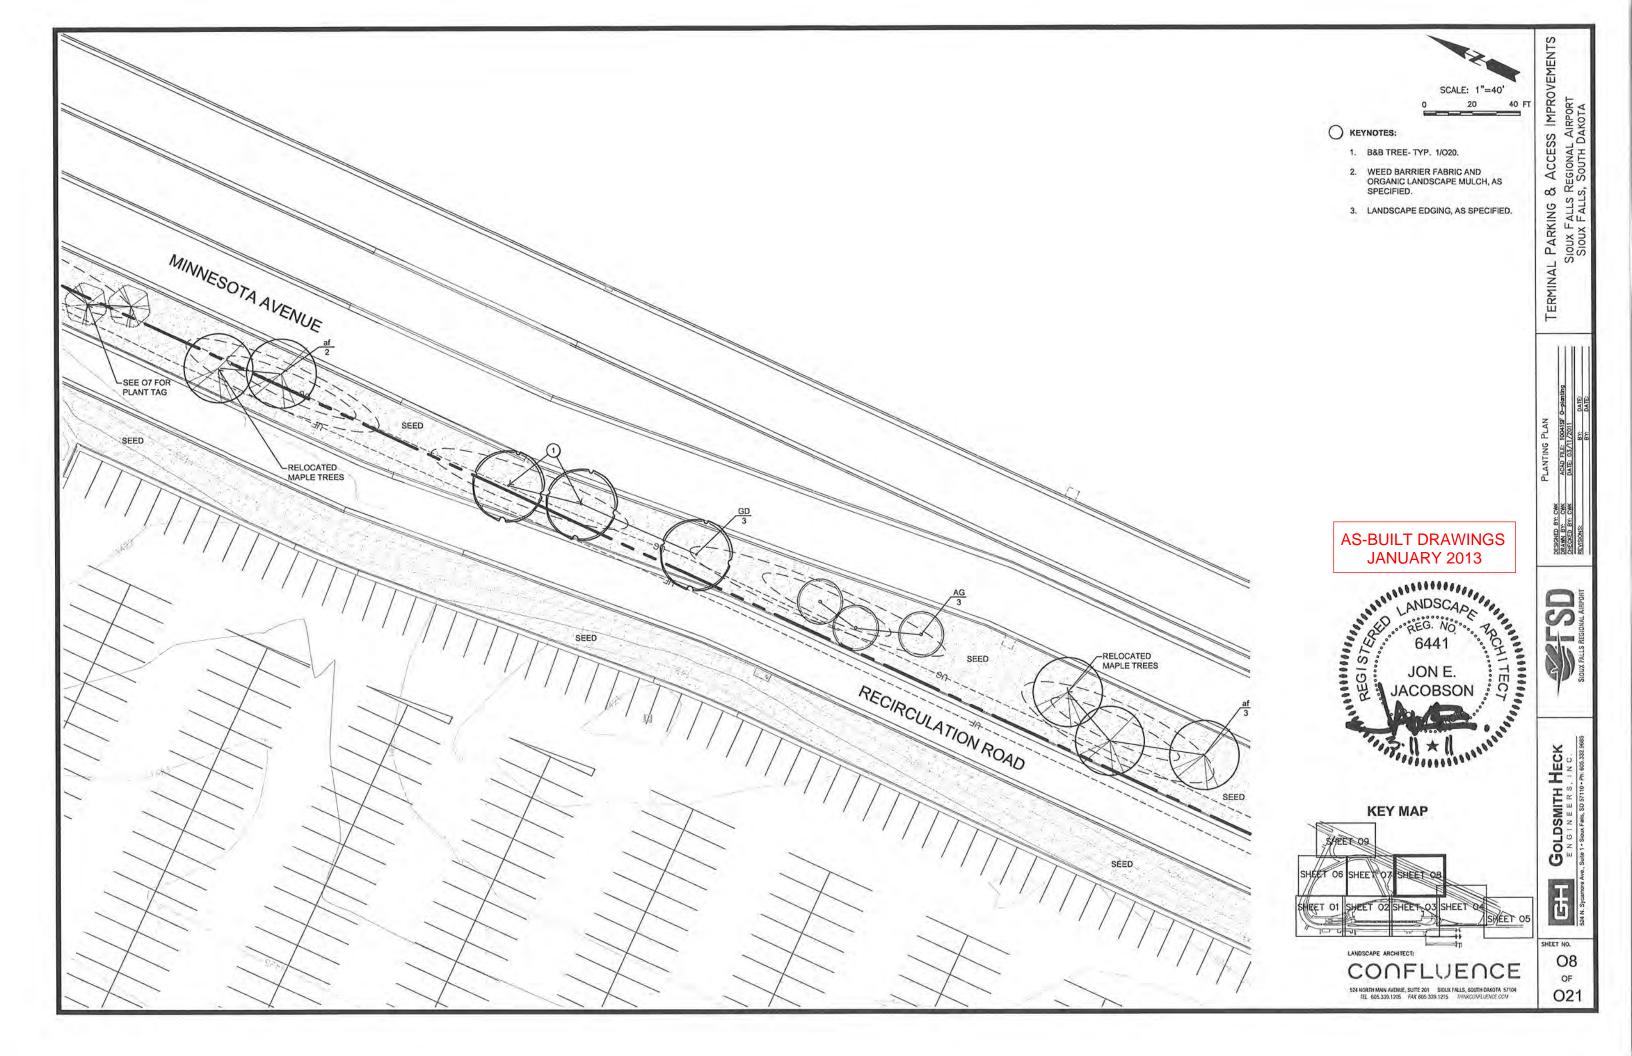

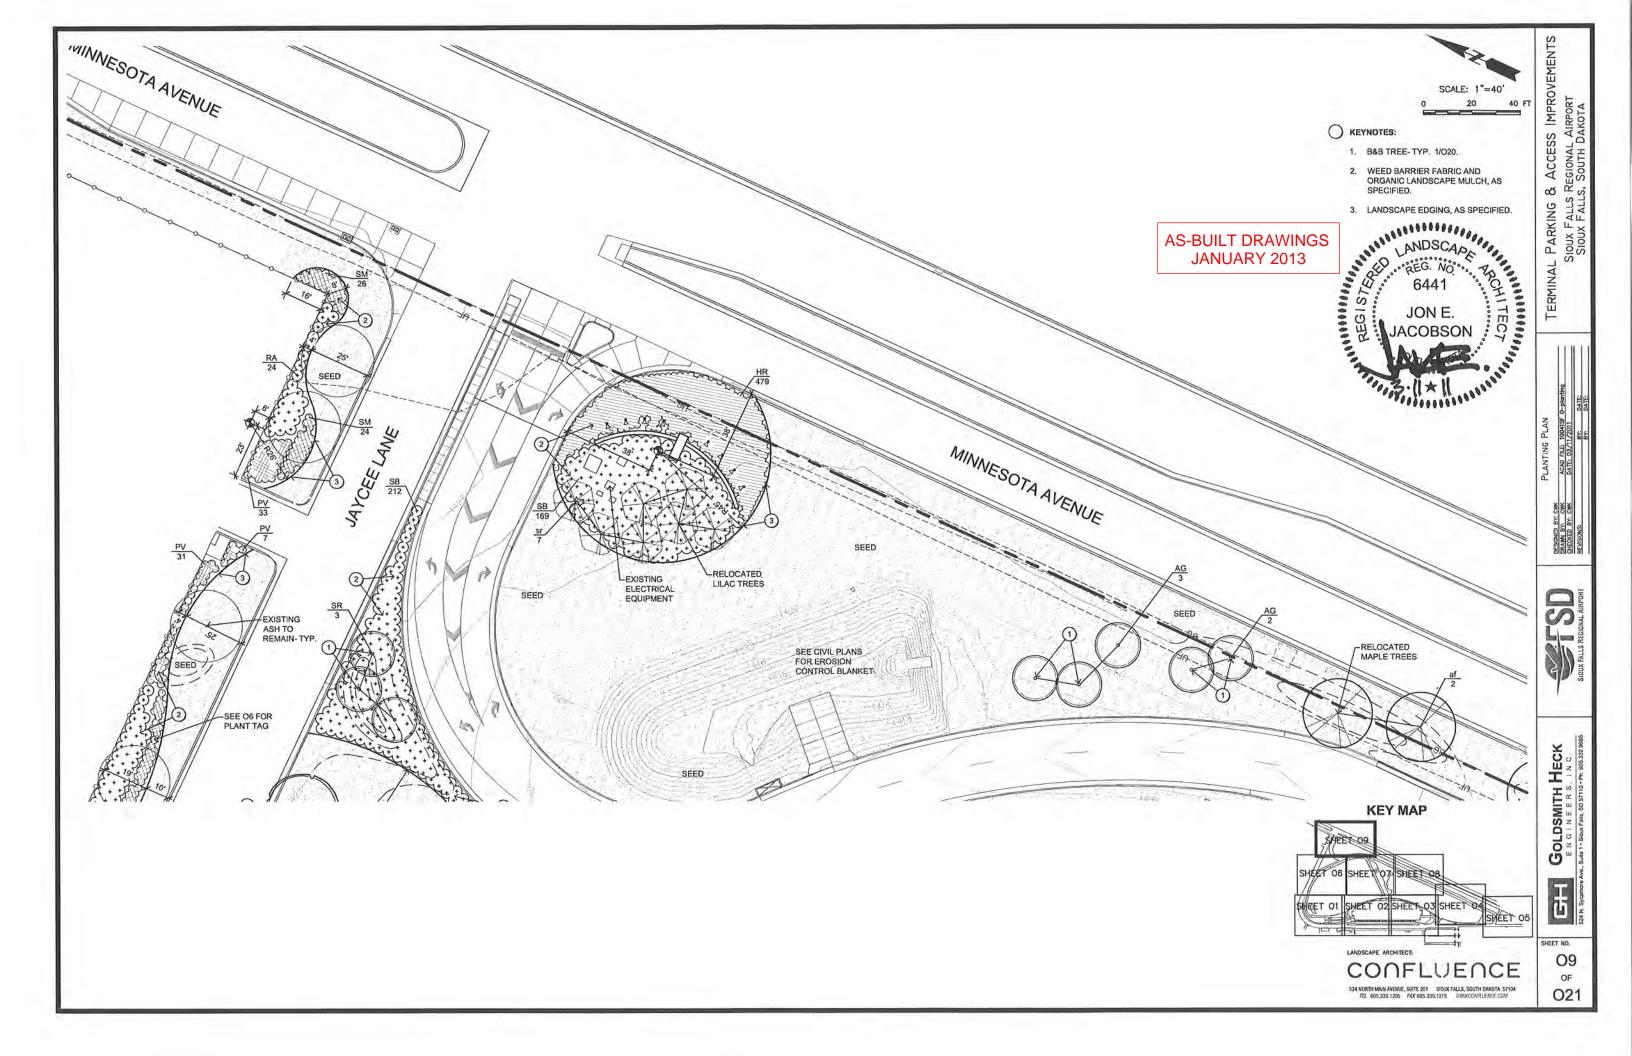



		TO THE BOULEVARD ALONG MINNESOTA AVENUE MAY BE			
ARCHIT		HERE THIS OCCURS PLANT RELOCATED TREES ±18" (AS I R THAN EXISTING GRADE IN BOULEVARD WITH BERMS TO			
PL	ANT SCHE	DULE: EXISTING TREE RELOCATIONS			
KEY	QTY		SIZE	NOTES	
	OPY TREES	1		_	
af	16	ACER FREEMANNII 'JEFFERSRED' AUTUMN BLAZE MAPLE	±3" CAL		
ORN	AMENTAL TH	REES			
cc	5	CRATEAEGUS CRUS-GALLI VAR. INERMIS THORNLESS COCKSPUR HAWTHORN	±3" CAL		
ms	10	MALUS, SPP. CRABAPPLE	±3" CAL		
Sf	13	SYRINGA RETICULATA JAPANESE TREE LILAG	±6' HT	CLUMP	
	1				
PL	ANT SCHE	DULE			
KEY	QTY		SIZE	COND	NOTES
the second se	OPY TREES	7			
GD	3	GYMNOCLADUS DIOICUS KENTUCKY COFFEETREE	2" CAL	B&B	
GT	42	GLEDITSIA TRIACANTHOS 'HARVE' NORTHERN ACCLAIM HONEYLOCUST	2 1/2" CAL	B&B	
UM	20	ULMUS 'MORTON' ACCOLADE ELM	2 1/2" CAL	B&B	
	AMENTAL T				
AG	17	ACER GINNALA AMUR MAPLE	7-8' HT	B&B	MULTI-STEM
MC	16	MALUS 'CENTZAM' CENTURION CRABAPPLE	2" CAL	B&B	
SR	16	SYRINGA RETICULATA 'IVORY SILK' JAPANESE TREE LILAC	7-8' HT	868	MULTI-STEM
EVE	RGREEN TR	EES			
PG	10	PICEA GLAUCA 'DENSATA' BLACK HILLS SPRUCE	6-7' HT	B&B	
PN	27	PINUS NIGRA AUSTRIAN PINE	6-7' HT	B&B	
EVE	RGREEN SH	RUBS			
тм	32	TAXUS x MEDIA 'TAUNTON' TAUNTON YEW	#5	CONT.	
SHR	UBS				
CS	39	CORNUS SERICEA 'CARDINAL' CARDINAL RED OSIER DOGWOOD	#5	CONT.	54" SPACING
НА	55	HYDRANGEA ARBORESCENS 'ANNABELLE' ANNABELLE HYDRANGEA	#5	CONT.	48" SPACING
RA	515	RHUS AROMATICA 'GRO-LOW' GRO-LOW FRAGRANT SUMAC	#3	CONT.	48" SPACING
SB	731	SPIRAEA X BUMALDA 'GOLDFLAME' GOLDFLAME SPIREA	#3	CONT.	36" SPACING
PER	ENNIALS				
нн	120	HOSTA 'HONEYBELLS' HONEYBELLS HOSTA	#1	CONT.	32" SPACING
HR DSCAPE PROHITECT N E. DBSON PV	957	HEMEROCALLIS 'ROCKET CITY' ROCKET CITY DAYLILY	#1	CONT.	24" SPACING
SCAPE HS	.1414	HEMEROCALLIS 'STELLA D'ORO' STELLA D'ORO DAYLILY	#1	CONT.	24" SPACING
No. 70 SM	323	SEDUM 'AUTUMN JOY' AUTUMN JOY SEDUM	#1	CONT.	30" SPACING
TE ORM	AMENTAL G	RASSES			
	796	CALAMAGROSTIS ACUTIFLORA 'KARL FOERSTER' FEATHER REED GRASS	#1	CONT.	30" SPACING
SON ?? FV	563	PANICUM VIRGATUM 'HEAVY METAL' HEAVY METAL SWITCHGRASS	#1	CONT.	30" SPACING

524 NORTH MAN AVENUE, SUITE 201 SIDUX FALLS, SOLITH DAKOTA 57104 TEL 605.339.1205 FAX 605.339.1215 THINKOWFLIENCE COM


021



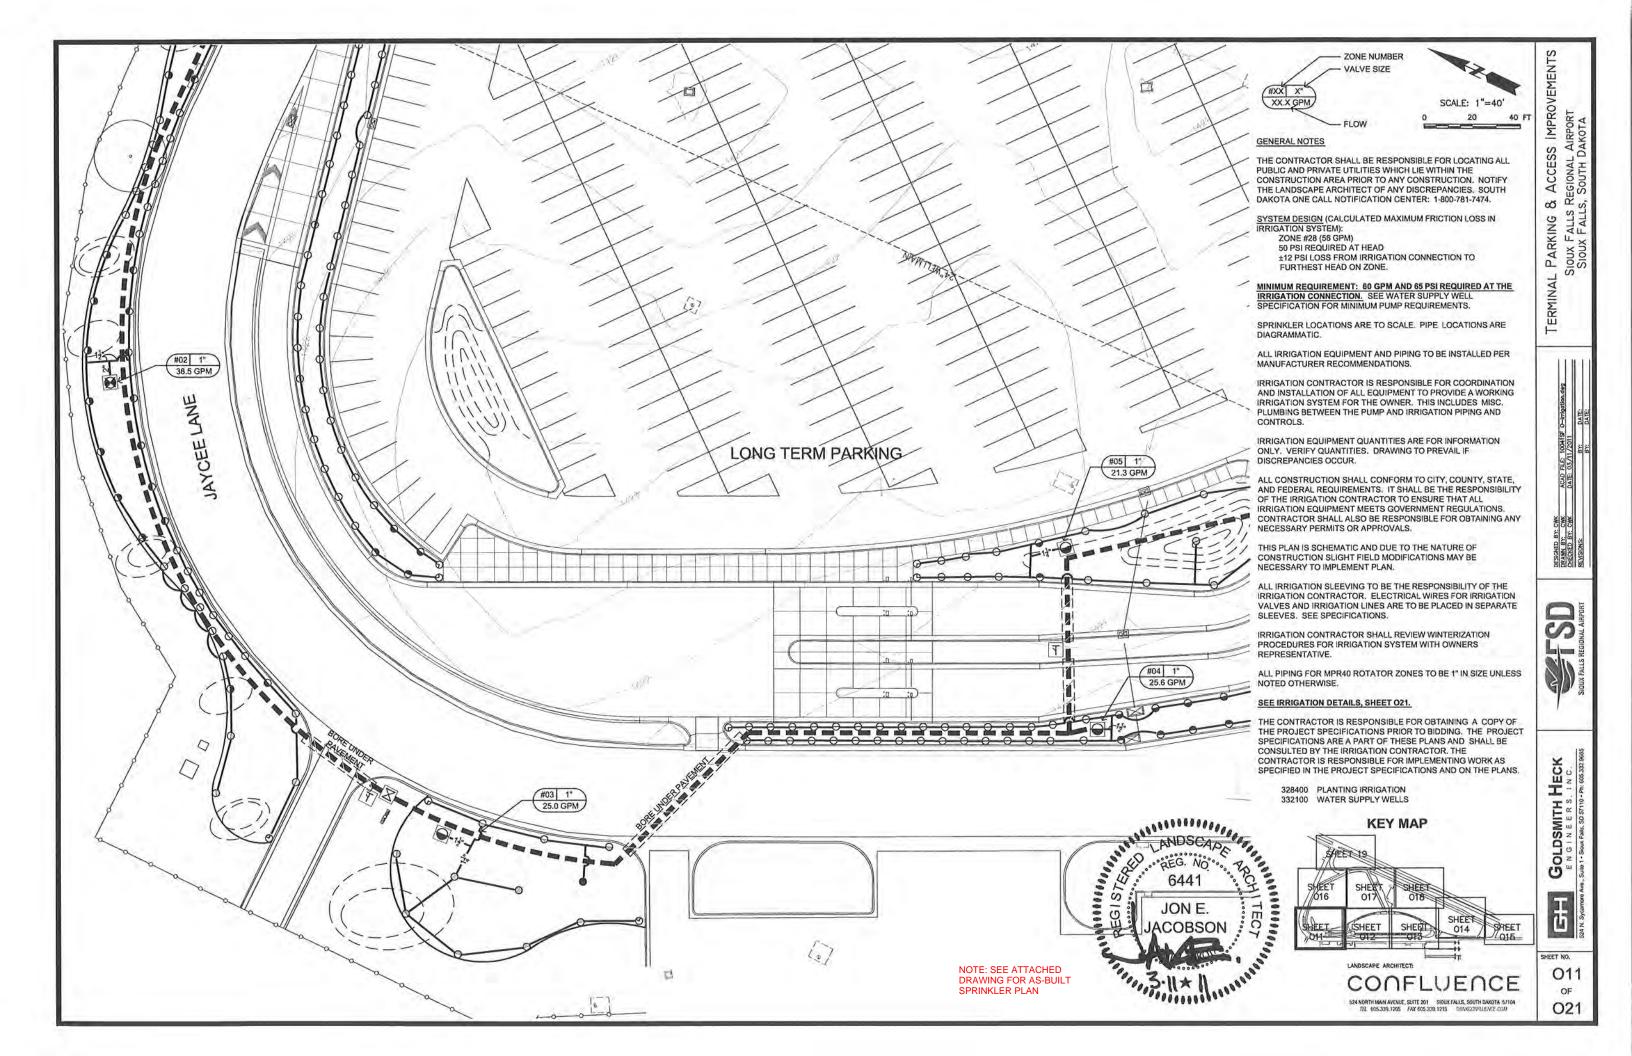

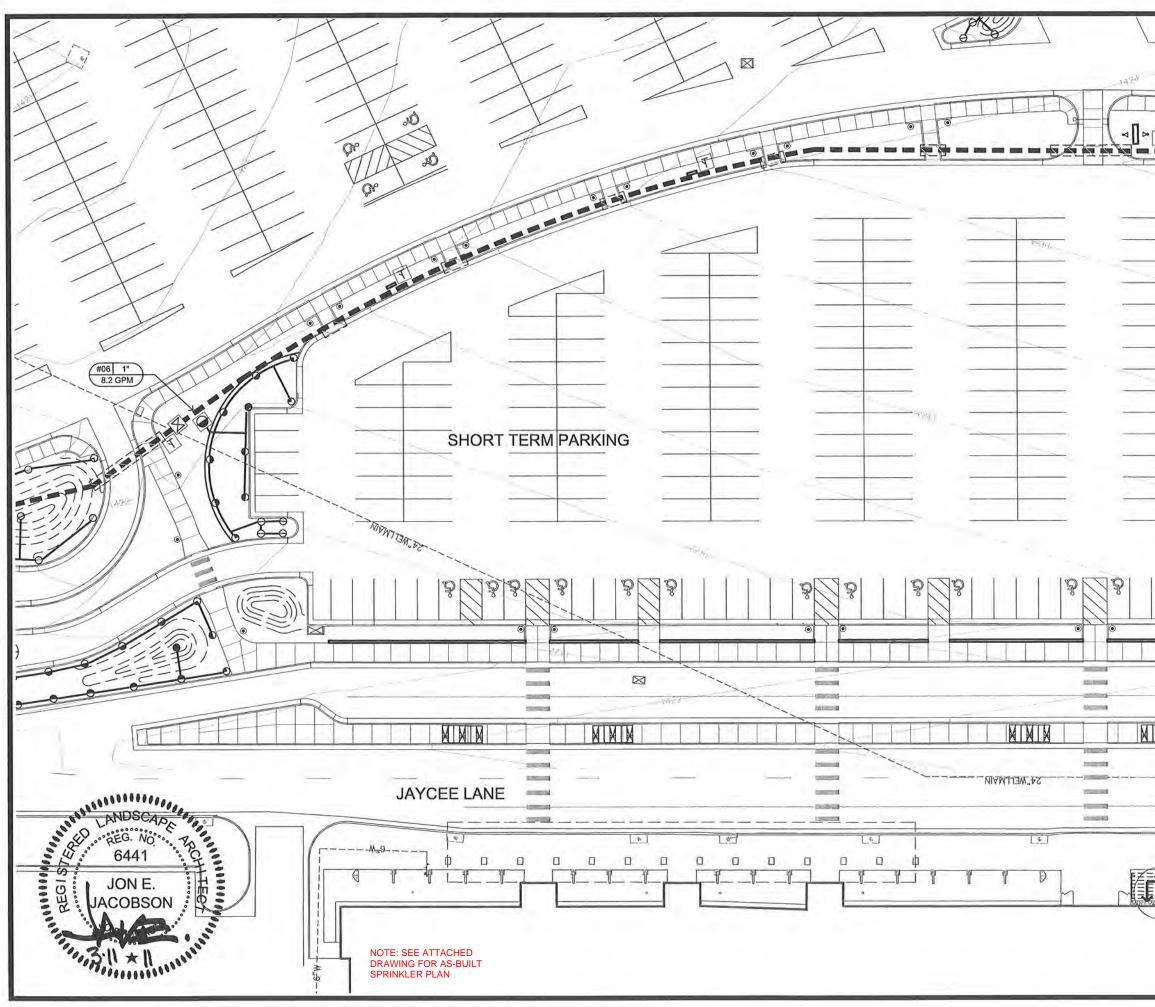

-		GATI		SCALE: 1"=40' 20 40 FT	TERMINAL PARKING & ACCESS IMPROVEMENTS SIOUX FALLS REGIONAL AIRPORT SIOUX FALLS, SOUTH DAKOTA
	KEY	QTY	DESCRIPTION	COMMENTS	AIF
]	w	1	WELL	SEE SPECIFICATIONS	NAL TH T
		1	I-CORE CONTROLLER HUNTER IC-3601-PL	LOCATE IRRIGATION CONTROLS IN THE	ACI
		1	HUNTER DUAL48M 2 WIRE DECODER MODULE REMOTE CONTROL	PARKING BUILDING MECHANICAL ROOM	S RE
	_	1	HUNTER ICR-KIT		ALL
1		33	HUNTER DUAL STATION DECO ARRESTOR	DER AND SURGE	AK AY
	S	1	HUNTER SOLAR SYNC MODULE AND SENSOR	COORDINATE LOCATION W/ ENG.	PA Siol
	O	10	1" GLOBE VALVE	4/021	U N
		24	HUNTER ICV-101G 1-1/2" GLOBE VALVE	4/021	NA
-	-		HUNTER ICV-151G 1" DRIP ZONE KIT		M
	Ð	1	HUNTER ICZ-101 QUICK COUPLING VALVE	INCLUDE 3 EA: HK-33	Ш
1	<u> </u>	18	HUNTER HQ-3RC	KEY & HS-0 SWIVEL	
		6	3" PVC ISOLATION VALVE IN VALVE BOX	VERIFY LOCATIONS WITH OWNER	Let II I
-	- CosR	14	HUNTER PGP ULTRA PGP-04 - 3.0SR	SHORT RADIUS 3.0 GPM @ 50 PSI	on.dip
	- 6	2	HUNTER PGP ULTRA	LOW ANGLE	Intgat
		-	PGP-04 - 3.5LA HUNTER PGP ULTRA	3.5 GPM @ 50 PSI LOW ANGLE	004155 O-brigation.dng DATE: DATE:
-	0	65	PGP-04 - 3.5LA HUNTER PGP ULTRA	3.5 GPM @ 50 PSI 4.0 GPM @ 45 PSI	DATE: DATE: DATE:
-	4	11	PGP-04 - 4.0		- I-
	9	62	HUNTER PGP ULTRA PGP-04 - 6.0	6.0 GPM @ 45 PSI	ACAD FILE: DATE: 03/11/201 BY: BY:
	$\odot$	9	HUNTER PGP ULTRA PGP-04 - 8.0	8.0 GPM @ 45 PSI	10 FLE: E: 03/1
	Ø	15	HUNTER MP ROTATOR	0.19 GPM @ 40 PSI	ACAD
-	0	193	MPR40-04-MP1000-90 HUNTER MP ROTATOR	8' TO 15' RADIUS 0.37 GPM @ 40 PSI	
1	-	1.22	MPR40-04-MP1000-180 HUNTER MP ROTATOR	8' TO 15' RADIUS 0.40 GPM @ 40 PSI	<u> ŠŠŠŠ</u>
	0	13	MPR40-04-MP2000-90	13' TO 21' RADIUS	BIT: CHK BT: CHK BT: CHK
-	•	273	HUNTER MP ROTATOR MPR40-04-MP2000-180	0.74 GPM @ 40 PSI 13' TO 21' RADIUS	DESIGNED BY: DRAMN BY: OHECKED BY: REVISIONS
	۲	3	HUNTER MP ROTATOR MPR40-04-MP2000-360	1.47 GPM @ 40 PSI 13' TO 21' RADIUS	<u>ଶାଖିଥା</u> ଶ
	G	4	HUNTER MP ROTATOR MPR40-04-MP3000-90	0.86 GPM @ 40 PSI 22' TO 30' RADIUS	
1 1	0	40	HUNTER MP ROTATOR	1.82 GPM @ 40 PSI	
	-		MPR40-04-MP3000-180 HUNTER MP ROTATOR	22' TO 30' RADIUS 3.64 GPM @ 40 PSI	LI POL
	0	7 875 LF	MPR40-04-MP3000-360 4" SLEEVE SCHEDULE 40 PVC	22' TO 30' RADIUS	NAL A
1		5,530	2-1/2" MAINLINE CLASS 200 PV	C	SEGIO
1	8488	LF	1" LATERAL SDR 21 POLY		SIDUX FALLS REGIONAL AIRPO
		11,710 LF			SUN SUN
	12"	1,900 LF	1-1/4" LATERAL SDR 21 POLY		No.
	12"	855 LF	1-1/2" LATERAL CLASS 160 PV	0	
	2"	515 LF	2" LATERAL CLASS 160 PVC		-
	22	50 LF	2-1/2" LATERAL CLASS 160 PV	- (F-1+)	18
M	-	400 LF 2230	3" CL315 PVC DRIP LINE HEAD NETAFIM TECHLINE TLDL6-12	and the second s	AITH HECK
		LF			HEO
	12"	170 LF	1-1/4" MAINLINE CLASS 200 PV	C	10. P
			17002 144 5		LL B B B B B B B B B B B B B B B B B B
11	-		KEY MAP		SSM P E
	-		SHEET 19		GOLDSMITH HECK E N G I N E E R S, I N C. Suite 1 - Scolar Fails, SD 57110 - Ph. 605.232.9
	=	÷	AC		O Z -1 ag
1	-		SHEET SHEET SHEET		ve. Su
1=	2	1	016 017 018		The state
ŧ		17		SHEET	GH GOLDSN E N GI N E S24 N. Sycamoro Ave., Suffor 1 - Scoar Faas.
any the	5	(9	HEET SHEET SHEET	014 SHEET	S24N.
/		2			
				tp	SHEET NO.
			COOFL	UEOCE	012
			524 NORTH MAIN AVENUE, SUITE 201	SIOUX FALLS, SOUTH DAXOTA 57104	o⊧ 021
			TEL 605.339.1205 FAX 605.3	39.1215 THINKCONFLUENCE.COM	1 1 1 1 4

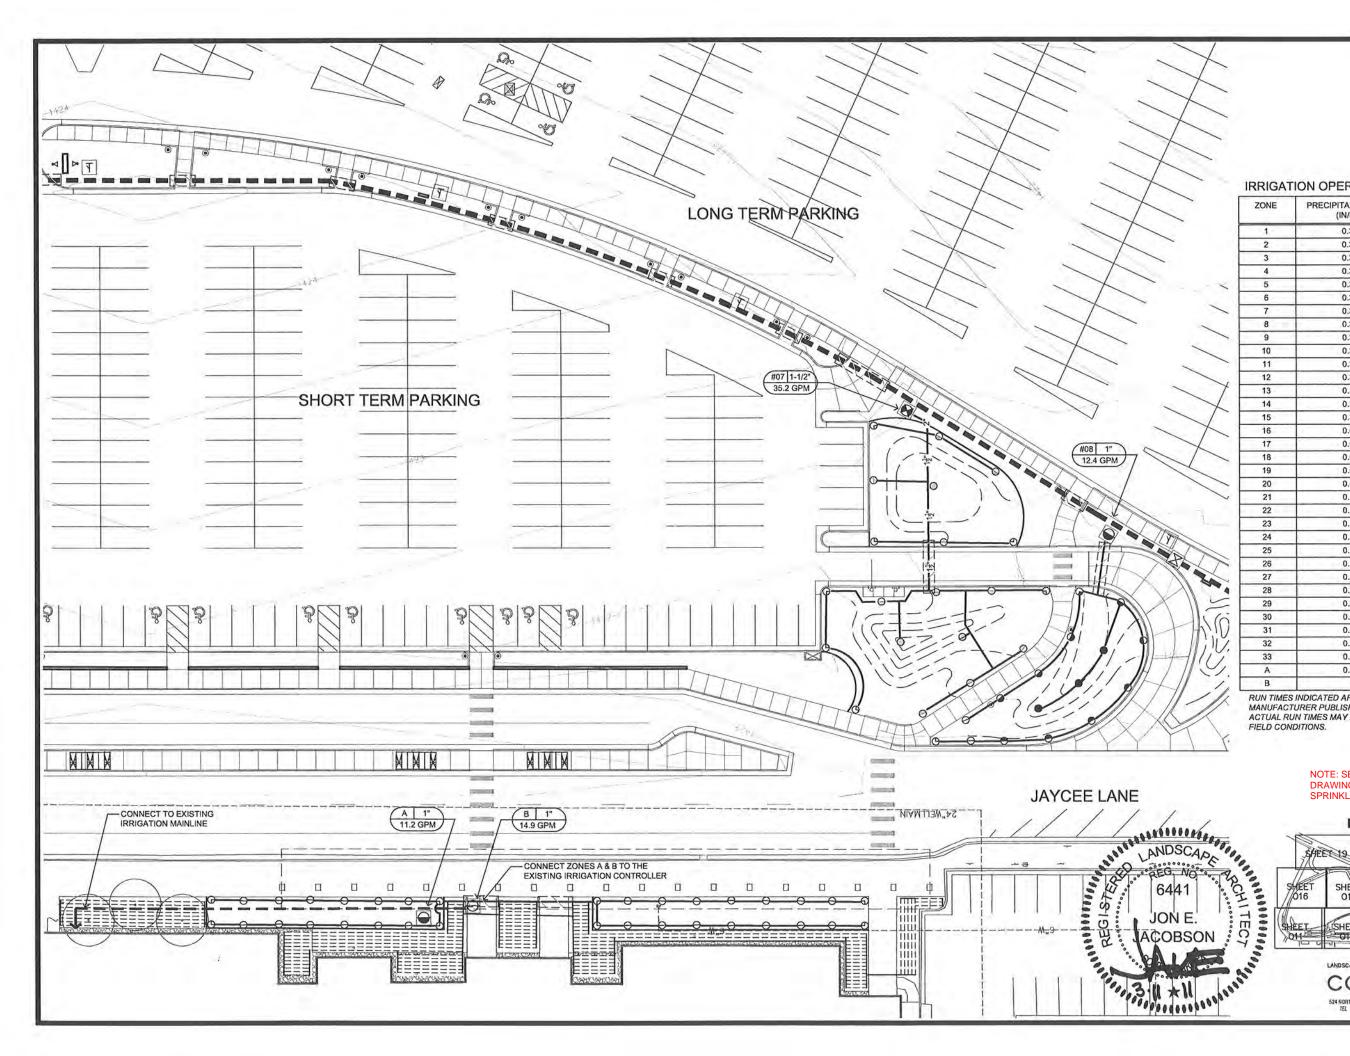

SCALE: 1"=40' 20

#### **MPROVEMENTS** 40 F Access **IRRIGATION OPERATION SCHEDULE** ð ZONE PRECIPITATION RATE RUN TIME (IN/HR) (MINUTES PER WEEK) ERMINAL PARKING 0.39 154 1 2 0.39 154 0.39 154 3 4 0.39 154 5 0.39 154 0.39 6 154 154 0.39 7 8 0.39 154 9 0.39 154 10 0.39 154 11 0.39 154 12 0.39 154 13 0.39 154 14 0.39 154 0.39 15 154 0.62 97 16 PLAN 17 0.62 97 GATION 18 0.62 97 19 0.62 97 20 0.62 97 21 0.55 109 22 0.55 109 23 0.55 109 0.92 24 65 25 0.55 109 26 0.55 109 27 0.62 97 28 0.62 97 29 0.62 97 0.62 97 30 31 0.62 97 32 0.62 97 0.62 33 97 0.39 154 A В RUN TIMES INDICATED ARE A REFERENCE POINT BASED ON MANUFACTURER PUBLISHED PRECIPITATION RATES. ACTUAL RUN TIMES MAY NEED TO BE ADJUSTED BASED ON FIELD CONDITIONS. GOLDSMITH HECK NOTE: SEE ATTACHED DRAWING FOR AS-BUILT SPRINKLER PLAN **KEY MAP** SHEET 19 SHEET SHEET 018 표 017 SHEET 014 SHEET SHEET SHEET 012 OIS SHEET NO.

CONFLUENCE 524 NORTH MAIN AVENUE, SUITE 201 SIOUX FALLS, SOUTH DAKOTA 57104 TEL 605.339.1205 FAX 605.339.1215 THINKCONFLUENCE.COM

LANDSCAPE ARCHITECT:

and a star


SIOUX FALLS REGIONAL AIRPORT SIOUX FALLS, SOUTH DAKOTA DESIGNED BY: CWK DRAWN BY: CWK CHECKED BY: CWK REVISIONS:





013


OF


021

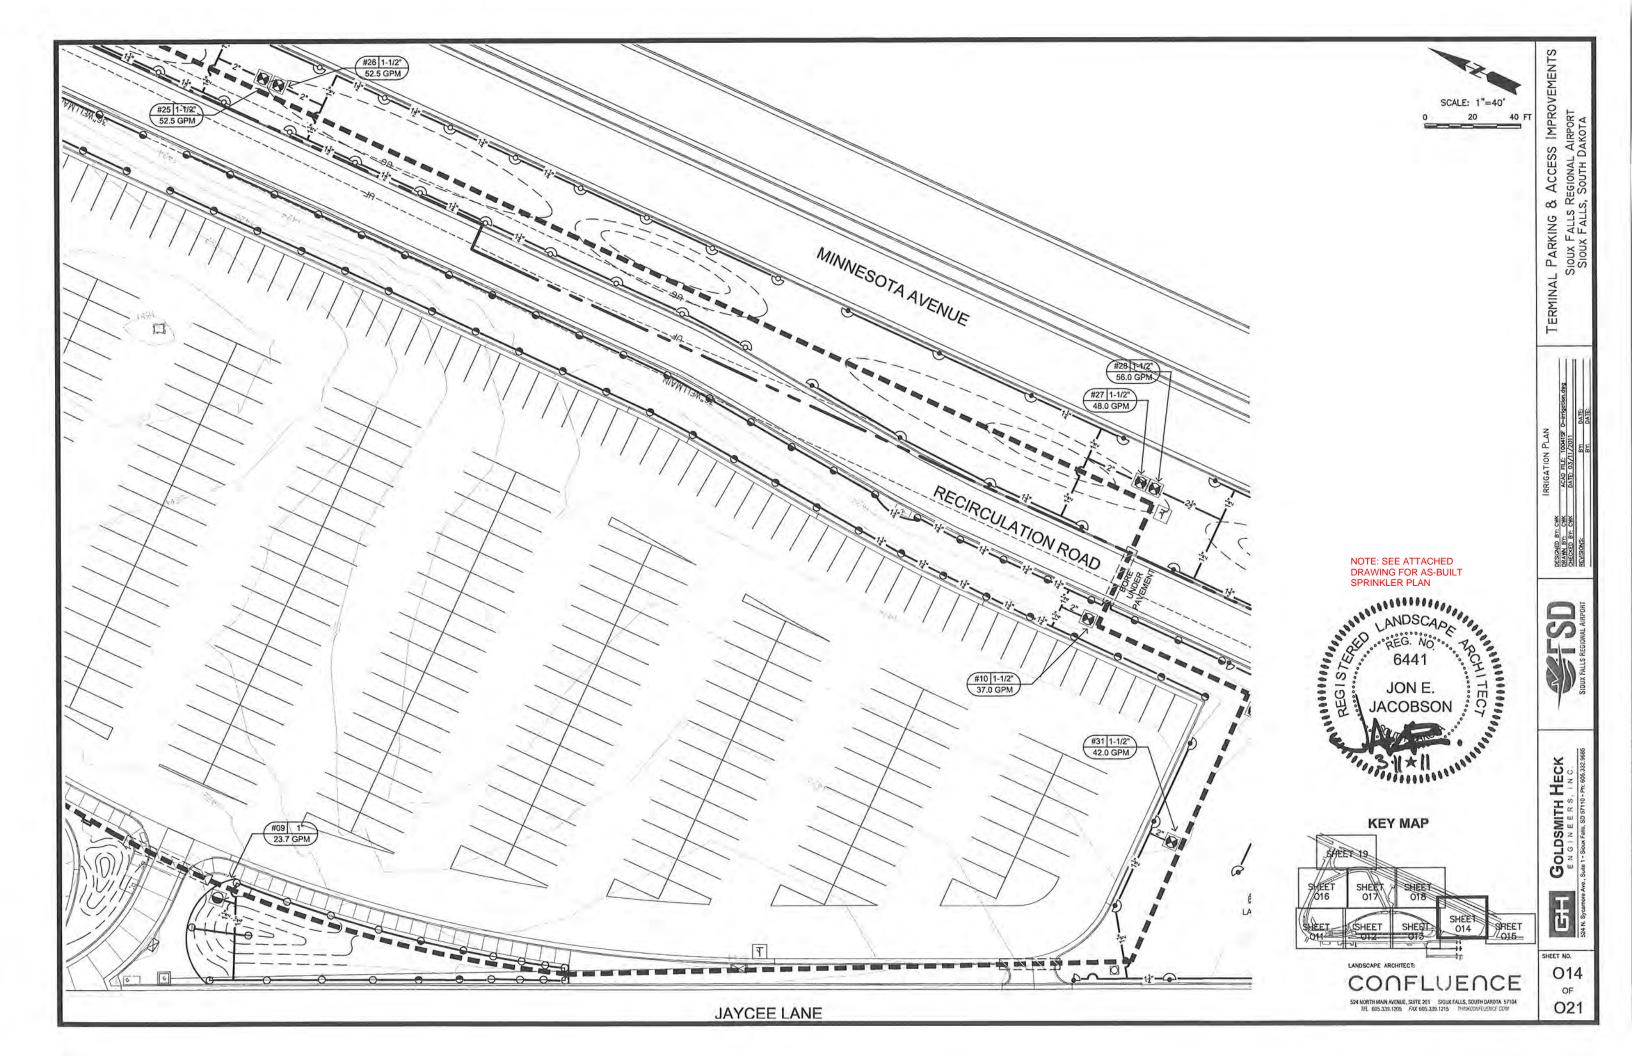


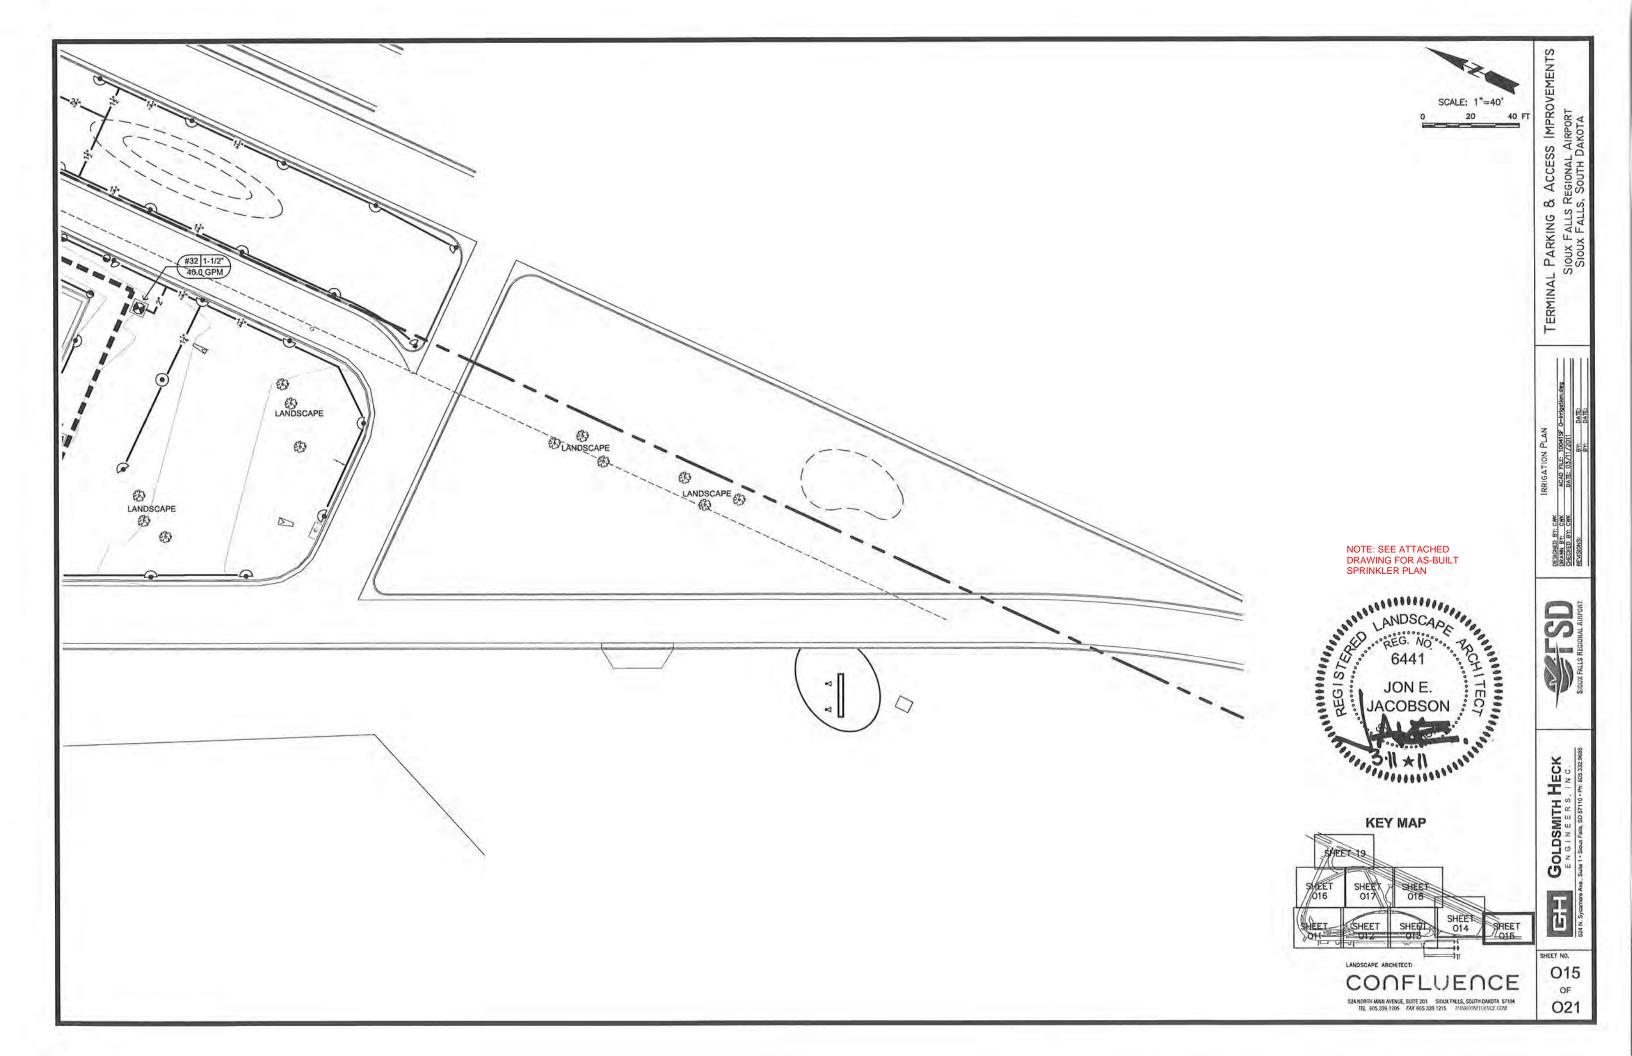


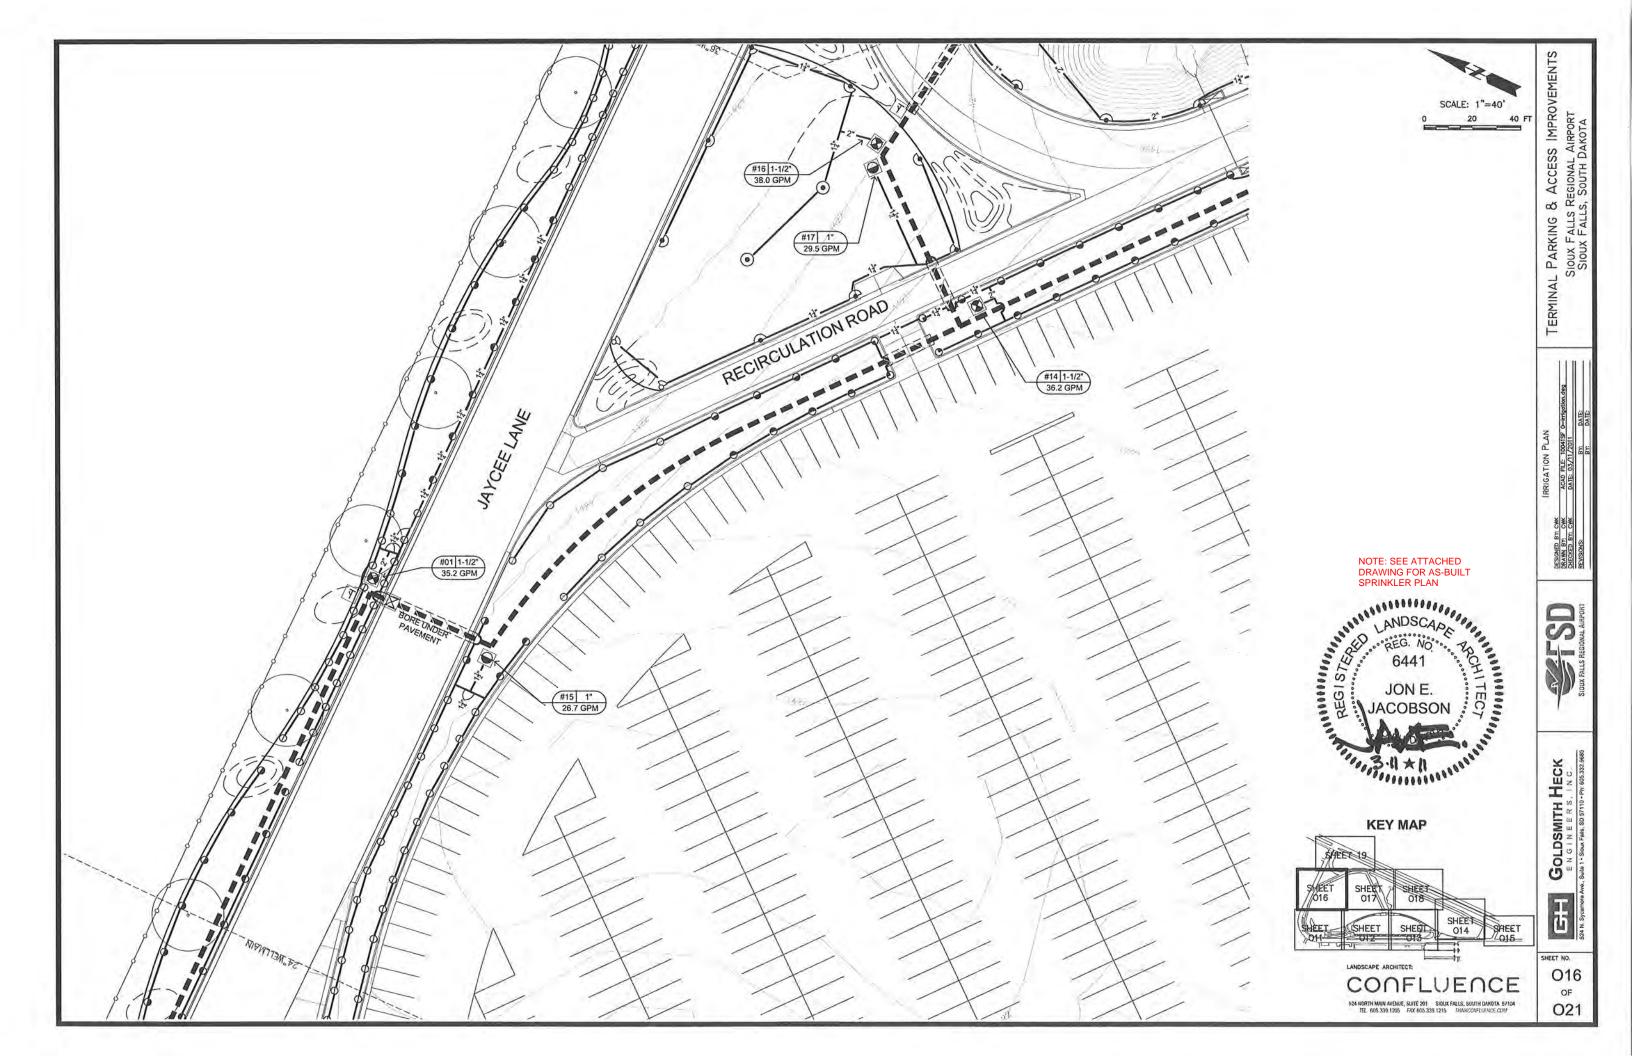


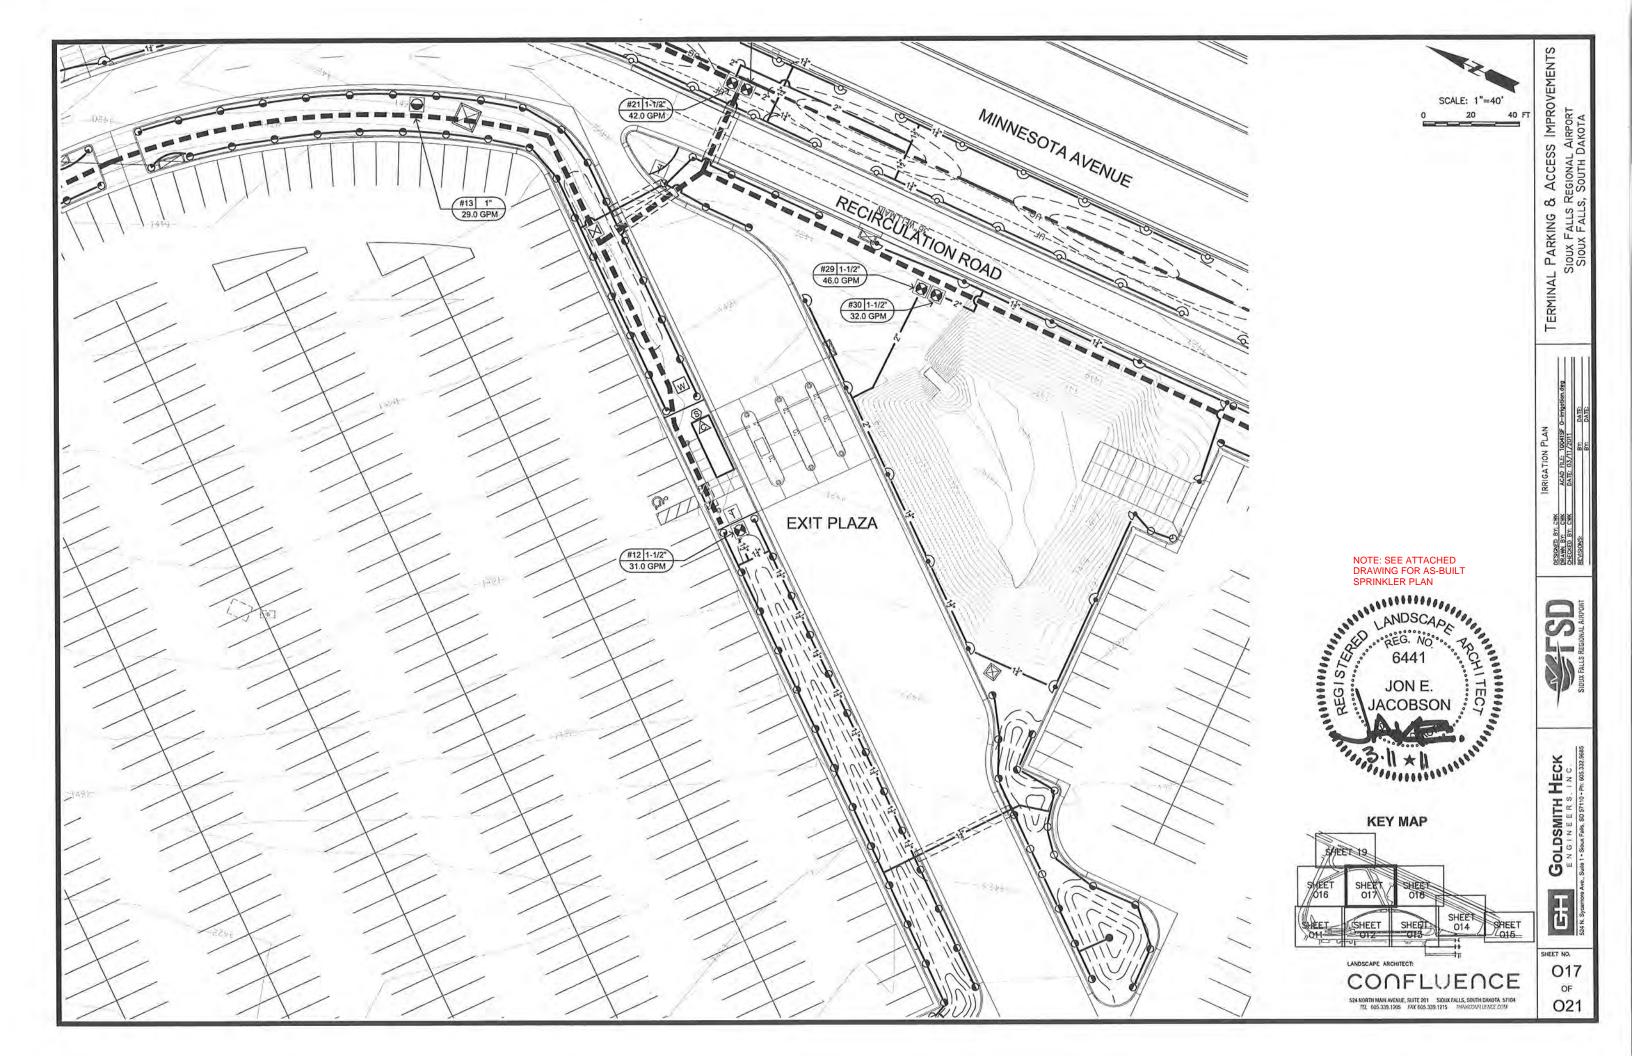


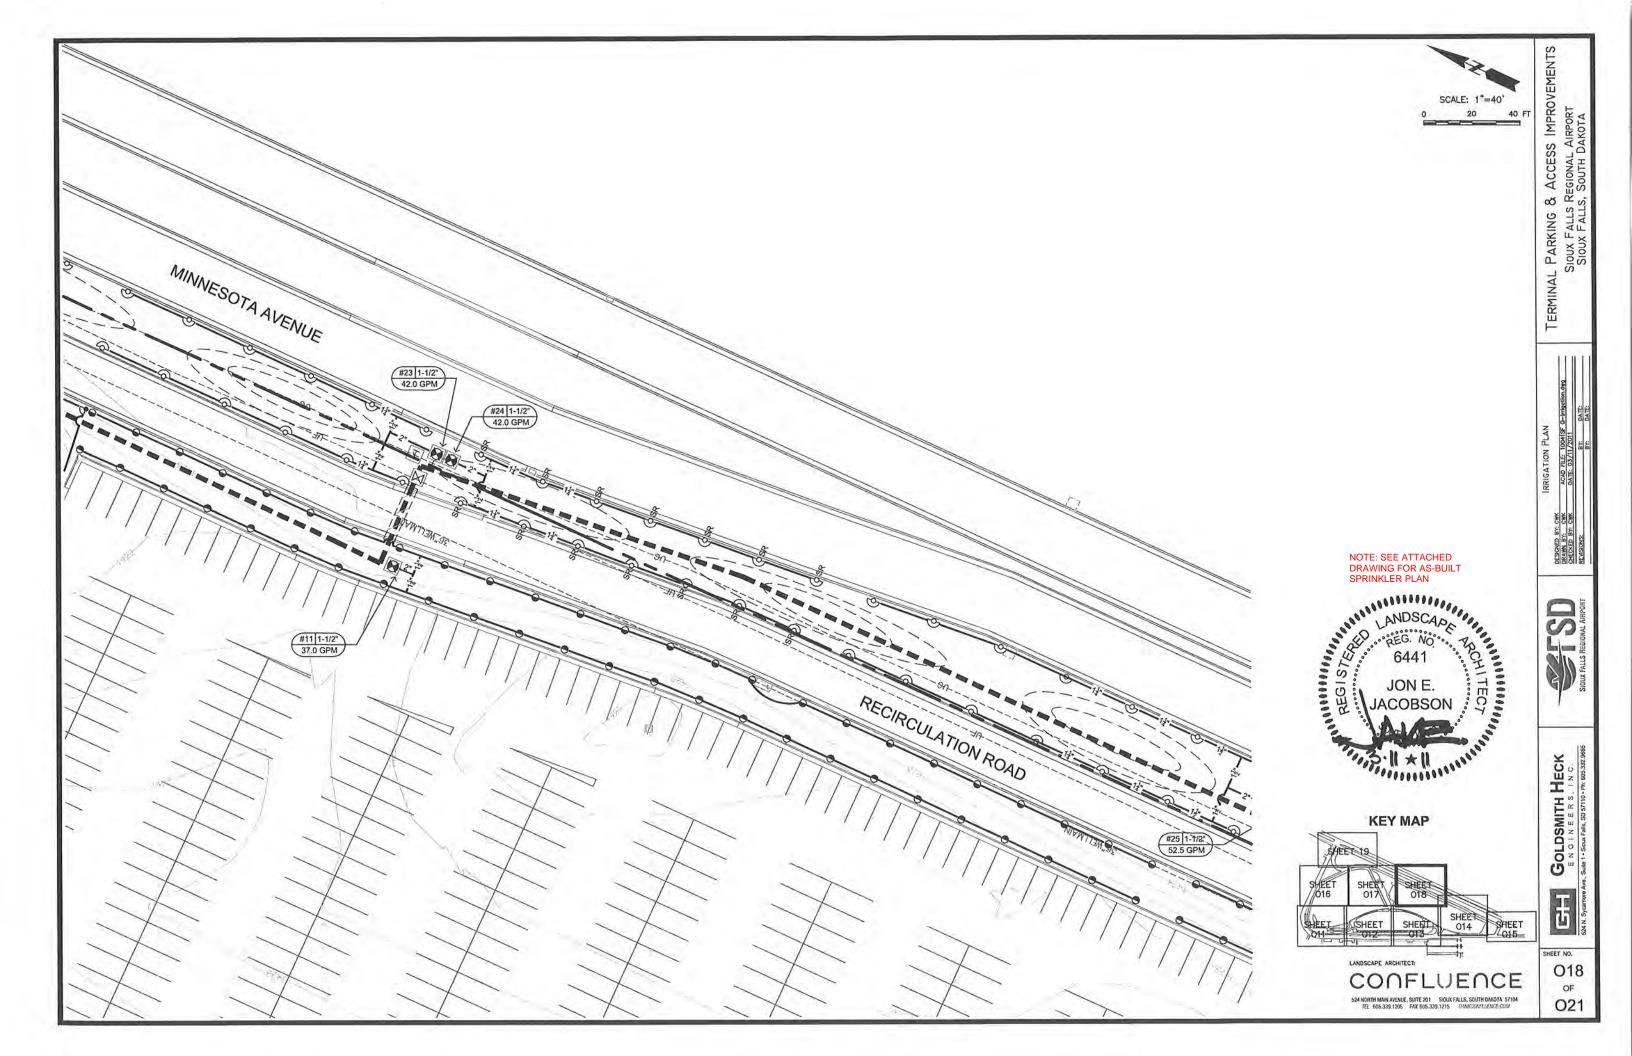


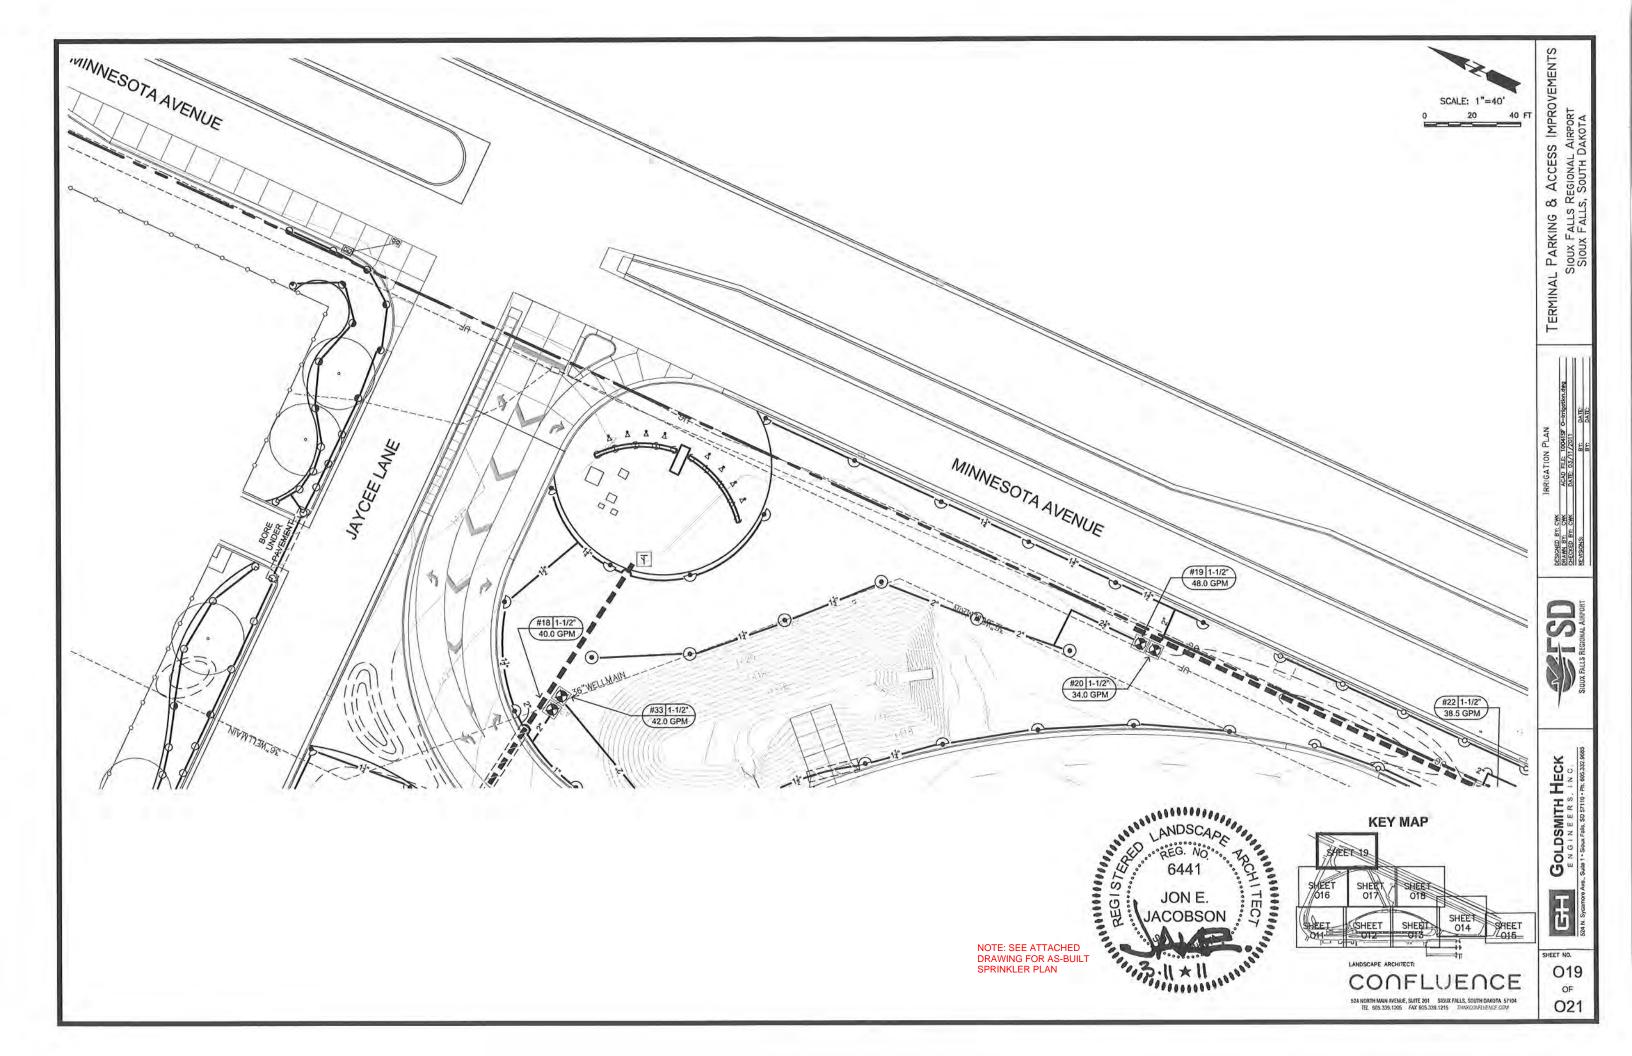


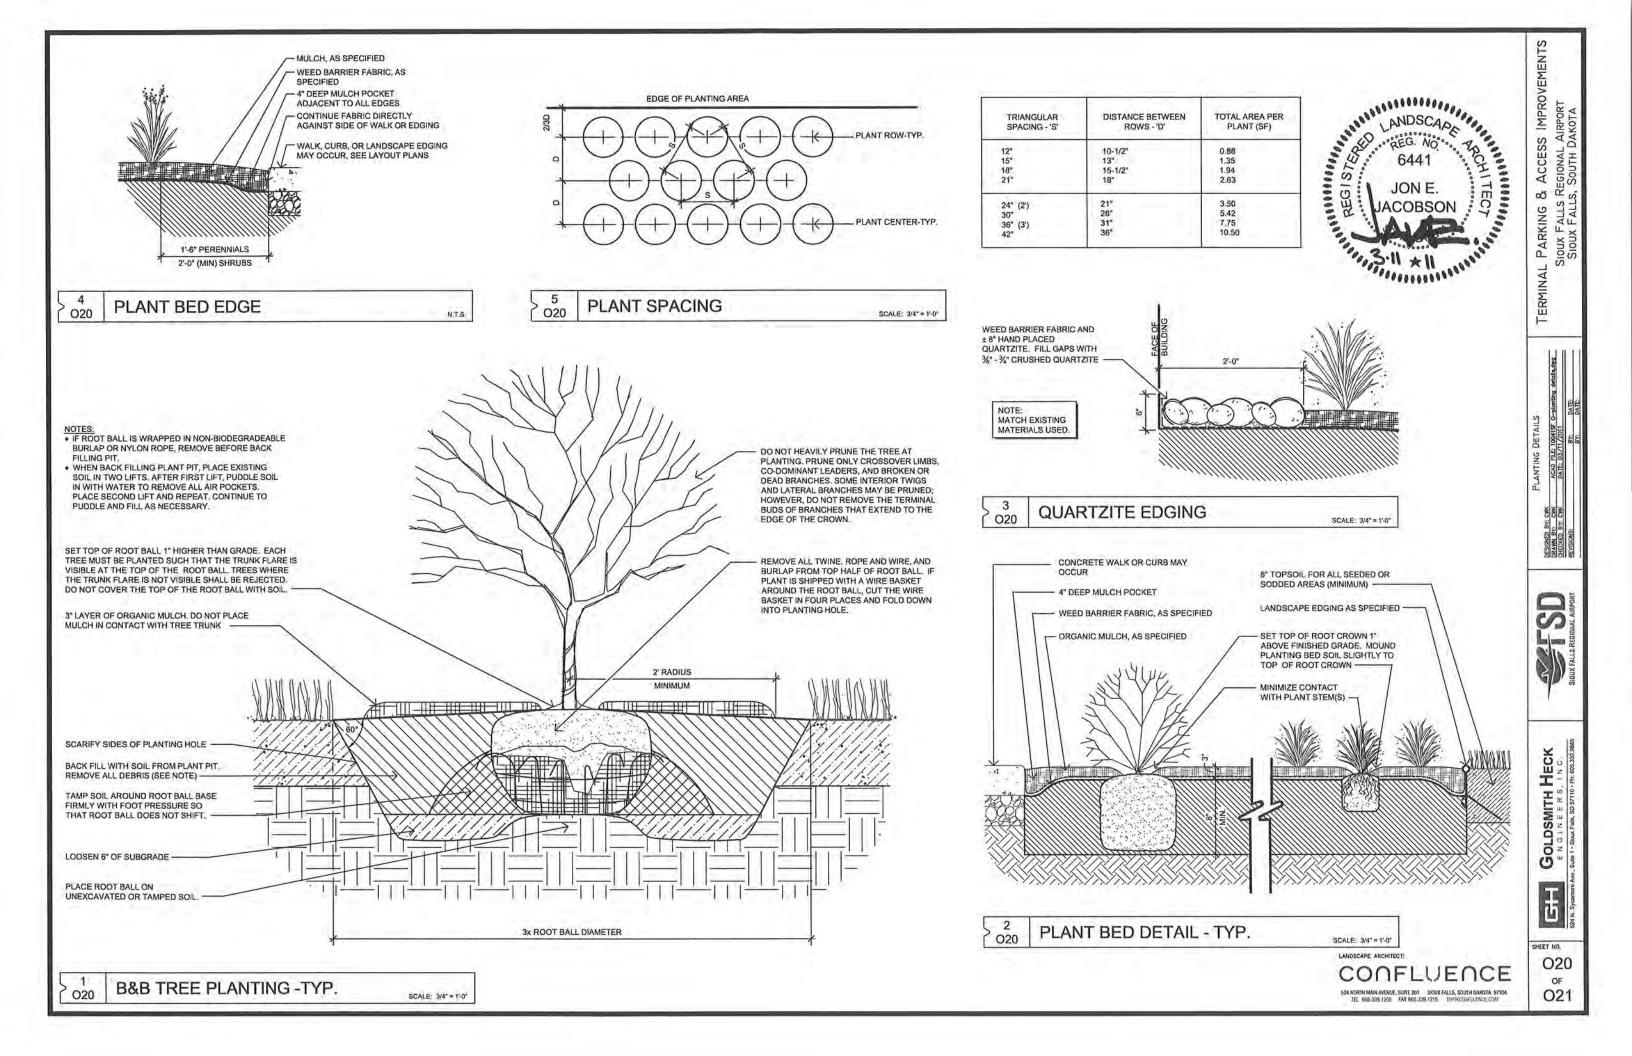


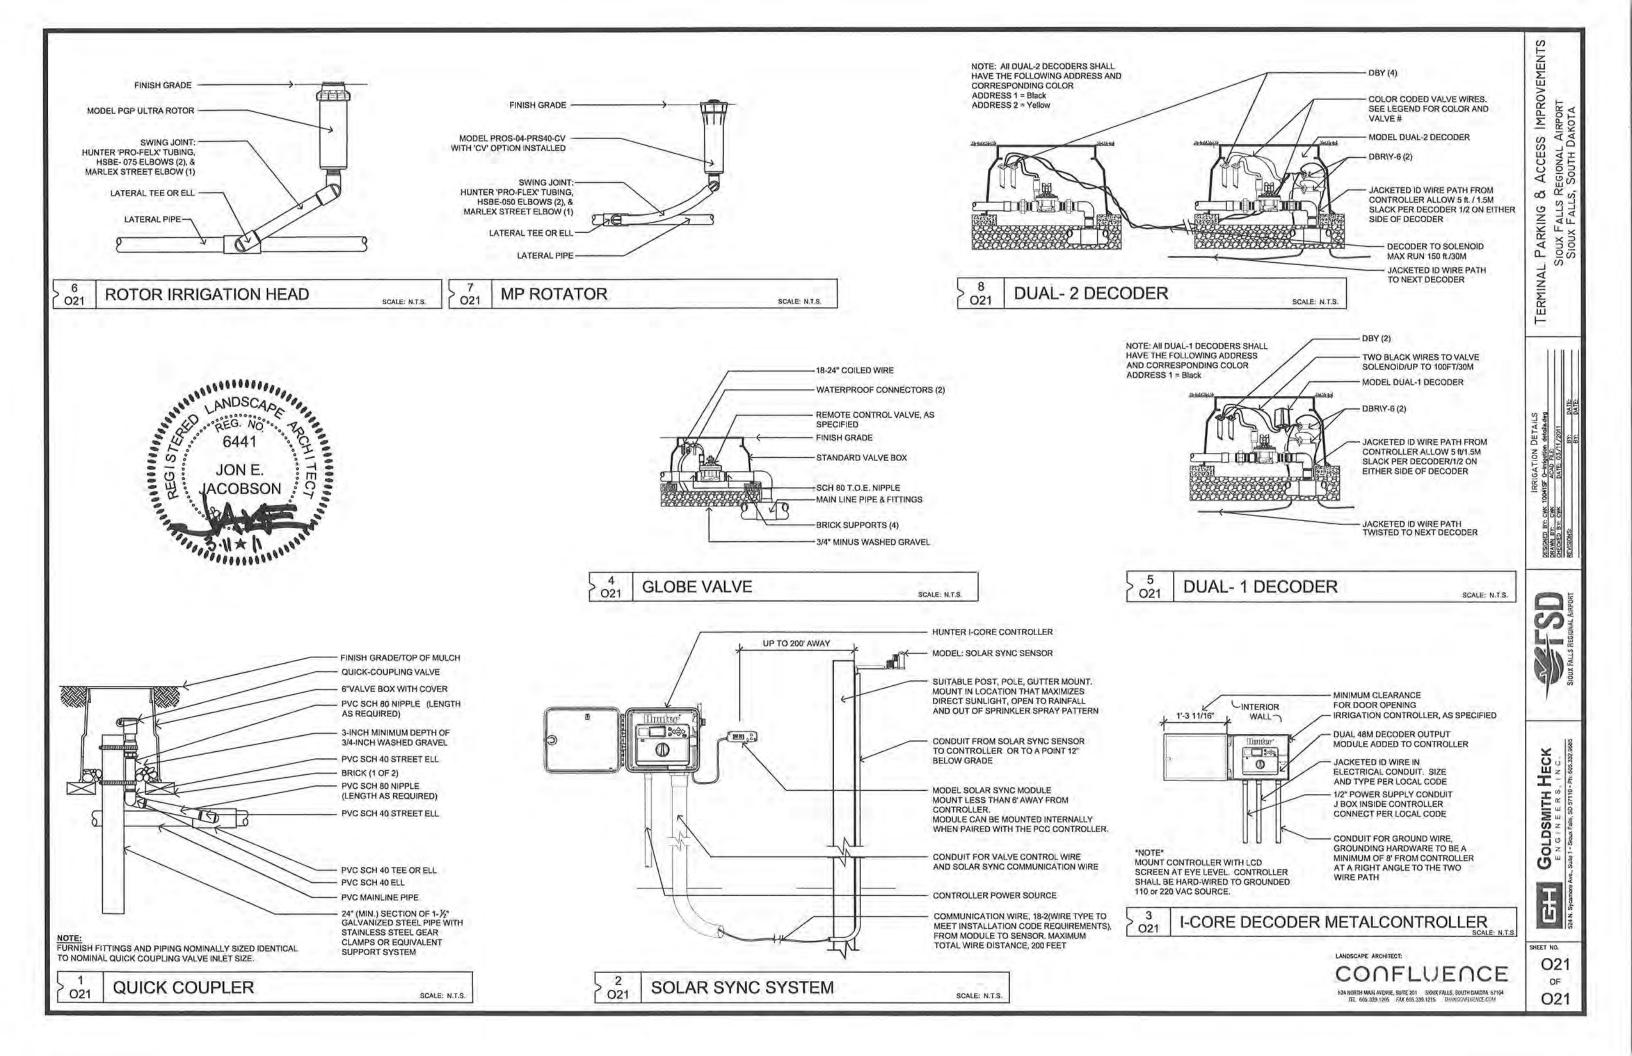


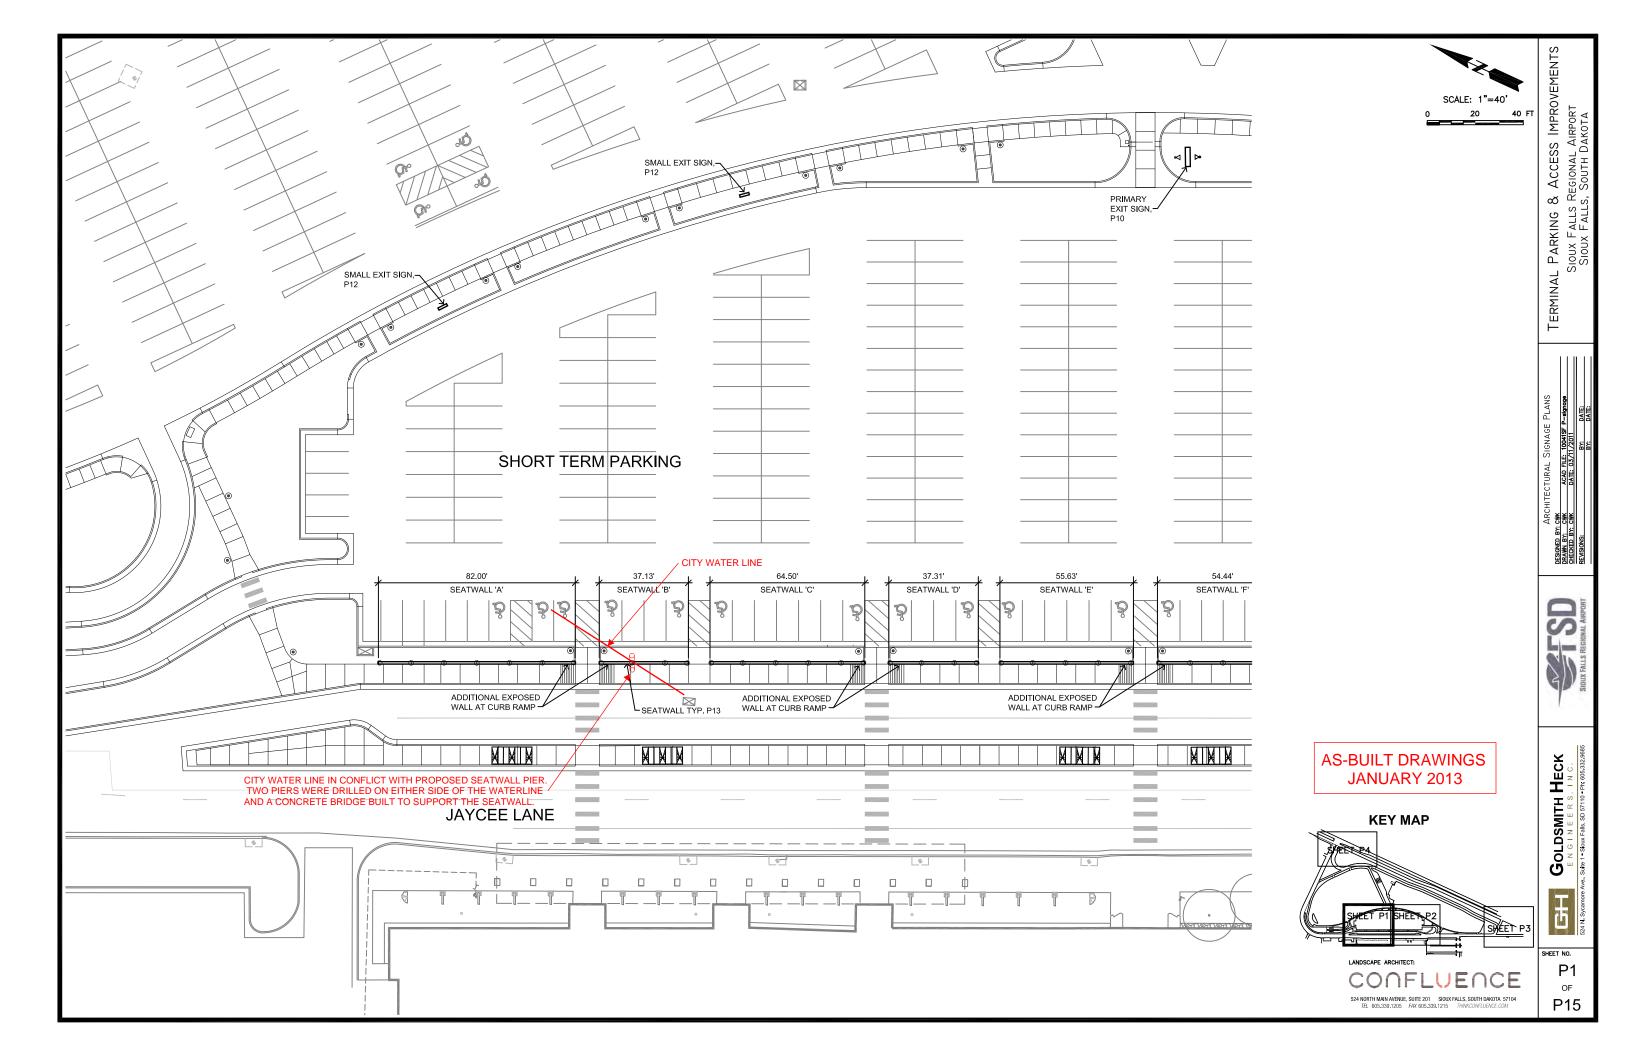


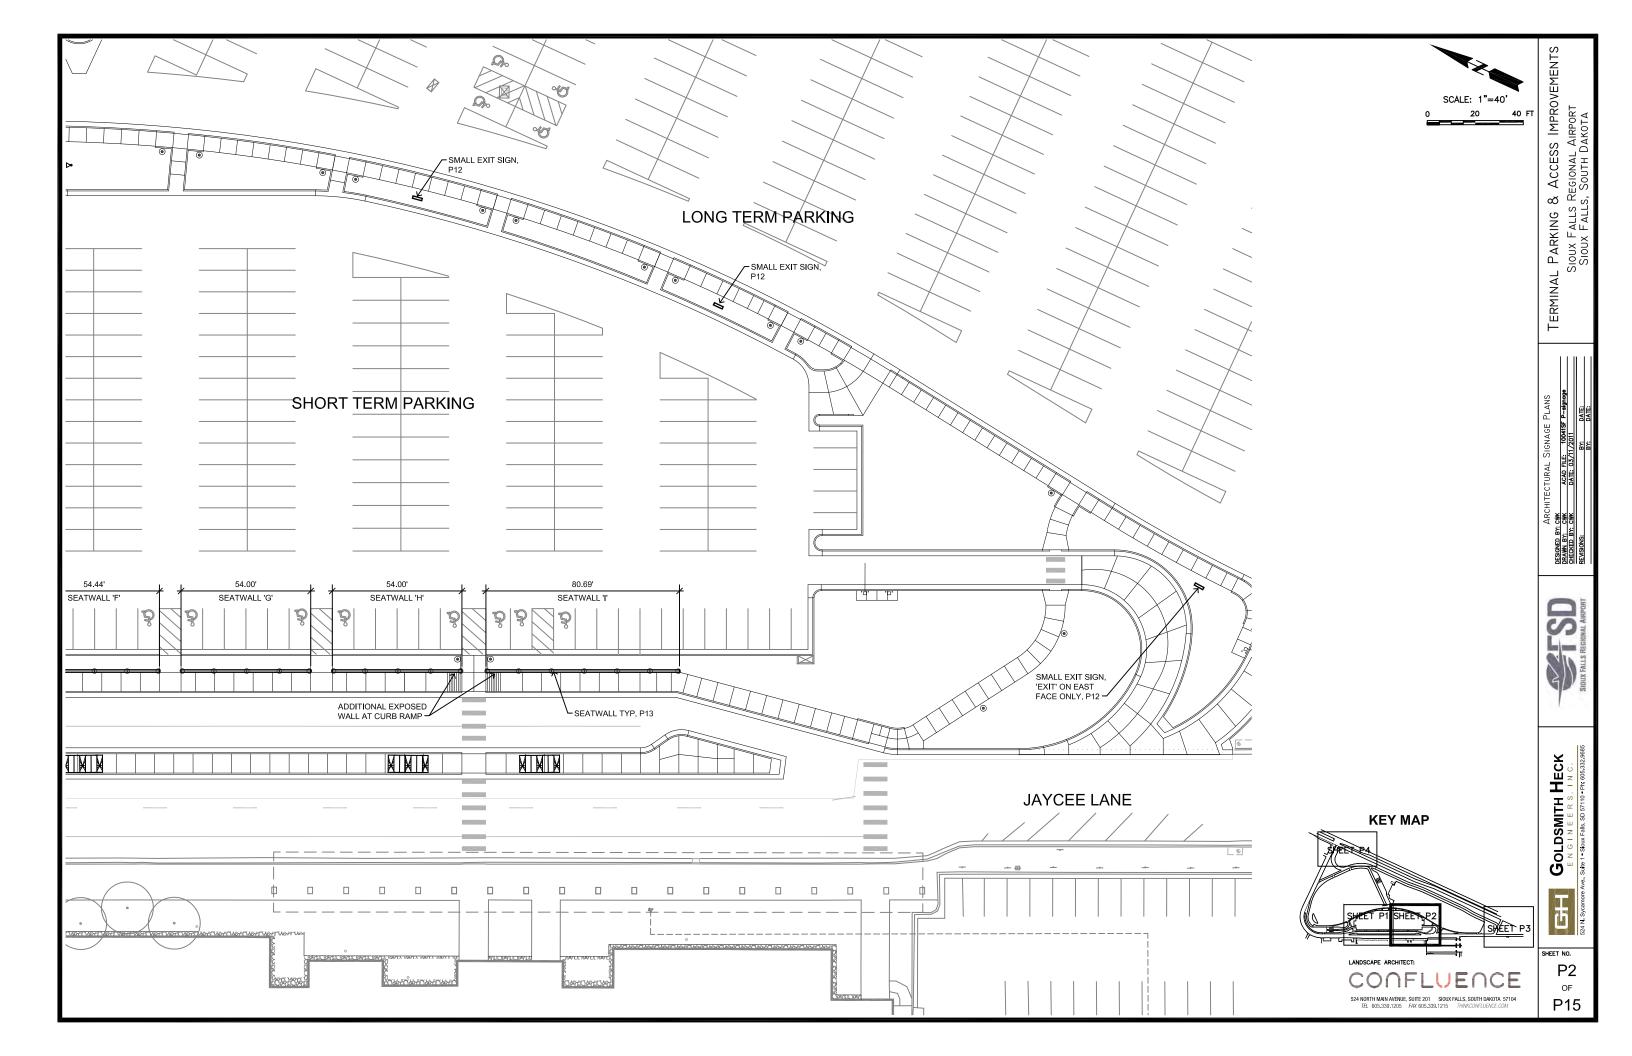


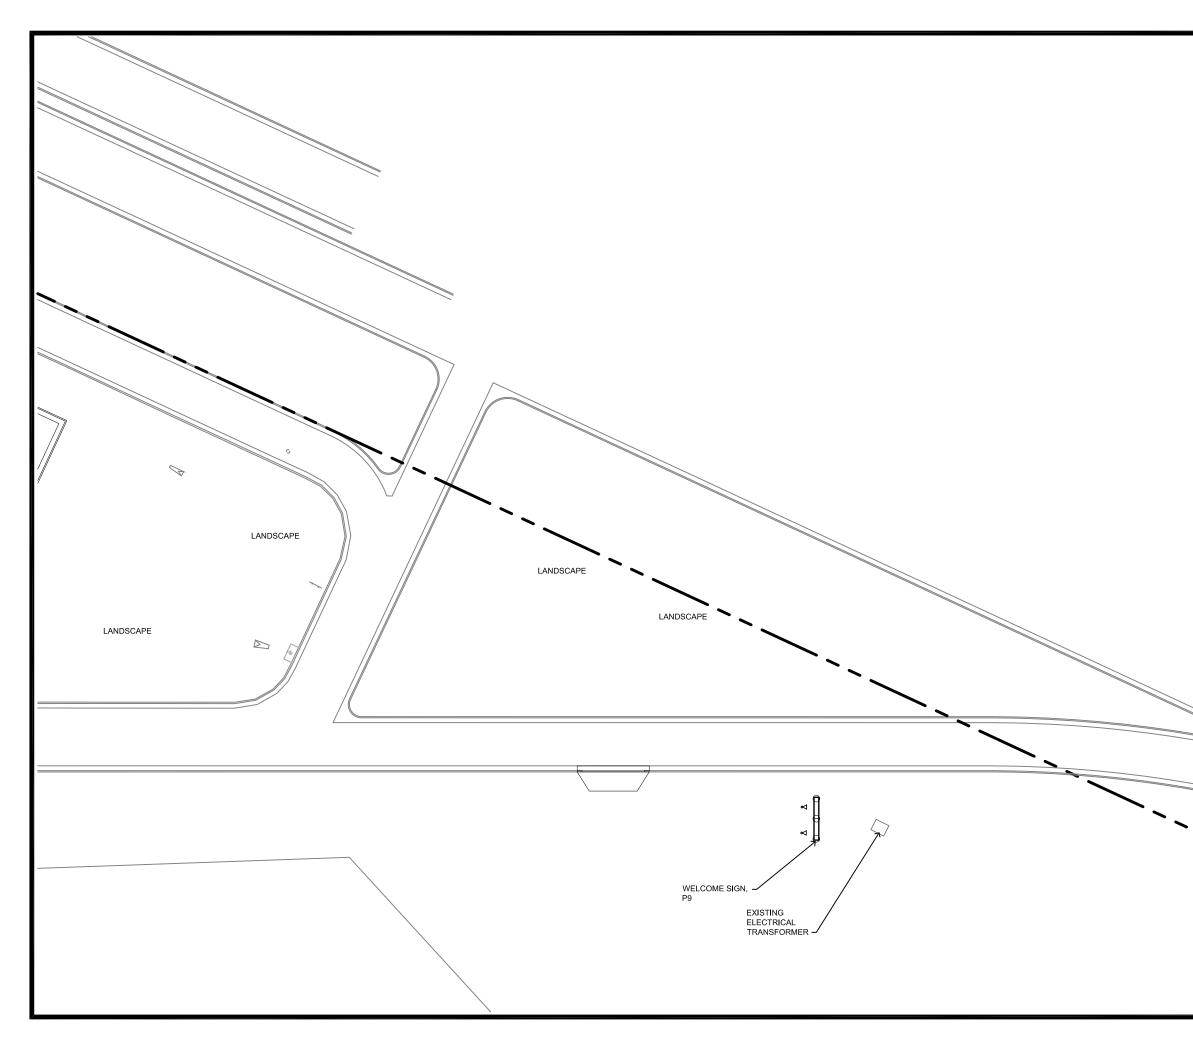


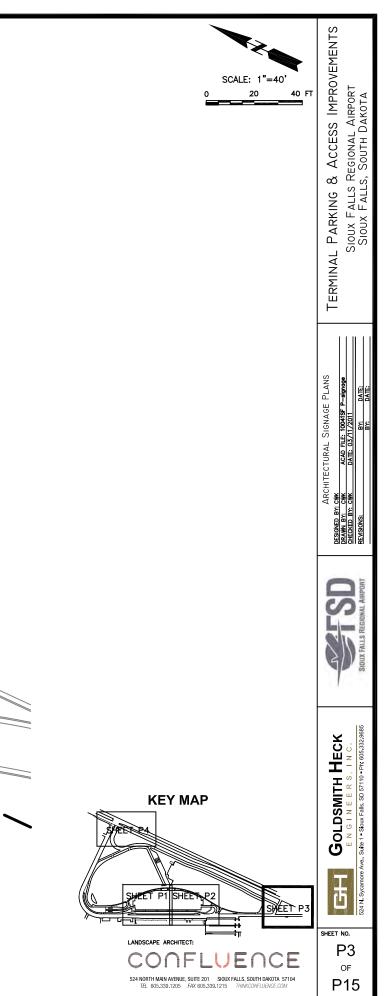

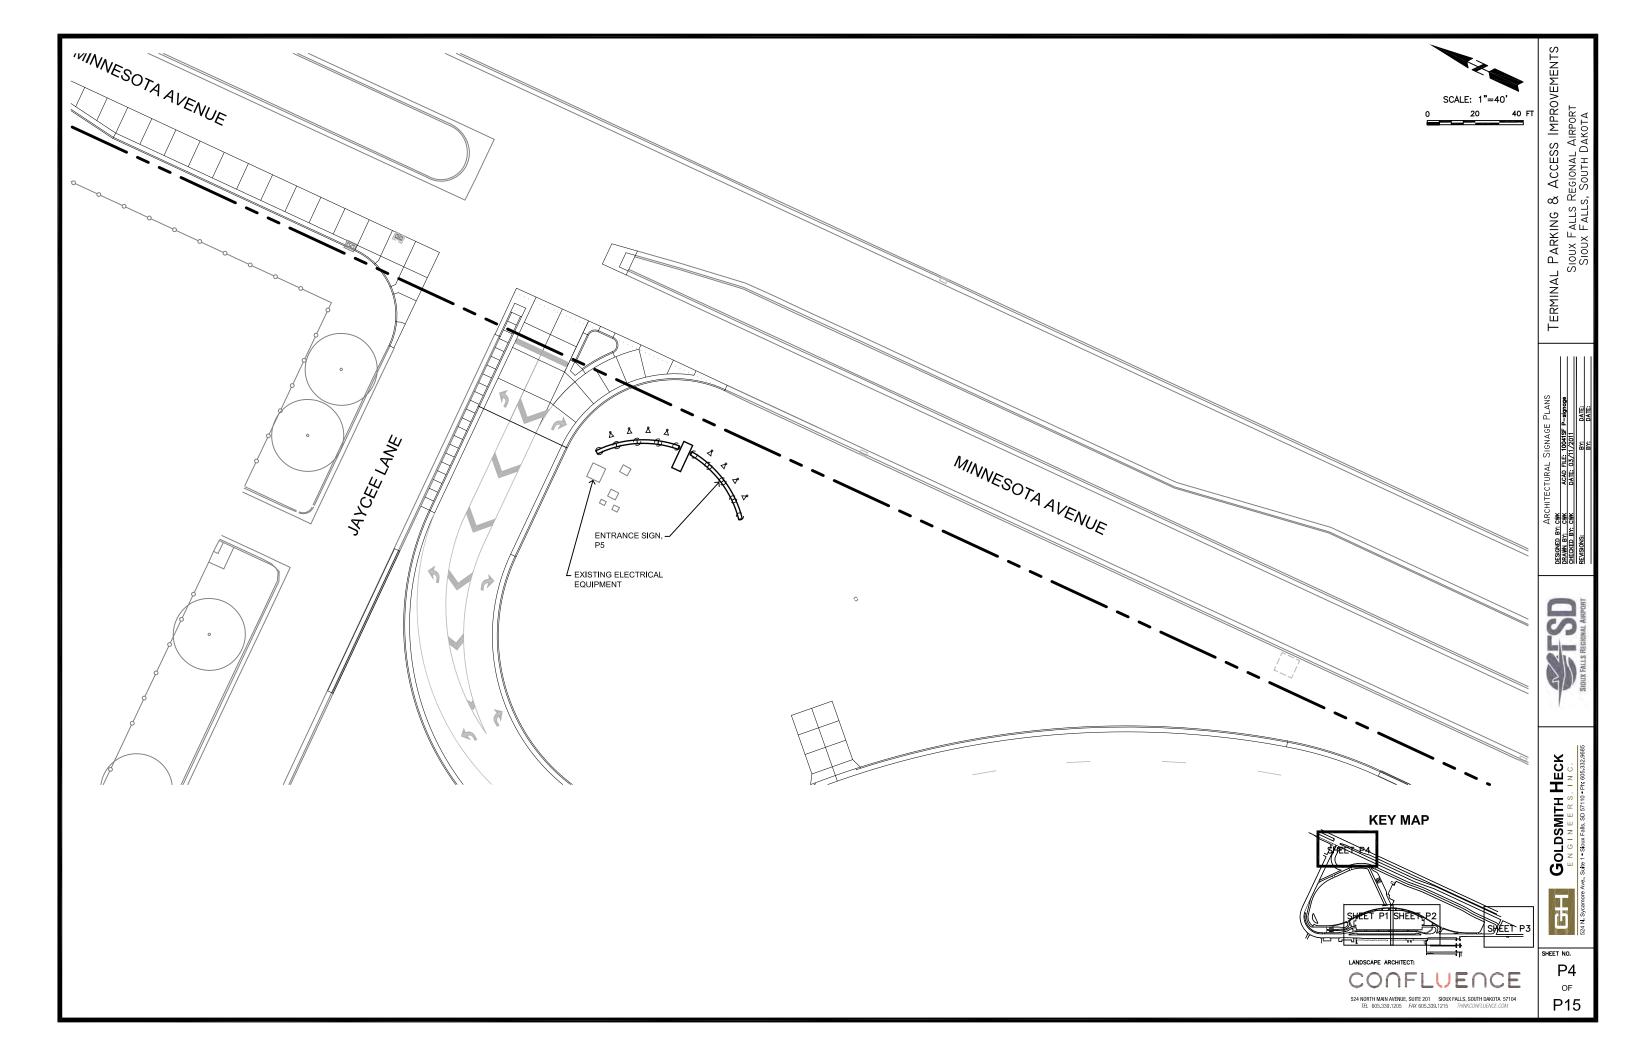


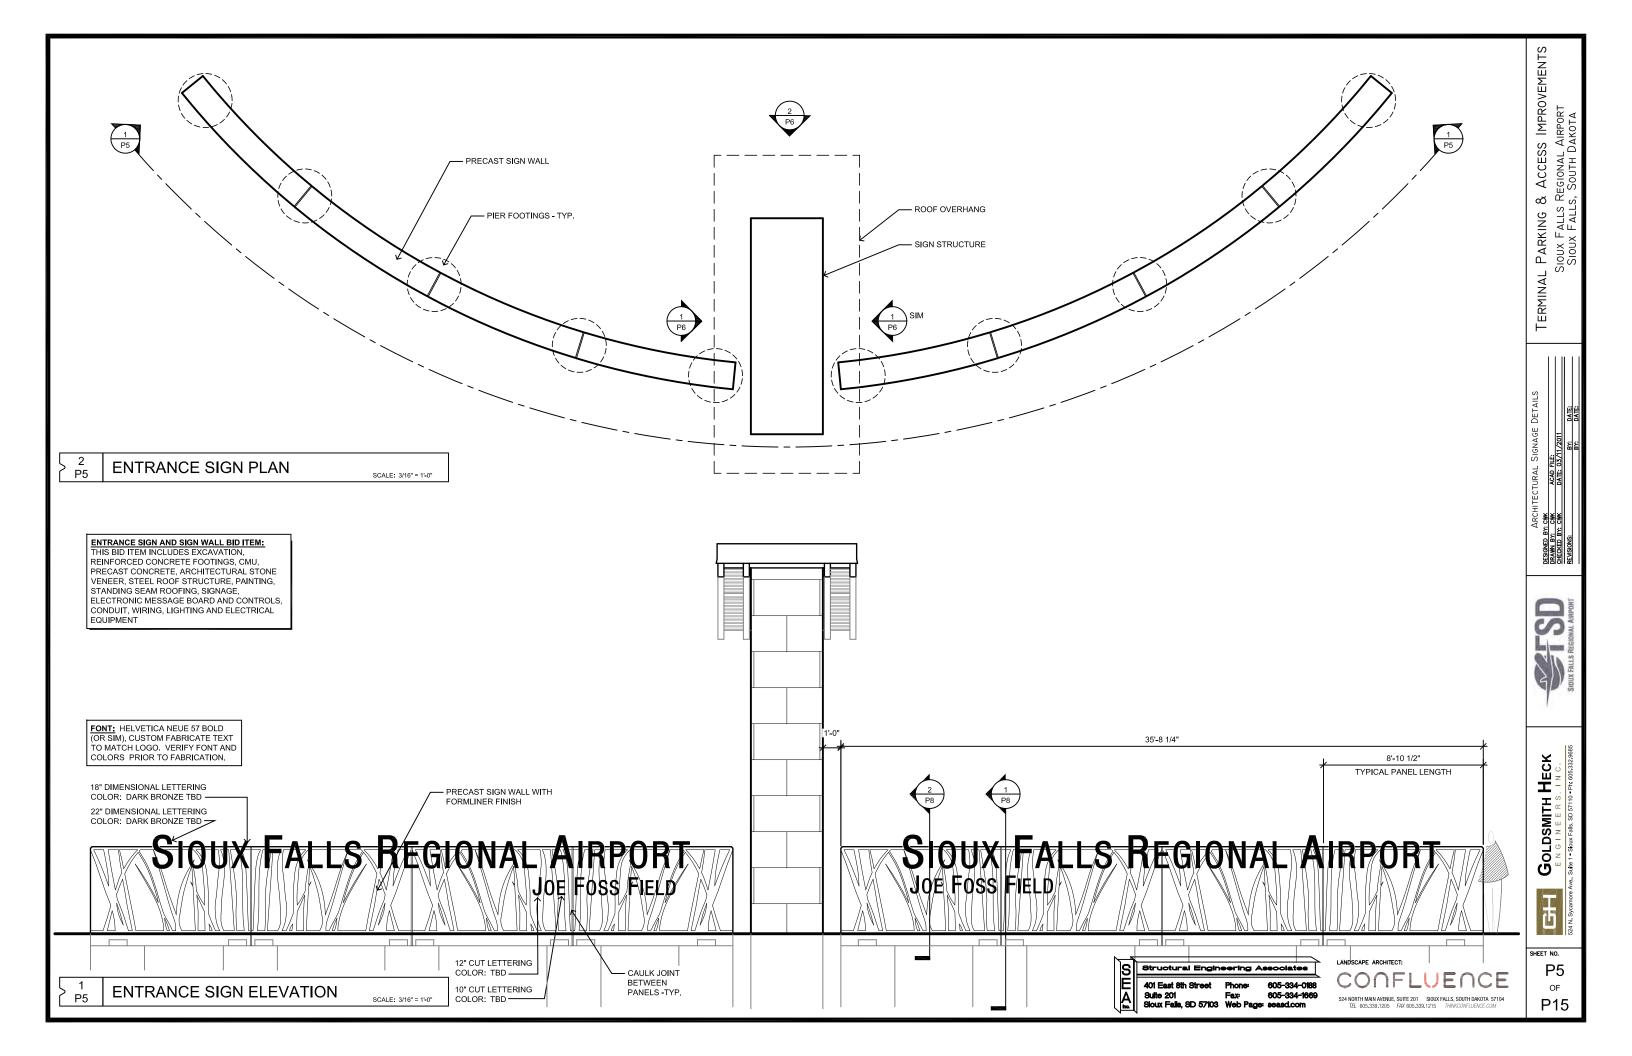


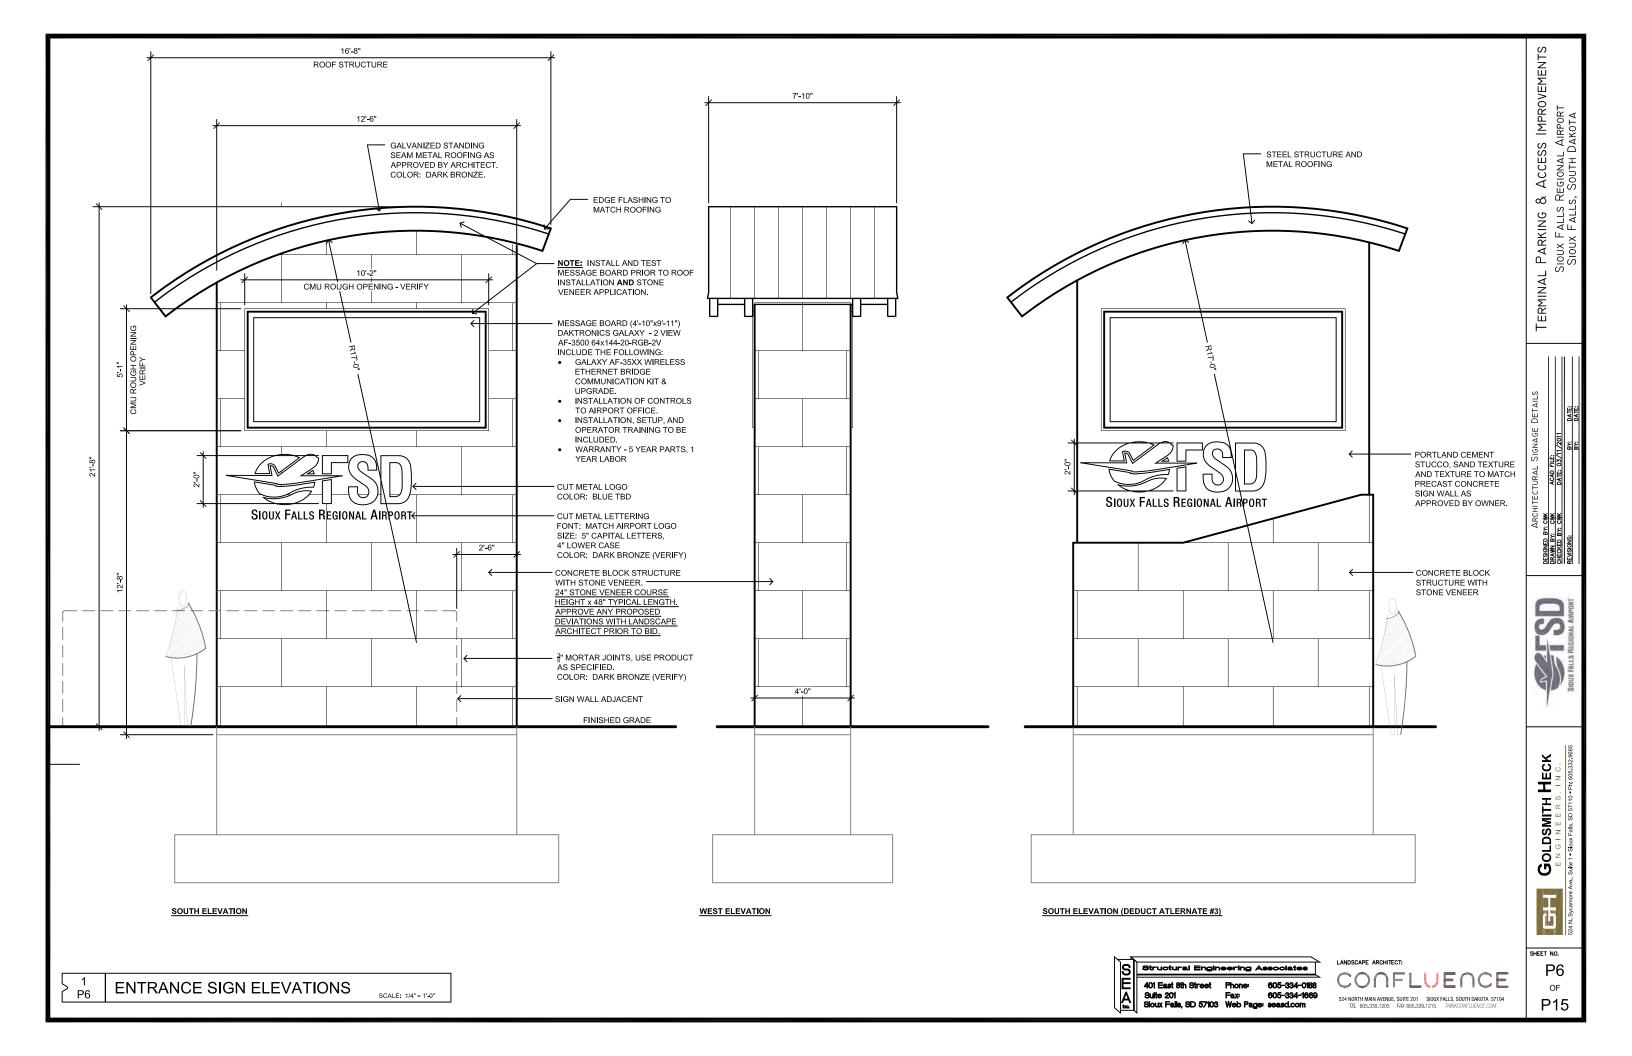


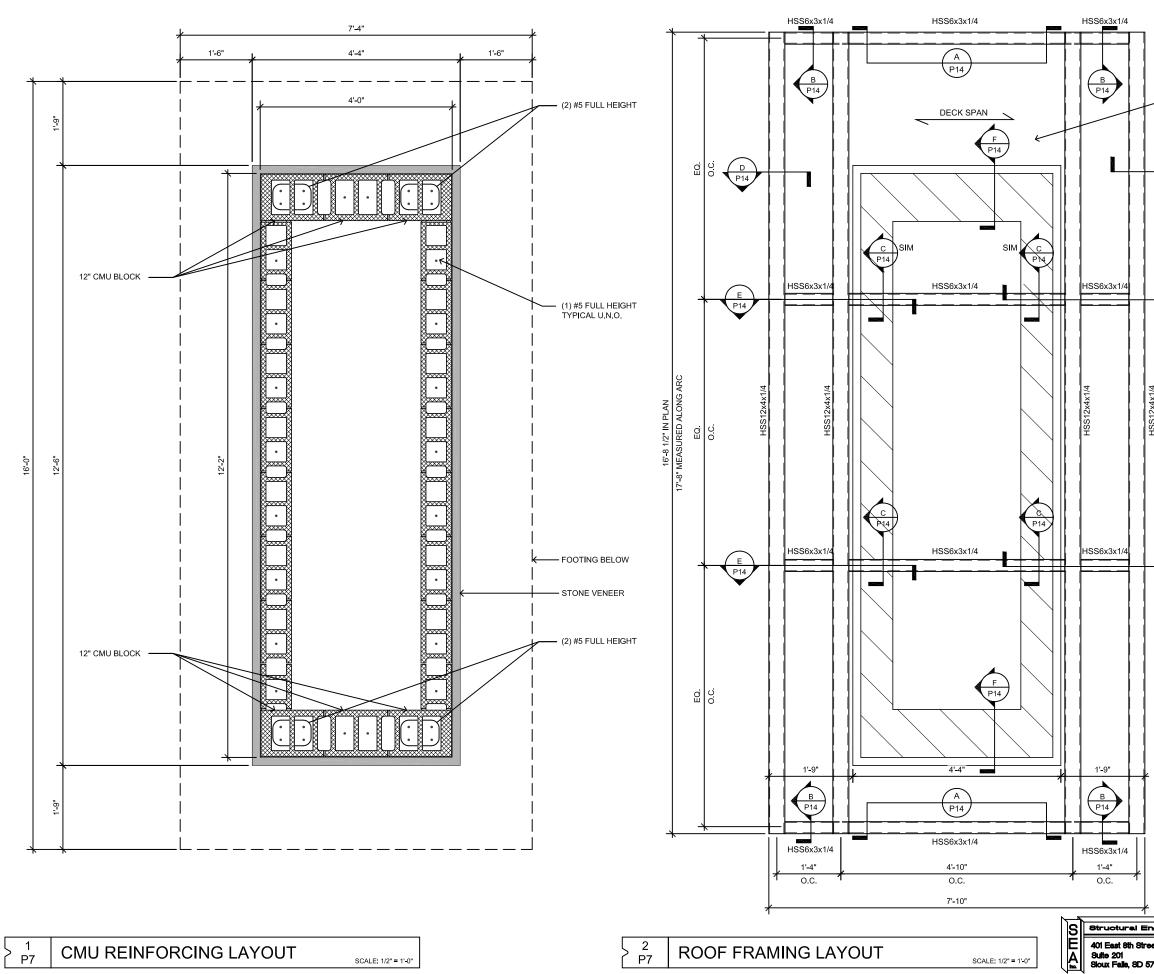



		NTS
		TERMINAL PARKING & ACCESS IMPROVEMENTS SIOUX FALLS REGIONAL AIRPORT SIOUX FALLS, SOUTH DAKOTA
1 1/2" x 22 GA. WIDE DECK 36/7 WELD PA SIDE LAP FASTENEF	ATTERN (2) #10 TEK	- PARKING & ACCESS IMPRO SIOUX FALLS REGIONAL AIRPORT SIOUX FALLS, SOUTH DAKOTA
		<ul> <li>ACCE</li> <li>REGIONA</li> <li>SOUTH</li> </ul>
D P14		KING 8 Falls F x Falls
		AL PAR Sioux Siou:
•		ERMIN
E P14		
		LAILS
HSS12x4x1/4		IGNAGE DETA 11/2011 BY: DATE: BY: DATE:
TSS T		ARCHITECTURAL SIGNAGE DETAILS 2.0#K Actor File: 0.#K bate: 03/11/2011 2.0#K bate: 03/11/2011 8*: 0.4TE:
		<b></b>
		DESIGNED DRAWN BY CHECKED E REVISIONS.
E P14		<b>SB</b> AL AIRPORT
		SIDUX FALLS REGIONAL
		Sinux
		2.9685 2.9685
		<b>FH HECK</b> R s, I N C. 57110 - PH: 605.332.
<u>.</u>		GOLDSMITH ENGINERS, wite 1- Stour Falls, SD 57110-
		GIT GOLDSMITH HECK E N G I N E E R S, I N C. 524 N. Sycamore Ave., Suite 1 - Stour Falls, SD 57110 - Ptr 806.33220685
		524 N. Sycamor
ingineering Associates	LANDSCAPE ARCHITECT:	SHEET NO. P7
Fax: 605-334-1669 57103 Web Page: seasd.com	524 NORTH MAIN AVENUE, SUITE 201 SKOUX FALLS, SOUTH DAKOTA 57104 TEL 605,339,1205 FAX 605,339,1215 THNIKCONFLUENCE.COM	₀⊧ P15

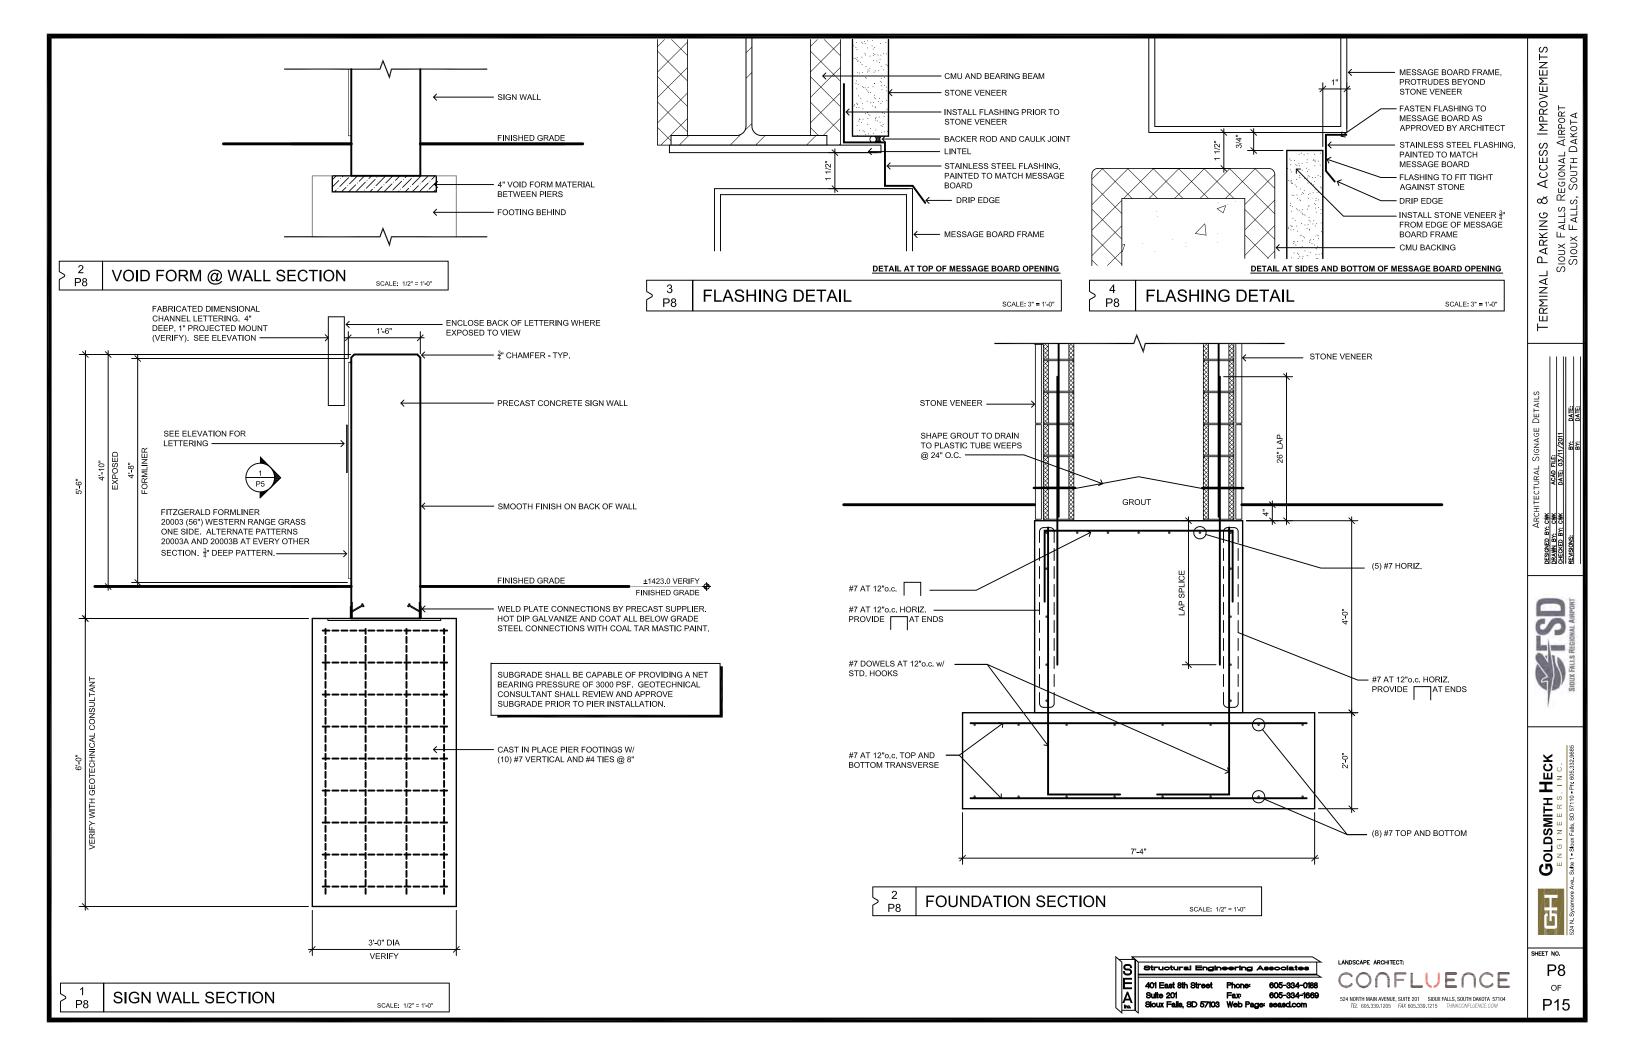


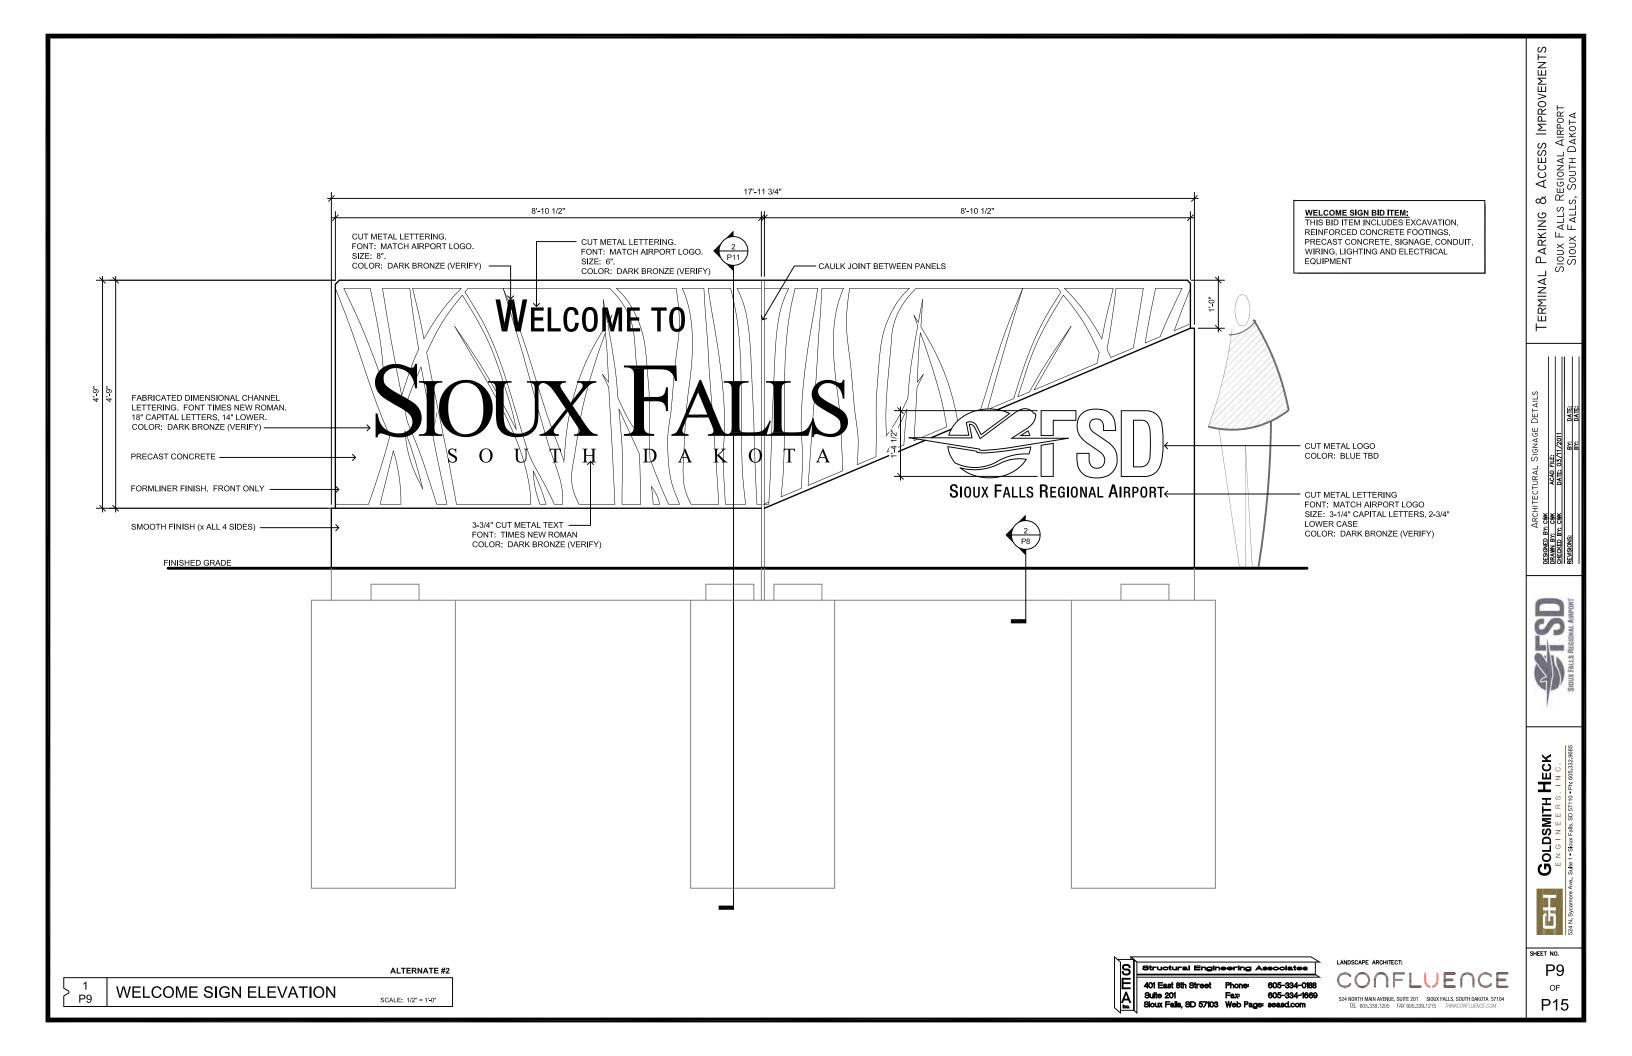


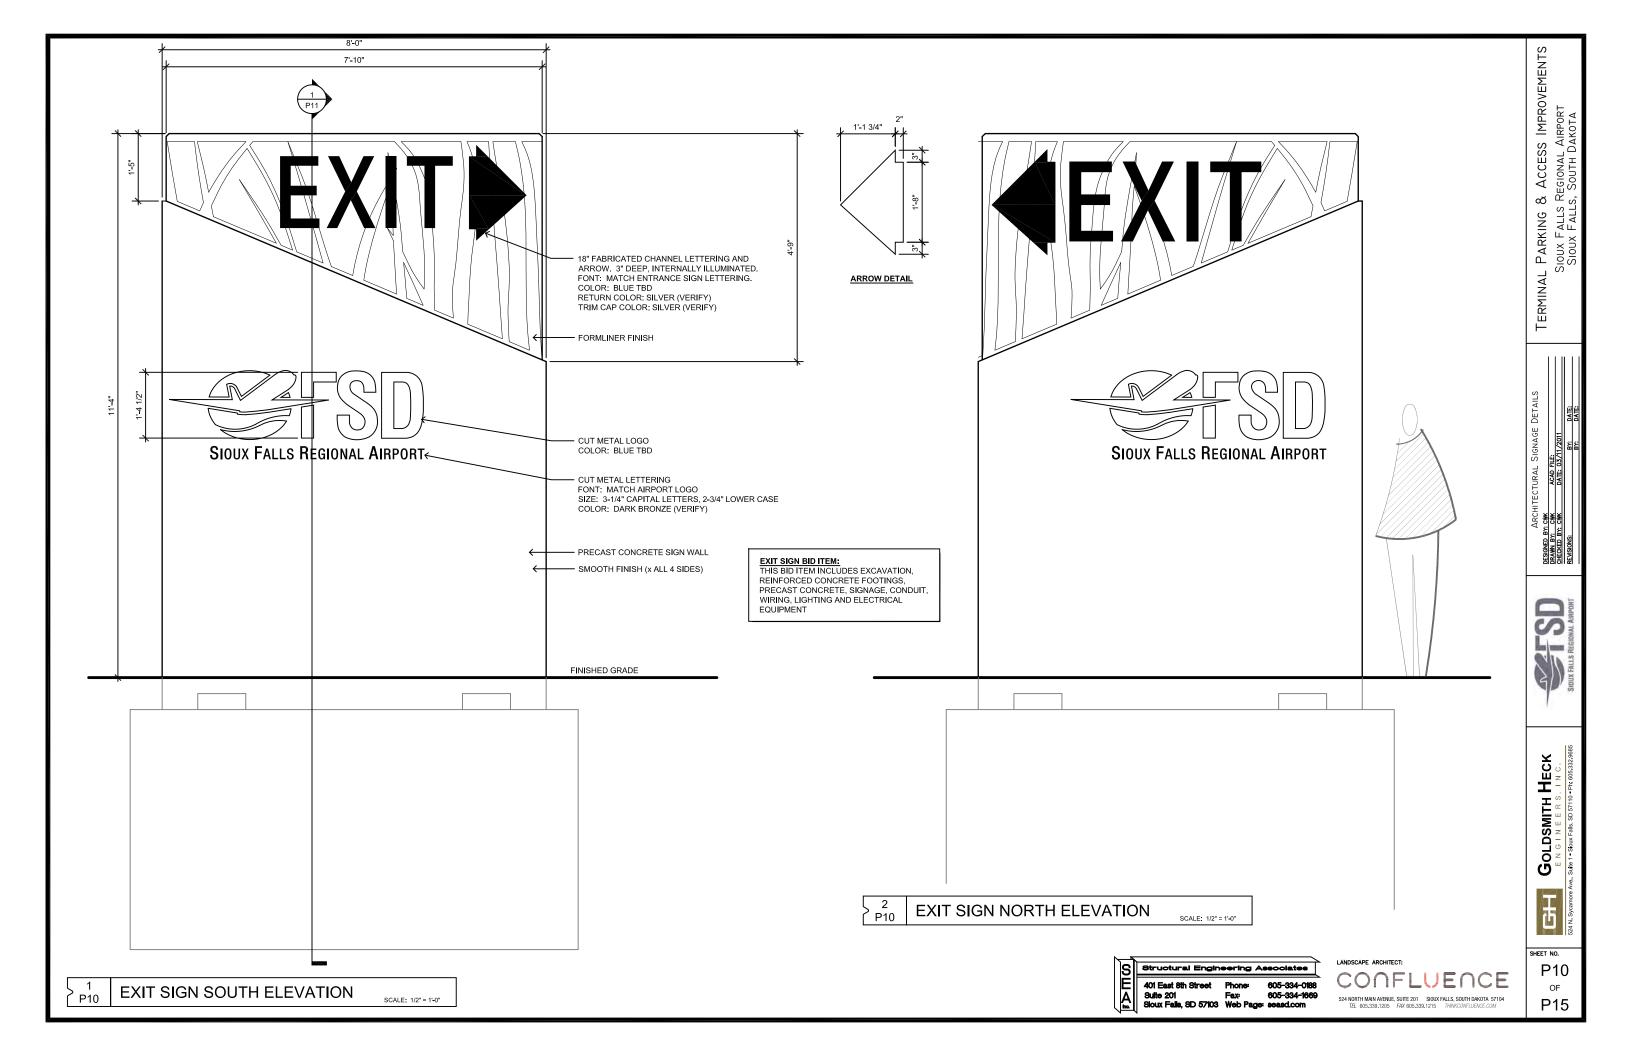

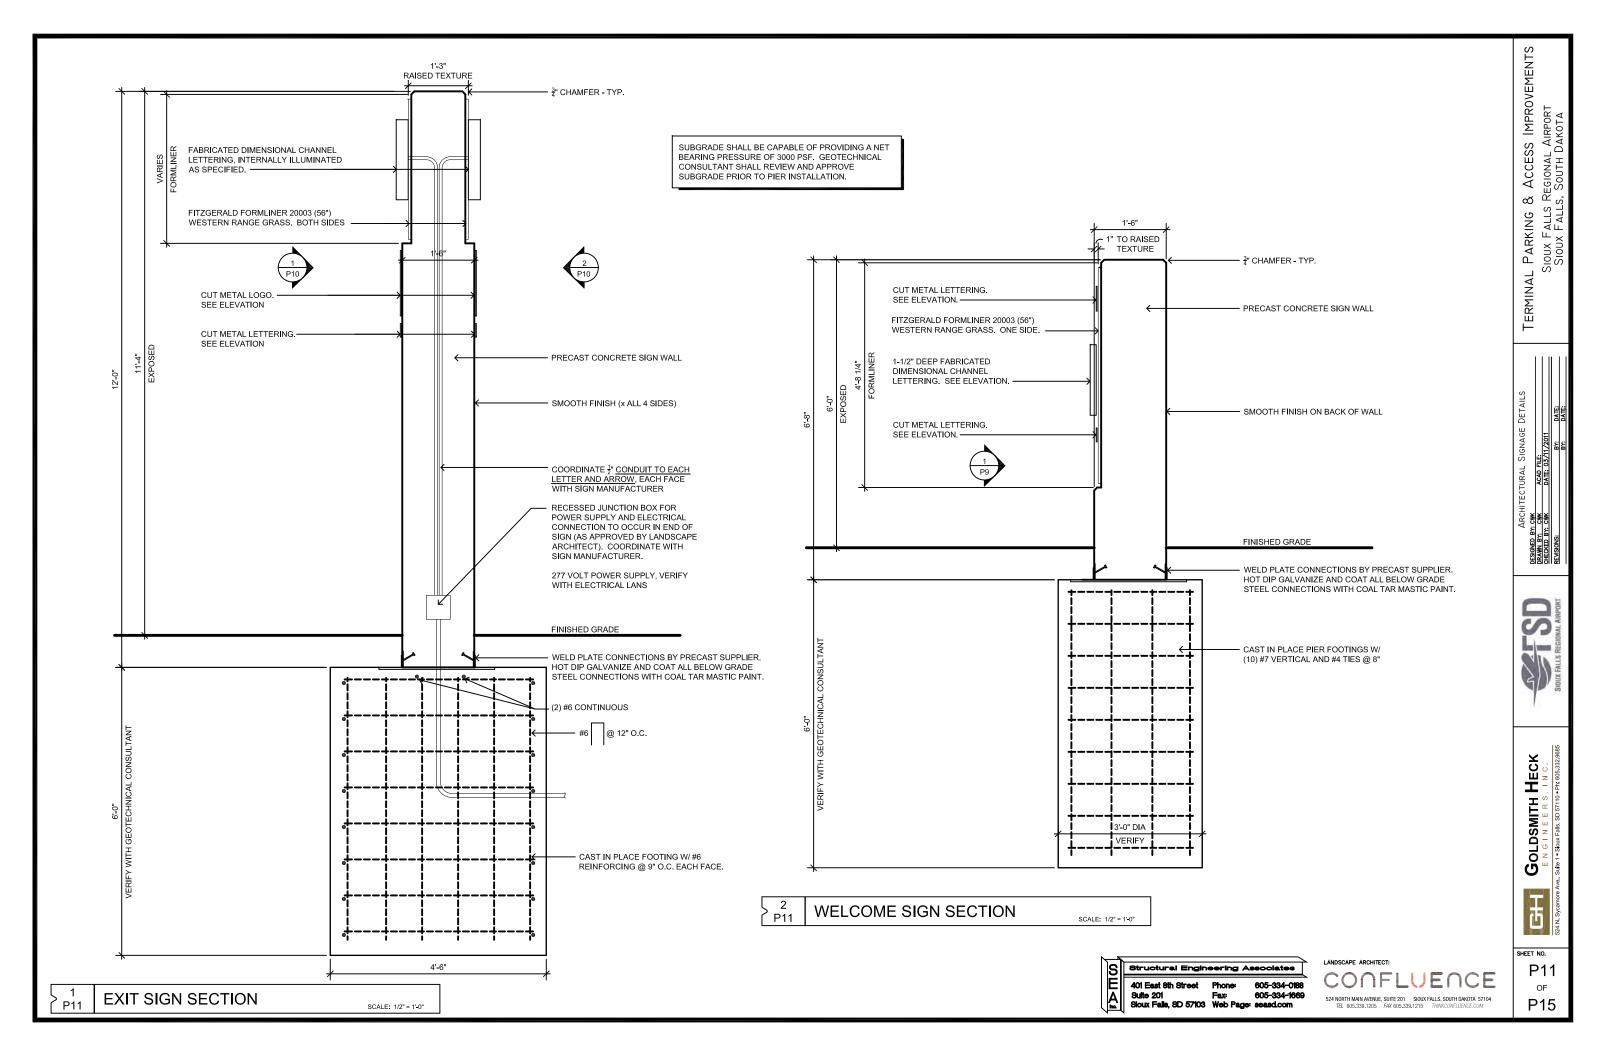

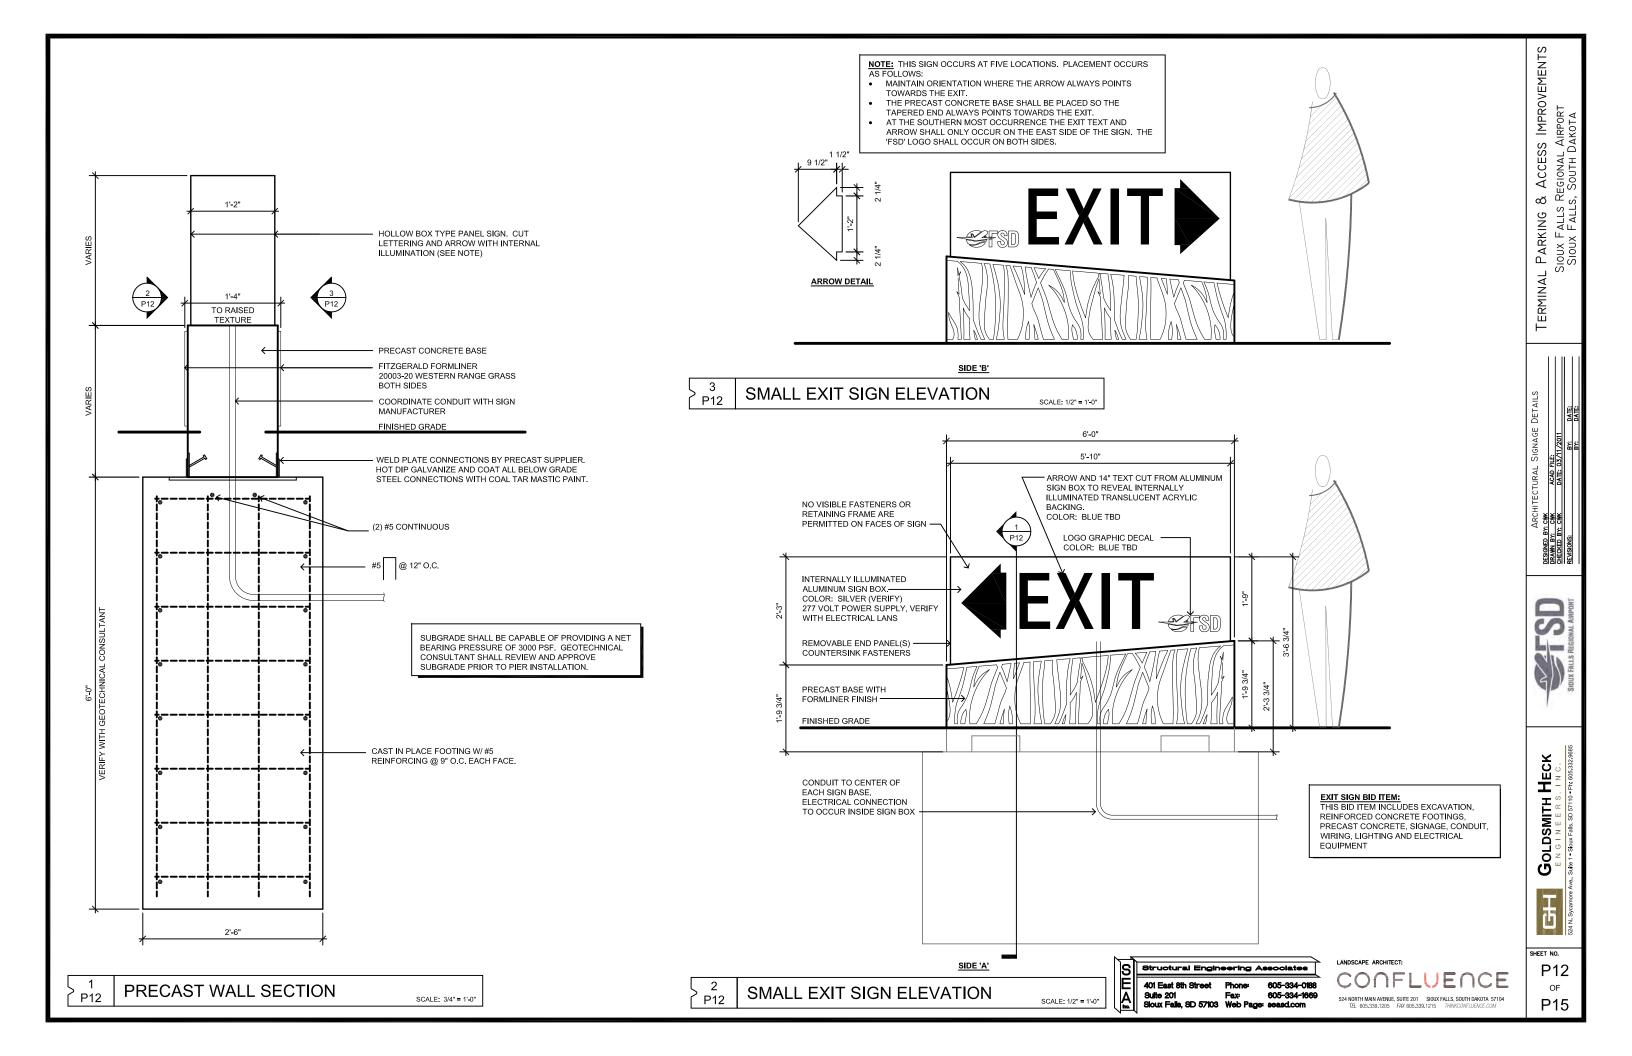

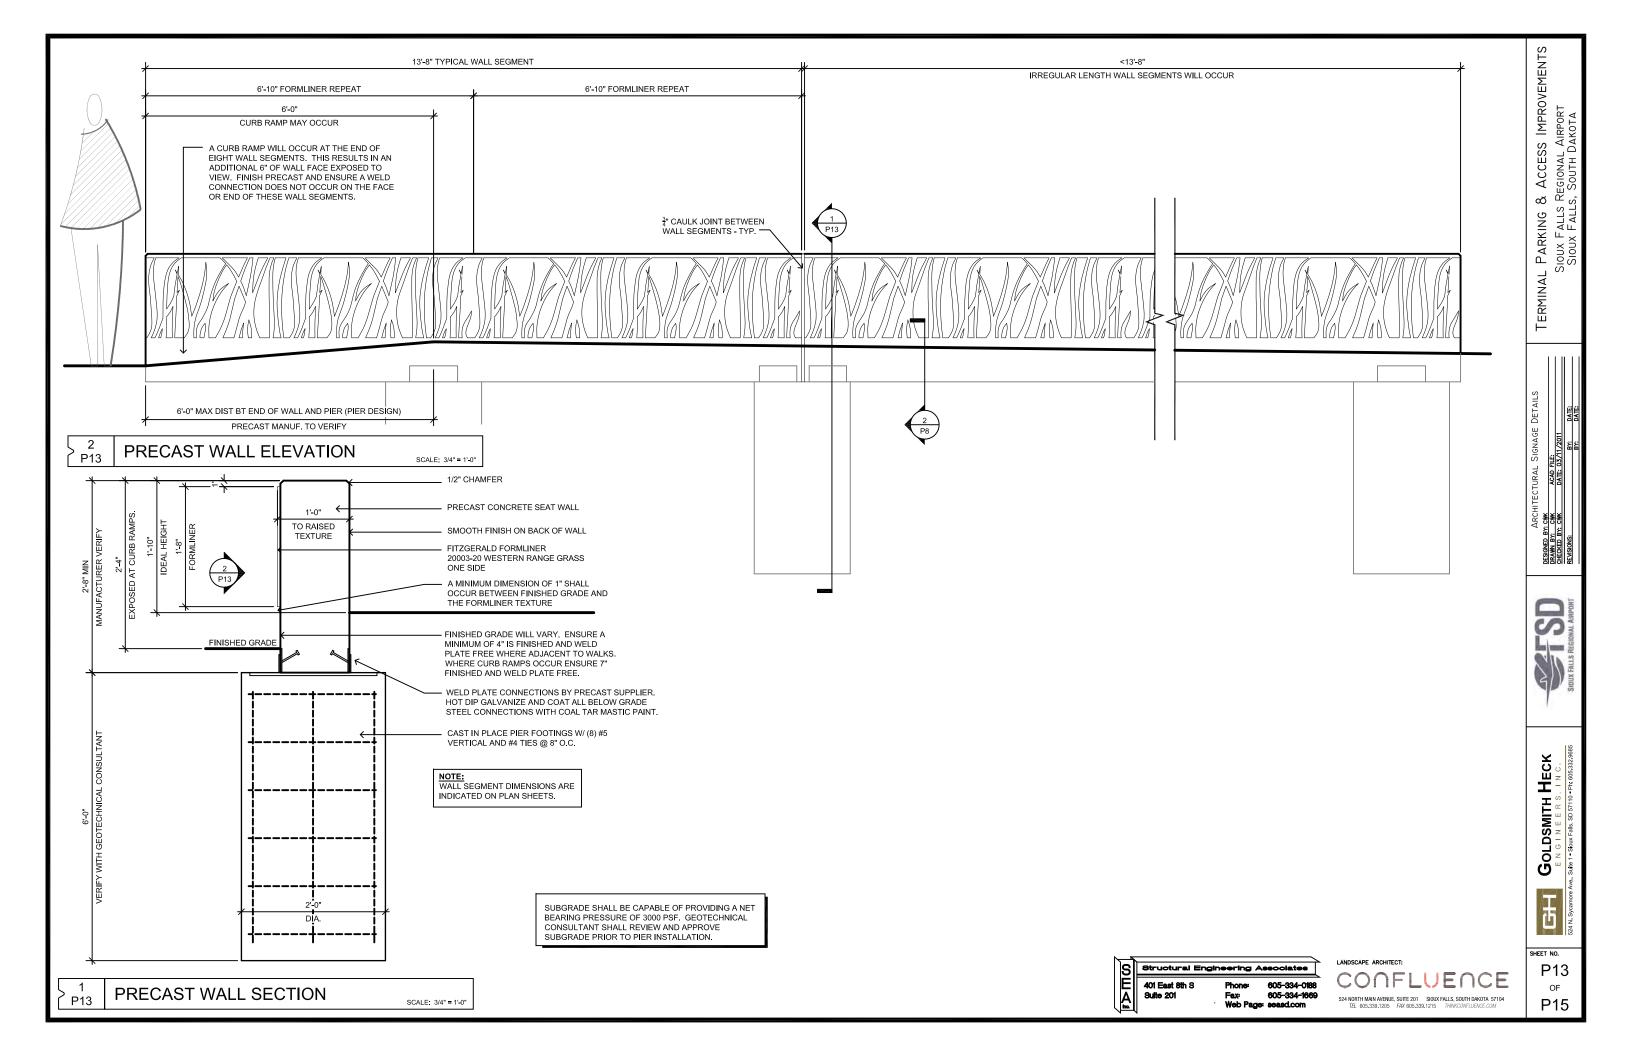

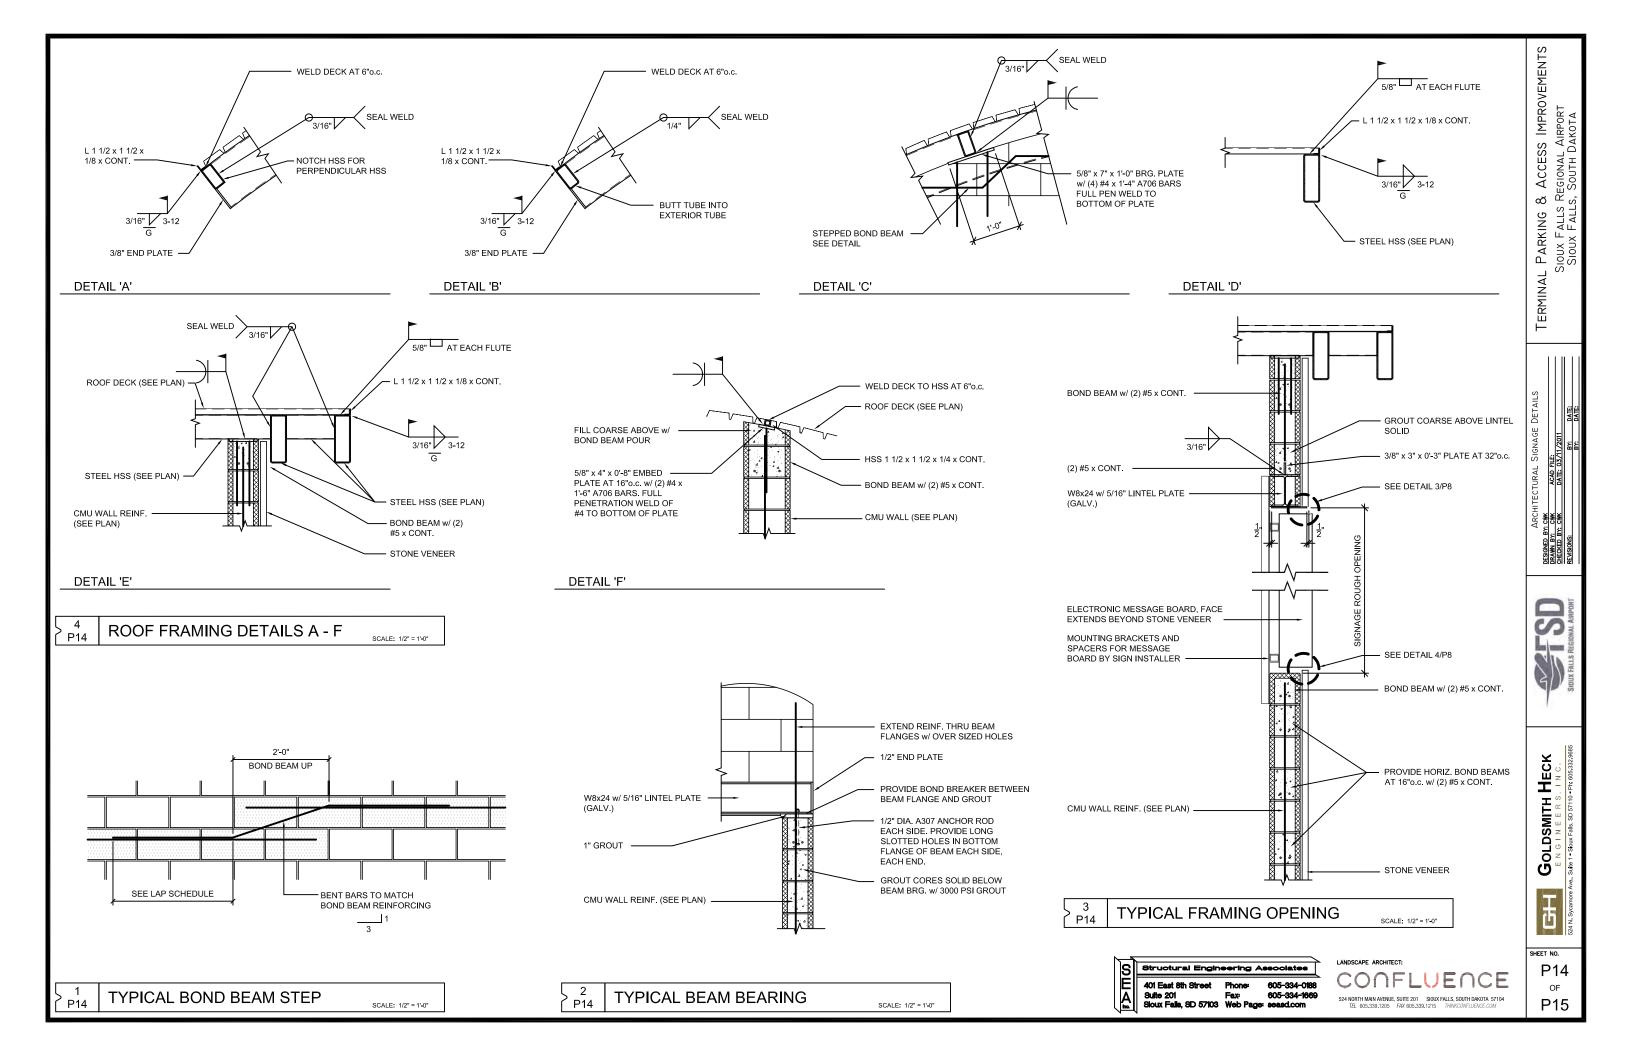

## STRUCTURAL GENERAL NOTES

## INTERNATIONAL BUILDING CODE, 2009

2. BUILDING CODE FOR THE CITY OF SIOUX FALLS, SD

## DESIGN LOADS

- ROOF LOADS
- BASIC LIVE LOAD 20 PSF GROUND SNOW LOAD Pg = 40 PSF SNOW EXPOSURE FACTOR Ce = 1.0 OCCUPANCY CATEGORY II (ASCE 7-05) SNOW LOAD IMPORTANCE FACTOR I = 1.0 THERMAL FACTOR Ct = 1.2 FOR UNHEATED STRUCTURES AND STRUCTURES INTENTIONALLY KEPT BELOW FREEZING. FLAT ROOF SNOW LOAD = PgX0.7CeXIxCt = Pf = 34 PSF PLUS APPLICABLE SLIDING, DRIFTING AND UNBALANCED SNOW LOAD INCREASES
- CONCENTRATED LOADS AS SHOWN IN IBC TABLE 1607.1 SHALL BE ADDED TO THE UNIFORM LOADS SHOWN ABOVE AS APPROPRIATE FOR ITS USE FOR MEMBERS DESIGNED BY SUPPLIERS.
- WIND LOADS BASIC WIND SPEED = 90 MPH OCCUPANCY CATEGORY II (ASCE 7-05) WIND LOAD IMPORTANCE FACTOR = 1.0 WIND EXPOSURE = C
- SEISMIC LATERAL LOADS OCCUPANCY CATEGORY II (ASCE 7-05) SEISMIC IMPORTANCE FACTOR 1.0 MAPPED SPECTRAL RESPONSE COEFFICIENTS SS = 0.11g FOR 0.2 SEC S1 = 0.04g FOR 1.0 SEC SITE CLASS D STIFF SOIL Fa = 1.6 Fv=2.4 SDS = 0.11g X 1.6x 2/3 = 0.1173g FOR 0.2 SEC SD1 = 0.04g X 2.4 X 2/3 = 0.0640g FOR 1.0 SEC

SEISMIC DESIGN CATEGORY A

## MATERIALS GRADES AND STRENGTHS

- CAST-IN-PLACE CONCRETE FOOTINGS AND FOUNDATIONS - F'c = 3000 PSI AT 28 DAYS GROUT - NON METALLIC, SHRINK RESISTANT WITH F'c = 8000 PSI AT 28 DAYS
- MASONRY 2 CONCRETE MASONRY UNITS - ASTM C90 TYPE "N-1" CONCRETE MASONRY MORTAR - TYPE S MASONRY CORE FILL AND BOND BEAMS - F'c = 3000 PSI AT 28 DAYS
- REINFORCING STEEL BARS - ASTM A615 (GRADE 60) WELDABLE BARS - A706 Fy=60ksi (GRADE 60) WELDED DEFORMED BAR ANCHORS - LENTON OR APPROVED EQUAL WELDED WIRE FABRIC - ASTM A185
- STRUCTURAL STEEL WIDE FLANGE SHAPES - ASTM A992 (Fv=50 KSI) PLATES AND OTHER SHAPES - ASTM A36 (Fy=36 KSI) STRUCTURAL TUBES - ASTM A500, GRADE B (Fy=46 KSI) ANCHOR BOLTS/RODS - ASTM F1554-S1 GR 55 YELLOW (WELDABLE)TYPICAL ASTM F1554 GR 36 BLUE (AT NOTED LOCATIONS) ASTM A307 (AT NOTED LOCATIONS) ASTM A36 THREADED RODS(AT NOTED LOCATIONS) EXPANSION BOLTS - HILTI KWIK BOLT 3

### GENERAL

- 1. THE INFORMATION SHOWN ON THE STRUCTURAL DRAWINGS IS NOT TO BE SCALED, AS THE ITEMS SHOWN MAY NOT BE TO SCALE FOR THE SPECIFIC LOCATION.
- 2. NO OPENINGS OR SLEEVES SHALL BE CUT OR PROVIDED IN WALLS OR FLOOR CONSTRUCTION WITHOUT
- EXAMINE ARCHITECTURAL, MECHANICAL, PLUMBING AND ELECTRICAL DRAWINGS TO DETERMINE LOCATION AND DIMENSIONS OF CHASES, INSERTS, OPENINGS, SLEEVES, REVEALS, DEPRESSIONS AND OTHER PROJECT REQUIREMENTS NOT SHOWN ON STRUCTURAL DRAWINGS.
- BEFORE FABRICATION AND ERECTION OF ANY MATERIALS, FIELD VERIFY ALL EXISTING ELEVATIONS, DIMENSIONS AND CONDITIONS AS SHOWN ON THE DRAWINGS AND REPORT ANY DISCREPANCIES TO THE ARCHITECT/ENGINEER AT ONCE FOR RESOLUTION
- 5. STRUCTURAL MEMBERS INCLUDING JOISTS, SLABS, BEAMS, TRUSSES, COLUMNS AND WALLS ARE DESIGNED FOR "IN PLACE" LOADS, CONTRACTOR IS RESPONSIBLE FOR BRACING, WITHOUT OVERSTRESSING, ALL STRUCTURAL ELEMENTS (AS REQUIRED AT ANY STAGE OF CONSTRUCTION) UNTIL COMPLETION OF THIS PROJECT

#### FOUNDATIONS

- FOOTINGS HAVE BEEN DESIGNED FOR A MAXIMUM SOIL BEARING PRESSURE OF 3000 PSF. REFERENCE AMERICAN ENGINEERING TESTING, INC. REPORT NO. 32-00250 DATED 12.14.2010. IF THE SOIL AT THE FOOTING ELEVATIONS SHOWN IS OF QUESTIONABLE BEARING VALUE, NOTIFY THE ARCHITECT/ ENGINEER AT ONCE FOR RESOLUTION.
- TESTING SERVICE MUST INSPECT AND APPROVE SUBGRADES AND FILL LAYERS BEFORE FURTHER CONSTRUCTION WORK IS PERFORMED THEREON. NOTIFY TESTING SERVICE PRIOR TO PROCEEDING WITH PLACEMENT OF FOOTINGS, FILL, OR OTHER CONSTRUCTION OVER SUBGRADES AND FILL.
- WATER SHALL NOT BE PERMITTED TO POND IN FOOTING EXCAVATION. KEEP EXCAVATION DRY. FAILURE TO DO SO WILL BE CAUSE FOR REQUIRING CONTRACTOR TO REMOVE WATER DAMAGED SOILS AND REPLACE WITH CONTROLLED FILL AS DIRECTED.

- 4. SHOULD ANY QUESTIONABLE CONDITIONS BE ENCOUNTERED DURING EXCAVATION NOTIFY A/F IMMEDIATELY FOOTING ELEVATIONS ARE SUBJECT TO CHANGE DEPENDING ON SOIL CONDITIONS ENCOUNTERED.
- 5 REMOVE ANY ABANDONED SEWER OR SERVICE LINE ENCOUNTERED DURING EXCAVATION WITHIN THE BUILDING LINES. SHOULD SUCH LINES BE FOUND BELOW OR ADJACENT TO FOOTING LOCATIONS. NOTIFY THE A/E.
- ALL FOOTINGS SHALL BE CENTERED UNDER WALLS. NO OFFSETS SHALL BE PERMITTED.
- 7. WHERE FILL MATERIAL IS PLACED ON BOTH SIDES OF GRADE BEAMS OR WALLS. IT SHALL BE PLACED IN LAYERS ALTERNATELY ON OPPOSITE SIDES TO MAINTAIN LEVELS THAT WILL AVOID DISPLACEMENT OF, OR DAMAGE TO, THE WALLS OR BEAMS.
- 8. WHERE FILL MATERIAL IS PLACED ON ONE SIDE OF A WALL, THE WALL SHALL BE ADEQUATELY SHORED AND BRACED OR THE MATERIAL SHALL NOT BE PLACED UNTIL SUPPORTING FLOOR SLABS HAVE BEEN POURED AND
- 9. NO FILL OR BACKFILL SHALL BE "SETTLED" BY THE USE OF WATER.
- 10. PROVIDE A MINIMUM SIX INCHES OF DRAINAGE FILL BELOW ALL INTERIOR FLOOR SLABS.
- 11. IF CONSTRUCTION IS ANTICIPATED DURING COLD WEATHER, ALL FOUNDATIONS AND SLABS ARE TO BE PROTECTED FROM FROST PENETRATION UNTIL PROJECT COMPLETION. CONCRETE CAN NOT BE PLACED ON FROZEN SUB-GRADES. FROST CAN NOT BE ALLOWED TO PENETRATE BELOW THE FOOTINGS. IF FLOOR SLAB SUB-GRADES FREEZE, THE FROZEN SOILS ARE TO BE REMOVED AND REPLACED, OR COMPLETELY THAWED AND RE-COMPACTED, PRIOR TO PLACEMENT OF THE FLOOR SLAB.

## CONCRETE

- 1. CODE FOR REINFORCED CONCRETE DESIGN AND CONSTRUCTION IS ACI 318, LATEST EDITION.
- 2. ARRANGEMENT AND BENDING OF REINFORCING STEEL SHALL BE IN ACCORDANCE WITH ACI DETAILING MANUAL, LATEST EDITION
- 3. REINFORCING STEEL SHALL BE NEW DEFORMED BARS
- ALL REINFORCING BARS SHALL BE LAP SPLICED WITH CLASS B TENSION LAP SPLICES
- 5. CONCRETE COVER TO REINFORCING STEEL, UNO, SHALL BE AS FOLLOWS:

SURFACES CAST AGAINST EARTH - 3"

FORMED SURFACES IN CONTACT WITH EARTH OR EXPOSED TO WEATHER: #6 BAR OR LARGER - 2", #5 BAR OR SMALLER - 1-1/2"

FORMED SURFACES NOT IN CONTACT WITH EARTH OR EXPOSED TO WEATHER: WALLS, SLABS, JOISTS - 1", BEAMS, COLUMNS - 1-1/2"

- DETAIL AND PROVIDE SUITABLE WIRE SPACERS, CHAIRS, TIES, ETC., FOR SUPPORTING REINFORCING STEEL IN THE PROPER POSITION WHILE PLACING CONCRETE.
- 7. ALL CHAIRS SUPPORTED BY GRADE SHALL INCLUDE SAND PLATES.
- 8. BAR SUPPORTS WHICH COME IN CONTACT WITH EXPOSED SURFACES SHALL HAVE PLASTIC OR RUBBER TIPS OR BE STAINLESS STEEL
- 9. PROVIDE HOOKED DOWELS OF SAME SIZE AND SPACING AS VERTICAL OR COLUMN REINFORCING AT THE FOUNDATION, UNLESS NOTED OTHERWISE. ALL HOOKED DOWELS SHALL BE TIED IN PLACE PRIOR TO CONCRETE
- 10. PROVIDE BENT CORNER BARS TO MATCH AND LAP WITH HORIZONTAL BARS AT CORNERS AND INTERSECTIONS OF WALLS, BEAMS, BOND BEAMS, AND FOOTINGS
- 11. WHERE CONSTRUCTION JOINTS ARE NOT SHOWN, OR WHEN ALTERNATE LOCATIONS ARE PROPOSED DRAWINGS SHOWING LOCATION OF CONSTRUCTION AND CONTROL JOINTS AND PLACING SEQUENCE SHALL BE SUBMITTED FOR APPROVAL PRIOR TO PREPARATION OF THE REINFORCING STEEL SHOP DRAWINGS.
- 12. HORIZONTAL CONSTRUCTION JOINTS ARE NOT PERMITTED IN CONCRETE MEMBERS UNLESS SHOWN ON THE DRAWINGS OR APPROVED IN ADVANCE. VERTICAL CONSTRUCTION JOINTS OR BULKHEADS SHALL BE MADE AT MIDSPAN OR POINTS OF MINIMUM SHEAR.
- 13. VERIFY LOCATION OF OPENINGS SHOWN THROUGH CONCRETE SLABS OR WALLS AND COORDINATE ANY ADDITIONAL REQUIRED OPENINGS WITH OTHER TRADES AND THE ARCHITECT/ENGINEER.
- 14. CONCRETE EXPOSED TO FREEZING AND THAWING SHALL CONTAIN 5-7% ENTRAINED AIR
- 15. ALUMINUM CONDUIT OR PIPING MAY NOT BE EMBEDDED IN ANY CONCRETE
- 16. CALCIUM CHLORIDE IS NOT PERMITTED IN ANY CONCRETE ADMIXTURES
- 17. SUBMIT MIX DESIGN TO ENGINEER/ARCHITECT FOR APPROVAL PRIOR TO PLACING ANY CONCRETE. MIX DESIGNS SHALL BE CERTIFIED BY A LICENSED ENGINEER IN THE STATE OF SOUTH DAKOTA.

## MASONRY

- 1. CONSTRUCT MASONRY TO IBC REQUIREMENTS
- 2. PROVIDE VERTICAL REINFORCEMENT IN EXTERIOR MASONRY WALLS: # 5 @ 16 INCHES O.C., UNO.
- 3 DOWEL VERTICAL WALL REINFORCING TO FOUNDATION FOOTING OR THICKENED SLAB WITH FITHER A HOOKED BAR LAPPED WITH VERTICAL STEEL OR A VERTICAL BAR LAPPED WITH VERTICAL CMU WALL REINF AND CONCRETE WALL REINFORCING.
- 4. REINFORCE EACH SIDE OF ALL OPENINGS, CORNERS IN MASONRY WALLS, AND ENDS OF ALL MASONRY WALLS WITH (1)#5 VERTICAL, FULL HEIGHT, IN TWO ADJACENT CORES.
- 5. REINFORCE ALL BOND BEAMS WITH (2)#5 BOTTOM, CONTINUOUS. REINFORCING TO BEND 2'-0" AROUND ALL CORNERS OR USE 4'-0" CORNER BARS
- 6. SHOP WELD ALL LINTEL UNITS.
- 7. PROVIDE WELDED WIRE JOINT REINFORCING IN ALL MASONRY WALLS AT 8" O.C. AT STACK BOND.

- MAY BE USED
- WHILE GROUTING.
- BEARINGS AND GROUT CORE FULL HEIGHT.


- 16. MASONRY STRENGTH NOTES:

## STEEL FRAMING

- AND RECOMMENDATIONS.
- LABORATORY

- WELDED.

## STEEL ROOF DECK

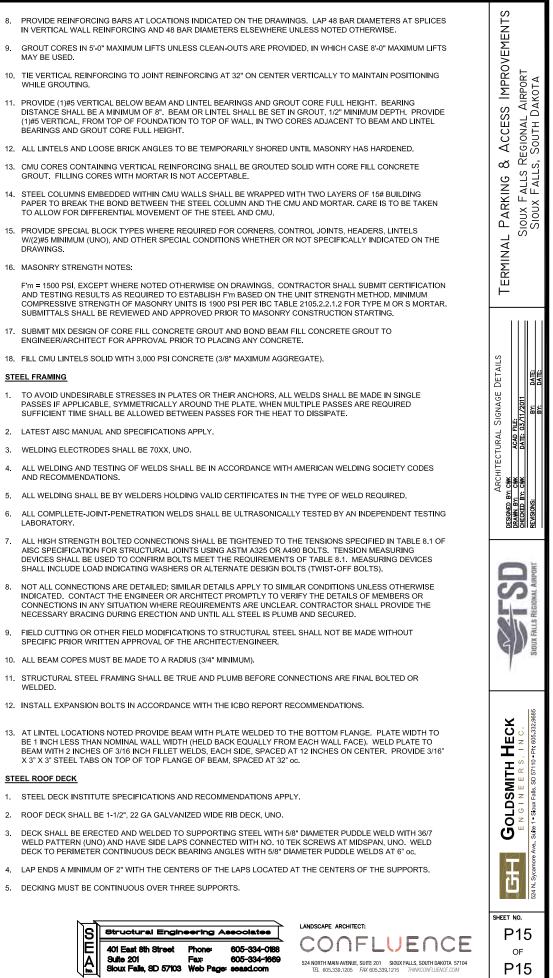



# HEADED SHEAR CONNECTOR STUDS - ASTM A108 (Fu = 58 KSI MIN)


		STANDARD DETAILS	s - Indez	x of Sheet	S
Page Number	Standard Plate Number	DESCRIPTION	Page Number	Standard Plate Number	Des
QI	SPECIAL	SOUTH POND - OUTLET CONTROL STRUCTURE	Q17	633.20	PAVEMENT MARKINGS ARROWS
Q2	SPECIAL	NORTH POND - OUTLET CONTROL STRUCTURE	QI7	634.01	TYPICAL APPLICATION - CONSTRUCTION OPER
Q3	SPECIAL	JB#7 DETAIL - SPECIAL 8'X6' JUNCTION BOX	Q18	635.12	SIGN FOOTING FOR MAST ARM SIGNAL
Q4	SPECIAL	TYPICAL BOLLARD DETAIL	QI8	635.14	TRAFFIC SIGNAL TRANSFORMER BASE SIZE AN
Q5	380.01	CONCRETE APPROACH PAVEMENT	Q19	635.17	CONTROLLER CABINET FOOTING FOR EIGHT PH
Q6	380.04 SP	TRANSVERSE CONTRACTION JOINT	Q19	635.31	JUNCTION BOX - TRAFFIC
Q6	380.06	SAWED LONGITUDINAL JOINT	Q20	635.33	JUNCTION BOX - INNERDUCTS
Q7	380.07	KEYWAY LONGITUDINAL CONSTRUCTION JOINT WITH TIE BARS	Q20	635.42	POWER FEED FROM GROUND POWER SOURCE
Q7	380.08	KEYWAY CONSTRUCTION JOINT WITHOUT TIE BARS	Q21	635.50	STREET LIGHT FOOTING 40' MAXIMUM POLE HE
Q8	380.09	LONGITUDINAL CONSTRUCTION JOINT WITH TIE BARS	Q21	635.52	STREET LIGHT FOOTING 45' TO 50' POLE HEIG
Q8	380.13	CONSTRUCTION JOINT ADJACENT TO EXISTING PAVEMENT	Q22	635.62	STREET LIGHT ON STANDARD T-BASE (BREAKA
Q9	380.14	TIE BAR INSTALLATION IN TRANSVERSE JOINT	Q22	635.70	JUNCTION BOX - LIGHTING
Q9	450.06	BEDDING AND BACKFILL FOR RCP B INSTALLATION	Q23	SPECIAL	SPILLOUT CONCRETE CURB AND GUTTER SECT
QIO	450.13 SP	STORM SEWER BOOT CONNECTION	Q23	650.01	CONCRETE CURB AND GUTTER SECTION
QII	460.01	STANDARD 6'-0" S.F. TYPE STORM SEWER INLET - FOR 15" TO 24" PIPES	Q24	650.04	CONCRETE FILLET SECTION AND CURB OPENIN
QI2	460.02	STANDARD 10'-0" S.F. TYPE STORM SEWER INLET - FOR 18" TO 30" PIPES	Q25	651.02	SIDEWALK RAMPS AND DETECTABLE WARNING
QI3	460.05	STANDARD STORM SEWER JUNCTION BOX TYPE I	Q26	671.01	MANHOLE CASTING AND COVER ADJUSTMENT
Q13	460.07	STANDARD STORM SEWER INLET TYPE BI	Q27	900.01	CONCRETE THRUST BLOCK
Q14	460.08	2'X2' CATCH BASIN WITH SURFACE DRAIN	Q28	900.02	VALVE BOX ADJUSTMENT/REPLACEMENT
Q14	632.10	HEIGHTS AND LATERAL LOCATIONS OF SIGNS FOR TYPICAL URBAN INSTALLATION	Q29	900.06	HYDRANT CONNECTION
Q15	632.20	SIGN MOUNT SPECIFICATIONS	Q29	900.08	PVC GATE VALVE INSTALLATION
Q15	632.20	SIGN MOUNT SPECIFICATIONS	Q30	900.12	WATER MAIN BEDDING DETAIL
QI6	633.10	PAVEMENT MARKINGS	Q30	950.12	TYPICAL SANITARY SEWER SERVICE
Q16	633.20	PAVEMENT MARKINGS ARROWS	Q31	950.13	CLEANOUT MANHOLE FRAME AND COVER

		TION ING G PANELS	AND BOLT CIRCLE REQUIREMENTS PHASE SIGNAL HEIGHT IGHT KAWAY)	ESCRIPTION RATIONS TYPICAL LANE CLOSURE
SHEET NO. INDEX OF	GH GOLDSMITH HECK ENGINEERS, INC. 524 N. Sycamore Are., Sulle 1 - Slour Falls, SD 57110 - PN: 605.332.9666	SOOK FALLS REBIONAL ARPORT	DETAILS / STANDARD PLATES DESIGNED BY: DRAWN BY: DMS ACAD FILE: 210710_Standard Plates.dwp DHCKED BY: MDW DATE: 3/11/2011 REVISIONS: BY: DATE: BY: DATE:	TERMINAL PARKING & ACCESS IMPROVEMENTS SIOUX FALLS REGIONAL AIRPORT SIOUX FALLS, SOUTH DAKOTA

STANDARD DETAILS

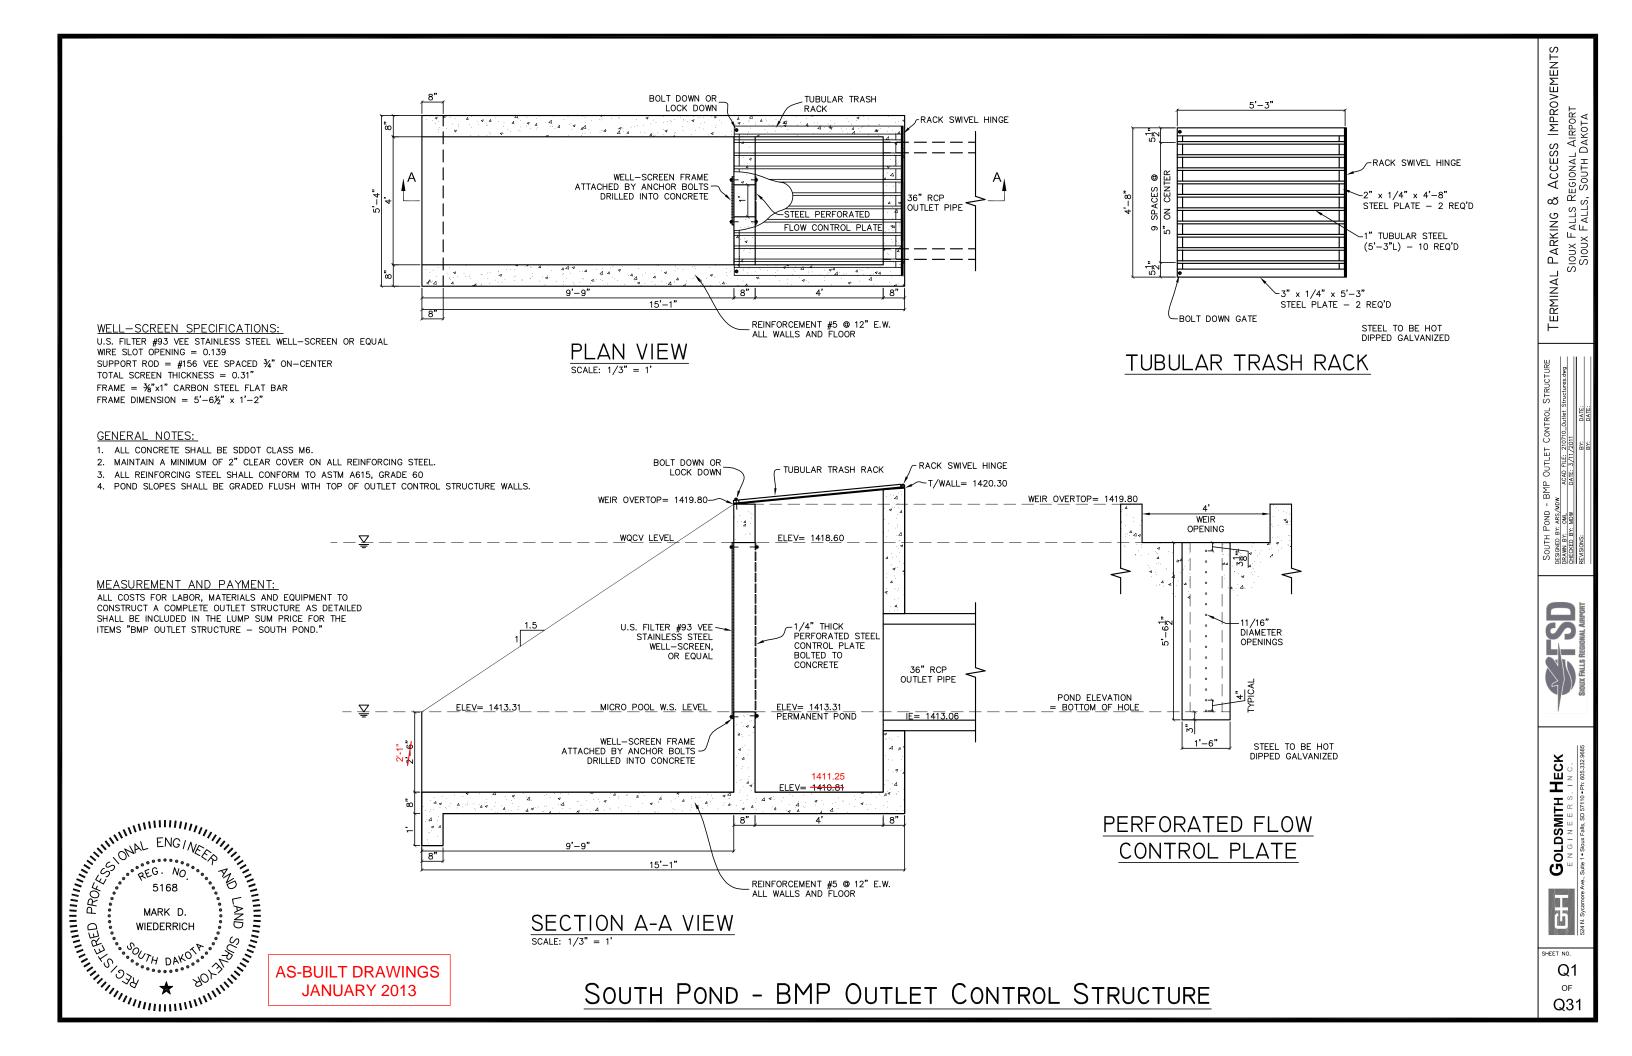


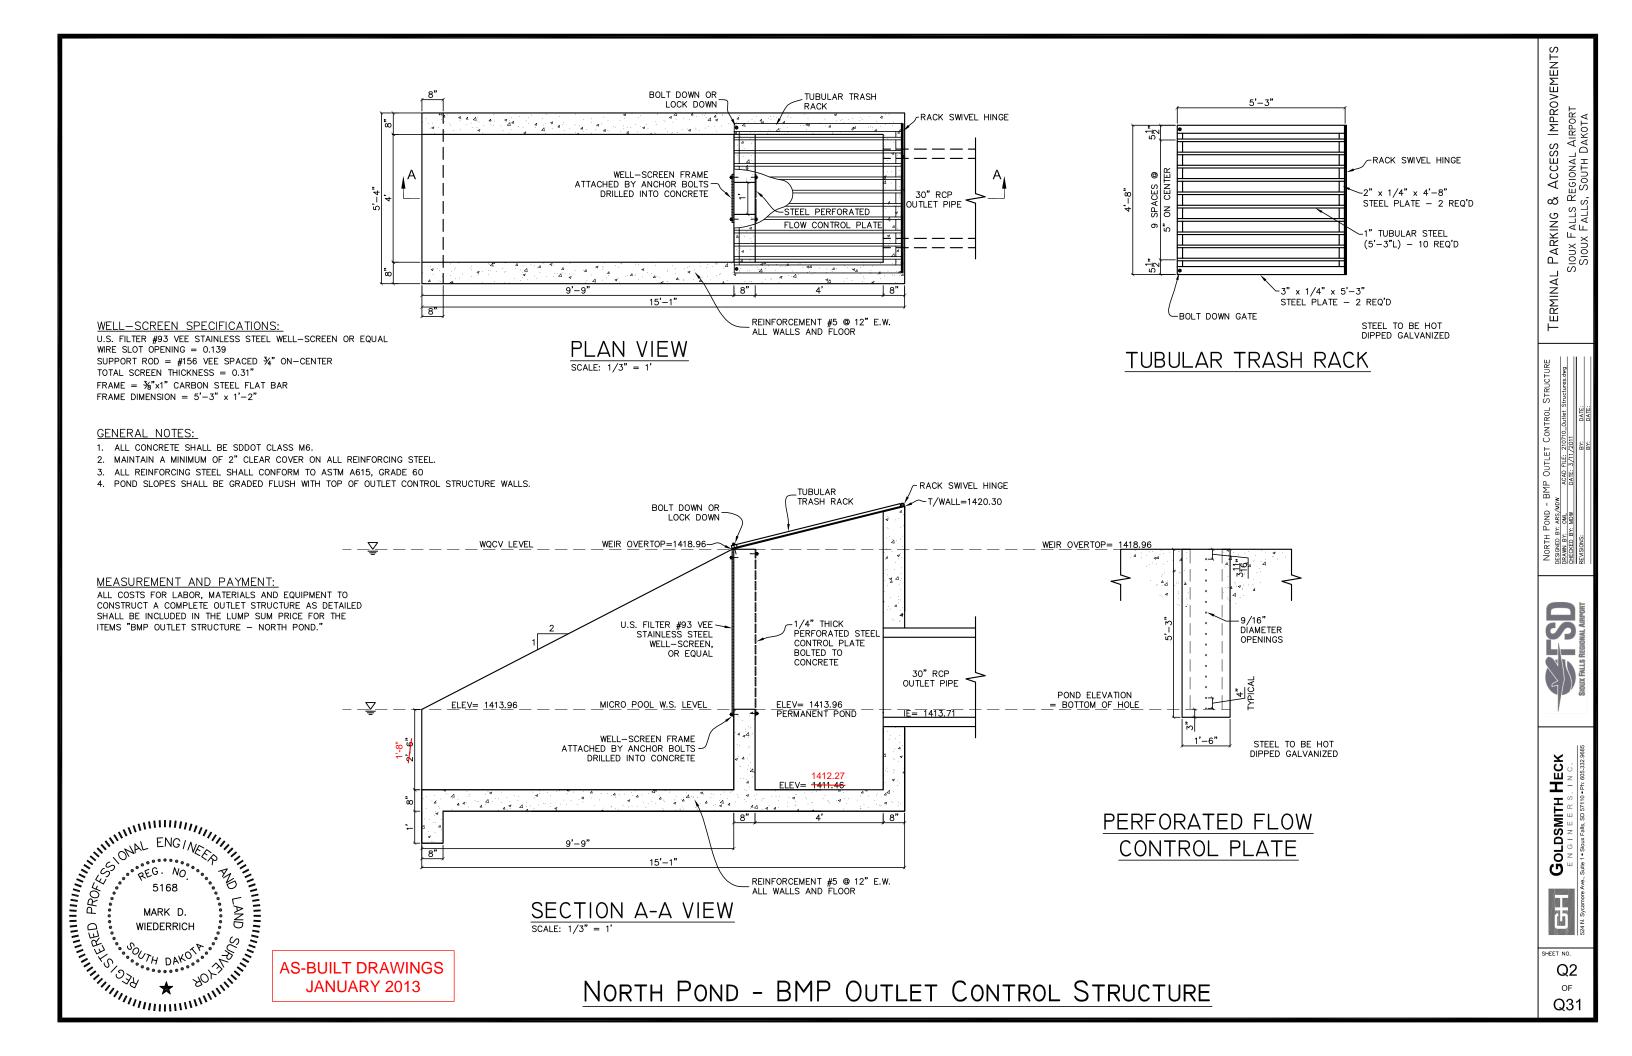


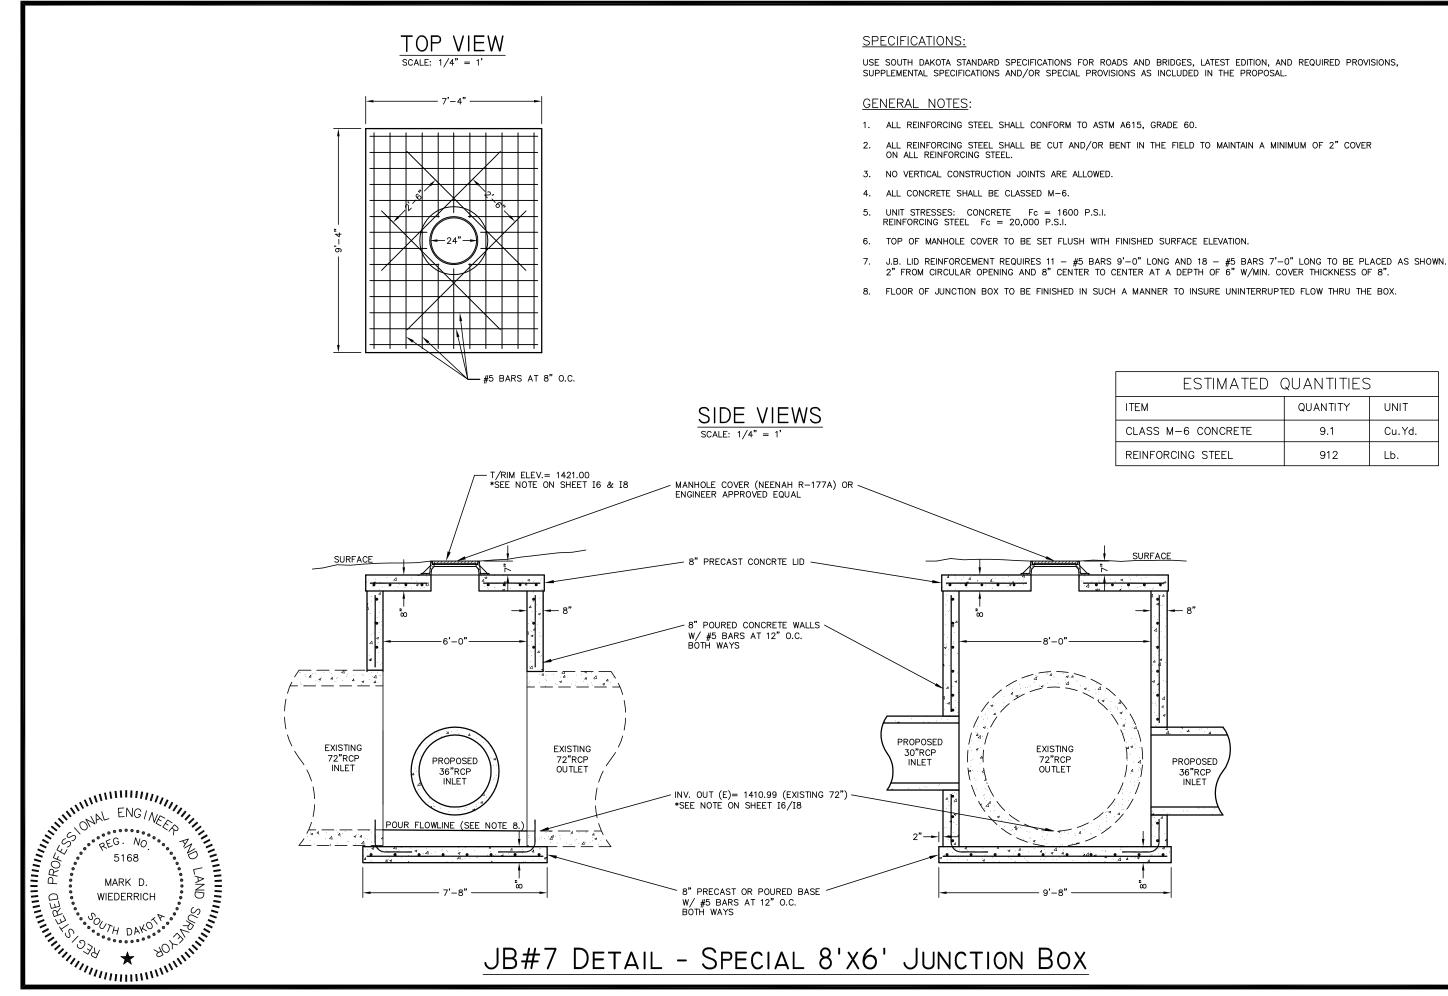


ESTIMATED QUANTITIES					
	QUANTITY	UNIT			
M-6 CONCRETE	9.1	Cu.Yd.			
DRCING STEEL	912	Lb.			




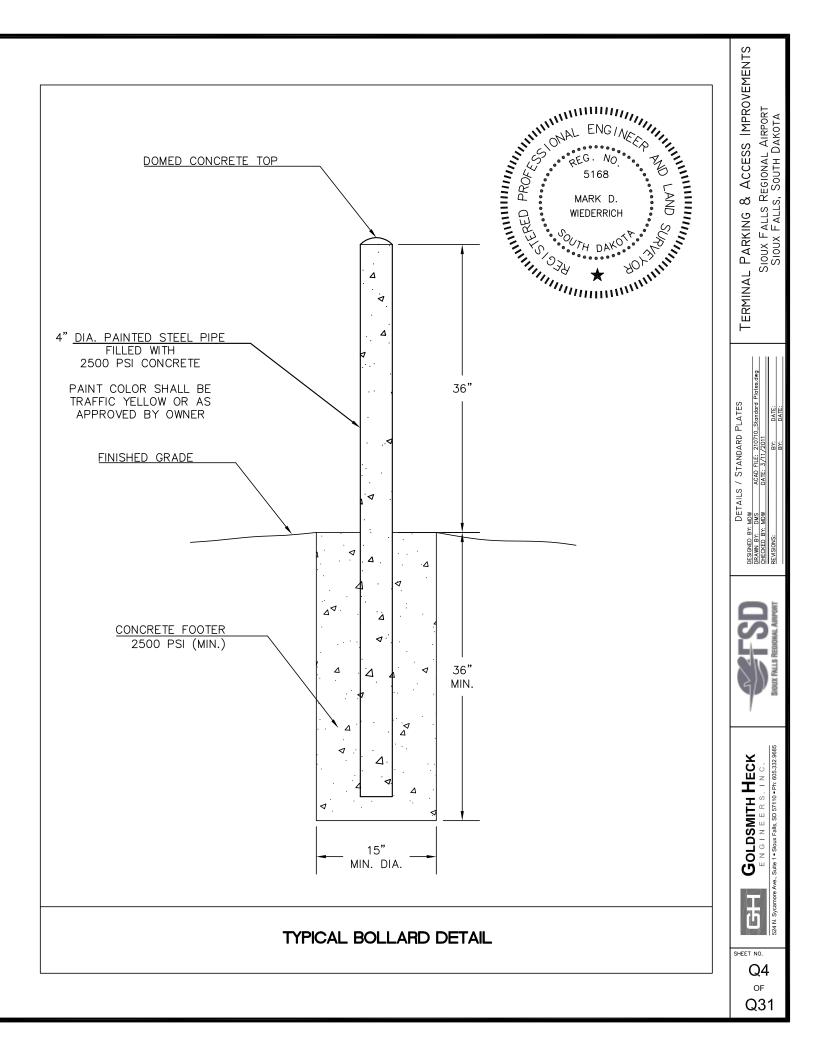

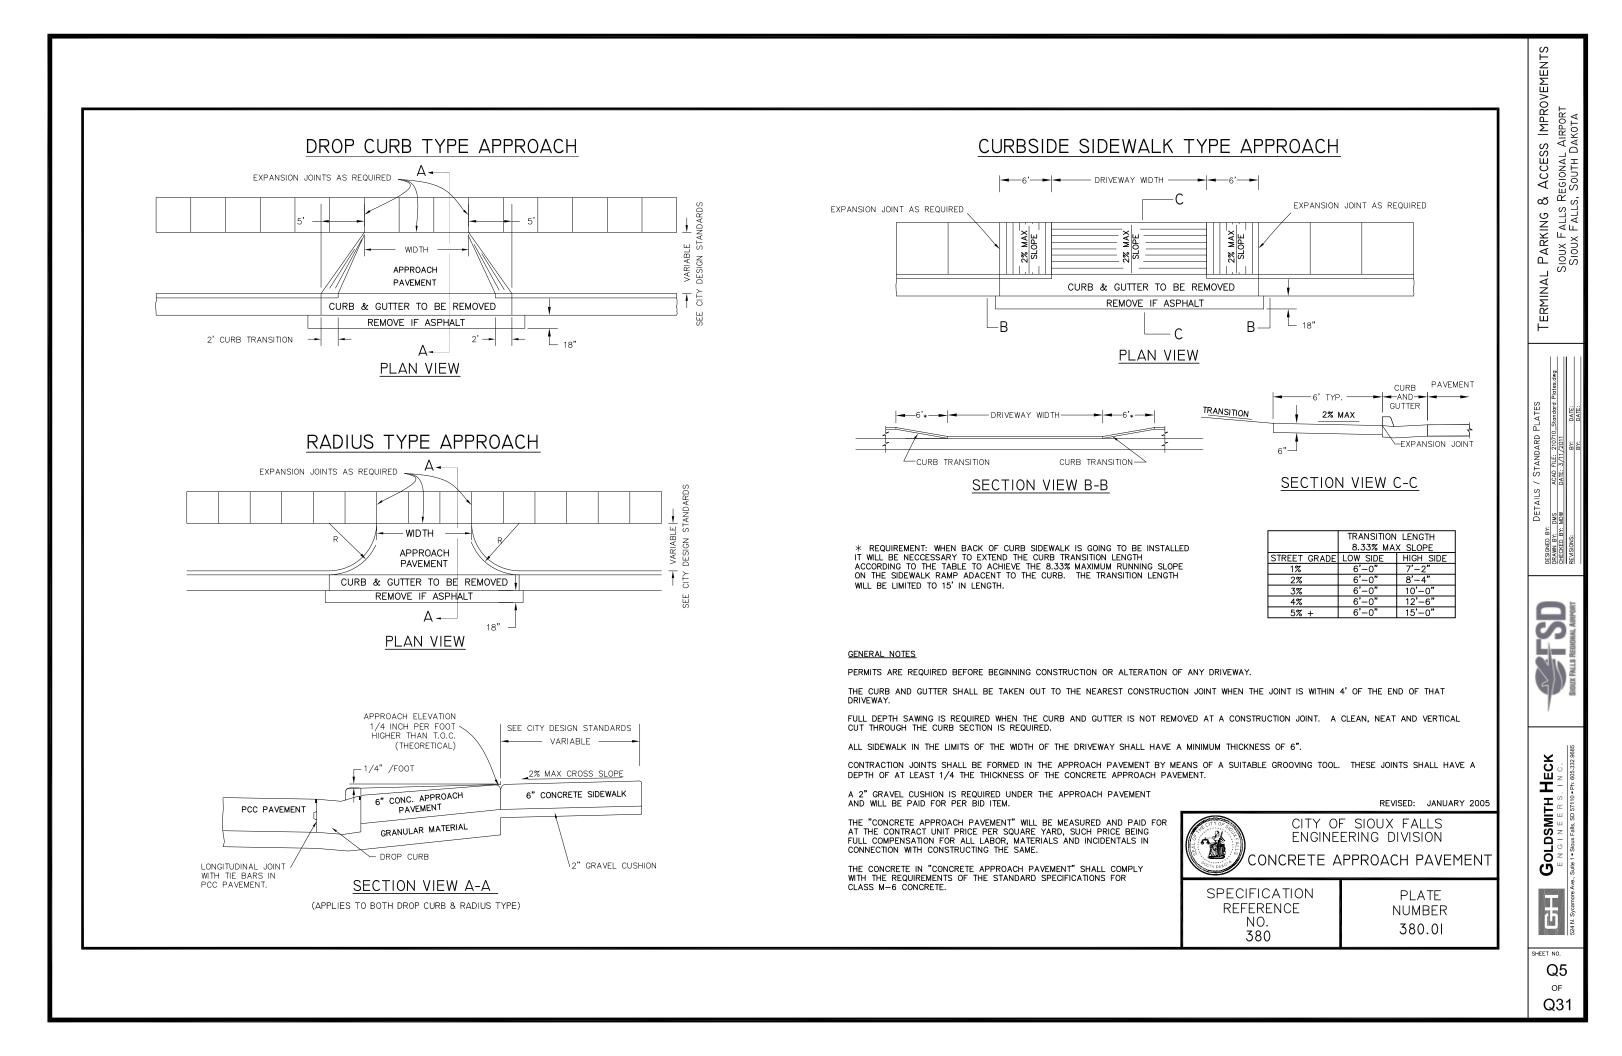


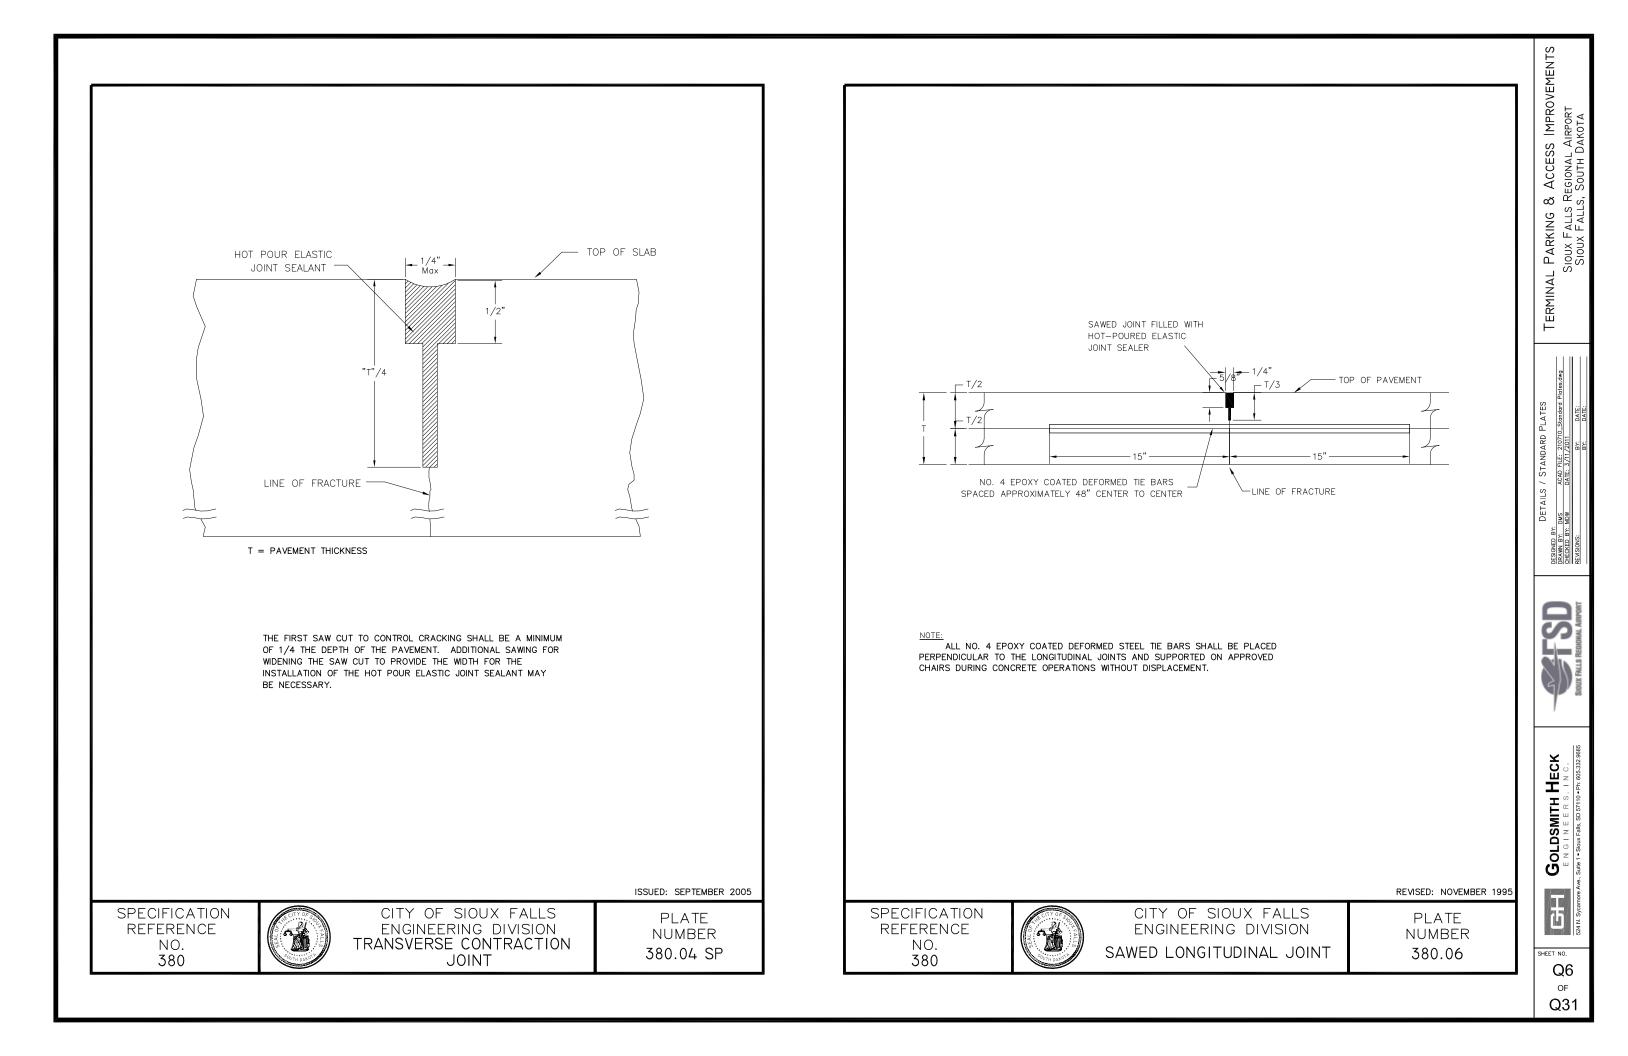


		CESS IMPROVEMENTS NAL AIRPORT ITH DAKOTA
		TERMINAL PARKING & ACCESS IMPROVEMENTS SIOUX FALLS REGIONAL AIRPORT SIOUX FALLS, SOUTH DAKOTA
IF PROPOSED, APPROVAL OF ALTERNATE DESIGNS OF THE KEYWAY WILL BE	SAWED JOINT FILLED WITH HOT-POURED ELASTIC JOINT SEALER	DETAILS / STANDARD PLATES DESIGNED BY: DEAMN BY: DNS ACAD FILE: 210710_Standard Plates dwg CHECKED BY: MDW DATE: 3/11/2011 EXVISIONS: BY: DATE: BY: DATE:
CONSIDERED BY THE ENGINEER FOR LONGITUDINAL CONSTRUCTION JOINTS. THE NO. 4 EPOXY COATED DEFORMED TIE BARS SHALL BE SPACED APPROXIMATELY 48" CENTER TO CENTER.	BE CONSIDERED BY THE ENGINEER.	
REVISED: NOVEMBER 1995 SPECIFICATION REFERENCE VERMINERING DIVISION NUMBER	REVISED: FEBRUARY 1993 SPECIFICATION REFERENCE LICEVILLATION CITY OF SIOUX FALLS ENGINEERING DIVISION NUMBER	GH GOLDSMITH HECK E N G I N E E R S, I N C. 524 N. Sycamore Ave., Suite 1 - Stow Falls, SD 57110 - Ph. 605.332.9685
REFERENCE NO. 380 REFERENCE NUMBER KEYWAY LONGITUDINAL JOINT WITH TIE BARS REFERENCE NUMBER 380.07	REFERENCE NO. 380 WITHOUT TIE BARS	SHEET NO. Q7 OF Q31

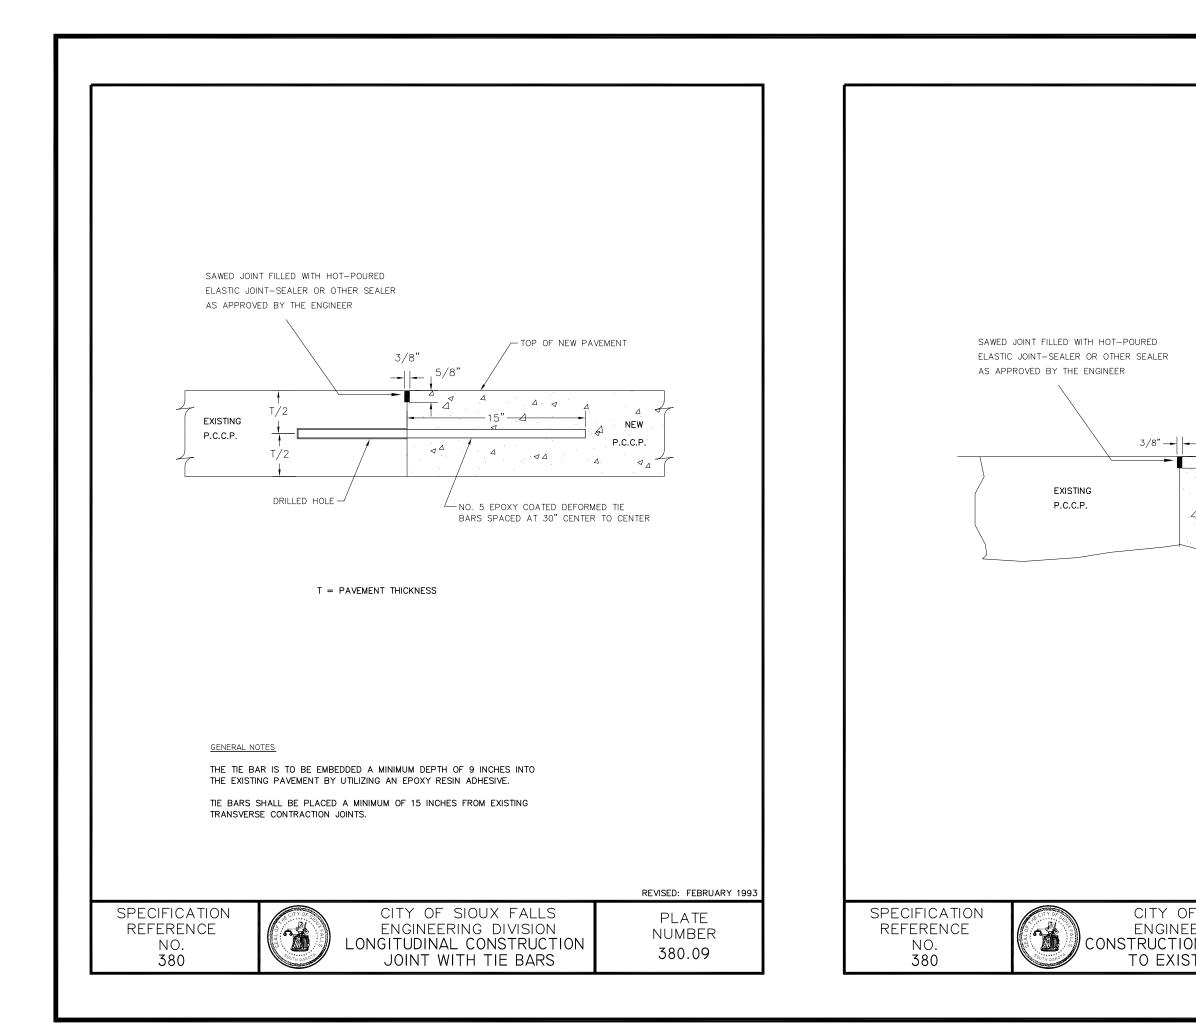



	F SIOUX FALLS ERING DIVISION N JOINT ADJACENT TING PAVEMENT BLATE NUMBER NUMBER 380.13	REVISED: FEBRUARY 1993		$ \begin{array}{c}  5/8'' \\  \hline  4 \\  \hline  4 \\  \hline  7 \\  \hline  8 \\  \hline  4 \\  \hline  7 \\  \hline  8 \\  \hline  8 \\  7 \\  \hline  8 \\  \hline  8 \\  7 \\  7 \\  7 \\  7 \\  7 \\  7 \\  7 \\$	
Q8 ₀ Q31	SHEET NO.	<b>GH GOLDSMITH HECK</b> E N G I N E E R S, I N C. 224 N. Sycamore Ave. Sule 1 - Stow Falls, 50 5710 - Ph: 605.332.9685	SOUX FALLS REBIONAL ARPORT	DETAILS / STANDARD PLATES DESIGNED BY: DEAMN, BY: DMS ACAD FILE: 210710_Standard Plates.dwg DEAMN, BY: DMS DECKED BY: MDW DATE: 3/11/2011 REVUSIONS: BY: DATE: BY: DATE:	TERMINAL PARKING & ACCESS IMPROVEMENTS SIOUX FALLS REGIONAL AIRPORT SIOUX FALLS, SOUTH DAKOTA

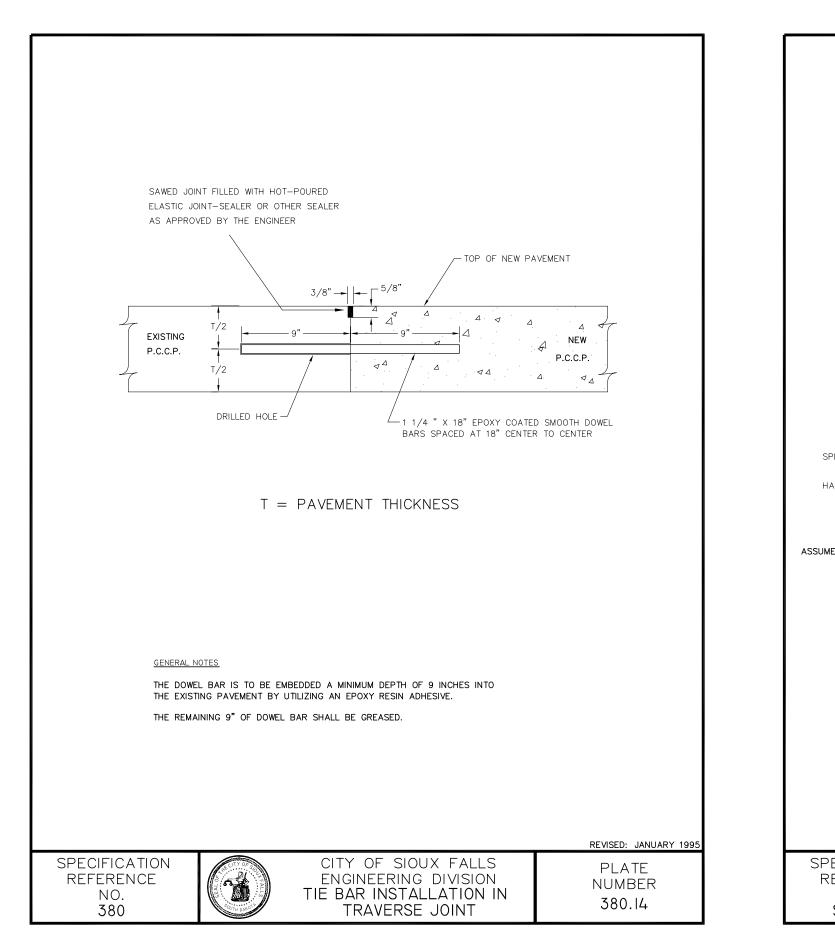


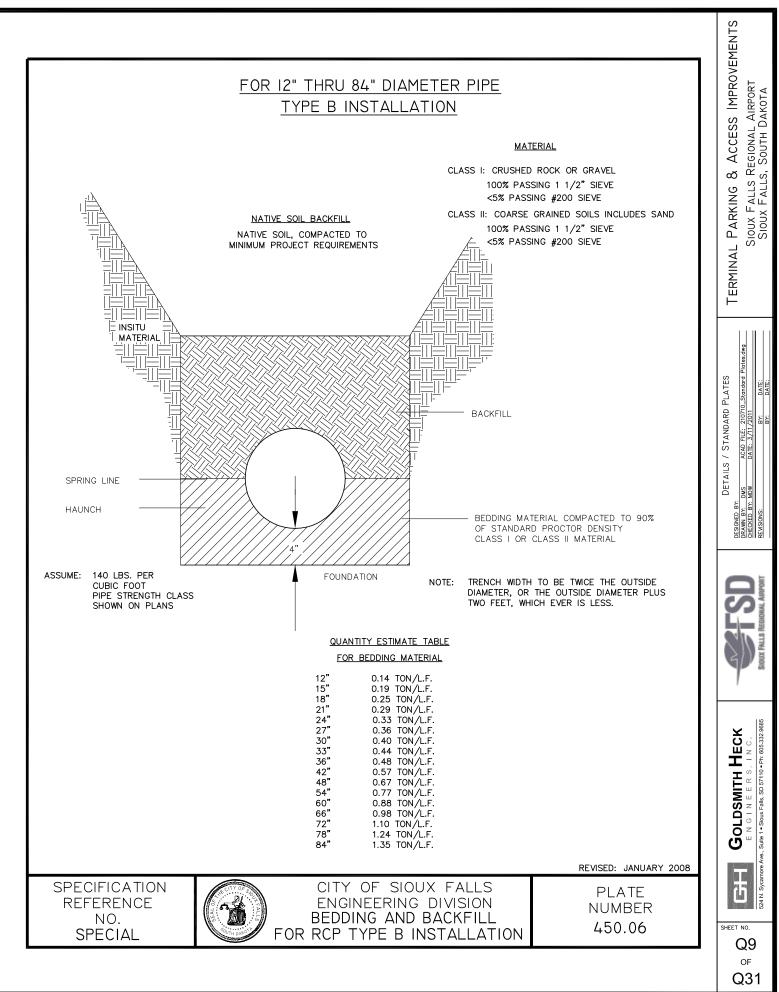




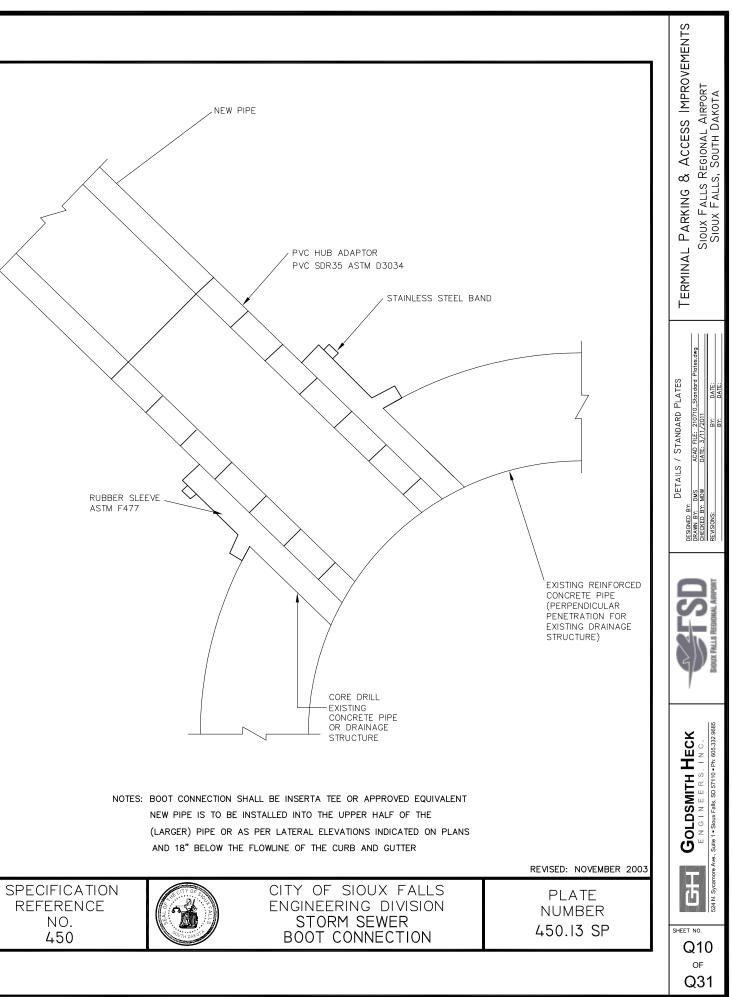

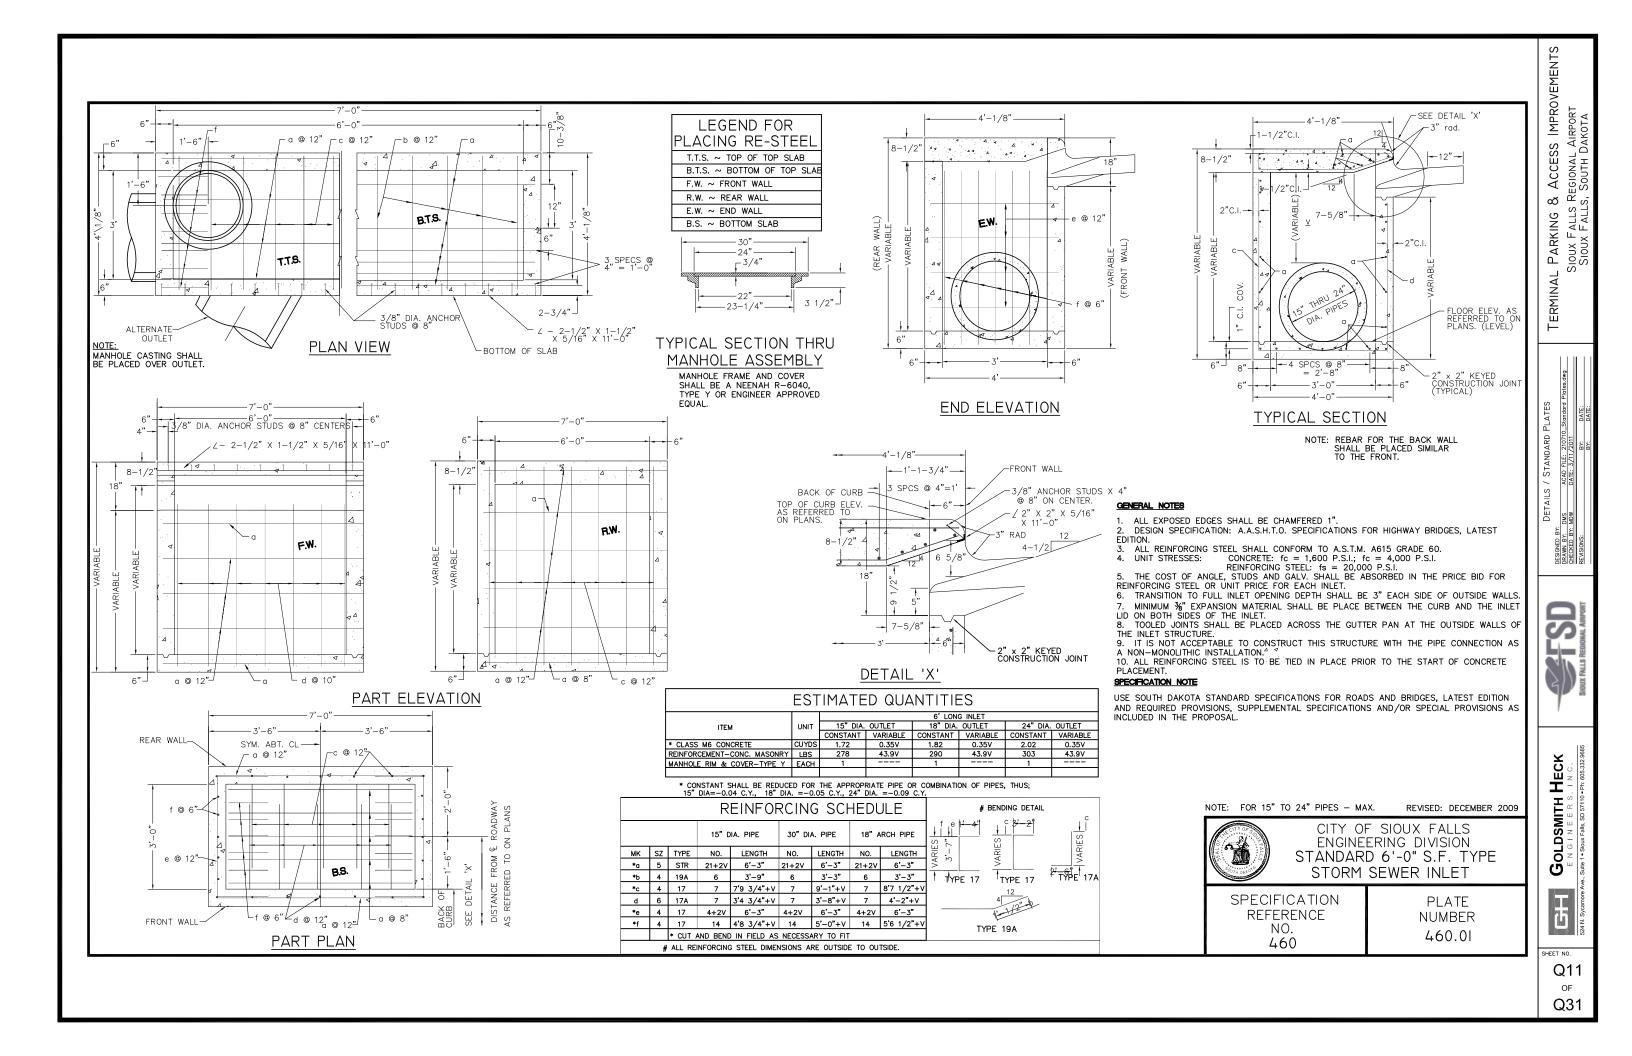

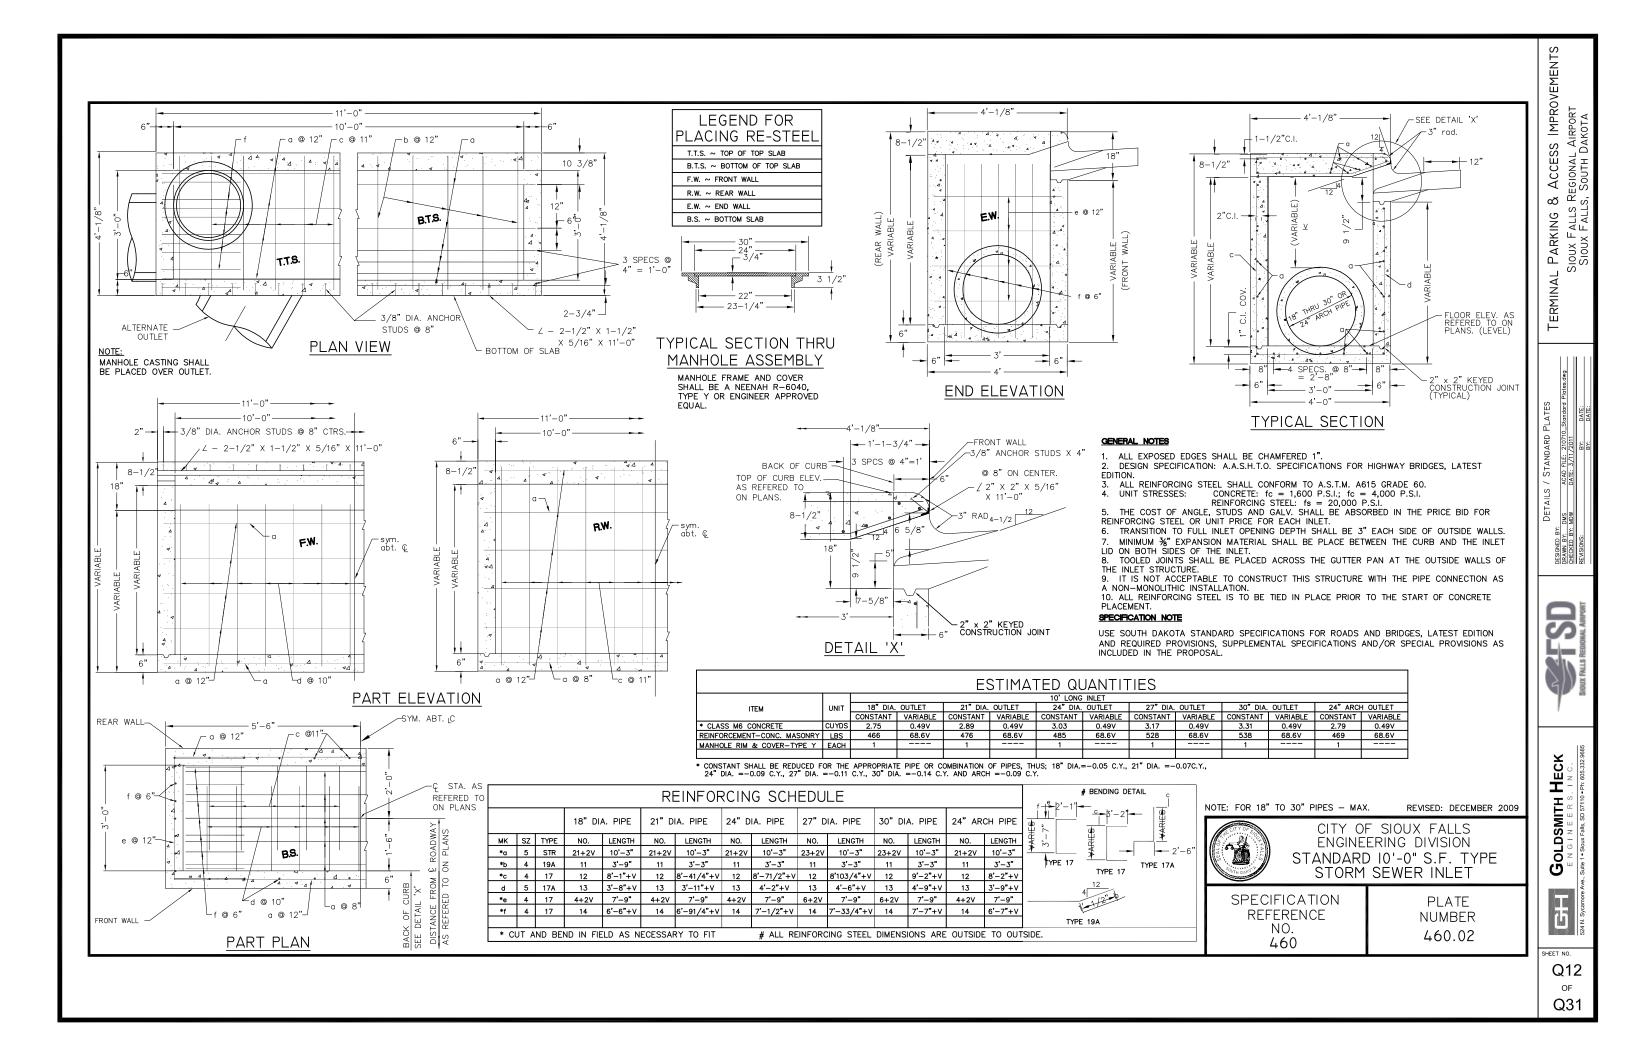

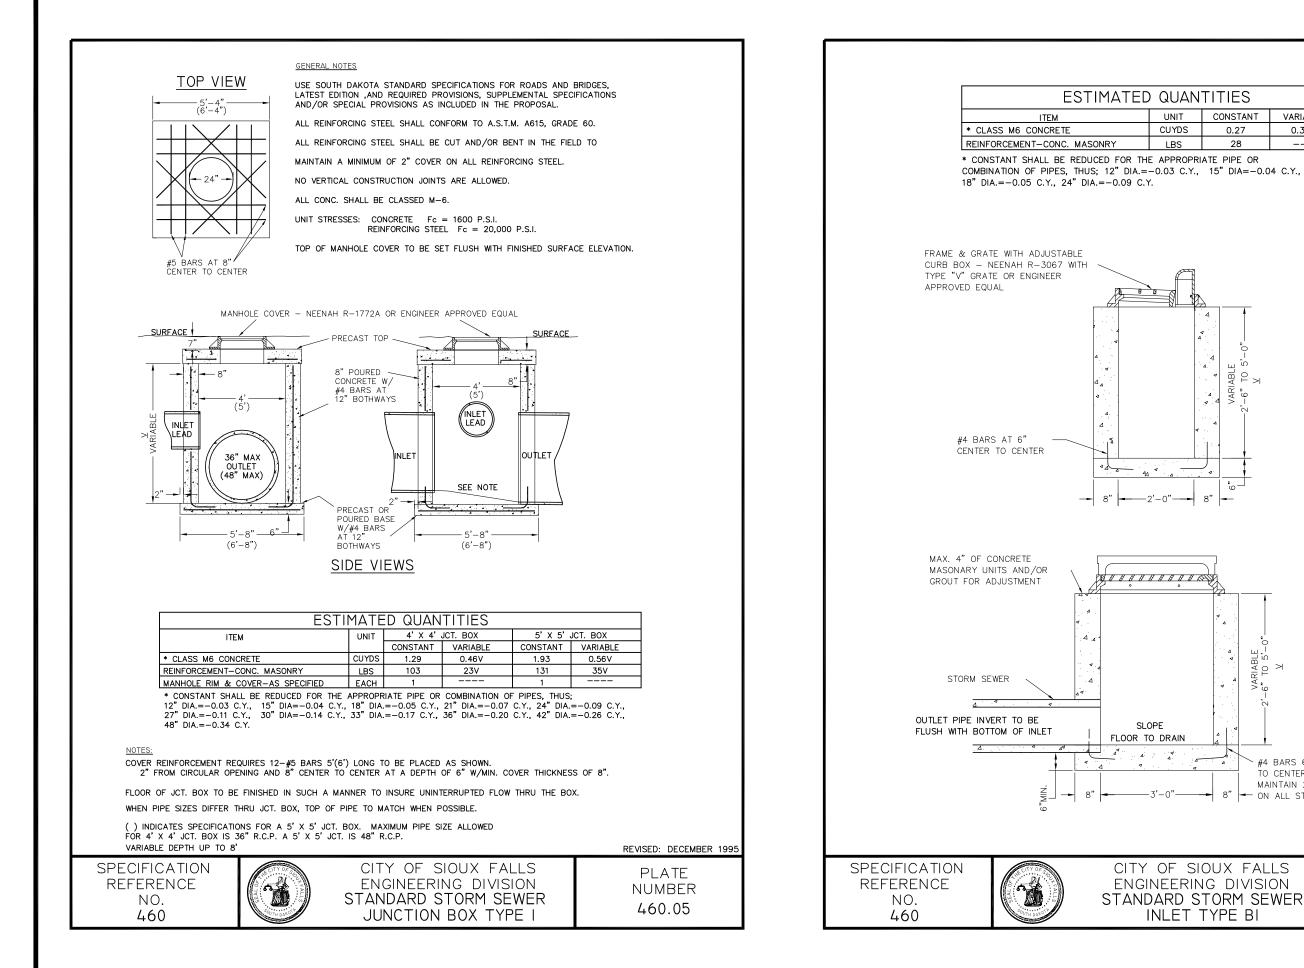

QUANTITIES				
UNIT	CONSTANT	VARIABLE		
CUYDS	0.27	0.32V		
LBS	LBS 28			

\* <u>A</u>

SLOPE

CITY OF SIOUX FALLS


ENGINEERING DIVISION


STANDARD STORM SEWER

INLET TYPE BI


4


8"

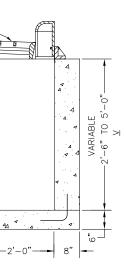


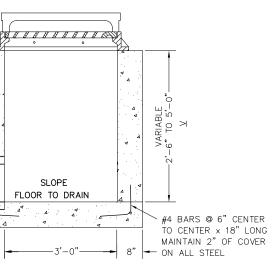


/ STANDARD PLATES ALE 2070-Standard Potescarg DATE 2010-Standard
DETAILS / STANDARD PLATES DETAILS / STANDARD PLATES DESIGNED BY: DECKID BY: DWS DECKID BY: DWS DYS DECKID BY: DWS DYS DECKID BY: DWS DYS DYS DYS DYS DYS DYS DYS DY
<b>SOLDSMITH HECK</b> E N G I N E E R S. I N C. Be 1 - SOUX Falls, SD 57710 - Ph: 805.332 3665
EVISED: DECEMBER 1995 PLATE NUMBER 460.07

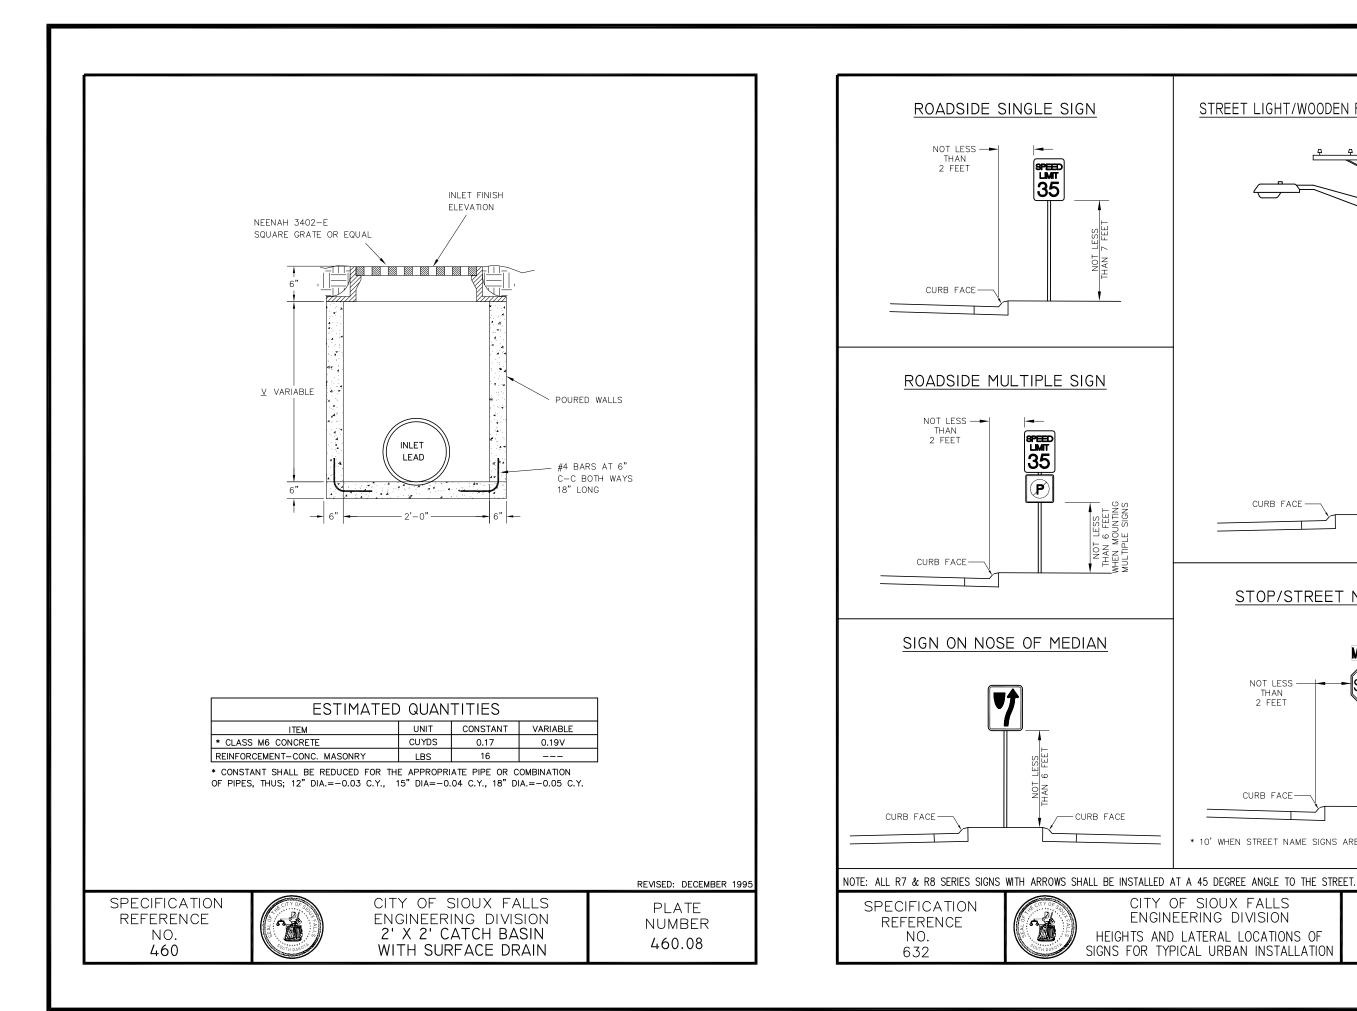


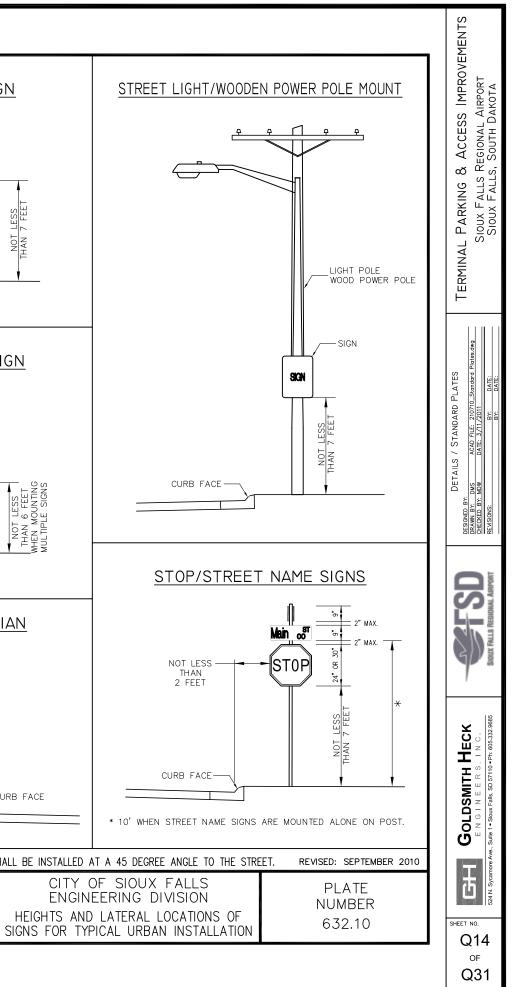


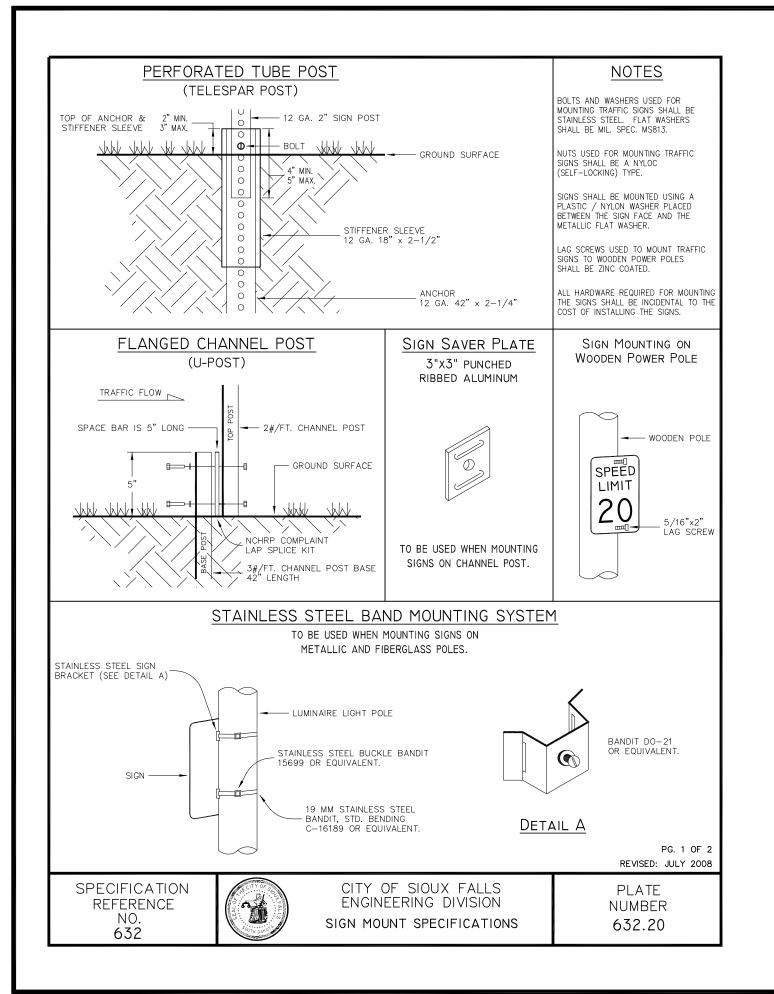


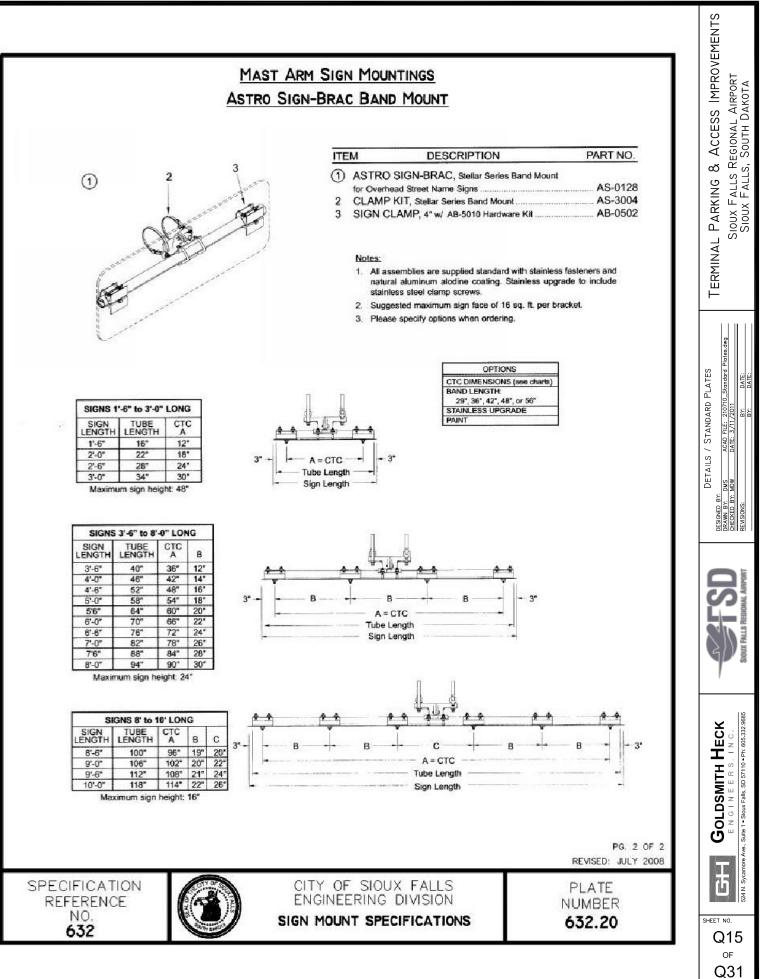



	Note that the second	A LOCAL DESIGNATION OF THE OWNER
	DESCRIPTION	PART NO.
STRO	SIGN-BRAC, Stellar Series Band Mo	ount
or Overhe	ad Street Name Signs	AS-0128
LAMP	KIT, Stellar Series Band Mount	AS-3004
GIGN CI	LAMP, 4" w/ AB-5010 Hardware Kit	AB-0502

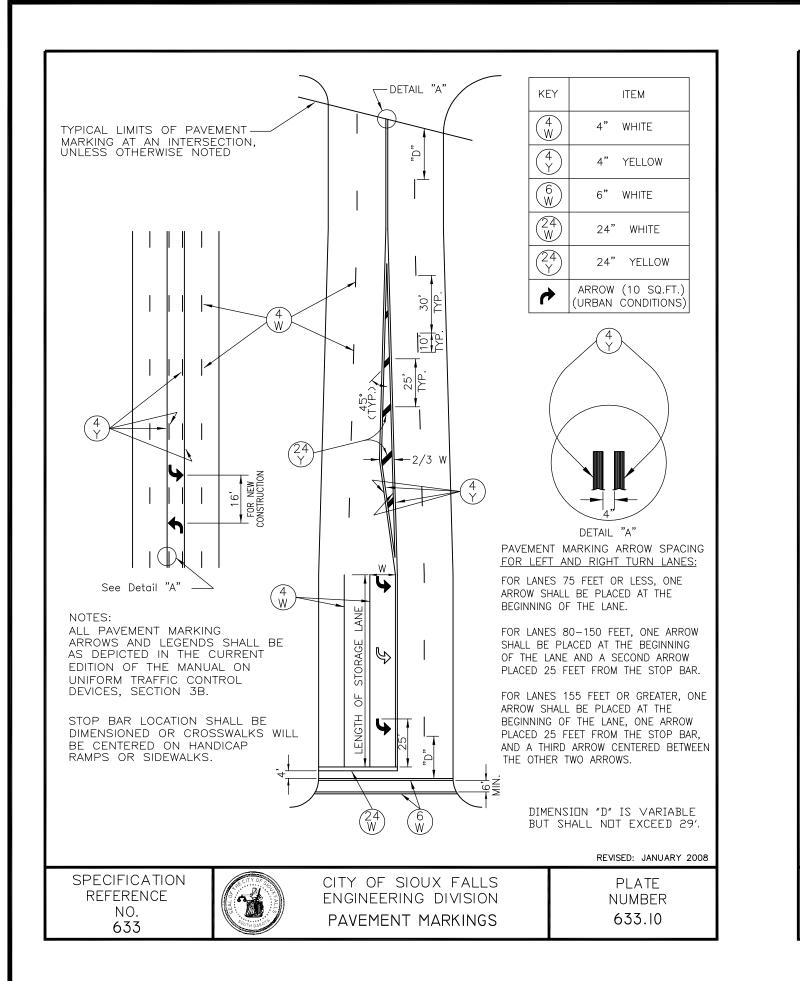


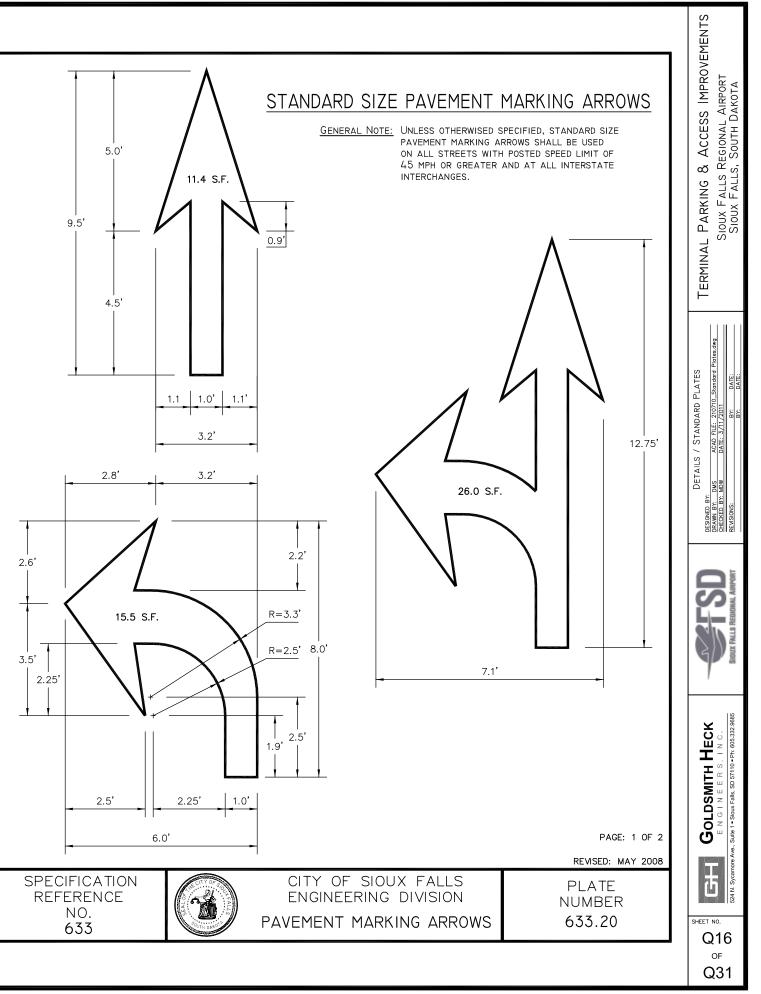


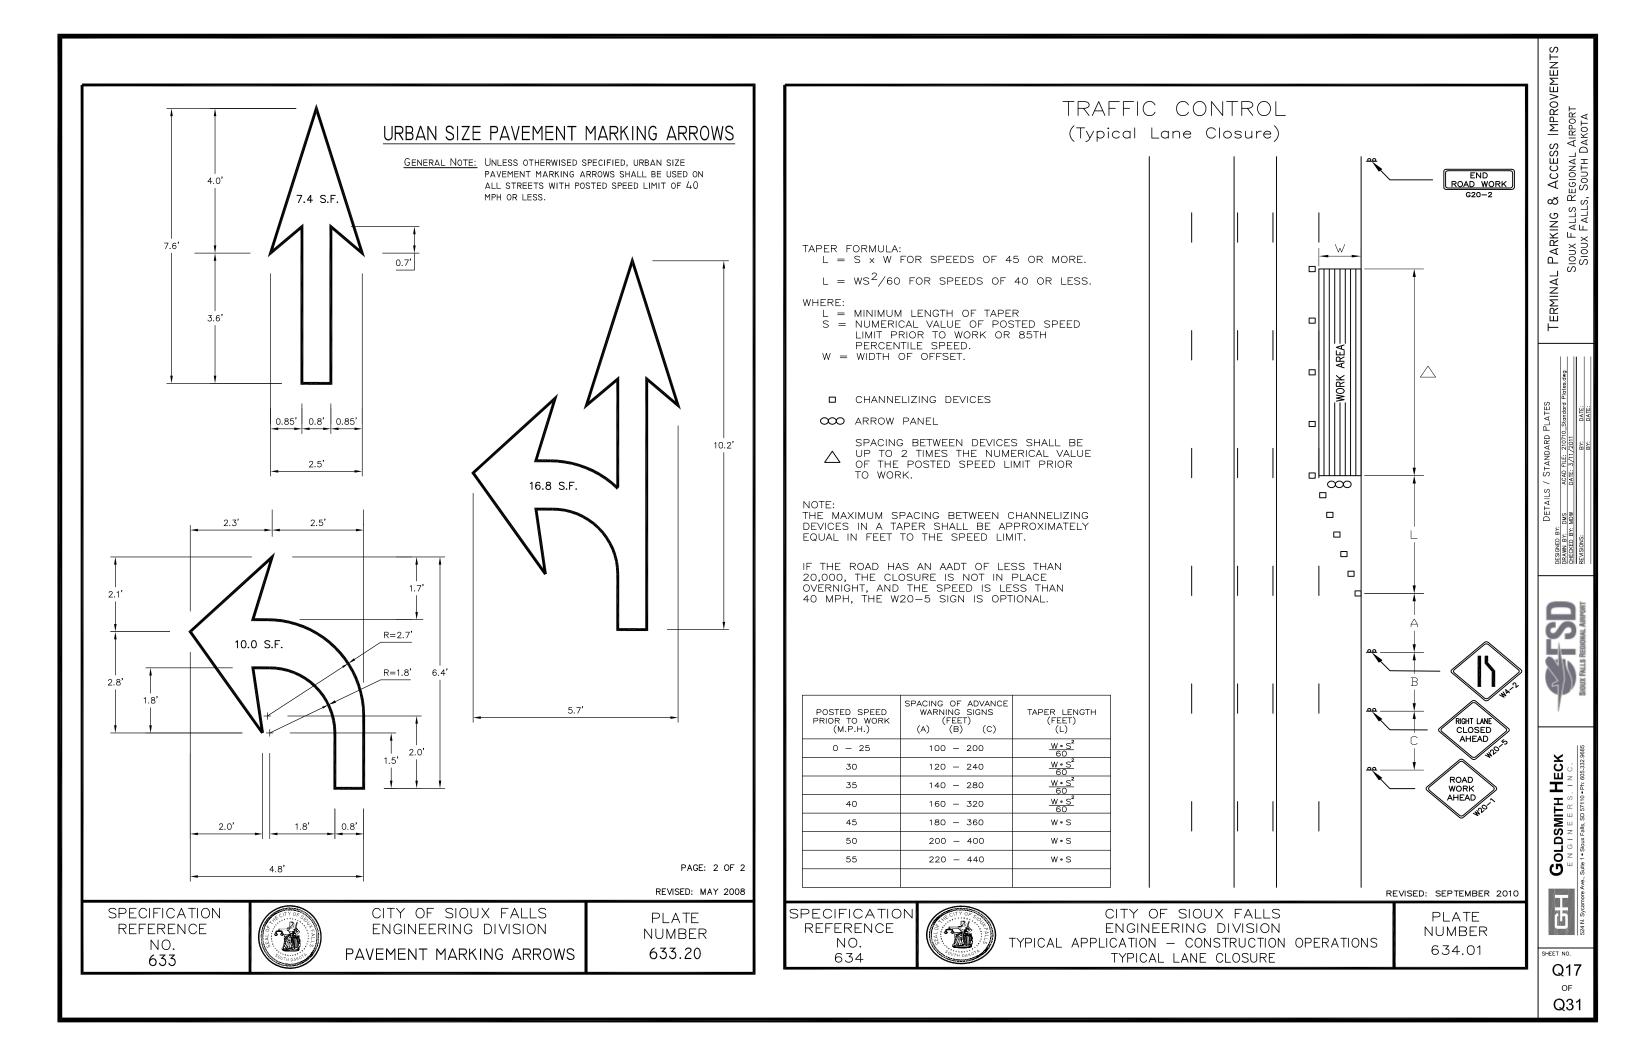


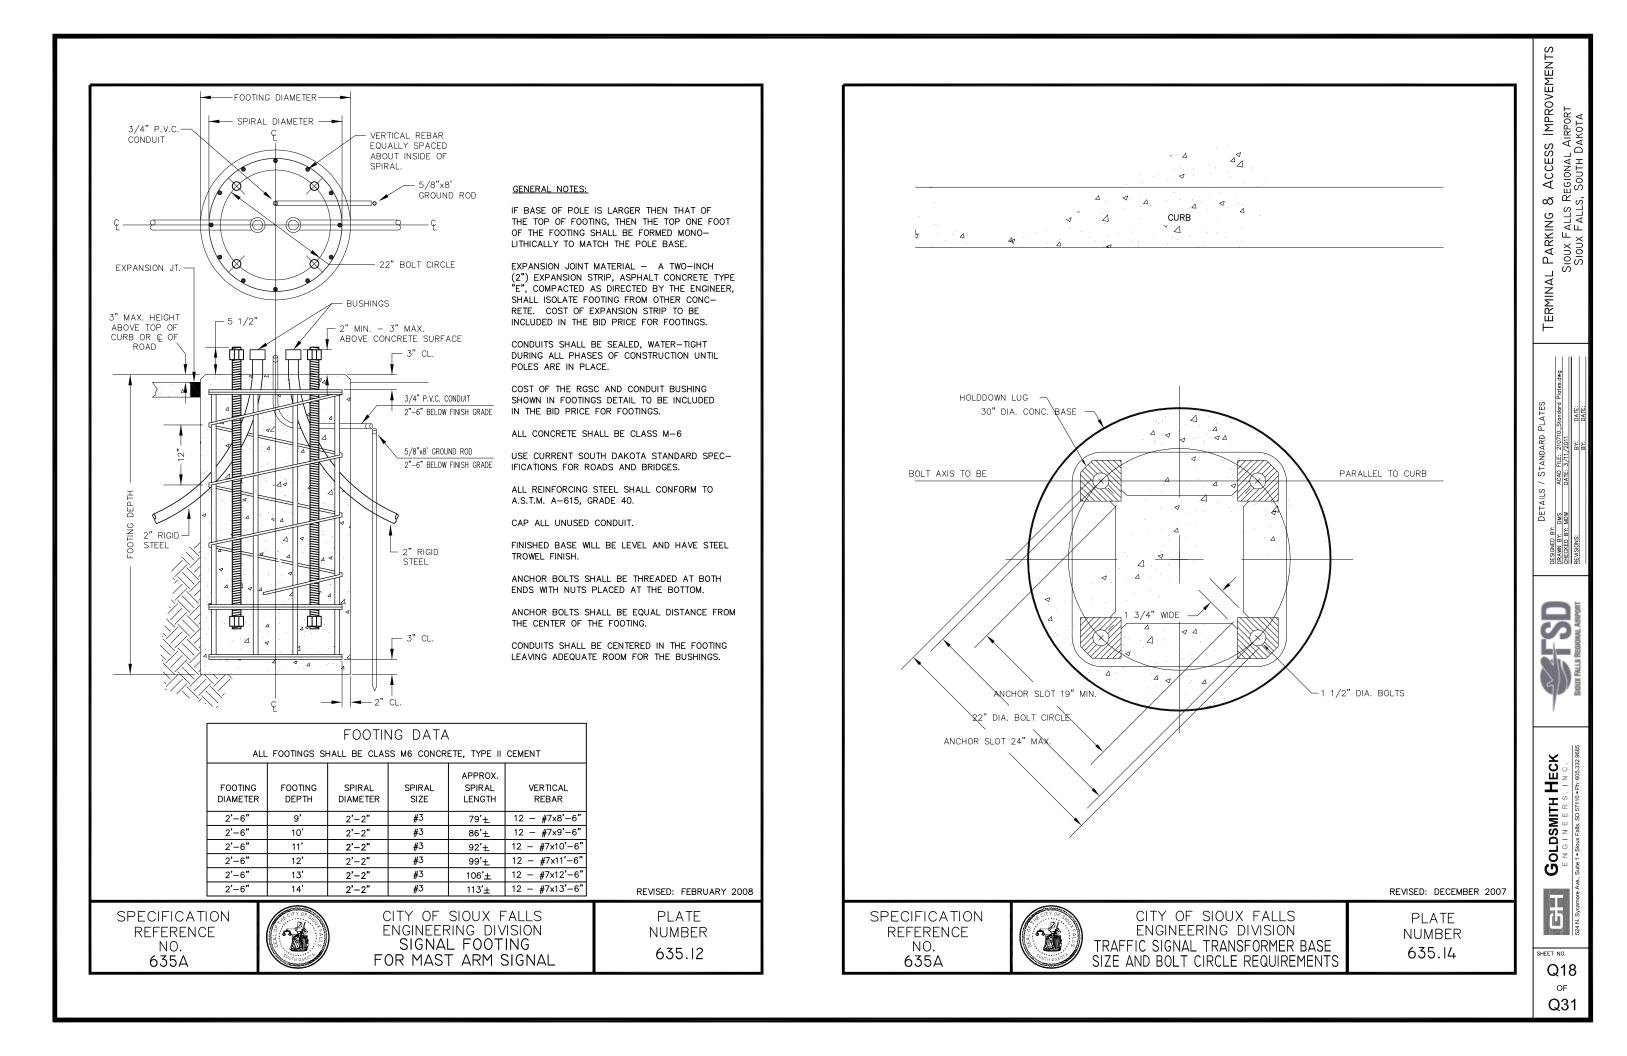


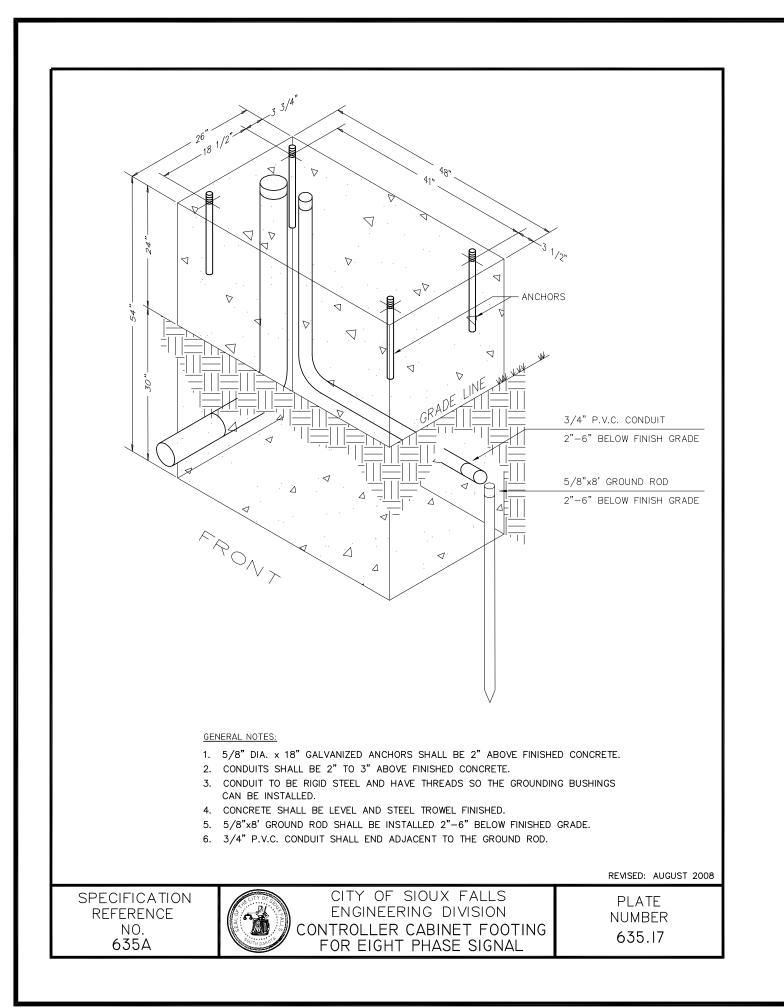


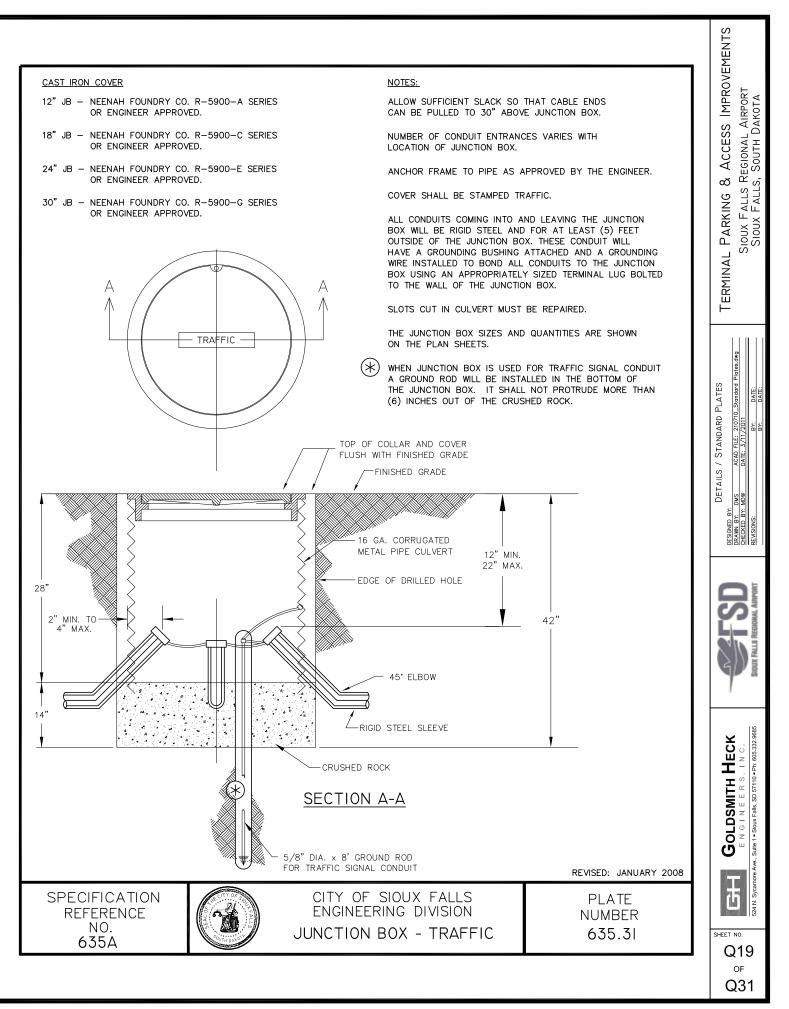


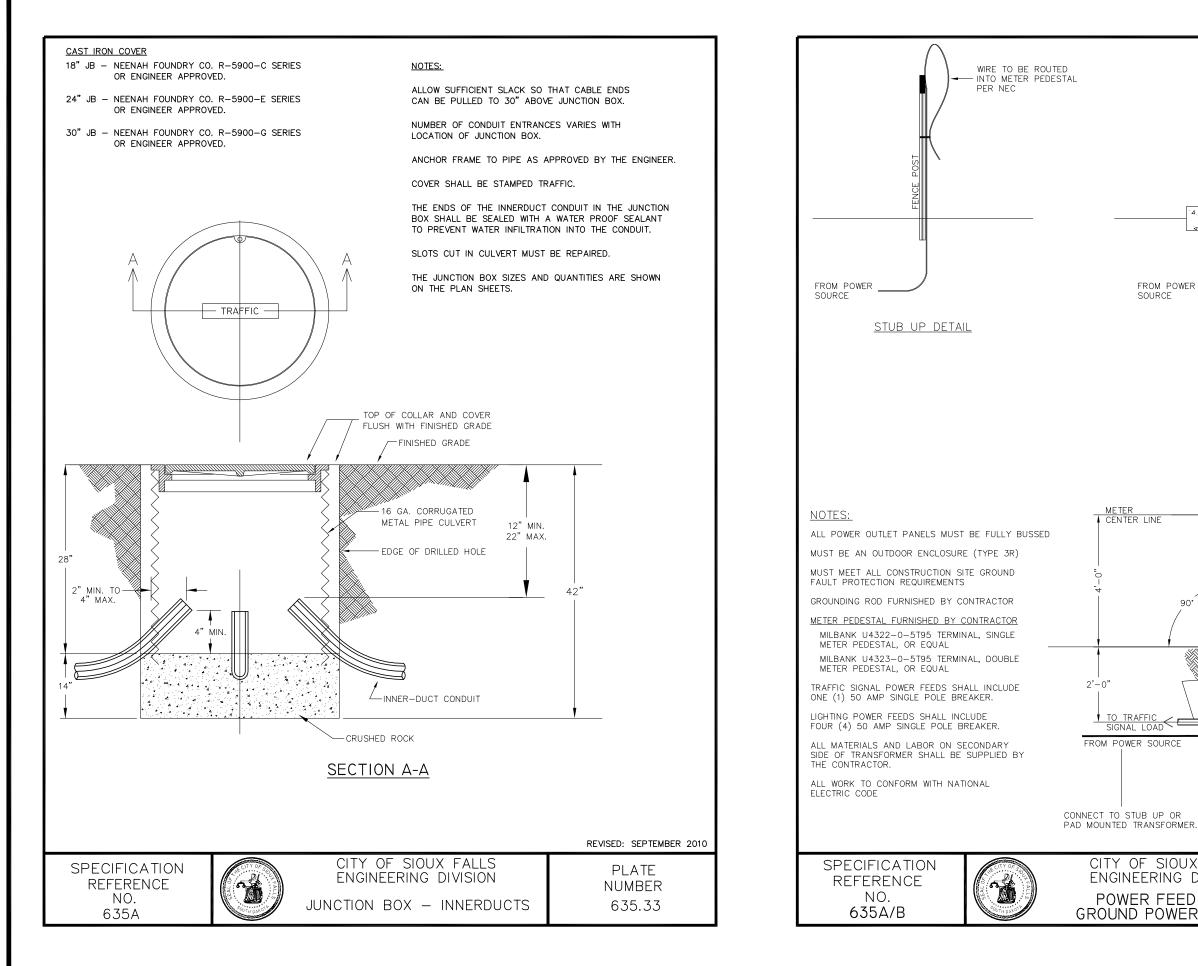


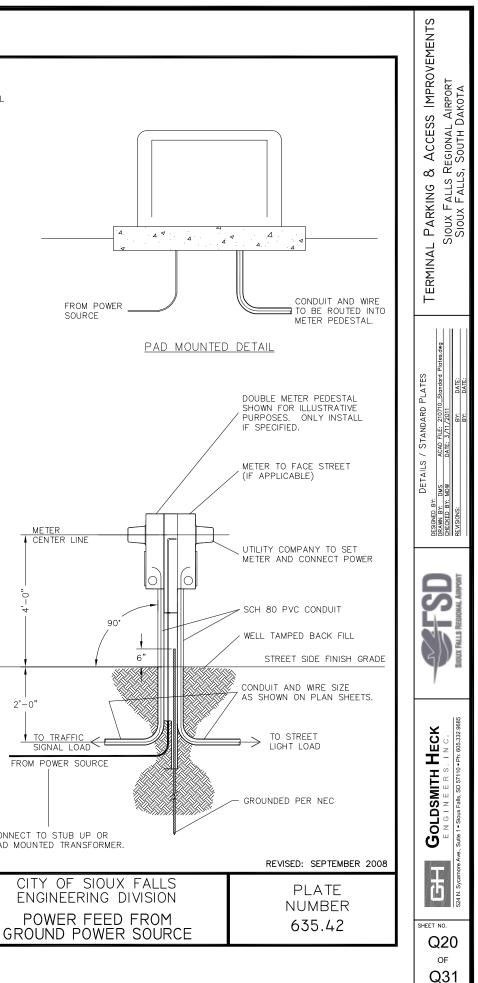


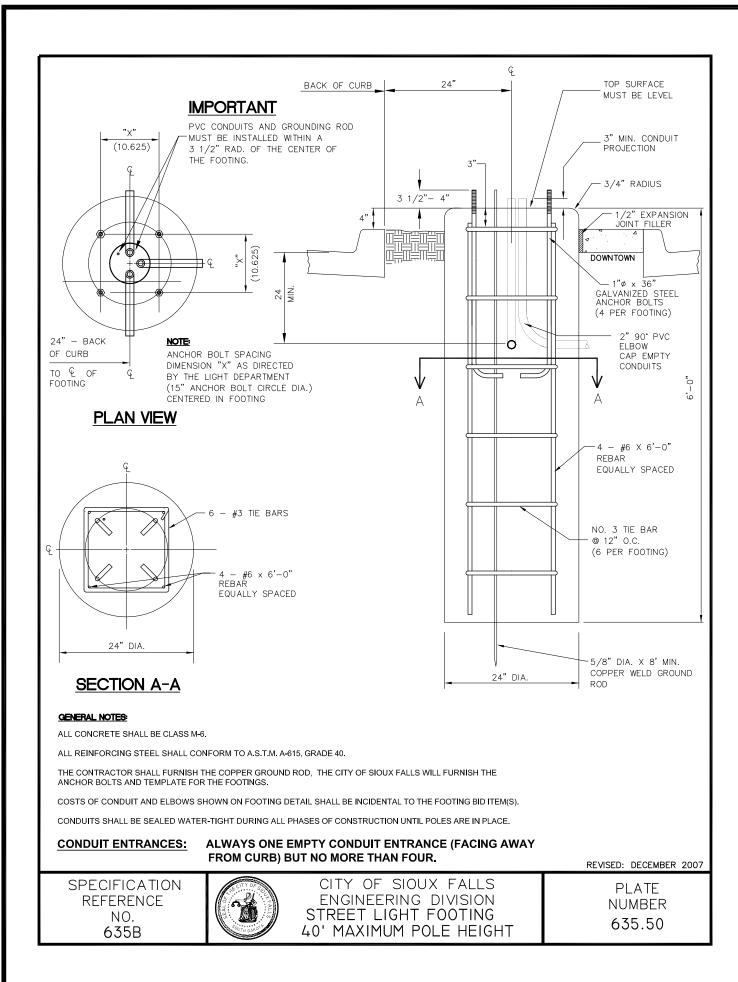


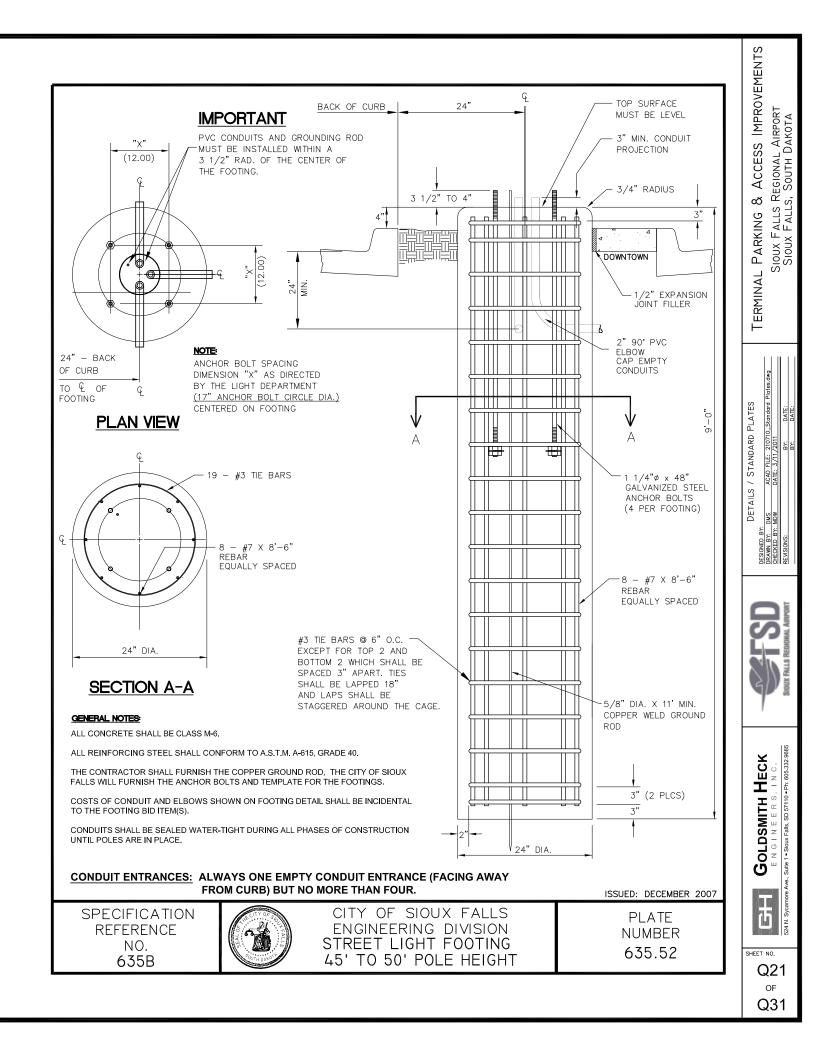

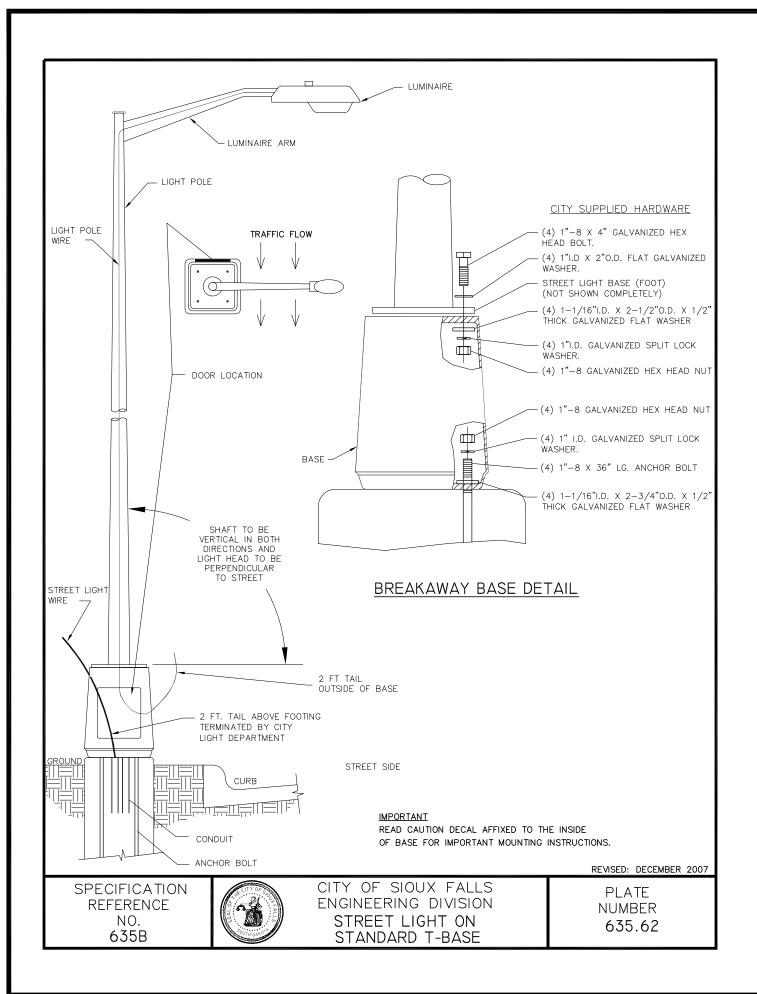

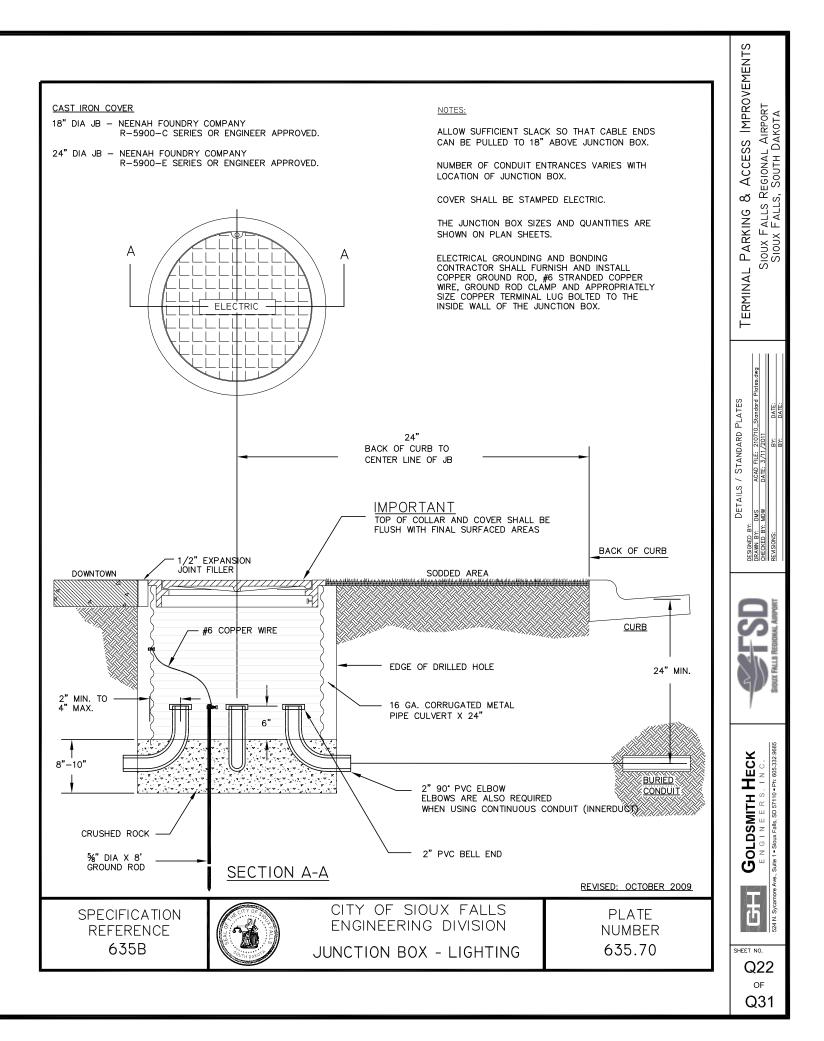


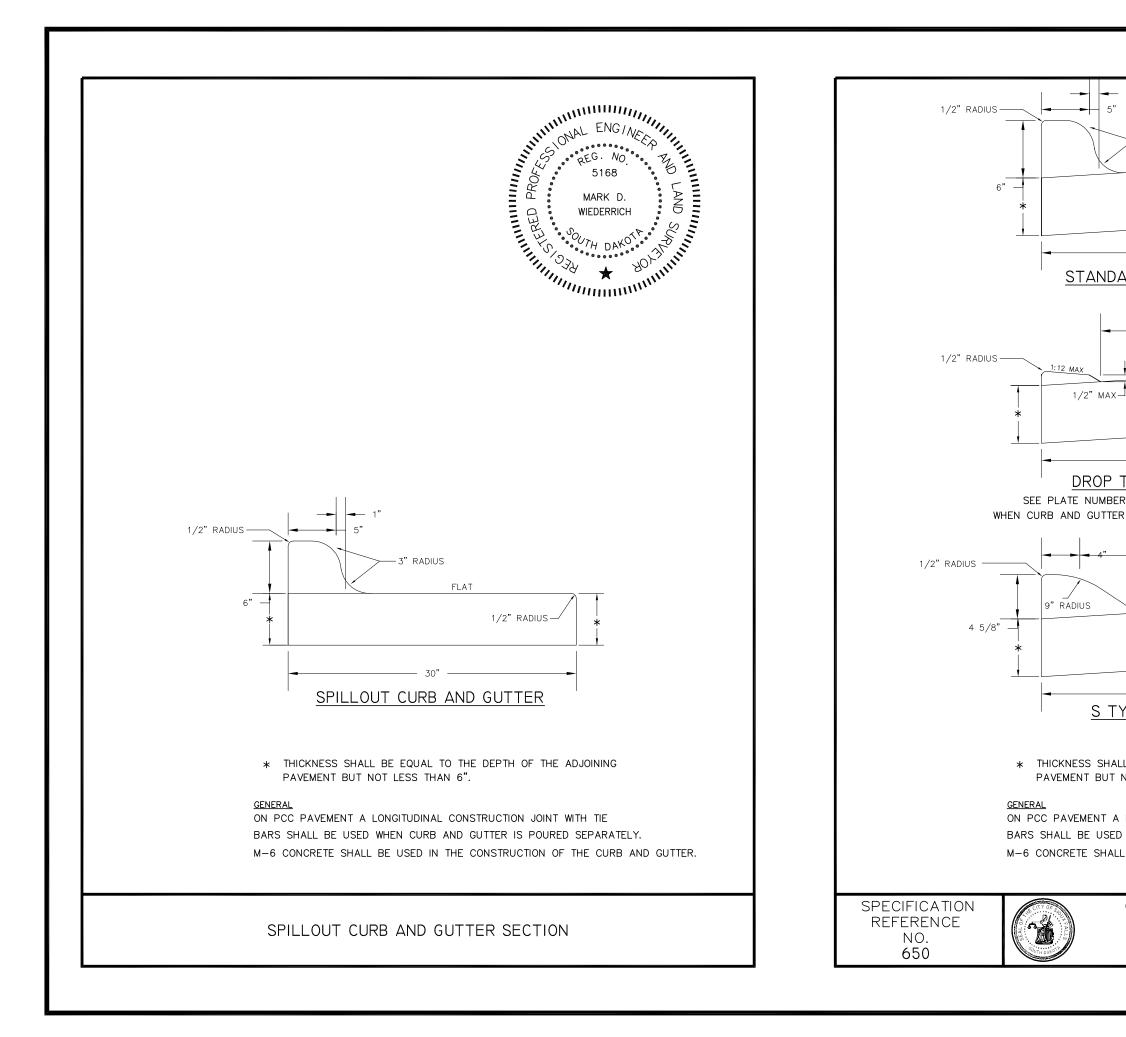

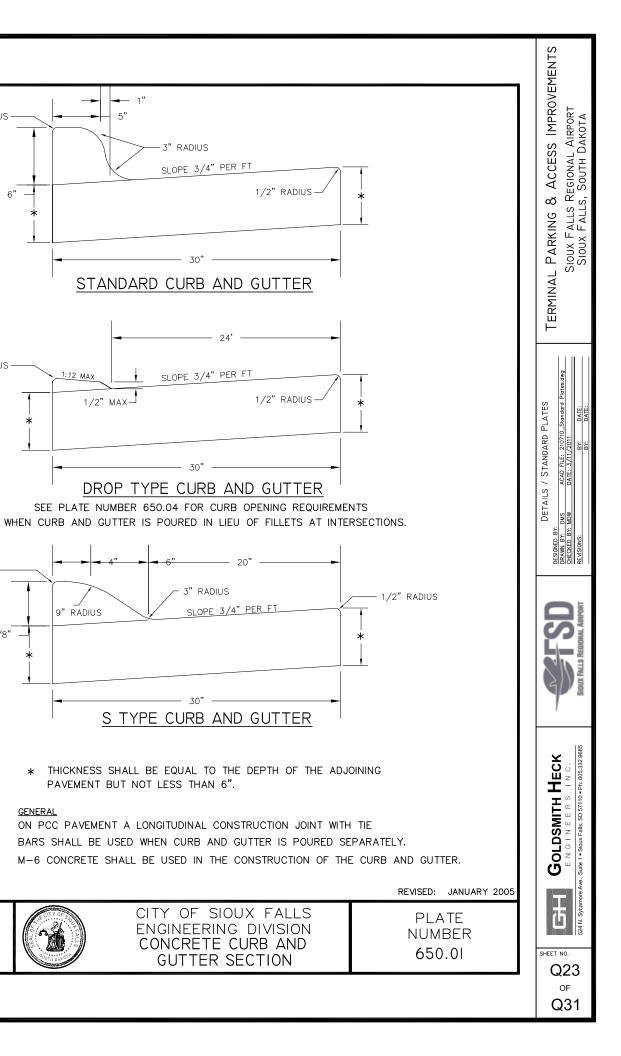

**—** 1"

5"

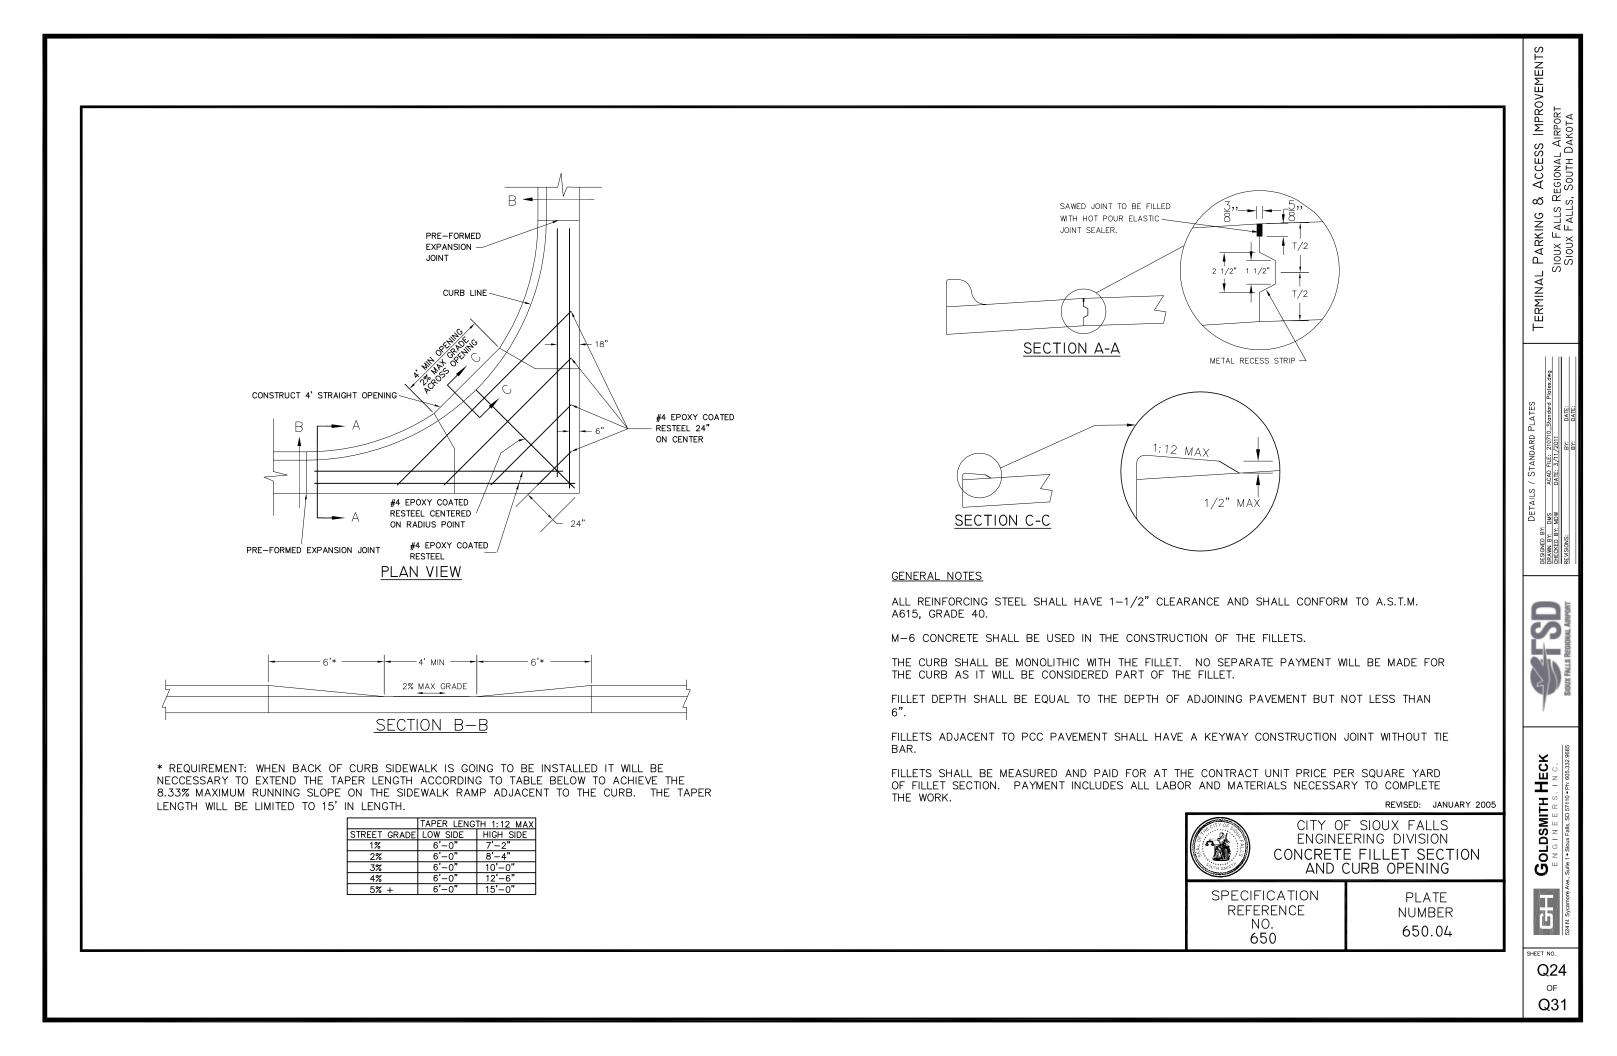

## STANDARD REQUIREMENTS

1) ALL RAMPS ARE REQUIRED TO HAVE A LANDING AREA WITH NO MORE THAN A 2% SLOPE IN ANY DIRECTION. THE LANDING AREA SHALL BE A MINIMUM OF 4' BY 4'. TYPICALLY, THE LANDING AREA SHALL BE LOCATED WHERE A PEDESTRIAN MAKES A TURNING MOVEMENT TO LINE UP WITH THE CURB OPENING. FOR EXAMPLE, THE LANDING AREA SHALL BE LOCATED WHERE 2 BOULEVARD SIDEWALKS JOIN AND CONNECT TO THE RAMP. THE LANDING AREA ON A CURB SIDE SIDEWALK SHALL BE LOCATED AT THE CURB OPENING. IT MAY BE NECESSARY TO HAVE MULTIPLE LANDING AREAS WHEN COMBINING BOULEVARD AND CURBSIDE SIDEWALKS. GRADE CHANGES FROM THE CONNECTING SIDEWALK OR RAMP TO THE LANDING AREA MUST BE PERPENDICULAR TO THE DIRECTION OF TRAVEL.

2) ALL RAMPS HAVE A MAXIMUM RUNNING SLOPE OF 8.33% (1" PER FOOT) WITH THE FOLLOWING EXCEPTION: ON BACK OF CURB SIDEWALKS, THE CURB RAMP LENGTH MAY NEED TO BE EXTENDED ACCORDING TO TABLE B TO ACHIEVE THE MAXIMUM SLOPE OF 8.33% THE CURB RAMP LENGTH WILL BE LIMITED TO A MAXIMUM LENGTH OF 15'.

3) ALL SIDEWALKS AND RAMPS HAVE A MAXIMUM CROSS SLOPE OF 2% (1/4" PER FOOT).

4) INSTALL PREMANUFACTURED DETECTABLE WARNING PANELS IN ACCORDANCE WITH MANUFACTURE'S RECOMMENDATIONS. THE CITY ENGINEER'S OFFICE HAS AN APPROVED LIST OF MANUFACTURES ON FILE. SEE DETAIL A AND TABLE A FOR DETECTABLE WARNING PANEL SIZE AND LOCATION. DETECTABLE WARNING PANELS SHALL BE AN APPROVED RED COLOR EXCEPT IN LOCATIONS WHERE THE ADJOINING CONCRETE SIDEWALK IS RED OR DARK IN COLOR. AT THESE LOCATIONS THE DETECTABLE WARNING PANEL SHALL BE A CONTRASTING COLOR APPROVED BY THE CITY ENGINEER. THE SIDEWALK DEPTH SHALL BE A MINIMUM OF 6" FOR A 2' AREA ADJACENT TO THE DETECTABLE WARNING PANEL.

5) OBSTRUCTIONS SUCH AS SIGNAL POLES, LIGHT POLES, TRAFFIC CONTROLLER CABINETS, ETC. CAN NOT BE LOCATED IN THE LANDING AREA OR THE RAMP SLOPE. ALL SIDEWALKS SHALL HAVE A 4' MINIMUM WIDTH FREE OF OBSTRUCTIONS TO ACCOMMODATE PEDESTRIAN TRAVEL

6) DEPENDING ON ADJOINING GRADES AND EXISTING CONDITIONS A CURB WITH A MAXIMUM HEIGHT OF 6" MAY NEED TO BE INSTALLED ON THE BACK OF THE LANDING AREA AND CONNECTING SIDEWALK. THIS CURB MAY ALSO NEED TO BE INSTALLED TO ENSURE STREET DRAINAGE DOES NOT OVERFLOW THE AREA BEHIND THE LANDING AREA AND RAMP.

### GENERAL NOTES

THE CONTRACTOR MUST HAVE AN ELECTRONIC LEVEL ON SITE TO ENSURE THE SPECIFIED SLOPES ARE MAINTAINED.


CARE SHALL BE TAKEN TO ENSURE THE SURFACE OF THE DETECTABLE WARNING PANEL IS CLEAN AND FREE OF CURING COMPOUND AND CONCRETE RESIDUE.

SURFACE TEXTURE OF THE RAMP SHALL BE OBTAINED BY COARSE BROOMING TRANSVERSE TO THE SLOPE OF THE RAMP.


JOINTS SHALL BE TOOLED INTO THE CONCRETE ADJACENT TO THE DETECTABLE WARNING PANELS TO ALLEVIATE POSSIBLE CORNER CRACKING (SEE DETAIL A).


THERE WILL BE NO SEPARATE PAYMENT FOR THE SIDEWALK LANDING AREA OR RAMP. THE SIDEWALK LANDING AREA AND RAMP, INCLUDING THE DETECTABLE WARNING PANEL AREA, SHALL BE MEASURED AND PAID FOR AT THE CONTRACT UNIT PRICE PER SQUARE FOOT FOR THE CORRESPONDING CONCRETE SIDEWALK BID ITEM. NO ADDITIONAL PAYMENT WILL BE MADE FOR THE ADDITIONAL CONCRETE DEPTH ADJACENT TO THE DETECTABLE WARNING PANEL.


THE DETECTABLE WARNING PANEL SHALL BE MEASURED TO THE NEAREST SQUARE FOOT. PAYMENT WILL BE AT THE CONTRACT UNIT PRICE PER SQUARE FOOT FOR THE DETECTABLE WARNING PANELS. PAYMENT SHALL INCLUDE ALL COSTS FOR MATERIALS, LABOR, AND EQUIPMENT NECESSARY FOR THE INSTALLATION OF THE DETECTABLE WARNING PANELS.

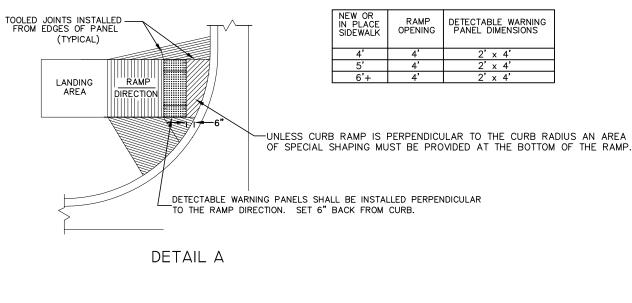





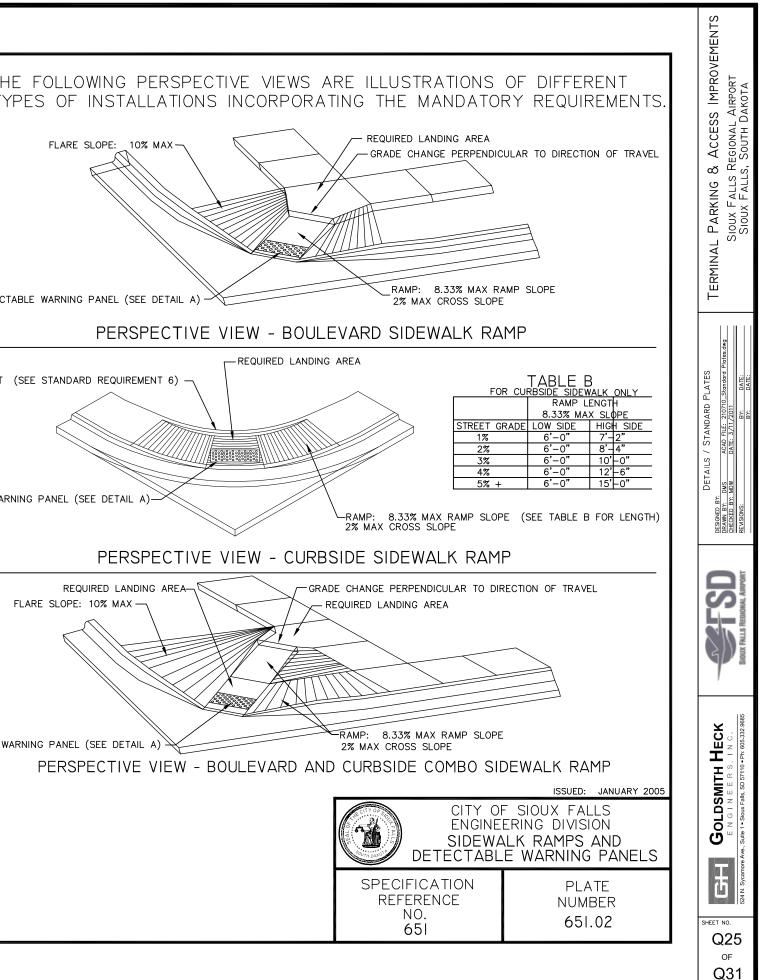

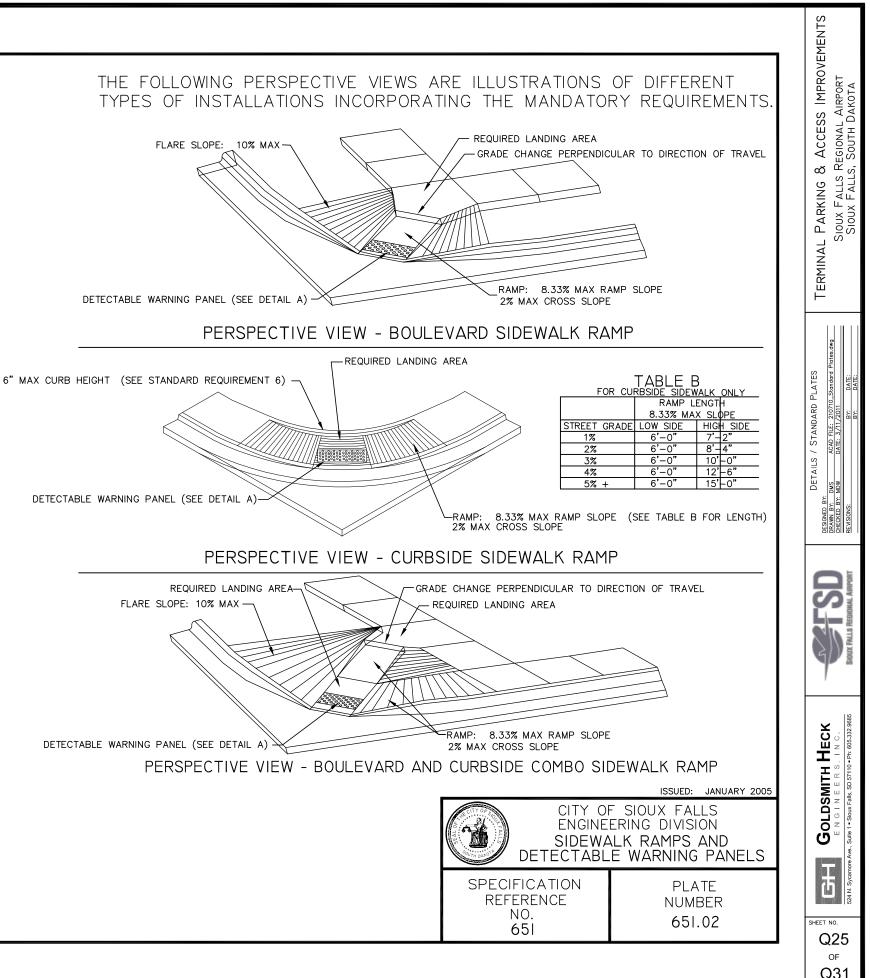


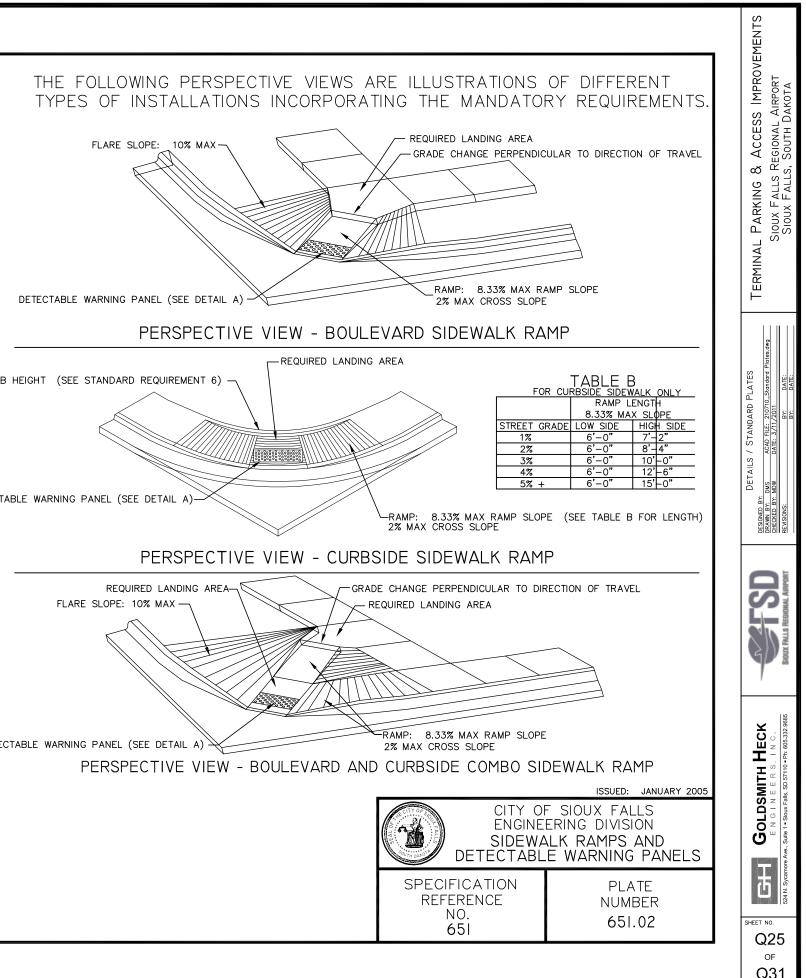

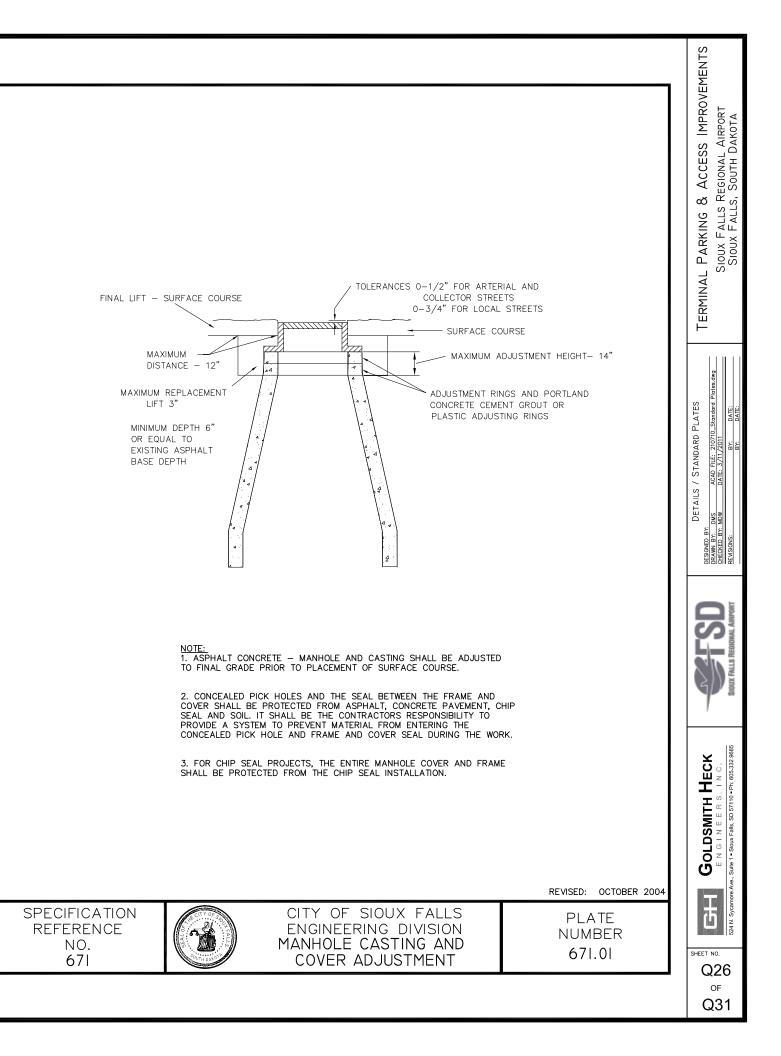


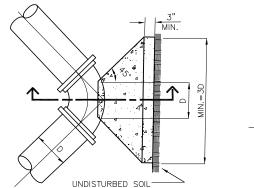


<u>PLAN VIEW</u>

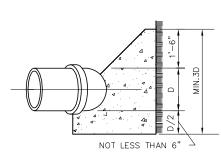




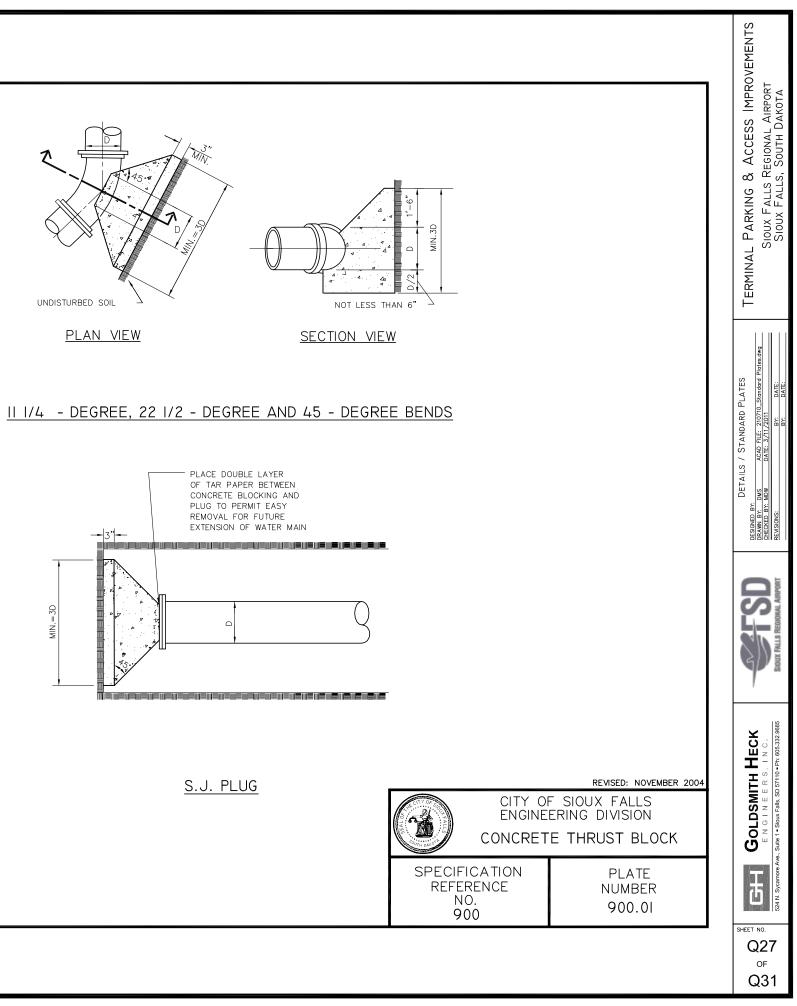

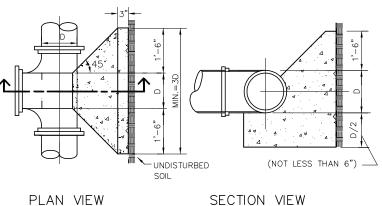


90 - DEGREE BEND

PLAN VIEW

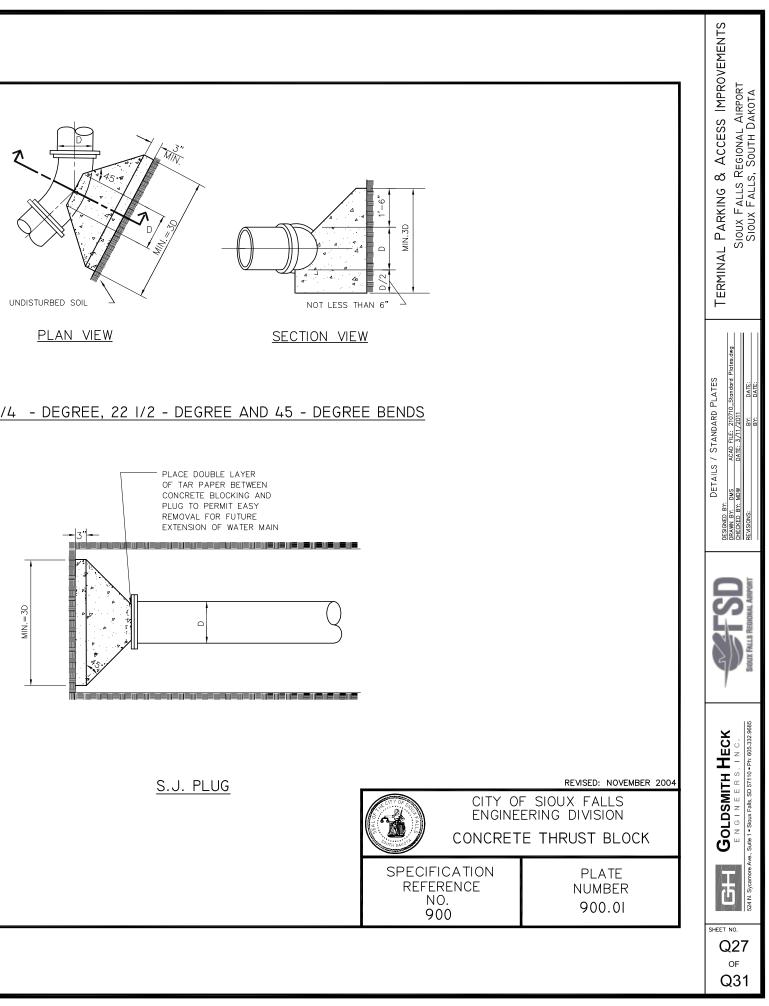


TEE


CONCRETE THRUST BLOCK

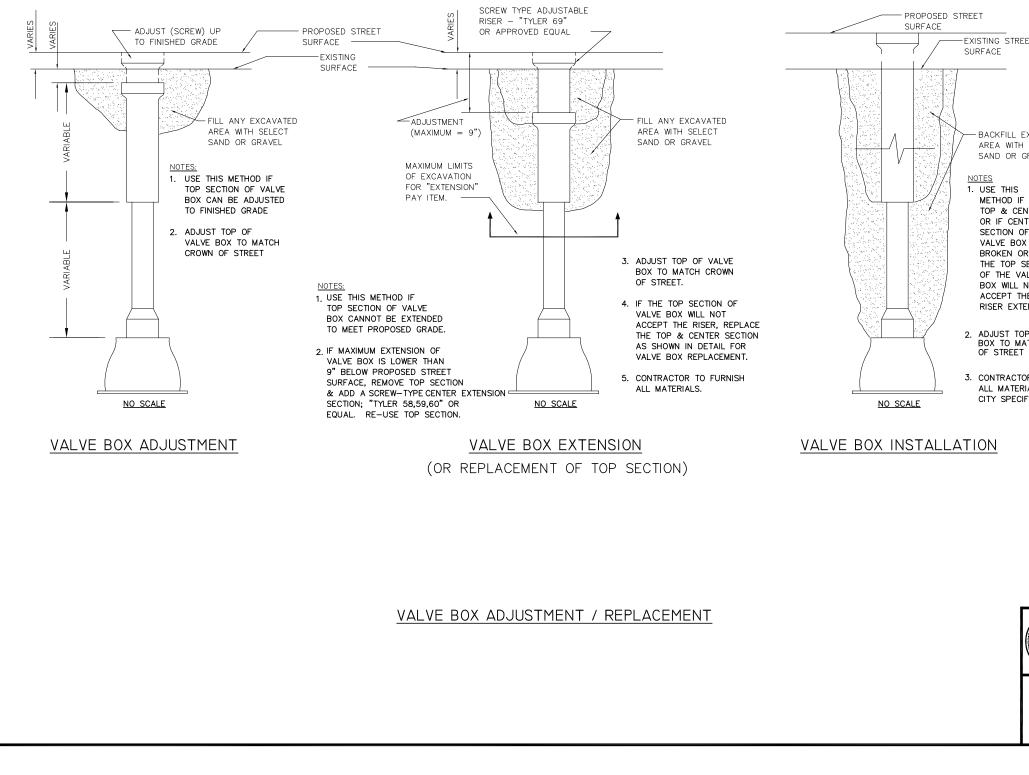


EET		TERMINAL PARKING & ACCESS IMPROVEMENTS SIOUX FALLS REGIONAL AIRPORT SIOUX FALLS, SOUTH DAKOTA
H SELECT GRAVEL F ENTER, NTER OF XIS DR IF SECTION (ALVE NOT HE TENSION. OP OF VALVE IATCH CROWN T T		DETAILS / STANDARD PLATES DESORD BY: DRAWN BY: DNS ACAD FILE: 210710_Standard Plates.dwg DRAWN BY: DNS ACAD FILE: 210710_Standard Plates.dwg DREAKED BY: MOW DATE: 3/11/2011 REVISIONS: BY: DATE:
RIALS TO MEET SIFICATIONS.		K SOURT FILLS REDONAL ARPORT
	REVISED: NOVEMBER 2004 F SIOUX FALLS ERING DIVISION ALVE BOX NT/ REPLACEMENT PLATE NUMBER 900.02	GOLDSMITH HECK E N G I N E E R S, I N C. 524 N. Sycamore Ave. Suite 1 - Slow Falls, SD 57110 - Ph. 606.332.9666
		SHEET NO. Q28 OF Q31

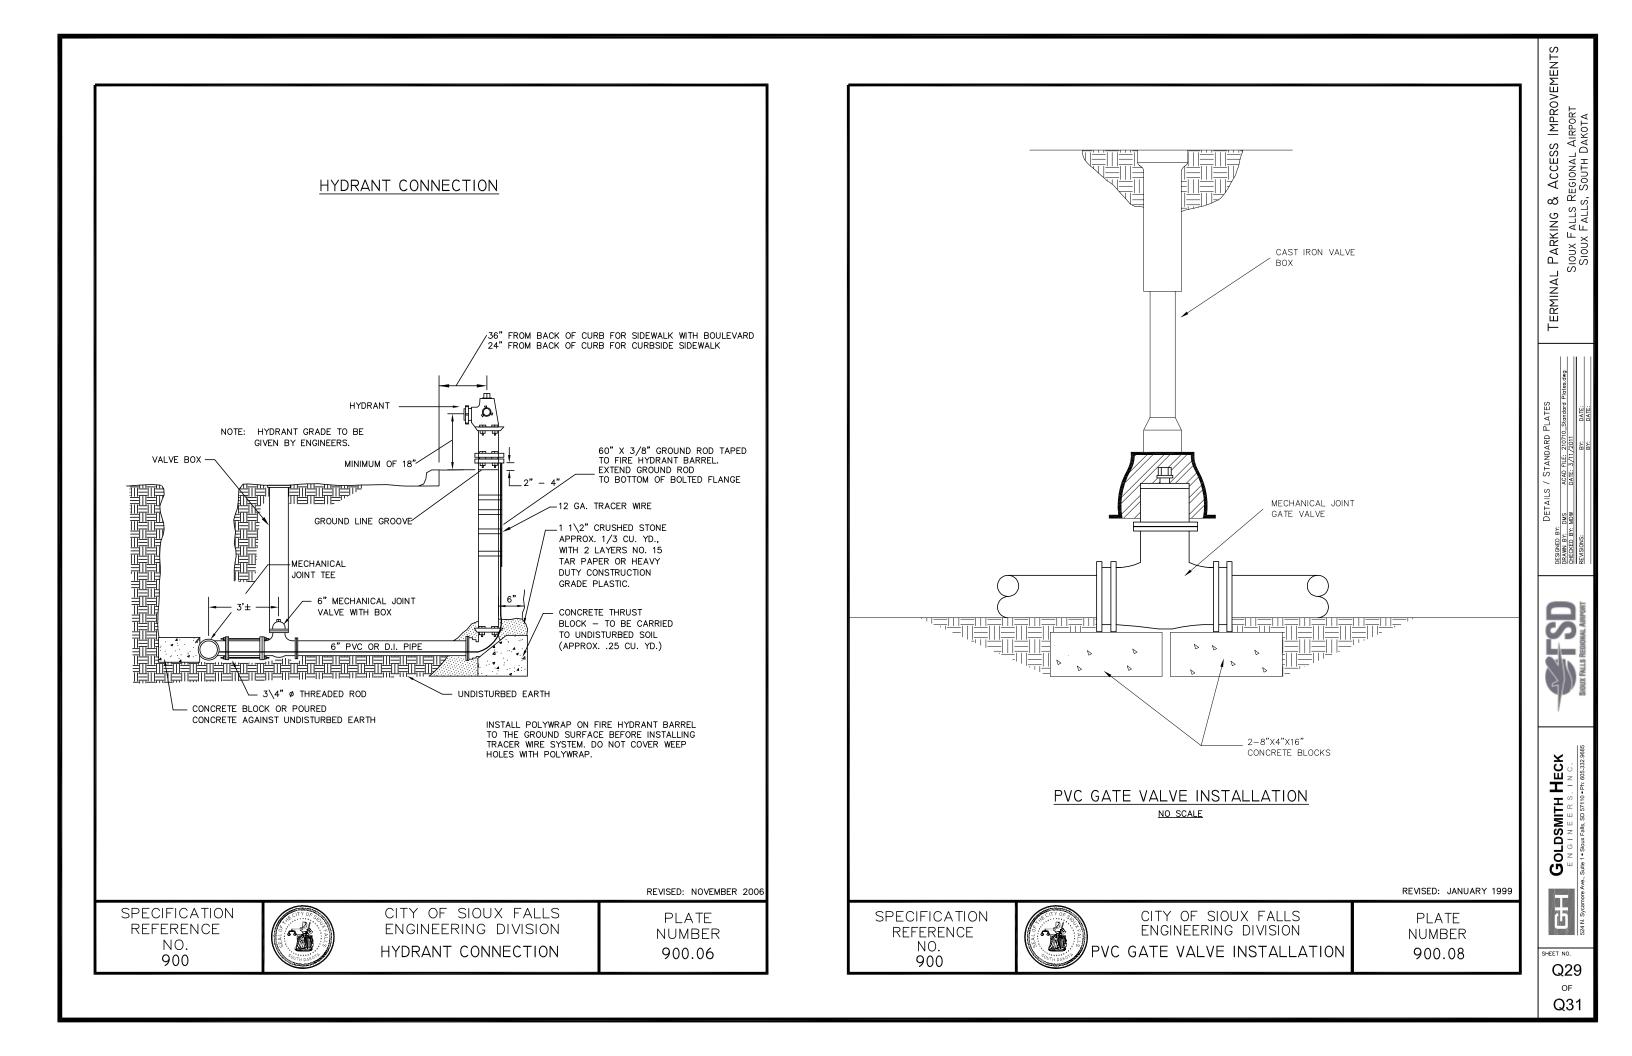


PIPE SIZE DIAMETER	TRENCH WIDTH	TRENCH HEIGHT	TRENCH AREA	PIPE AREA	WATER MAIN BEDDING MAT. AREA	WATER MAIN BEDDING MAT. TONS/LF
4"	28"	16"	3.11 SQ.FT.	.09 SQ.FT.	3.02 SQ.FT.	0.21
6"	30"	18"	3.75 SQ.FT.	.20 SQ.FT.	3.55 SQ.FT.	0.25
8"	32"	20"	4.44 SQ.FT.	.35 SQ.FT.	4.10 SQ.FT.	0.29
10"	34"	22"	5.19 SQ.FT.	.55 SQ.FT.	4.65 SQ.FT.	0.33
12"	36"	24"	6.00 SQ.FT.	.79 SQ.FT.	5.22 SQ.FT.	0.37
16"	40"	28"	7.78 SQ.FT.	1.40 SQ.FT.	6.38 SQ.FT.	0.45
20"	44"	32"	9.78 SQ.FT.	2.18 SQ.FT.	7.60 SQ.FT.	0.53
24"	48"	36"	12.00 SQ.FT.	3.14 SQ.FT.	8.86 SQ.FT.	0.62
30"	60"	42"	17.50 SQ.FT.	4.91 SQ.FT.	12.59 SQ.FT.	0.88
24" 30" >30" USE	48"	36" 42" SIDE OF WATE	12.00 SQ.FT. 17.50 SQ.FT.	3.14 SQ.FT.	8.86 SQ.FT.	0.62

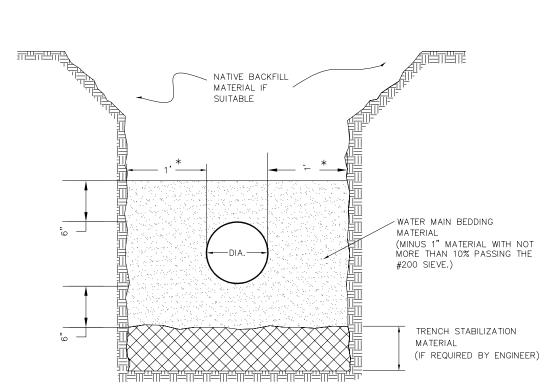


WATER MAIN BEDDING DETAIL

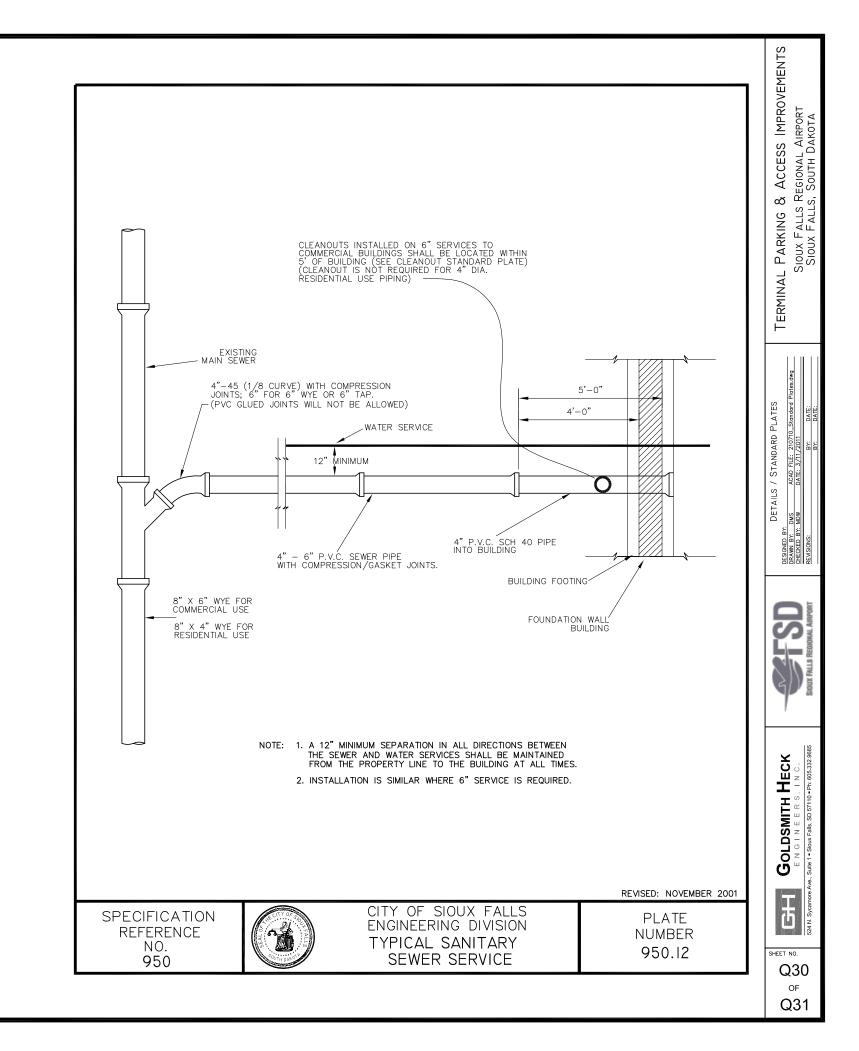

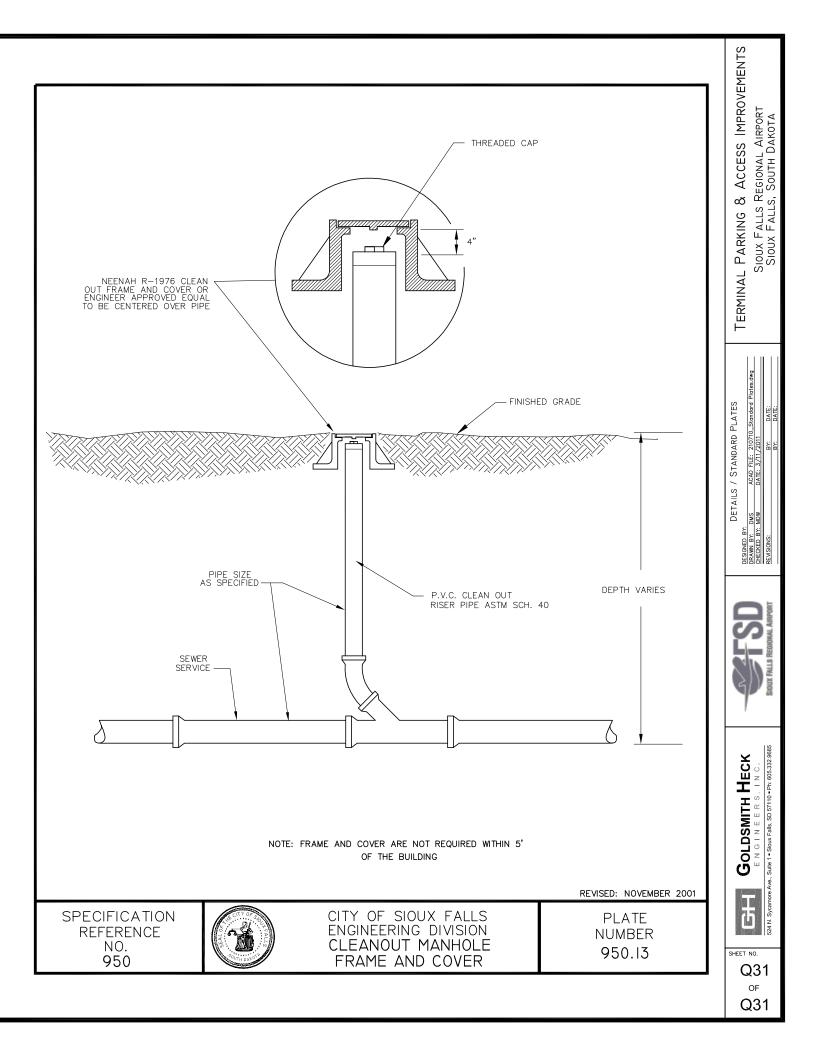

# **LEGEND OF SYMBOLS**

ДС	EXISTING FIRE HYDRANT	8"SAN	GRAVITY SANITARY SEWER (TYPE/SIZE)	LS
<u></u>	EXISTING VALVE & BOX	SFM	FORCE MAIN SANITARY SEWER	o
E+	EXISTING TEE	CS	COMBINED SEWER	oo
<b>&gt;</b>	EXISTING REDUCER	*50	WATER SHUTOFF	xx
	EXISTING SLEEVE	8"W	WATER MAIN & SIZE	
+ <u>∓</u> +	EXISTING CROSS	$\boxtimes$	CLEAN OUT	
W	EXISTING WATER MANHOLE	Ø	CAP END	
S	EXISTING SANITARY MANHOLE	S	PROPOSED SANITARY MANHOLE	
Огн	EXISTING SANITARY LAMPHOLE	$\bigotimes$	PROPOSED VALVE & BOX	
D	EXISTING JUNCTION BOX	$\bigcirc$	PROPOSED TEE	18"RCP
==1====================================	EXISTING APPROACH	$\otimes$	PROPOSED CROSS	
	EXISTING SIDEWALK	R	PROPOSED REDUCER OR INCREASER	
C	EXISTING DROP INLET	S	PROPOSED SLEEVE	1400
	EXISTING CULVERT	$(\square)$	PROPOSED FIRE HYDRANT	$\nabla$
1400	EXISTING CONTOURS	90B	PROPOSED 90' BEND	
8" S VCP	EX. SANITARY SEWER (SIZE/TYPE/MATERIAL)	(45B)	PROPOSED 45° BEND	<b>+</b> <sup>#4</sup>
	MATERIAL FOR LINES:	(22B)	PROPOSED 22 1/2" BEND	<b>¢</b>
VCP	VITRIFIED CLAY PIPE	(11B)	PROPOSED 11 1/4. BEND	$+ \triangleright$
PVC	SOLID WALL POLYVINYL CHLORIDE PIPE	P	PROPOSED M.J. PLUG	-
PVC TRUSS	POLYVINYL CHLORIDE TRUSS COMPOSITE PIPE		PROPOSED AIR RELEASE MANHOLE	$\longrightarrow$
ABS TRUSS	ACRYLONITRILE-BUTADIENNE-STYRENE COMPOSITE	ST	PROPOSED SMITH'S TAP	Ø
PVC CP	CLOSED PROFILE WALL POLYVINYL CHLORIDE PIPE	2"G	GAS MAIN & SIZE	
DIP	DUCTILE IRON PIPE	UT	UNDERGROUND TELEPHONE	<del>o</del>
RCP	REINFORCED CONCRETE PIPE	OT	OVERHEAD TELEPHONE	$\otimes$
CIP	CAST IRON PIPE	UP	UNDERGROUND POWER	Ø
CIPP	CURED IN PLACE PIPE	OP	OVERHEAD POWER	Ê
PE	POLYETHYLENE PIPE	F0	FIBER OPTIC	(
8"W	EXISTING WATER MAIN & SIZE	UTV	UNDERGROUND CABLE TV	
————————————————————	EXISTING STORM SEWER & SIZE	OTV	OVERHEAD CABLE TV	۲. ۲.
		TR	TRAFFIC	~
		IW	INDUSTRIAL WASTE	

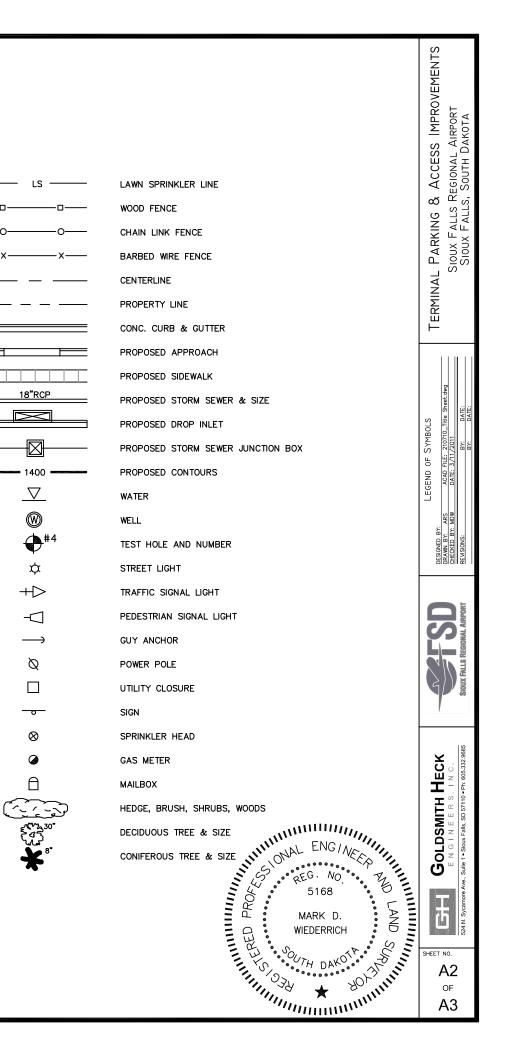

HORIZONTAL AND VERTICAL CONTROL POINTS						
POINT	DESCRIPTION	NORTHING	EASTING	ELEVATION		
CP1	REBAR	15839912.233	2241876.906	1425.67		
CP2	REBAR	15839814.893	2241165.905	1422.23		
CP3	PK NAIL	15839422.935	2241324.337	1421.70		
CP5	REBAR	15838595.563	2241746.278	1422.44		
CP6	REBAR	15838751.978	2241996.411	1424.50		

## TERMINAL PARKING ALIGNMENT

	MONUE (Son Same and S						
End 224438 Course 520-38-01E 19837822.861 22420457 2242047 22420457 2242047 22420457 22420457 22420457 22420457 22420457 2242047 22420457 2242047 2242047 22420 2240 2240 22420 2240 2240 2240 2240 2240		Desc.	Station	Spiral/Curve Data	a	Northing	Easting
		Begin End	0+00 22+84.38	Length: 2284.38	Course: S26-38-01E	15837922.861	2241021.7
	CP1						
			The sub-				
	*			a second and a second and a second a se			
		HETT	V ROAT		1949 - D D D D D D D D		
			Si SAD				
						NESOTA AVENUE (No.	
		<i>S</i> 7 //				NA ANDRE (SP)	******
					CP6		
	$\begin{array}{c} 0+00 \\ \varphi \\ -   - + - + - + - + - + - + - + - + - +$		<u>⊦0012+0(</u> ├──	<del>- +</del> "			1955 LANE
						0 0	
						Ŭ Ŭ	
				 		······································	

MINNES

